



SITE PLAN LEGEND

WATER VALVE	
SEWER METER	
WATER METER	
FH	
MANHOLE	
WATER LINE	
SCM LOCATIONS	
SEWER LINE	
30' STREETSCAPE BUFFER	
PERIMETER BUFFER	
NEUSE RIVER BUFFER	

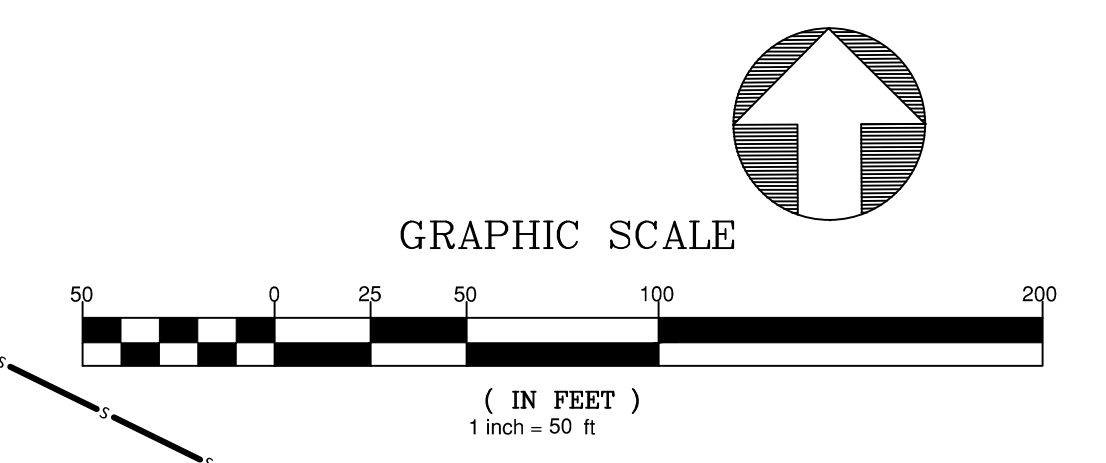

You'll need FHs every 400' along this waterline and a mainline valve every 1000'

Please provide an overall utility plan sheet.

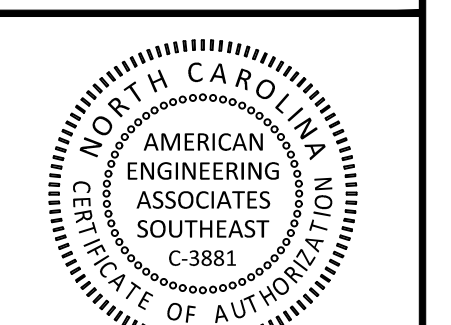

PRELIMINARY

FOR INFORMATION, ONLY

NO.	DATE	REVISION


STIPULATION FOR REUSE
 THIS DRAWING WAS PREPARED FOR USE ON THE SPECIFIC SITE, NAMED HEREON, CONTEMPORANEOUSLY WITH ITS ISSUE DATE AS LISTED, HEREON, AND IT IS NOT SUITABLE FOR USE ON A DIFFERENT PROJECT SITE OR AT A LATER TIME. USE OF THIS DRAWING FOR REFERENCE OR EXAMPLE ON ANOTHER PROJECT REQUIRES THE SERVICES OF PROPERLY LICENSED ARCHITECTS AND ENGINEERS. REPRODUCTION OF THIS DRAWING FOR REUSE ON ANOTHER PROJECT IS NOT AUTHORIZED AND MAY BE CONTRARY TO THE LAW.

MERRITT PROPERTY
UTILITY PLAN
(50 SCALE)
 ROLESVILLE RD
 WAKE COUNTY NC 27312

JOB NUMBER: 23-0004
 CHECKED BY:
 DRAWN BY: EDS
 DATE: APRIL 2024
 SHEET TITLE:

UTILITY PLAN
(50 SCALE)




SHEET NO.: **CU-102**

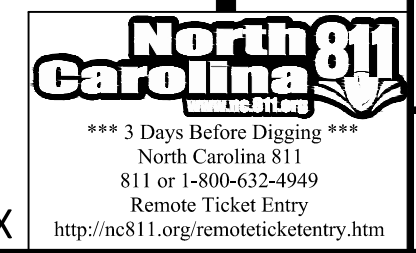

PROJECT NUMBER = PSP-YR-XX

Z:\Projects\2024\0004 Merritt Property\811\Working\Drawings\Utility\Site\CU-102 Utility Plan (50 Scale).dwg

Please include the latest Raleigh standard utility notes.

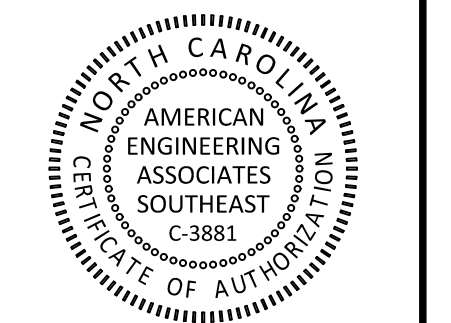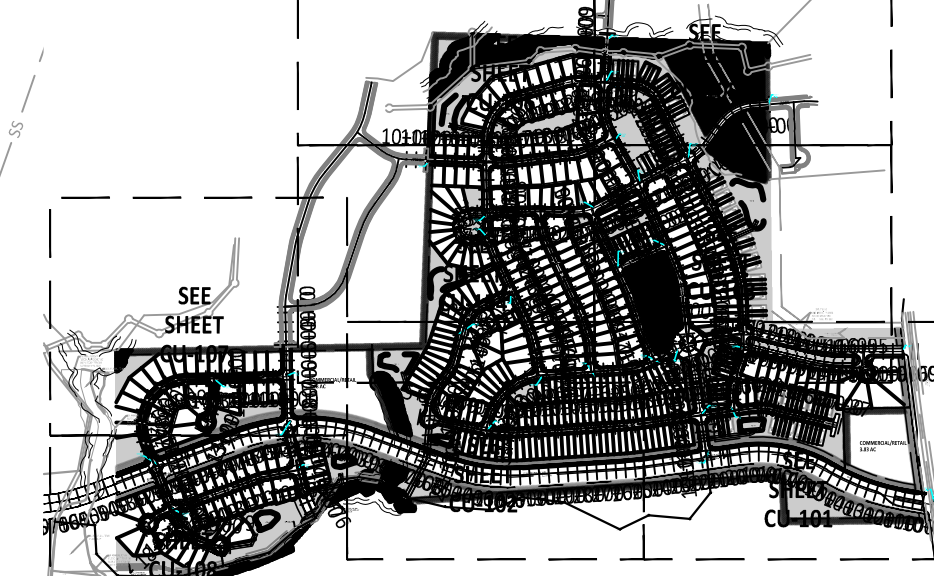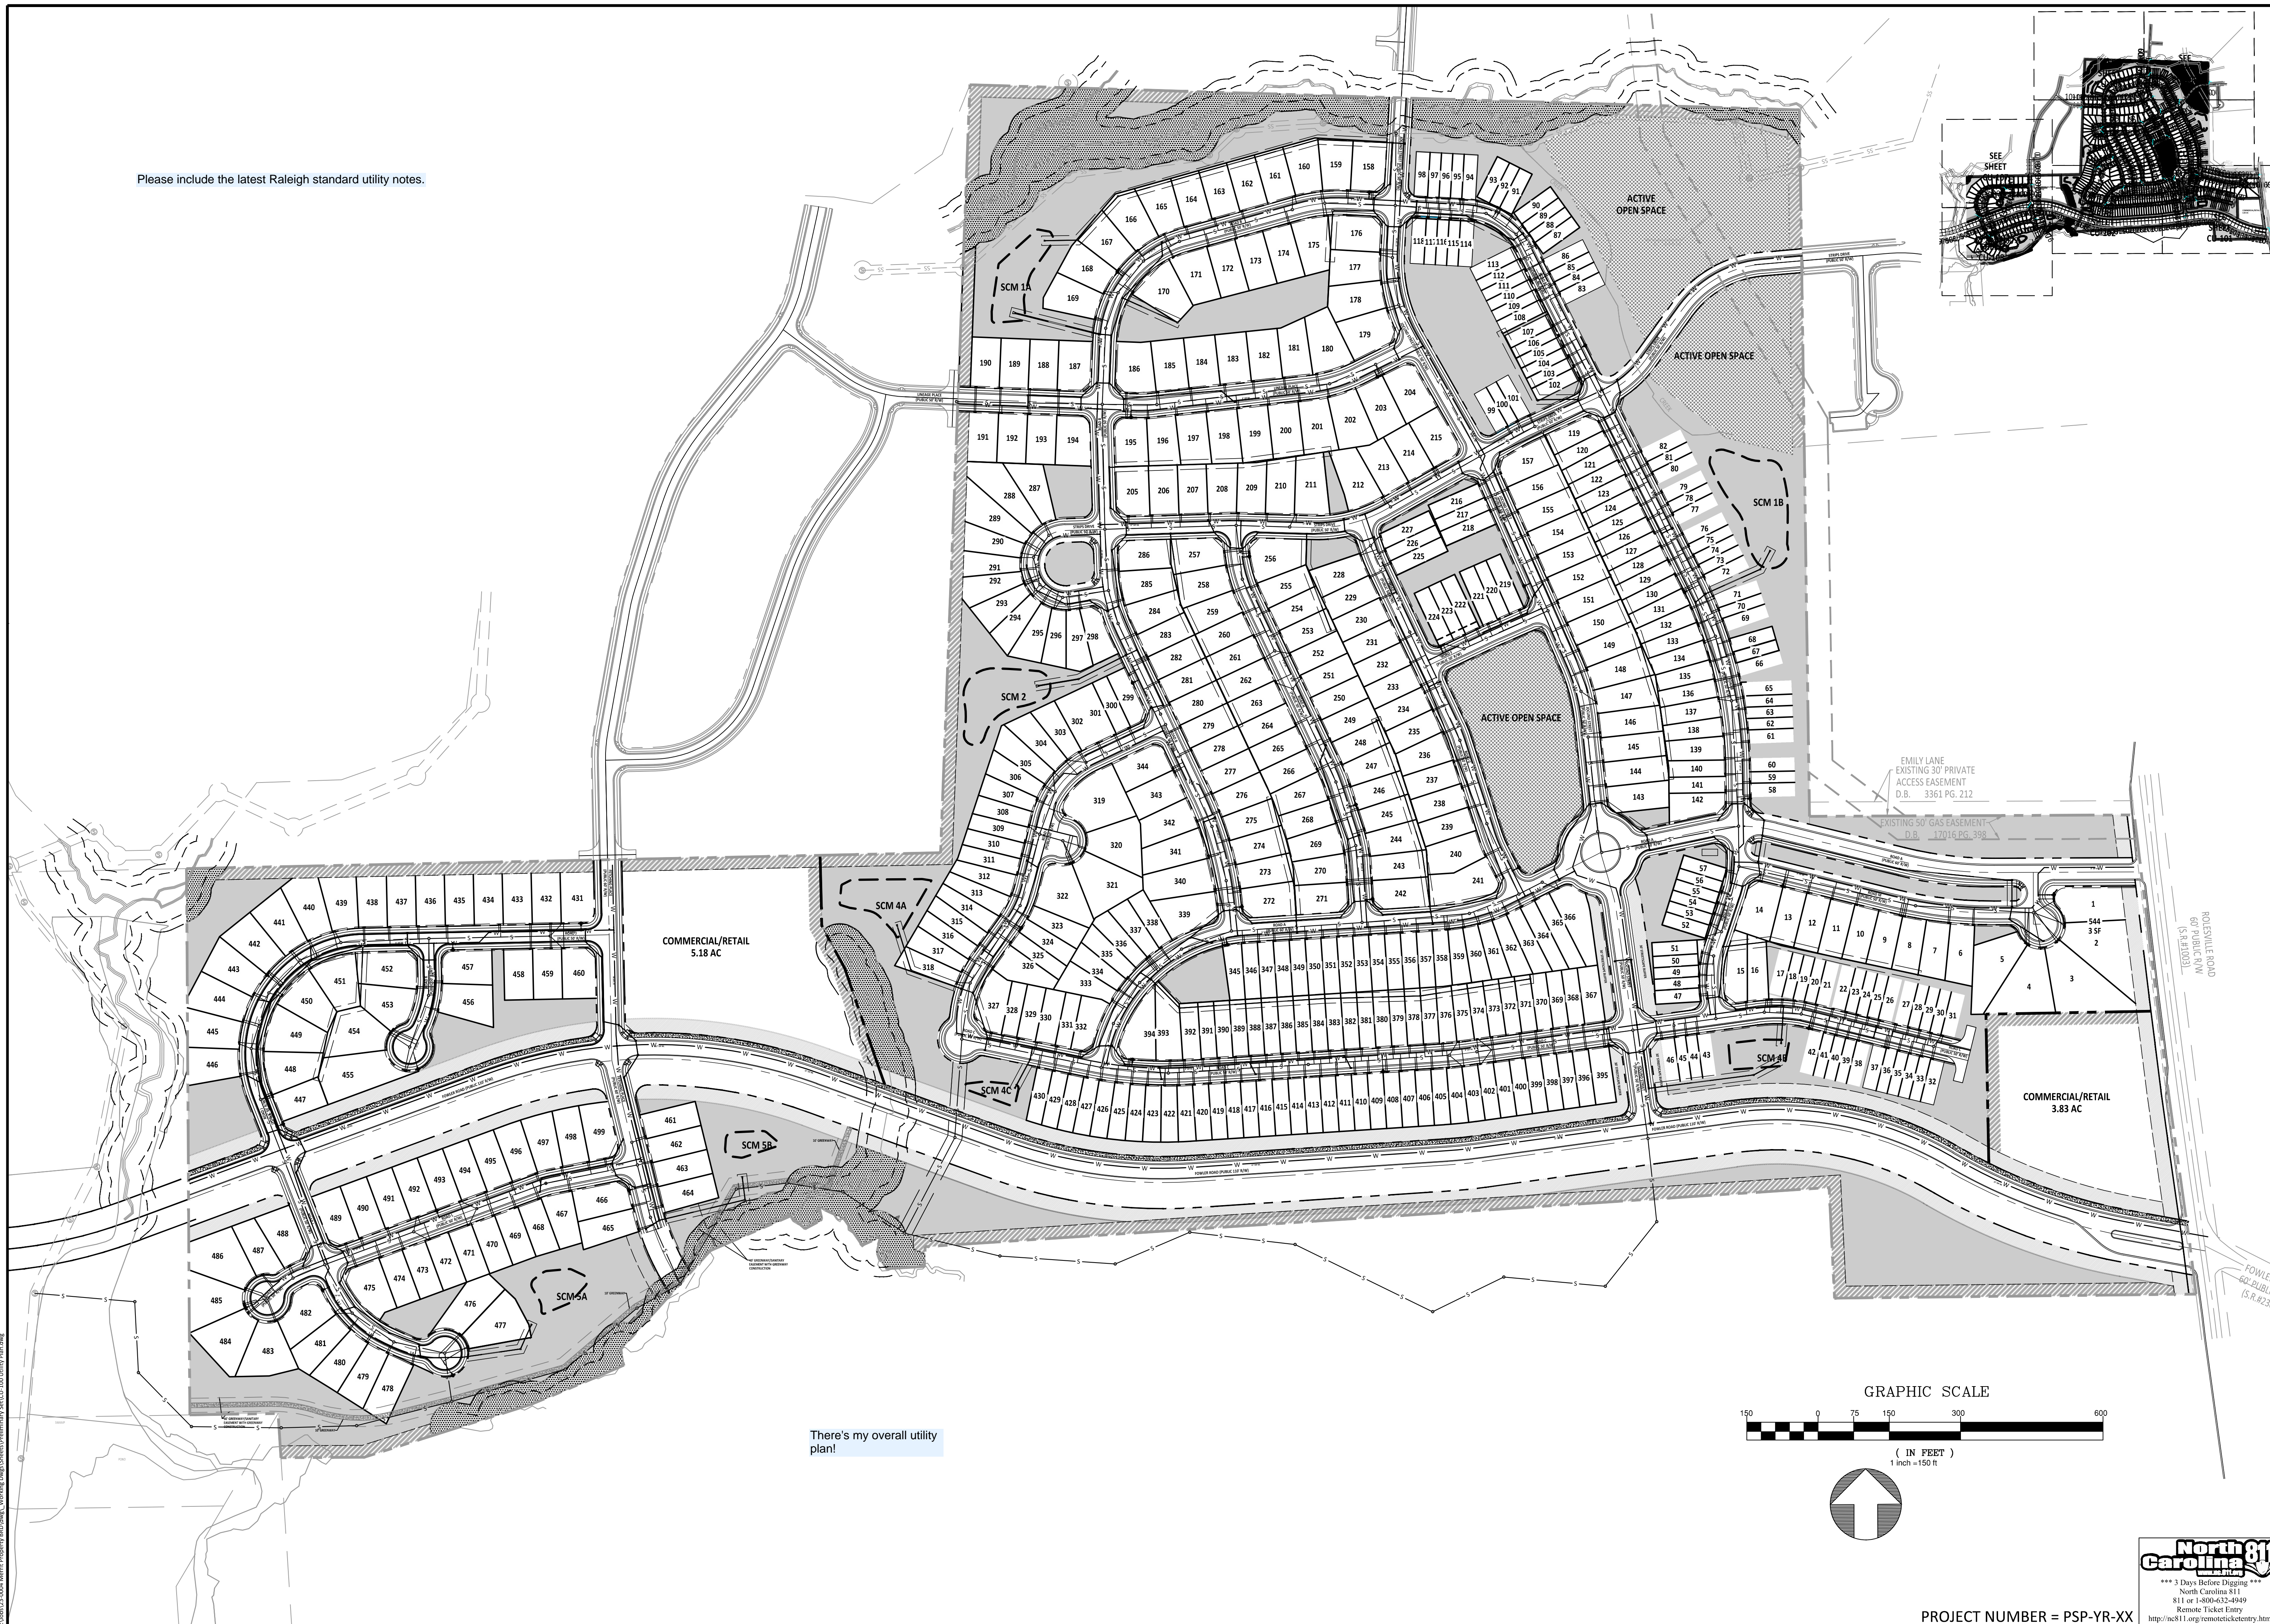

PRELIMINARY

FOR INFORMATION, ONLY


NO.	DATE	REVISION
1	7/25/24	MINOR SITE LAYOUT CHANGES

STIPULATION FOR REUSE
THIS DRAWING WAS PREPARED FOR USE ON THE SPECIFIC SITE, NAMED HEREON, CONTEMPORANEOUSLY WITH ITS ISSUE DATE AS LISTED, HEREON, AND IT IS NOT SUITABLE FOR USE ON A DIFFERENT PROJECT SITE OR AT A LATER TIME. USE OF THIS DRAWING FOR REFERENCE OR EXAMPLE ON ANOTHER PROJECT REQUIRES THE SERVICES OF PROPERLY LICENSED ARCHITECTS AND ENGINEERS. REPRODUCTION OF THIS DRAWING FOR REUSE ON ANOTHER PROJECT IS NOT AUTHORIZED AND MAY BE CONTRARY TO THE LAW.

MERRITT PROPERTY
UTILITY OVERALL PLAN
ROLESVILLE RD
WAKE COUNTY NC 27312


JOB NUMBER:	23-0004
CHECKED BY:	
DRAWN BY:	EDS
DATE:	APRIL 2024
SHEET TITLE:	UTILITY OVERALL PLAN
SHEET NO.:	CU-100

There's my overall utility plan!

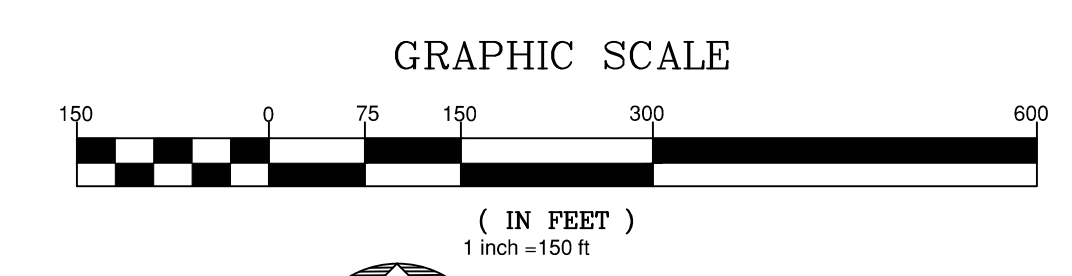


PROJECT NUMBER = PSP-YR-XX

Z:\Projects\2024\0004 Merritt Property\811\Utility Plan.dwg


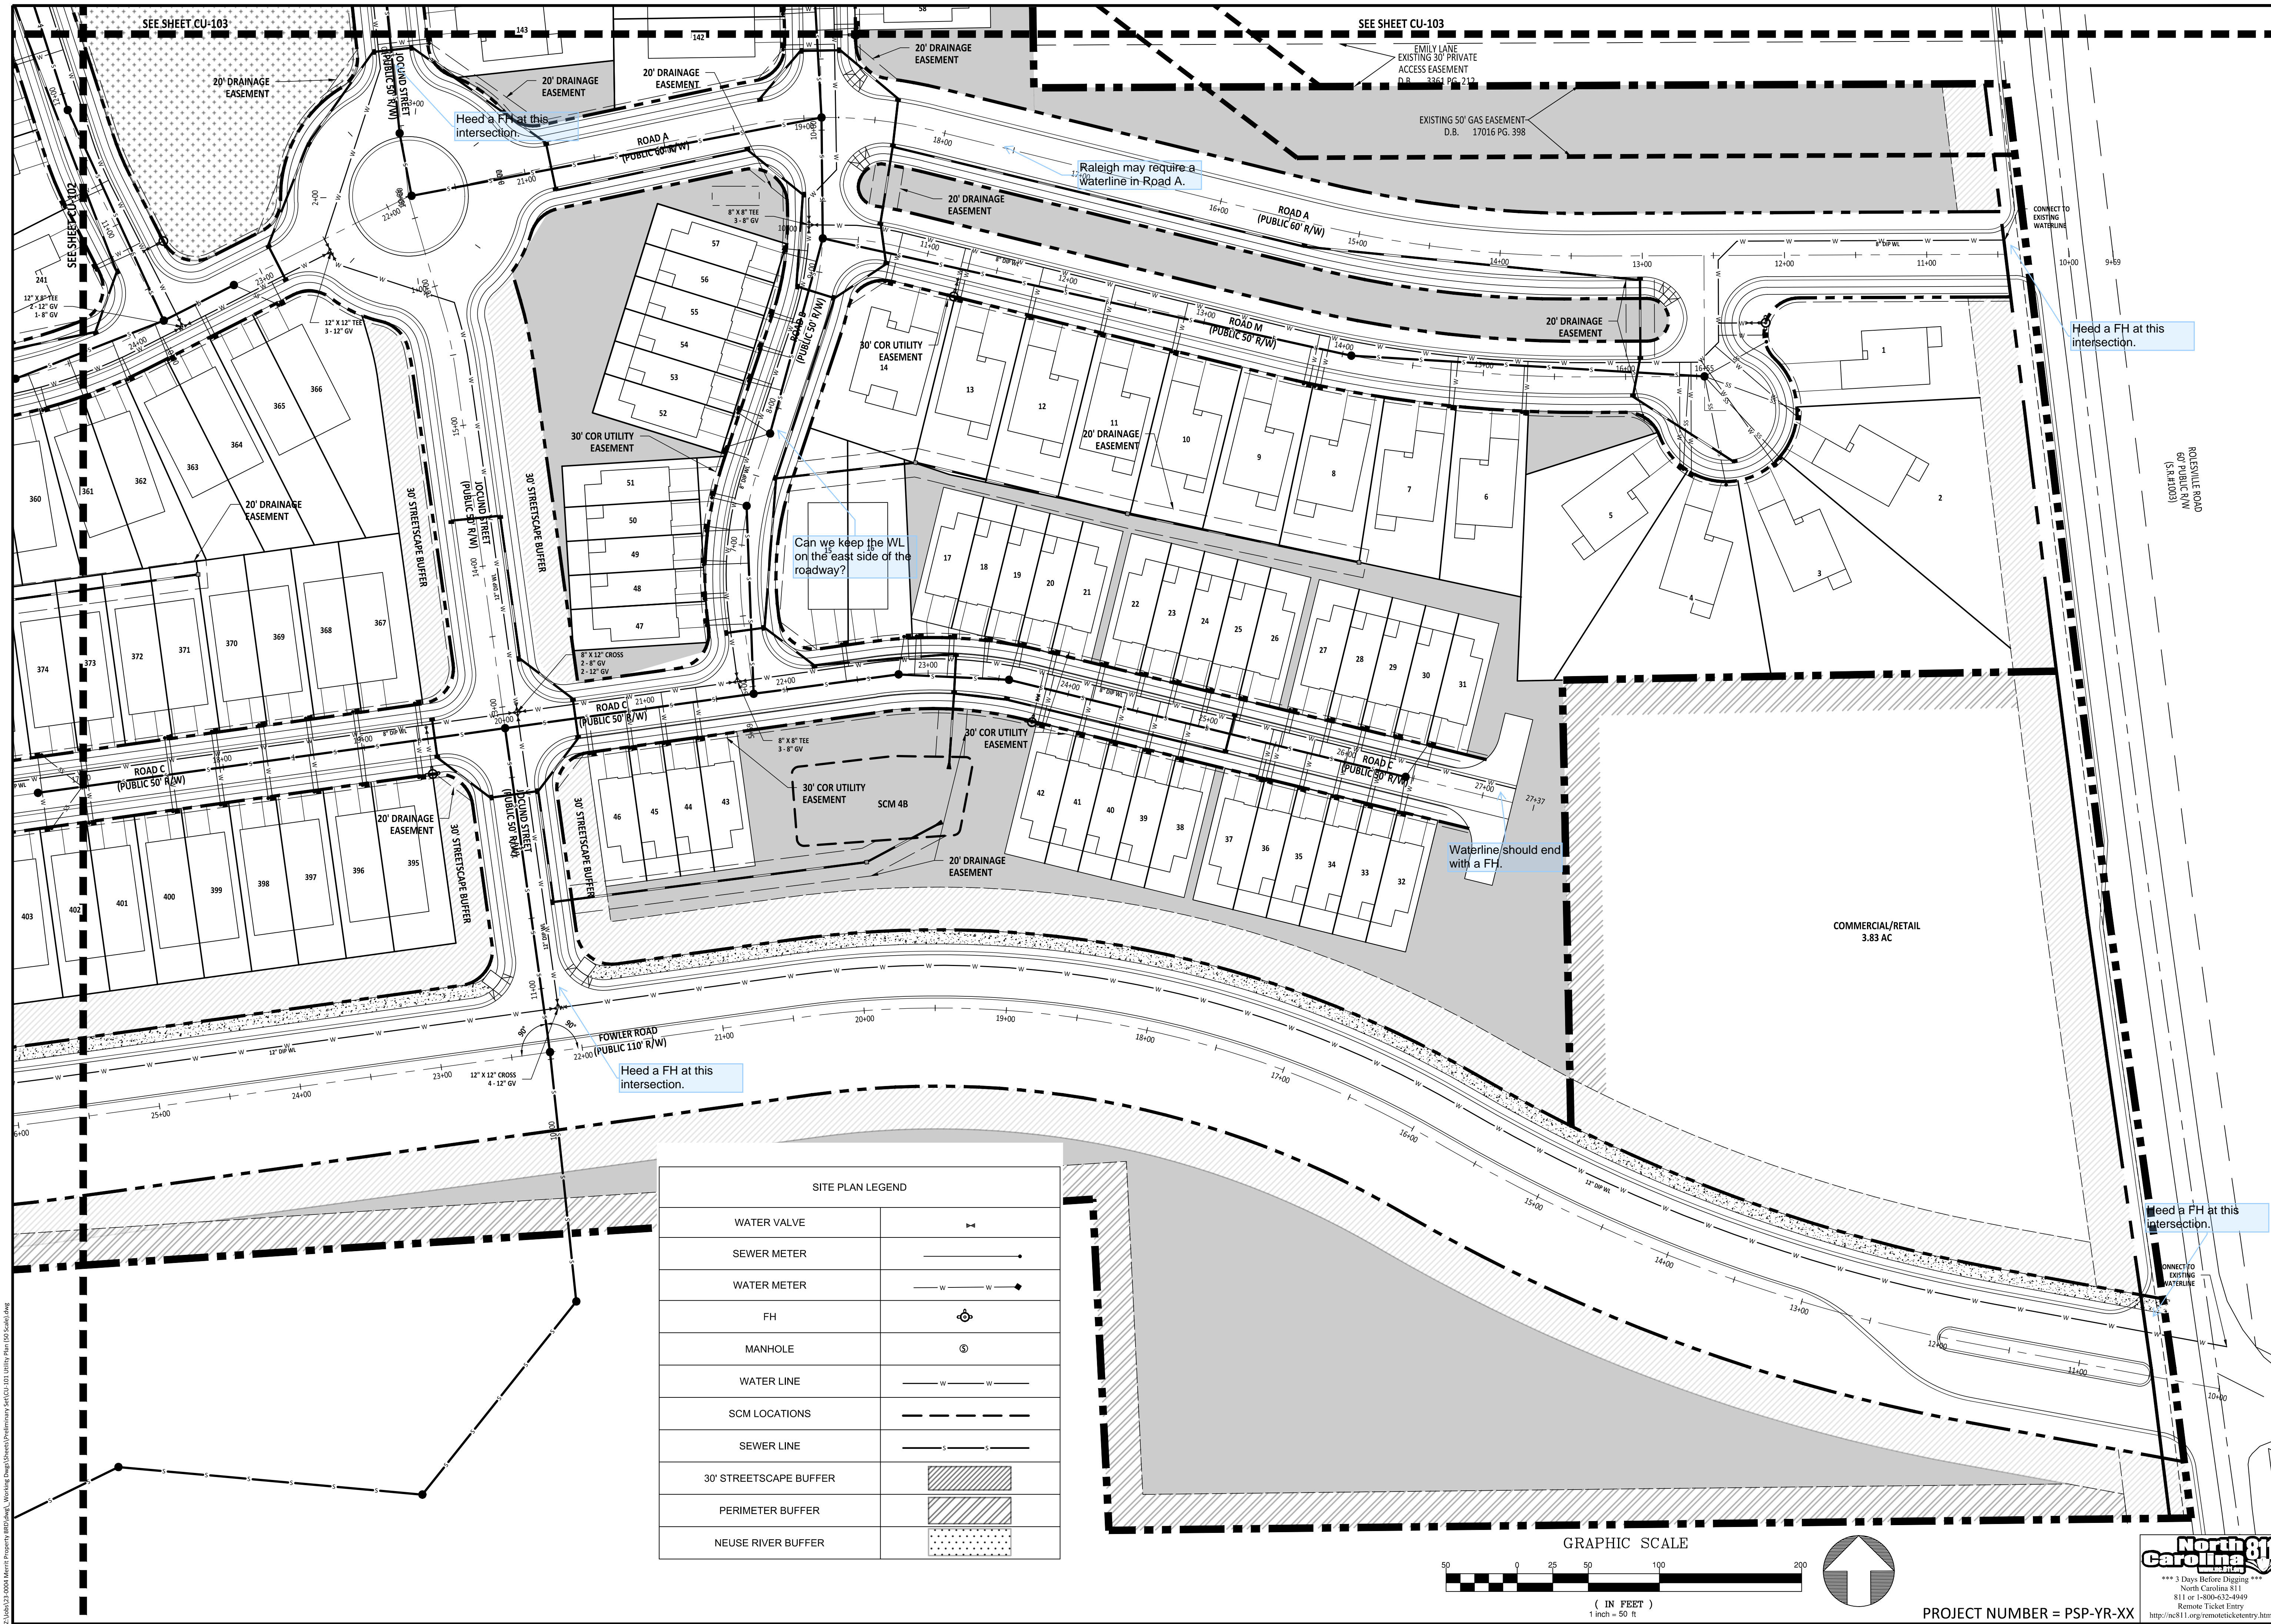


Z:\Projects\23-0004\Merritt Property\88070.dwg, Working Drawings\Sheet\88070.dwg, 10/11/2024 10:11:00 AM, 10/11/2024 10:11:00 AM

SITE PLAN LEGEND	
WATER VALVE	
SEWER METER	
WATER METER	
FH	
MANHOLE	
WATER LINE	
SCM LOCATIONS	
SEWER LINE	
30' STREETSCAPE BUFFER	
PERIMETER BUFFER	
NEUSE RIVER BUFFER	

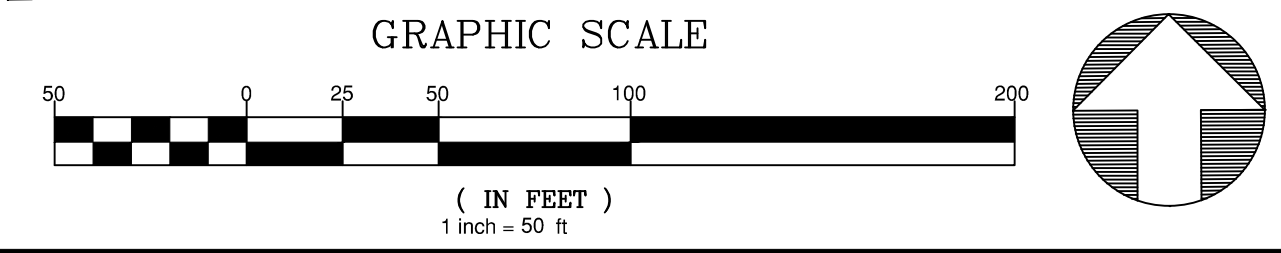

PROJECT NUMBER = PSP-YR-XX

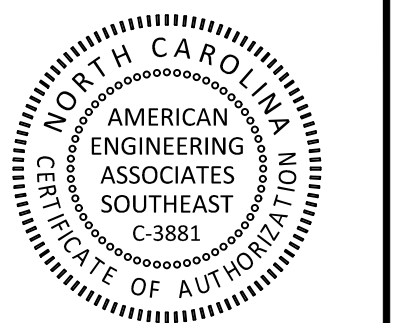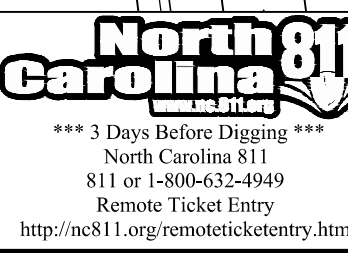

PRELIMINARY

FOR INFORMATION, ONLY

NO.	DATE	REVISION:

STIPULATION FOR REUSE
 THIS DRAWING WAS PREPARED FOR USE ON THE SPECIFIC SITE, NAMED HEREON, CONTEMPORANEOUSLY WITH ITS ISSUE DATE AS LISTED, HEREON, AND IT IS NOT SUITABLE FOR USE ON A DIFFERENT PROJECT SITE OR AT A LATER TIME. USE OF THIS DRAWING FOR REFERENCE OR EXAMPLE ON ANOTHER PROJECT REQUIRES THE SERVICES OF A PROPERLY LICENSED ARCHITECTS AND ENGINEERS. REPRODUCTION OF THIS DRAWING FOR REUSE ON ANOTHER PROJECT IS NOT AUTHORIZED AND MAY BE CONTRARY TO THE LAW.

MERRITT PROPERTY
UTILITY PLAN
(50 SCALE)
 ROLESVILLE RD
 WAKE COUNTY NC 27312

JOB NUMBER: 23-0004
 CHECKED BY: EDS
 DRAWN BY: EDS
 DATE: APRIL 2024
 SHEET TITLE:

UTILITY PLAN
(50 SCALE)

SHEET NO.: **CU-101**

