



SANITARY STRUCTURE SCHEDULE				
STRUCTURE #	RIM	INV IN	INV OUT	DESCRIPTION
A-10	380.00	INV IN = 372.32' (6")		PROP. CONNECTION TO EX. SAN. CLEANOUT
A-20	383.09	INV IN = 375.32' (6")	INV OUT = 375.31' (6")	PROP. 6" SAN. CLEANOUT
A-30	385.52	INV IN = 378.31' (6")	INV OUT = 378.31' (6")	PROP. 6" SAN. CLEANOUT
A-40	386.48	INV IN = 381.45' (6")	INV OUT = 381.45' (6")	PROP. 6" SAN. CLEANOUT
A-50	388.05	INV IN = 383.52' (6")	INV OUT = 383.52' (6")	PROP. 6" SAN. CLEANOUT
A-60			INV OUT = 384.00' (6")	PROP. SANITARY SEWER BUILDING CONNECTION

SANITARY PIPE SCHEDULE							
FROM	FROM INV	TO	TO INV	PIPE LENGTH	SLOPE (%)	DIAMETER (IN.)	MATERIAL
A-10	372.32	A-20	375.31	43'	6.89%	6"	PVC Pipe
A-20	375.32	A-30	378.31	43'	6.89%	6"	PVC Pipe
A-30	378.31	A-40	381.45	46'	6.89%	6"	PVC Pipe
A-40	381.45	A-50	383.52	30'	6.89%	6"	PVC Pipe
A-50	383.52	A-60	384.00	7'	6.86%	6"	PVC Pipe

Please include the Raleigh standard utility notes (CORPUD Handbook Appendix D).

At some point, once design is completed, please email me for the Raleigh Development fees (review fees and stub inspection fees). These fees will need to be paid prior to plan approval.

REVISIONS

REV	DATE	COMMENT	DRAWN BY
1	7/1/24	TRC COMMENTS	CJAC OAK



ALWAYS CALL 811
It's fast. It's free. It's the law.

PERMIT SET

THIS DRAWING IS INTENDED FOR MUNICIPAL AND/OR AGENCY REVIEW AND APPROVAL. IT IS NOT INTENDED AS A CONSTRUCTION DOCUMENT UNLESS INDICATED OTHERWISE.

PROJECT No.: NCB230114.00
DRAWN BY: VLJUE/CC
DATE: 04/23/24
CAD ID.: P-CIVIL-UTIL

PROJECT:


PROP. SITE PLAN DOCUMENTS
FOR



PROPOSED DEVELOPMENT
S MAIN ST & VIRGINIA WATER DR
ROLESVILLE, NC 27587
WAKE COUNTY



BOHLER ENGINEERING NC, PLLC
NCBELS P-1132
4130 PARKLAKE AVENUE, SUITE 200
RALEIGH, NC 27612
Phone: (919) 578-9000
NC@BohlerEng.com

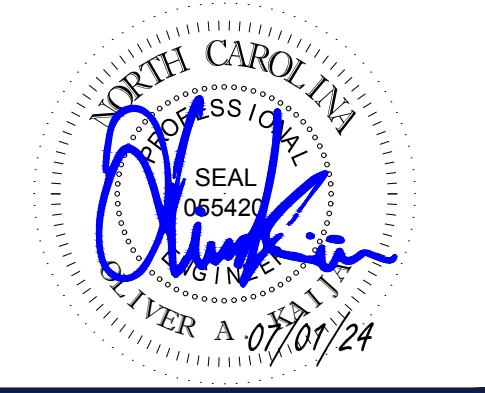


SHEET TITLE:

UTILITY PLAN

SHEET NUMBER:

C-501

REVISION 1 - 7/1/24

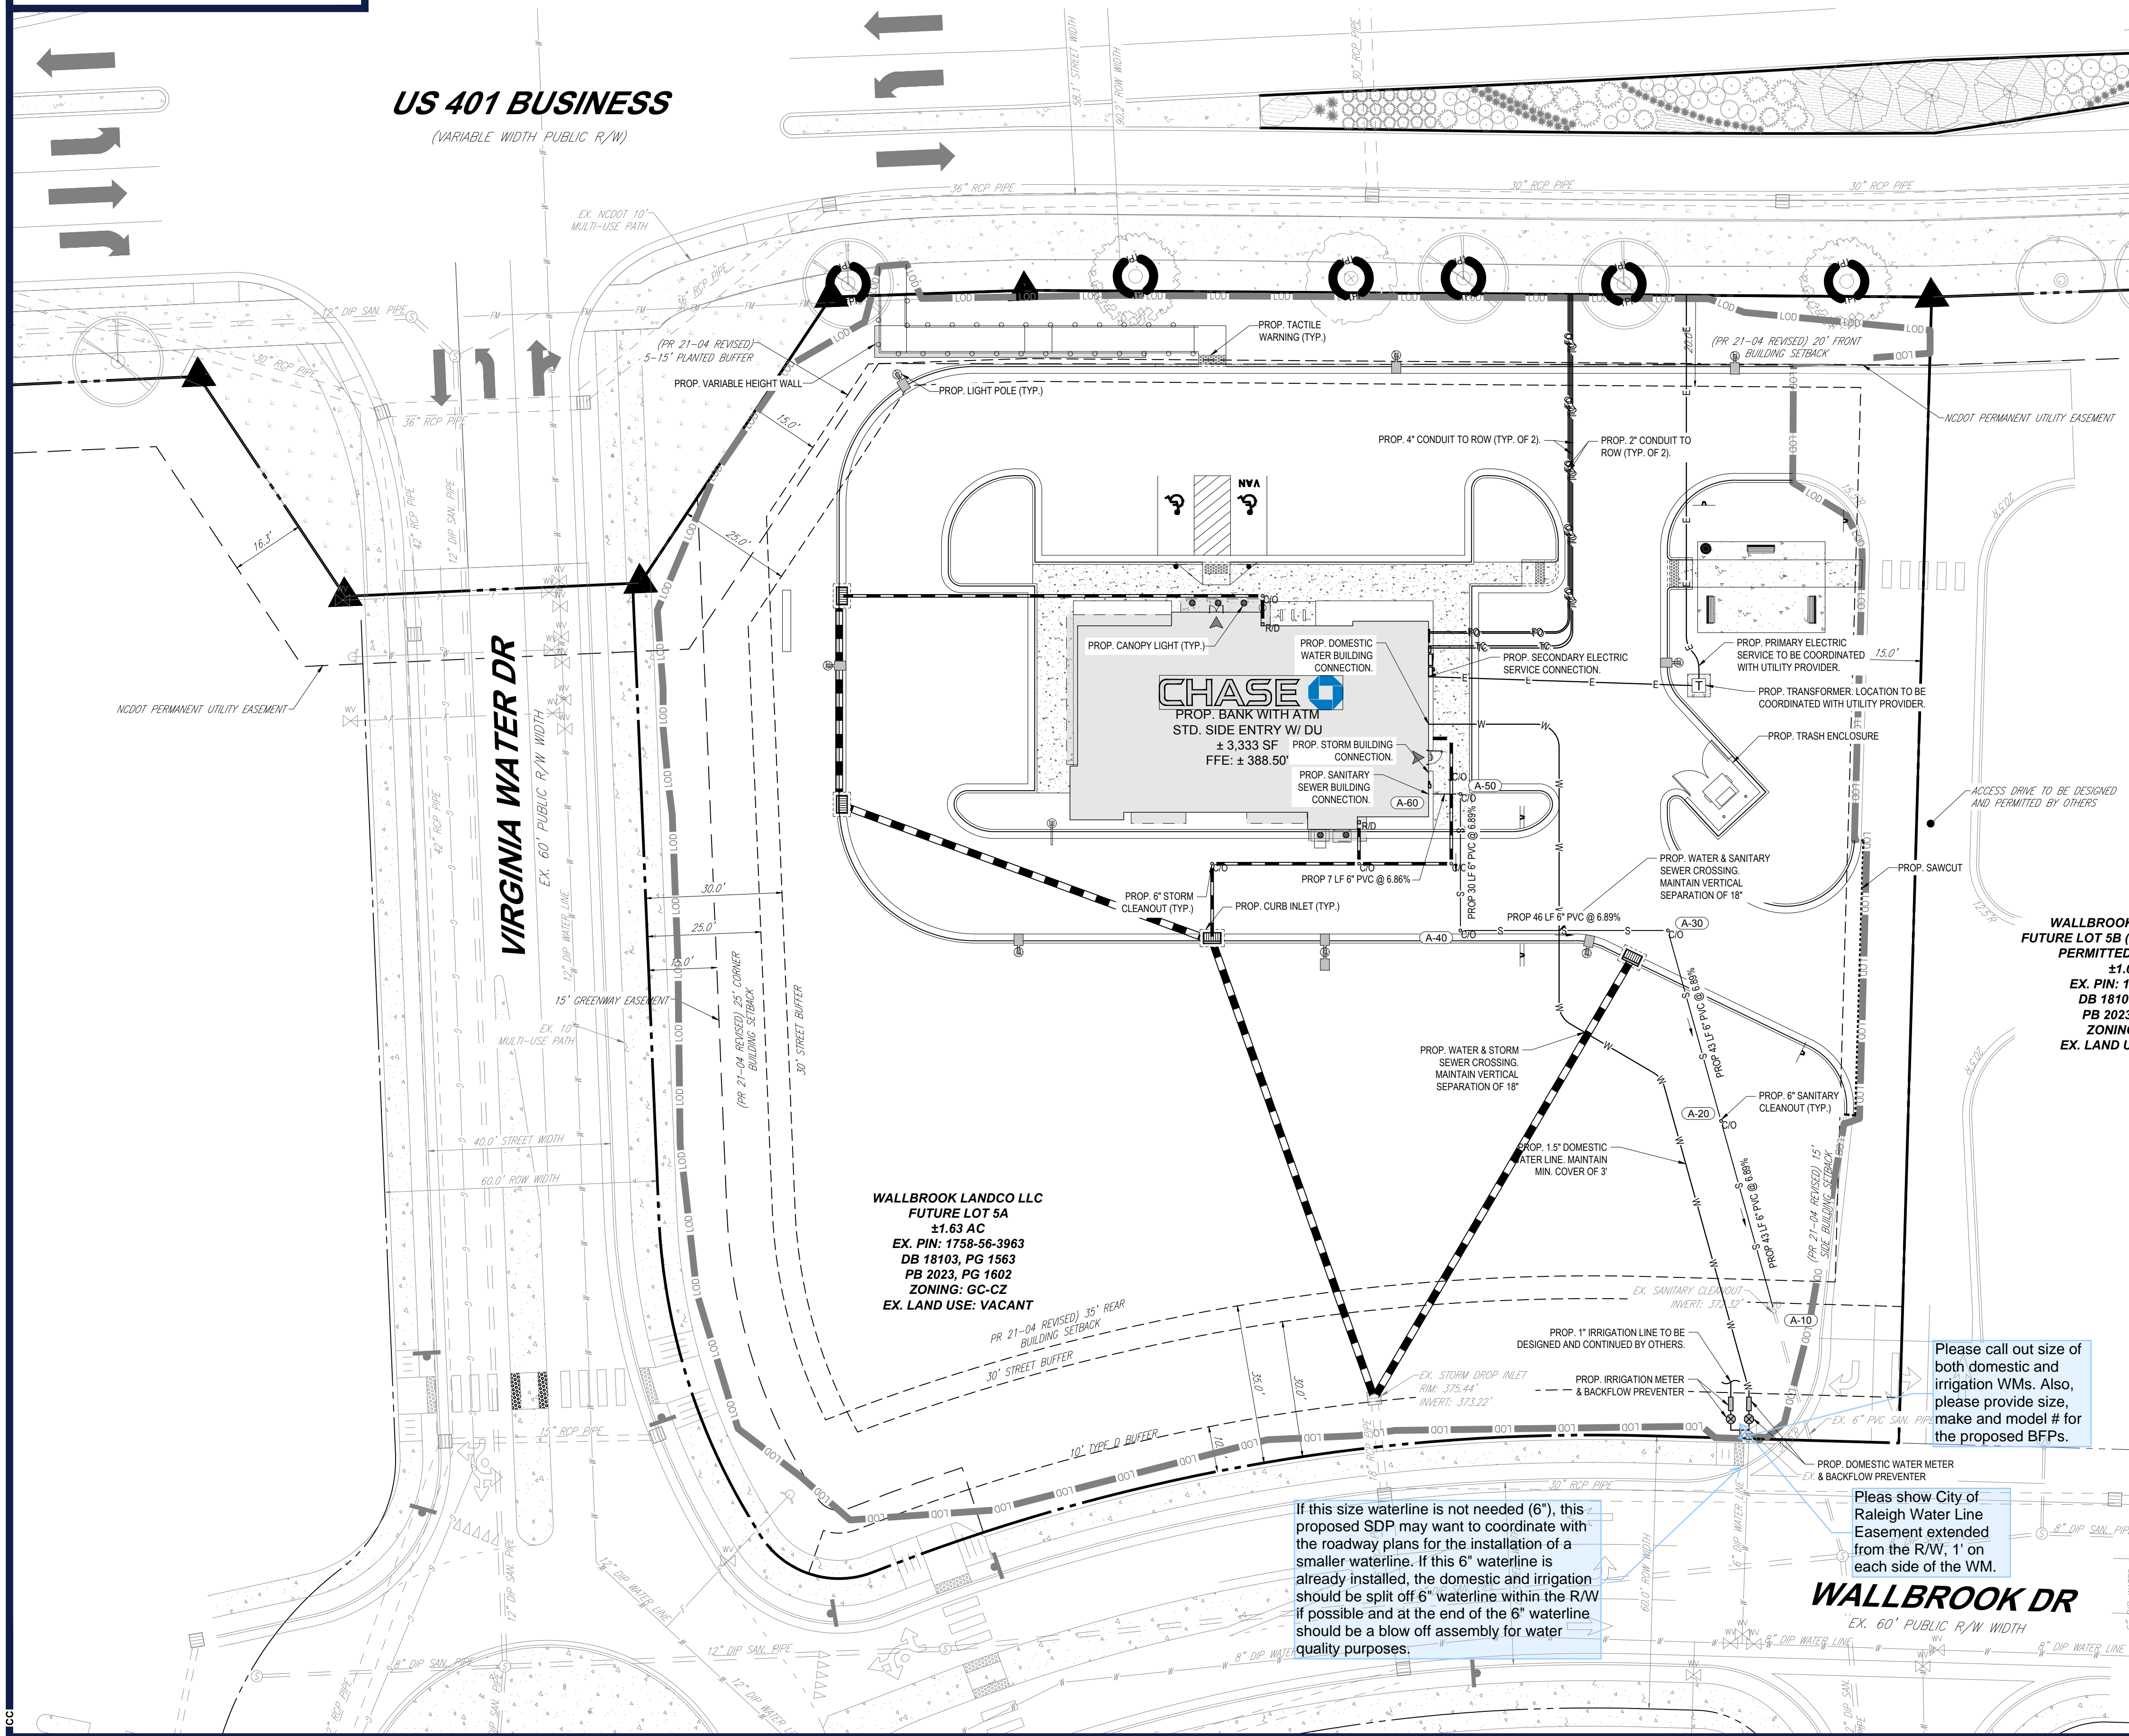

JUL 01, 2024
H:\2023\NCB230114\01.LAND DEVELOPMENT\CAD\DRAWINGS\PLAN SET\SP-CIVIL-UTIL\NCB230114.00-04-...-LAYOUT C-01 UTIL