

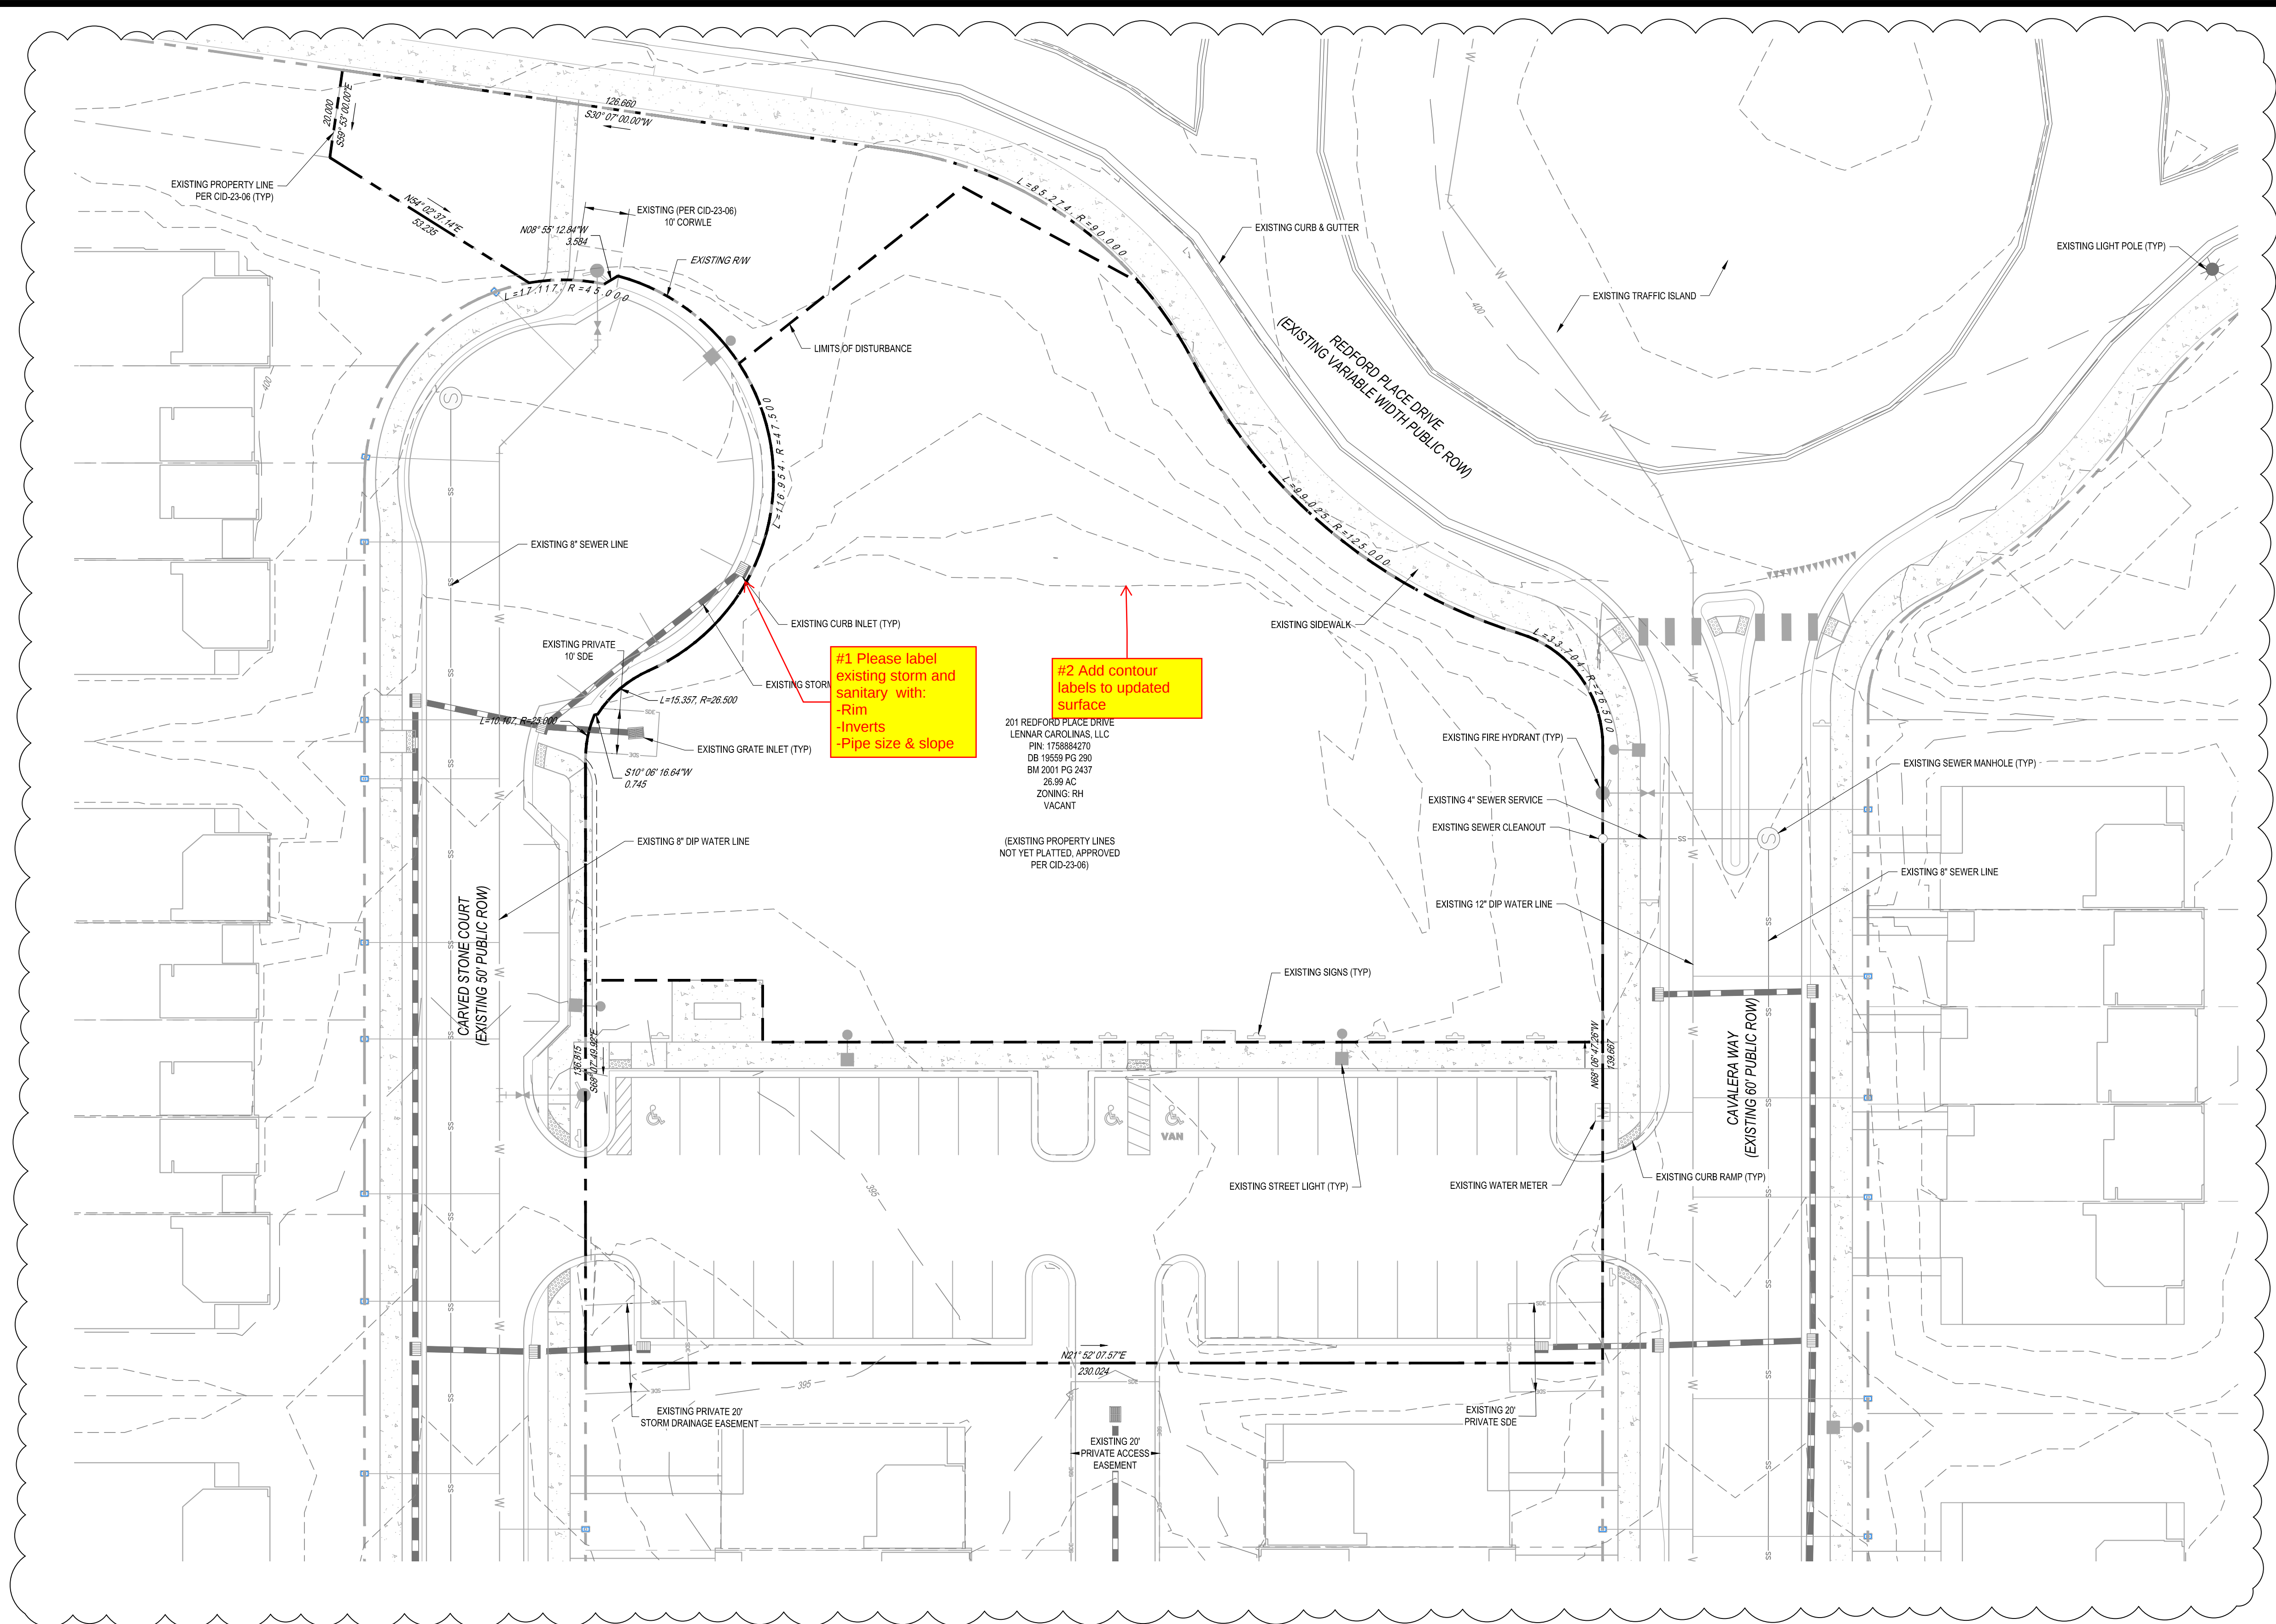


\\bgerinc\data\CA\Projects\Lennar\8430-03 - lennar - school street - rolesville\03 - DWG\plansheets\On-Stel\4-1 AMENITY - EXISTING CONDITIONS PLAN.dwg Layout: L4-1 AMENITY - EXISTING CONDITIONS Plotted: 3/3/2025 11:43:52 AM

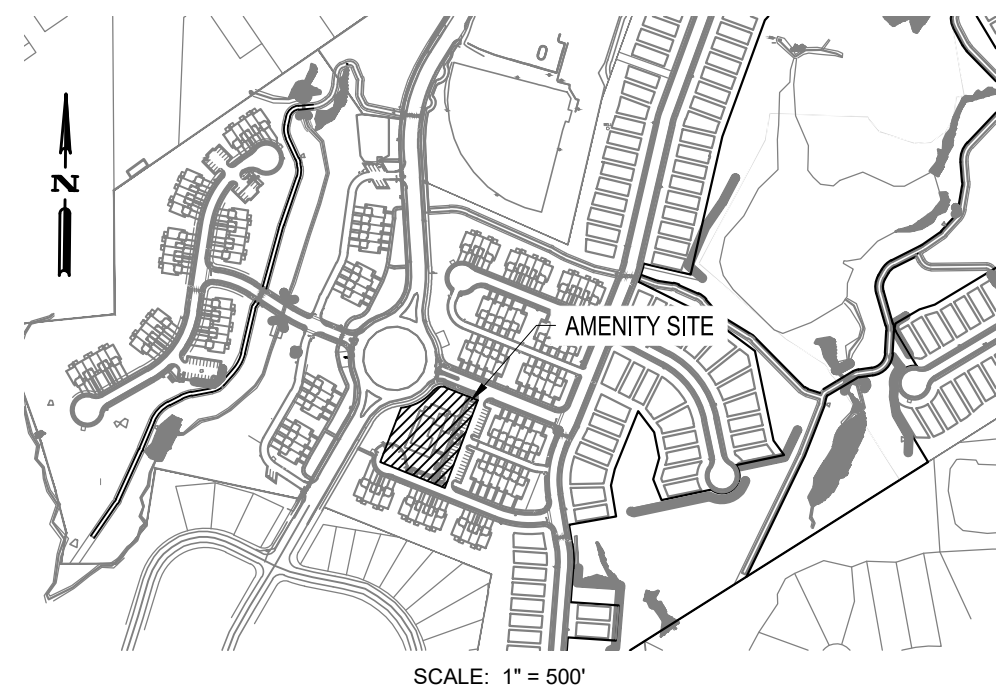

NOTE: METES AND BOUNDS ARE SHOWN FOR REFERENCE ONLY. THIS PLAN IS NOT TO BE USED FOR PLATTING OR RECORDATION.

SITE DEVELOPMENT PLAN
TOWN OF ROLESVILLE CASE NUMBER: SDP-24-10

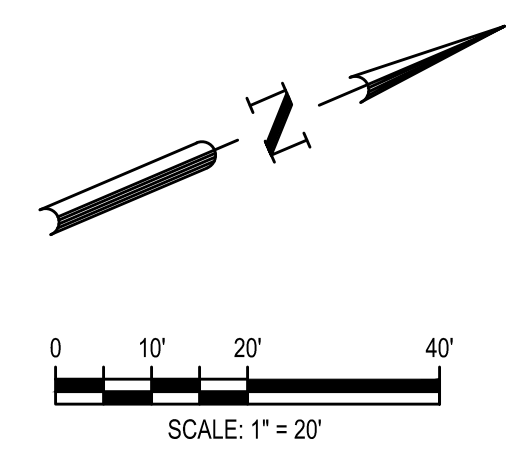

FILE NUMBER:
8430-03
DATE: 03/03/2025

L4-1

PARKER RIDGE
AMENITY CENTER
SDP-24-10
92 SCHOOL STREET
ROLESVILLE / NORTH CAROLINA / 27571

LENNAR
CORPORAION
1100 PERIMETER PARK DRIVE, SUITE 112
MORRISVILLE / NORTH CAROLINA / 27560

BCE
5438 WADE PARK BLVD, SUITE 420
RALEIGH NC 27607
WWW.BCEINC.COM
NC LICENSE #C-4397 ©2023

REV	DATE	DESCRIPTION
△	03/03/2025	PER TOWN OF ROLESVILLE COMMENT
△	01/02/2025	PER TOWN OF ROLESVILLE COMMENT

DESIGNED BY: DF/CD
DRAWN BY: DF/JWM
REVIEWED BY: DF