

LINE TABLE with columns: NAME, ROADWAY, LENGTH, DIRECTION, BEGIN STATION, END STATION. Lists road segments L1 through L29.

LINE TABLE with columns: NAME, ROADWAY, LENGTH, DIRECTION, BEGIN STATION, END STATION. Lists road segments L30 through L58.

CURVE TABLE with columns: NAME, ROADWAY, RADIUS, ARC LENGTH, CHORD LENGTH, CHORD DIRECTION, BEGIN STATION, END STATION. Lists curve details C1 through C25.




LEGEND: Defines symbols for existing property lines, flood lines, signs, roadways, wetlands, flood hazard zones, and other site features.

TOWNHOME NOTES: STATES INTERNAL TOWNHOME DRIVEWAYS ARE PRIVATE EASEMENTS AS PER CITY OF RALEIGH PUBLIC UTILITIES DEPARTMENT

NOTES: SEE COVER SHEET FOR ALL SETBACK REQUIREMENTS SEE SHEET 00000 FOR ADJACENT PROPERTY DETAILS

Table with columns: NAME, ROADWAY, RAD, SREC: This reference has been updated, BEGIN STATION, END STATION. Lists road segments C26 through C30.

GENERAL NOTES: 1. ALL CONSTRUCTION SHALL CONFORM TO... 2. ROADS AND DRIVEWAYS SHALL COMPLY WITH NCDOT... 3. SIGN PERMITS SHALL BE REQUIRED...

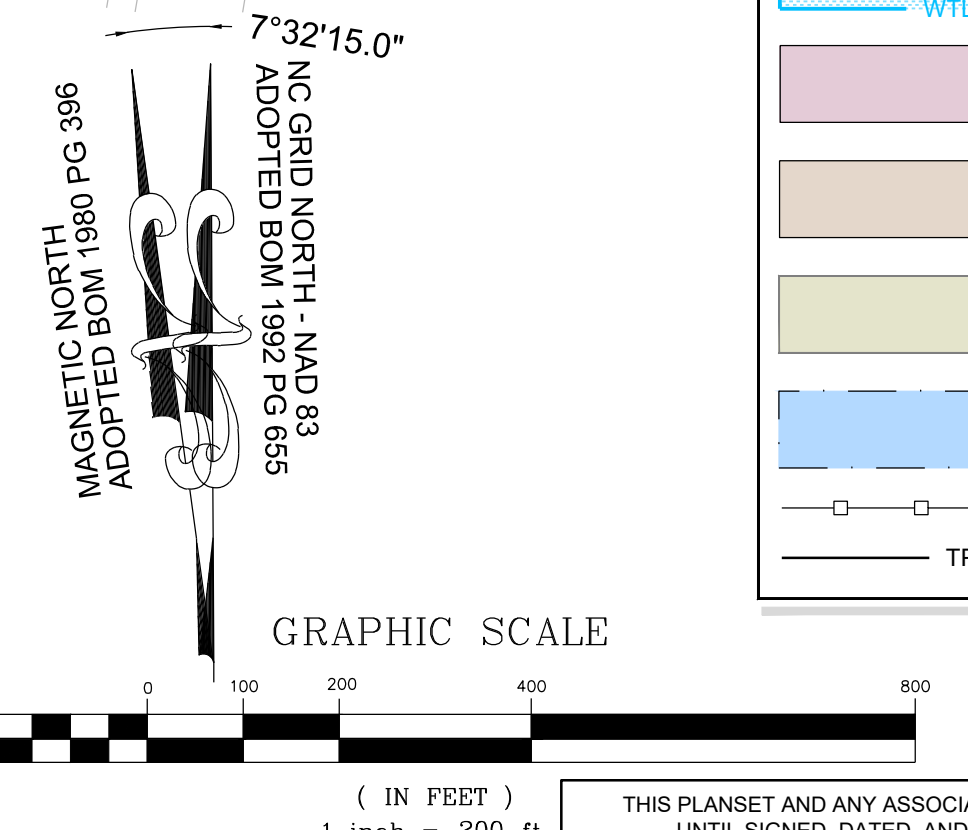




Revision table with columns: No., DATE, REVISIONS. Shows a series of revisions from 01 to 04.

STRONGROCK ENGINEERING GROUP logo and contact information: 305 CHURCH AT NORTH HILLS STREET, SUITE 1110 RALEIGH, NC 27609.

RESERVE @ MITCHELL MILL TOWN OF ROLESVILLE, WAKE COUNTY, NORTH CAROLINA PRELIMINARY SUBDIVISION PLAN OVERALL SITE PLAN DRAWING SHEET C-5.0 16 OF 90

THIS PLANSET AND ANY ASSOCIATED DOCUMENTS ARE PRELIMINARY AND NOT AUTHORIZED FOR CONSTRUCTION UNTIL SIGNED, DATED, AND OFFICIALLY RELEASED FOR CONSTRUCTION BY THE ENGINEER OF RECORD.

**TOWNHOME NOTES:**  
STATES INTERNAL TOWNHOME DRIVEWAYS ARE PRIVATE EASEMENTS AS PER CITY OF RALEIGH PUBLIC UTILITIES DEPARTMENT

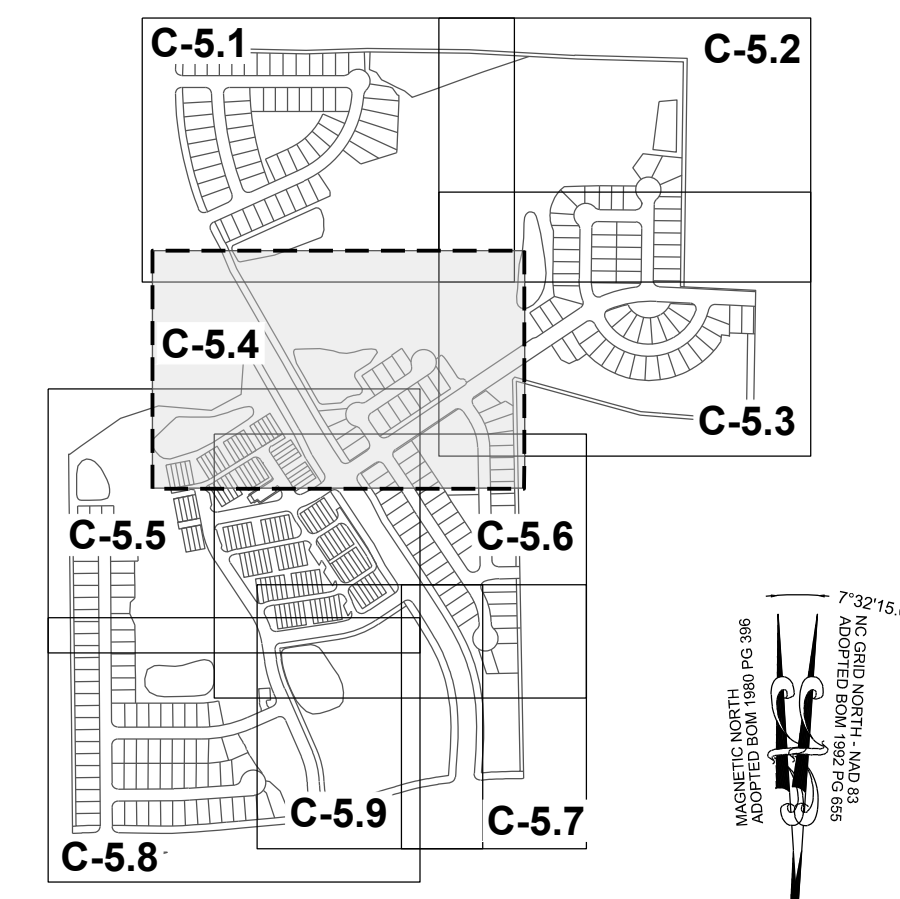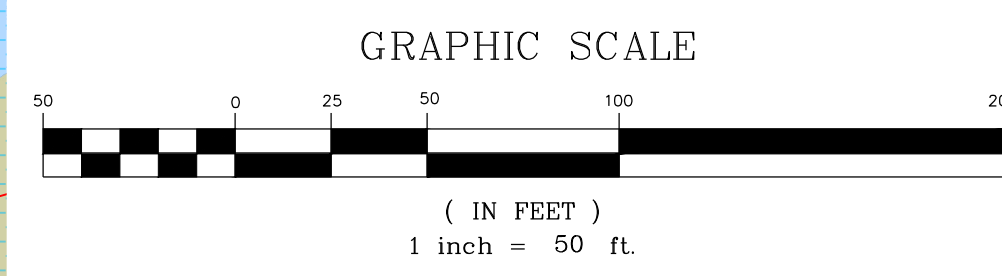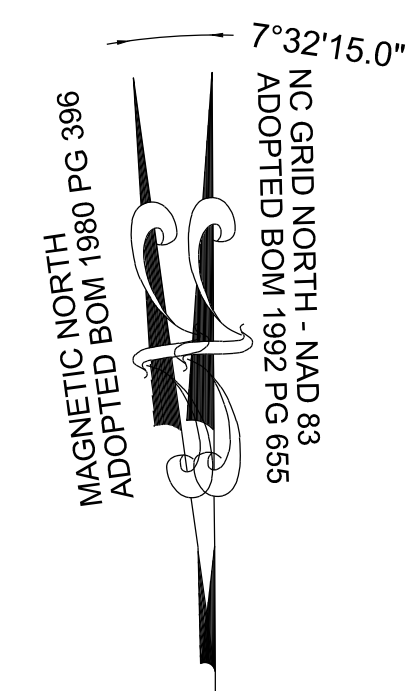

**SITE KEY PLAN**  
**LEGEND:**  
SEE SHEET C-5.0 FOR LEGEND, LINE & CURVE TABLES.


NO.	REVISIONS	DATE	BY
01			
02			
03			
04			

**STRONGROCK ENGINEERING GROUP**  
 STRONG ROCK ENGINEERING GROUP, PLLC | COMPANY LICENSE # P-2166  
 305 CHURCH AT NORTH HILLS STREET, SUITE 1110 RALEIGH, NC 27609 | INFORMATION@STRONGROCKGROUP.COM

STRONG ROCK PROJECT	JWL	JWL
PSP-24-03	SRG	JWL
NOT FOR CONSTRUCTION		
SCALE AS SHOWN		
DESIGNED BY		
DRAWN BY		
CHECKED BY		

RESERVE @ MITCHELL MILL  
TOWN OF ROLESVILLE, WAKE COUNTY, NORTH CAROLINA  
PRELIMINARY SUBDIVISION PLAN  
PARTIAL SITE PLAN IV

DRAWING SHEET  
**C-5.4**

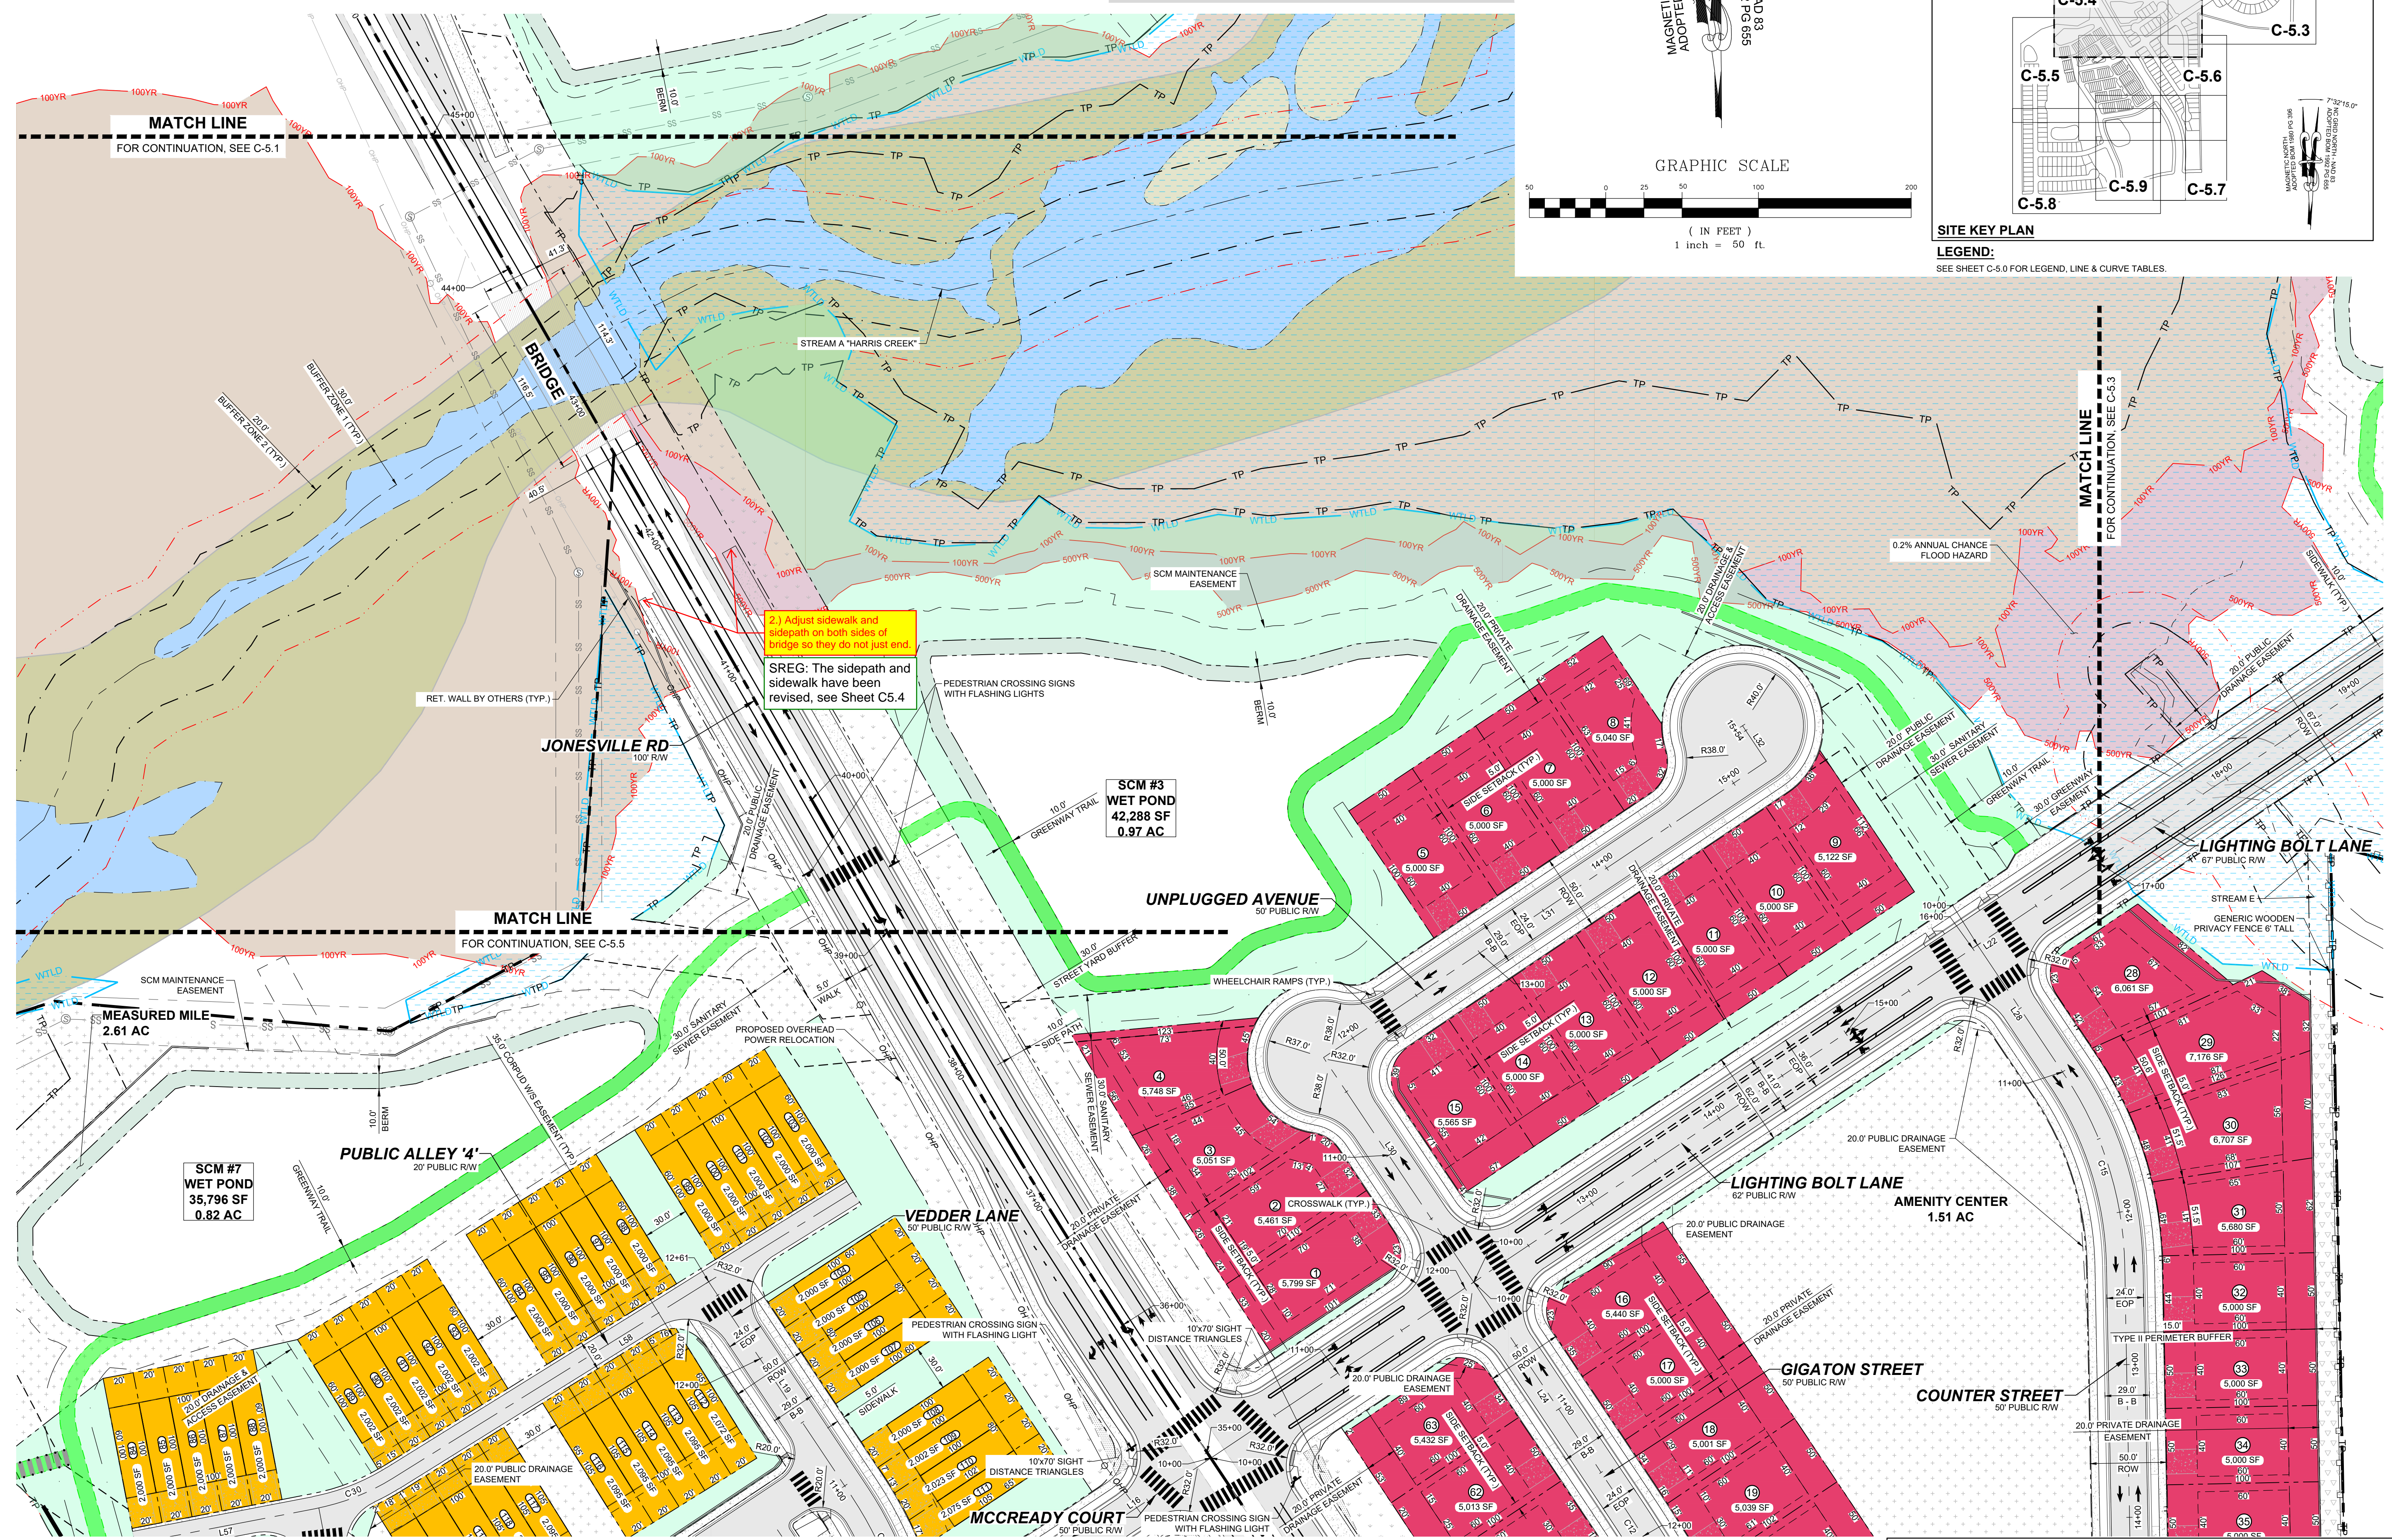

2.) Adjust sidewalk and sidepath on both sides of bridge so they do not just end  
SREG: The sidepath and sidewalk have been revised, see Sheet C5.4

SCM #3  
WET POND  
42,288 SF  
0.97 AC

SCM #7  
WET POND  
35,796 SF  
0.82 AC

THIS PLANSET AND ANY ASSOCIATED DOCUMENTS ARE PRELIMINARY AND NOT AUTHORIZED FOR CONSTRUCTION UNTIL SIGNED, DATED, AND OFFICIALLY RELEASED FOR CONSTRUCTION BY THE ENGINEER OF RECORD.