START DATE: **JUNE 6/5/24**DUE DATE: _07-08-24_ TRC/STAFF Comments issued on: __07/10/2024___

Review Group /Staff		Comments	Cleared Comments
Planning & Zoning — Planning Staff & WithersRavenel	 2. 3. 4. 5. 7. 8. 9.	been changed and to compare versions. Continue to Flatten or "OPTIMIZE" the PDF's when creating (especially the PSP plan set). See PDF Memo from WithersRavenel with 39 written Comments – many are Repeats, some are New based on changes made. NEW – Why were there 2 PDF's submitted, one being a 1 Sheet property survey, the other being a 10-sheet set of drawings termed "topographic exhibit". REPEAT (4 th Time) – Cover Sheet - Remove the references to TA 23-06 – BUILDING SETBACKS (MIN) NC-CZ (EMPLO***——OF TA 23-06) FRONT: 15' SIDE: 16' SITE PERIMETER BUFFER TYPE 2: 15' THOROUGHFARE BUFFER (JONESVILLE & MITCHELL MILL): 30' TOWNHOME SETBACKS NC-CZ (EMPLO**MENT OF TA 23-06) FRONT 20: 20' SIDE (STREET FRONTAGE): 10' RFAR**—20' REPEAT for the 4 th Time - Phasing – Applicant states "Client is still in progress with builders and such a phasing plan; it will not be accepted without Phasing. REPEAT for the 4 th Time - Addresses & Street Names — Contact Wake County GIS/911 to go through the Street Naming process and have Lot Addresses assigned. Every lot – residential, open space, HOA, etc. – should attain an Address. Applicant response did not even broach the lack of Addresses; Street Names are now provided. REPEAT for the 3't Time (Applicants V3 response is about open space calculations on Shts C-6.0 – C-6.3, which is not what this comment is about at all. The V2 Response was "New survey is ordered and in progress) – Cover Sheet/Site Data Table – Site Information / Acreages for the two districts – MA 22-06 Exhibit 2 stated the NC District was	
		54.558 Net Acres and the RM District 84.033 Net Acres. Given this is the Preliminary Subdivision Plat of the land,	

items like the now Right-of-way dedication is determined, and any further fine-tuning of surveying is completed, the acreages of the 2 Districts should not be expressed as (EST), or estimates. Revise to include the actual surveyed acreage of both Zoning Districts. Either add/include the Exhibit 2 from MA 22-06 or add/include a new Survey of the entire subject property that includes the breakdown of the 2 Zoning Districts. Staff suggests adding [accurate/actual Acreages] to current Sheet C-3.0 unless that makes this drawing busier than it already is.

11. REPEAT V2 Comment #14 (AGAIN) – Applicant response is "It is best to share our meeting notes to ensure that they are accurate and agreed upon in the future"; Just comply with the LDO, period. - Response was the clip below; Staff cannot locate the noted Note 8; always tell Staff on what sheet in the plans to find (a revision); also, if going to reference a meeting, include Notes/Minutes of that meeting, not relying on Staff's memory to recall the same that the Applicant recalls. Again, clarify in detail.


plan to go through the Rezoning process so as to take advantage of TA-23-05 for Townhome lot frontage purposes? ****

SREG RESPONSE: See note 8, meeting of Jan 17, 2024 addressed this item. Plans on this submittal reflect the meeting agreement for the townhomes

- 12. REPEAT (AGAIN) Cover Sheet "Commercial Tract (15%)" now says 9.66 ac, but it continues to delineate if this is the MINIMUM or the PROPOSED, which is the crux of the original Comment. NC District acreage is 53.89 x 0.15: 8.08 acres, so 9.66 acres being > 8.08 acres, presumption is 9.66 acres is the "Proposed". Cover Sheet/Site Data Table LDO 3.4.3.D.1. requires an NC District to have a Minimum 15% allocation of gross area for nonresidential uses This expresses 8.18 acres, which calculates as 15% of the expressed 55 AC (Est) This is the minimum requirement, but what is the Proposed amount? Add this and annotate each as "Min. Req./Proposed". It would be appropriate to also cite the LDO for these requirements so it is clear as where they originate (as opposed to something voluntarily committed to via a Zoning Condition for instance).
- 13. <u>REPEAT 3rd Time Unsigned Conditions of Approval</u> Applicant response of "The approved Zoning conditions from the Jan 17 meeting are attached and under separate cover the signed conditions will be sent to the town."
 - Sheet C-1.1 there continue to be no signatures.
 - V4 submittal did not contain any "attached" Conditions of Approval from the January 17th mtg -?
 - To date, the Town has not received signed Conditions under separate cover -?
- 14. <u>REPEAT for 3rd Time -- Sheet C-</u>5.0 through C-5.9 Every Lot shall be labeled Block and Lot including all non-residential lots. Applicant response: "This is still in progress and will appear on later CD Drawings." NO Blocks and Lots is basic and primary Preliminary Subdivision information DO NOT RESUBMIT without providing Blocks and Lot numbering.
- 15. <u>REPEAT AGAIN Addresses are still not present on Plans</u> Addresses are a basic subdivision component; Street names were attained, which means Wake Co GIS/911 can assign addresses. Addresses get officially created upon

Final Plat recordation. The LDO is silent on this facet because it is so basic an item; Staff will perform a Text Amendment to make LDO require Lot Addresses at time of Preliminary Subdivision Plat.

16. <u>REPEAT</u> — Cover Sheets/Site Information/ - the Perimeter Buffer and Thoroughfare Buffer is still immediately below the Front, Side, Rear Building setback information — Comment was to detach these Overall and Perimeter subdivision standards from those that apply to each and every residential lot — Applicant response is "Cover sheet Revised' — yet Cover sheet is unchanged. See the clip below, part of the original (V3) comment.

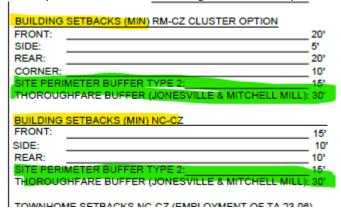

- 17. REPEAT Cover Sheet/"Site Information" Table / Impervious Areas Applicant response: Cover Sheet revise. The "Total On-Site Impervious Area" was revised from 8.47 acres to 9.62 acres saying that within the entire 53.88 acre NC-CZ District, building ALL the houses, all the driveways, all the streets, and all the non-residential development in the ~8 acre non-residential tract that all that development will only comprise 9.62 of the 53.88 acres??? Again, is Staff completely misinterpreting this information?
- 18. REPEAT The sheet of "Civil Notes" is still in this plan set; V3 is the 4th sheet, now V4 is the 3rd sheet Applicant response: Cover Sheet revised. Staff see's no revision and again asks, these are all about actual construction, and this is Preliminary Subdivision so should they not be removed and include in CID plan set, which is a constructable plan set; PSP is not a constructable plan set. Revise Cover Sheet Sheet index accordingly.

Parks & Recreation -Eddie Henderson The routing of the Greenway is <u>significantly less desirable</u> compared to the previous (V2) version, now being rerouted to the home side of three additional stormwater ponds and no longer following the wetlands in these areas. Additionally, there are several sections of Greenway that are no longer present (Deleted) – WHY?. Please provide a written response to explain these changes or revise the Greenway to show how it was (Previously in V2). The previous response to staff's comment referencing a catastrophic storm event that may wash out a greenway is <u>not a sufficient reason</u> for the undesirable Greenway routing. Reminder: The Town is responsible for perpetual maintenance of the public Greenways; this is all taken into account at these location discussions/approvals. Greenways need to be not

	<u>directly</u> adjacent to homes wherever possible (a Town decision). Provide a response as to why the other sections of Greenway were removed.	
Engineering - Brian Laux / Jacqu Thompson	See Two (2) PDF's of: (1.) Memo written comments – there are just 2 on the PSP, and list for future CID plans. (2.) Mark-up comments on Part 1 PSP Plan set Sheets C-5.0 and C-5.4 only.	
COR Public Utilitie Tim Beasley	See PDF of mark-ups – there are 18 entries/comments.	
Wake Co Watersh Mgmnt - Janet Bo	,	TBD
Wake County Fire EMS - Brittany Hocutt	 ALLEYS WHERE HOUSES ARE TO BE ADDRESSED SHALL HAVE A NAME. ALLEYS SHALL HAVE THE SAME WEIGHT RATING AS MAIN ROADS TO SUPPORT LOADS OF FIRE TRUCKS THAT ARE THE PRIMARY ACCESS TO HOUSES- MINIMUM 80K POUNDS. ALLEYS SHALL BE 20 FT WIDE AS THEY ARE THE PRIMARY ACCESS TO HOUSES. 	
NCDOT – Jacob Nicholson	No further comments on the preliminary plat at this time.	>