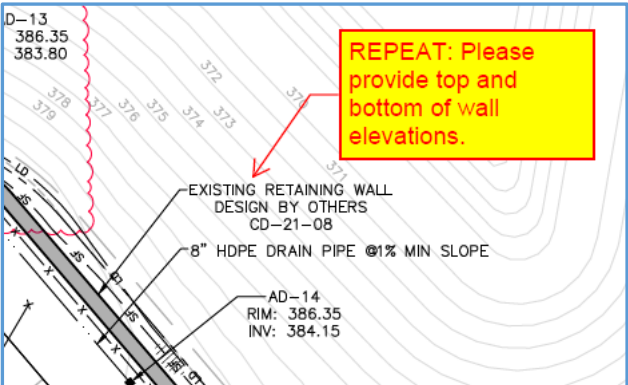


SDP-24-06 – ROLESVILLE CROSSING AMENITY CENTER – V3 Submittal review cycle

START DATE: DECEMBER 2024	DUE DATE: 01-06-25 __	TRC/STAFF Comments issued on: _12/22/2025_
----------------------------------	------------------------------	---

Review Group / Staff	Comments	Cleared Comments
Planning & Zoning – Planning Staff	<ol style="list-style-type: none"> 1. <i>Continue to</i> Provide a Written Response to ALL comments. 2. <i>Continue to</i> Add revision dates to all submittal materials. 3. <i>Continue to</i> Cloud/bubble all changes in the plan set. 4. Address any other reviewers comments. 	
Engineering - Jacque Thompson	<p>Add top and bottom of wall elevations to the grading plan – see this clip from C3.00. Confirmation of this revision can be accomplished on the Signature Set submittal, not requiring a full TRC resubmittal unto itself.</p> 	
Wake Co Watershed Management – *Kevin Zelaya*	V3 – No comments received; based on Applicants response that Erosion Control plans have been submitted – but perhaps NOT YET approved – the Wake County review remains outstanding. Contact new representatives Kevin Zelaya kevin.zelaya@wake.gov and Alexander Geddie alexander.geddie@wake.gov to gauge their reviews and ability to sign this SDP.	
COR Public Utilities - Tim Beasley	No comments/Approved for Signature.	✓
Wake County Fire / EMS - Brittany Hocutt	<i>No further Comments.</i>	✓
NCDOT – Jacob Nicholson	<i>No comments expected.</i>	NA
Parks & Recreation - Eddie Henderson	<i>There are no comments.</i>	✓