


SEE SHEET C2.01

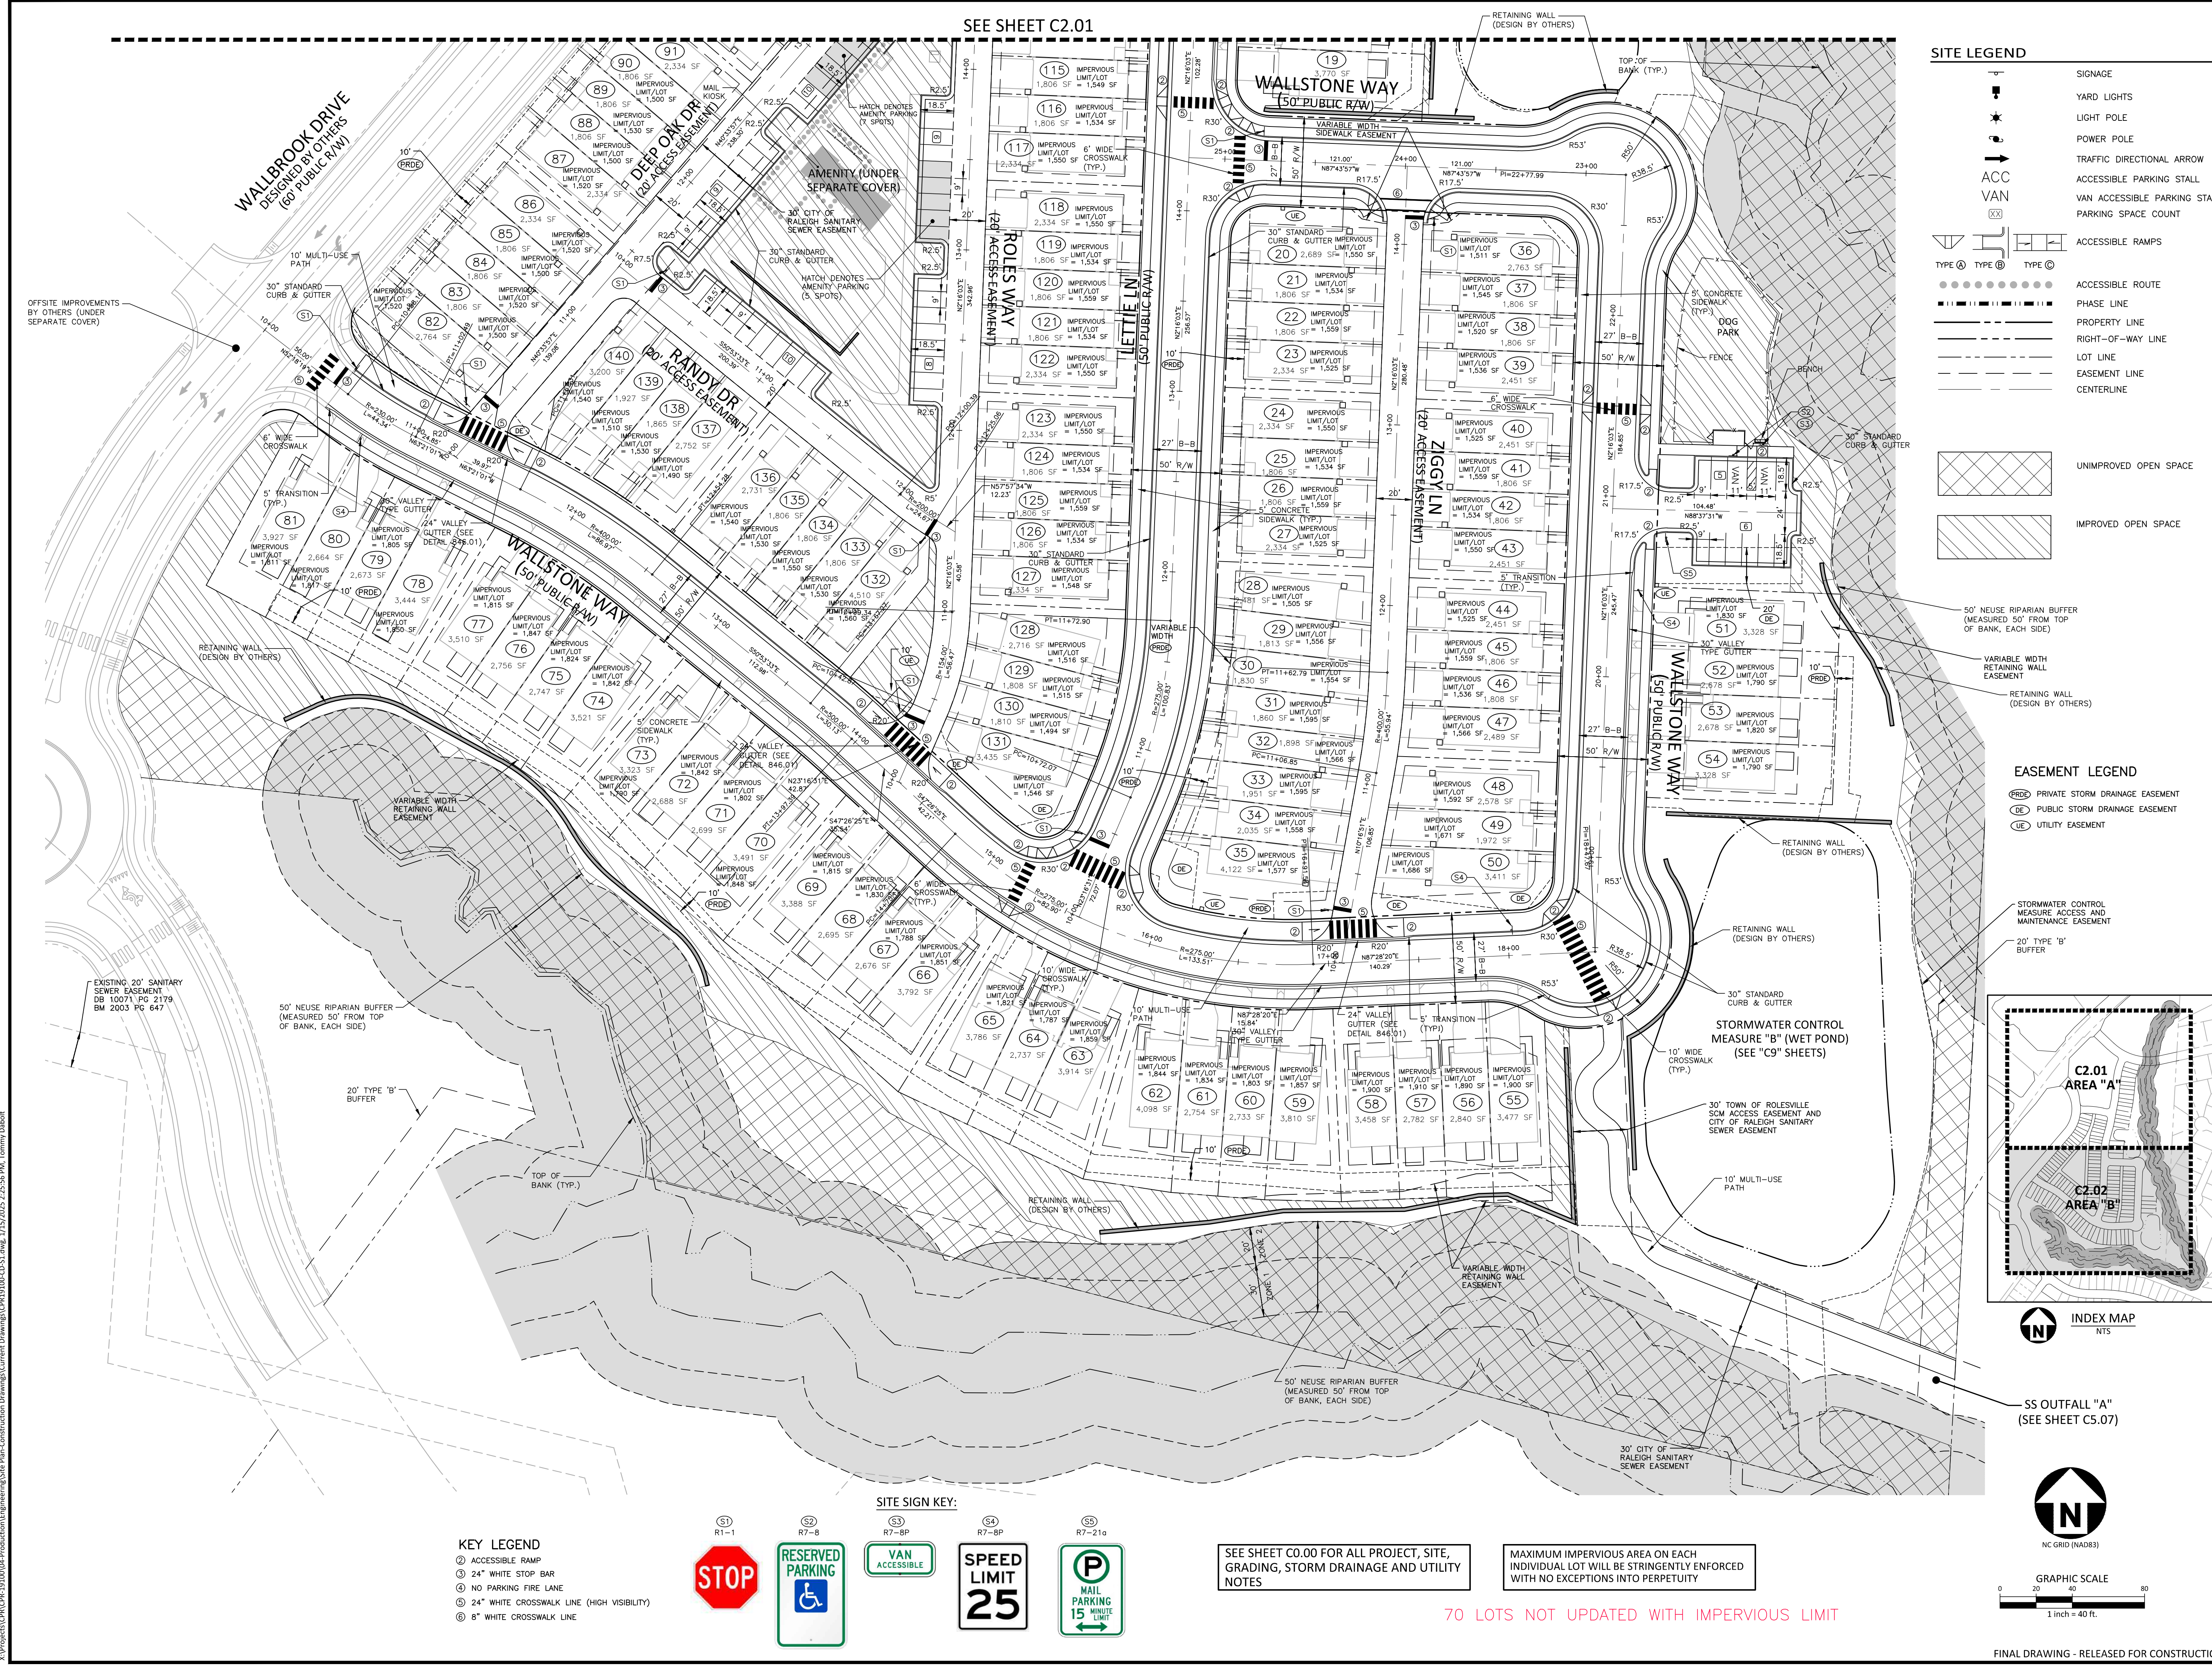

- SITE LEGEND**
- Signage
 - Yard Lights
 - Light Pole
 - Power Pole
 - Traffic Directional Arrow
 - Accessible Parking Stall
 - Van Accessible Parking Stall
 - Parking Space Count
 - Accessible Ramps
 - Accessible Route
 - Phase Line
 - Property Line
 - Right-of-Way Line
 - Lot Line
 - Easement Line
 - Centerline

- EASEMENT LEGEND**
- Private Storm Drainage Easement
 - Public Storm Drainage Easement
 - Utility Easement

- KEY LEGEND**
- Accessible Ramp
 - 24" White Stop Bar
 - No Parking Fire Lane
 - 24" White Crosswalk Line (High Visibility)
 - 8" White Crosswalk Line


- INDEX MAP**
- NTS
- SS Outfall "A" (See Sheet C5.07)
- GRAPHIC SCALE
- 1 inch = 40 ft.

McADAMS

The John R. McAdams Company, Inc.
621 Hillsborough Street
Suite 500
Raleigh, NC 27603
phone 919. 361. 5000
fax 919. 361. 2269
license number: C-0293, C-187
www.mcadamsco.com

WALLBROOK LANDCO, LLC
3 KEEL STREET, SUITE 2
WRIGHTSVILLE BEACH, NORTH CAROLINA
28480-1709

WALLBROOK
CONSTRUCTION DRAWINGS
ROLESVILLE, NORTH CAROLINA

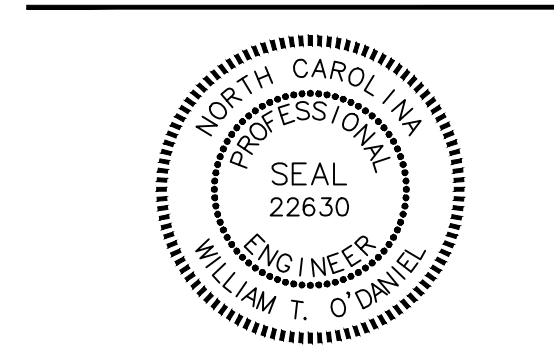

REVISIONS

NO.	DATE	REVISION
1	11.02.2023	EW-400 REVISION
2	05.10.2024	UPDATING SCM B GRADING AND SCM A OUTLET
3	06.06.2024	SEWER MANHOLE REVISIONS
4	08.30.2024	UPDATED BUILDING FOOTPRINTS AND IMPERVIOUS AREA
5	10.28.2024	ADDED WALL DRAIN DETAIL
6	01.15.2025	LOT MAX. IMPERVIOUS AREA UPDATE

PLAN INFORMATION

PROJECT NO.	CPR-19100
FILENAME	CPR19100-CD-S1
CHECKED BY	WTO
DRAWN BY	JMS
SCALE	1"=40'
DATE	05.22.2023

SITE PLAN - AREA "B"

C2.02

FINAL DRAWING - RELEASED FOR CONSTRUCTION