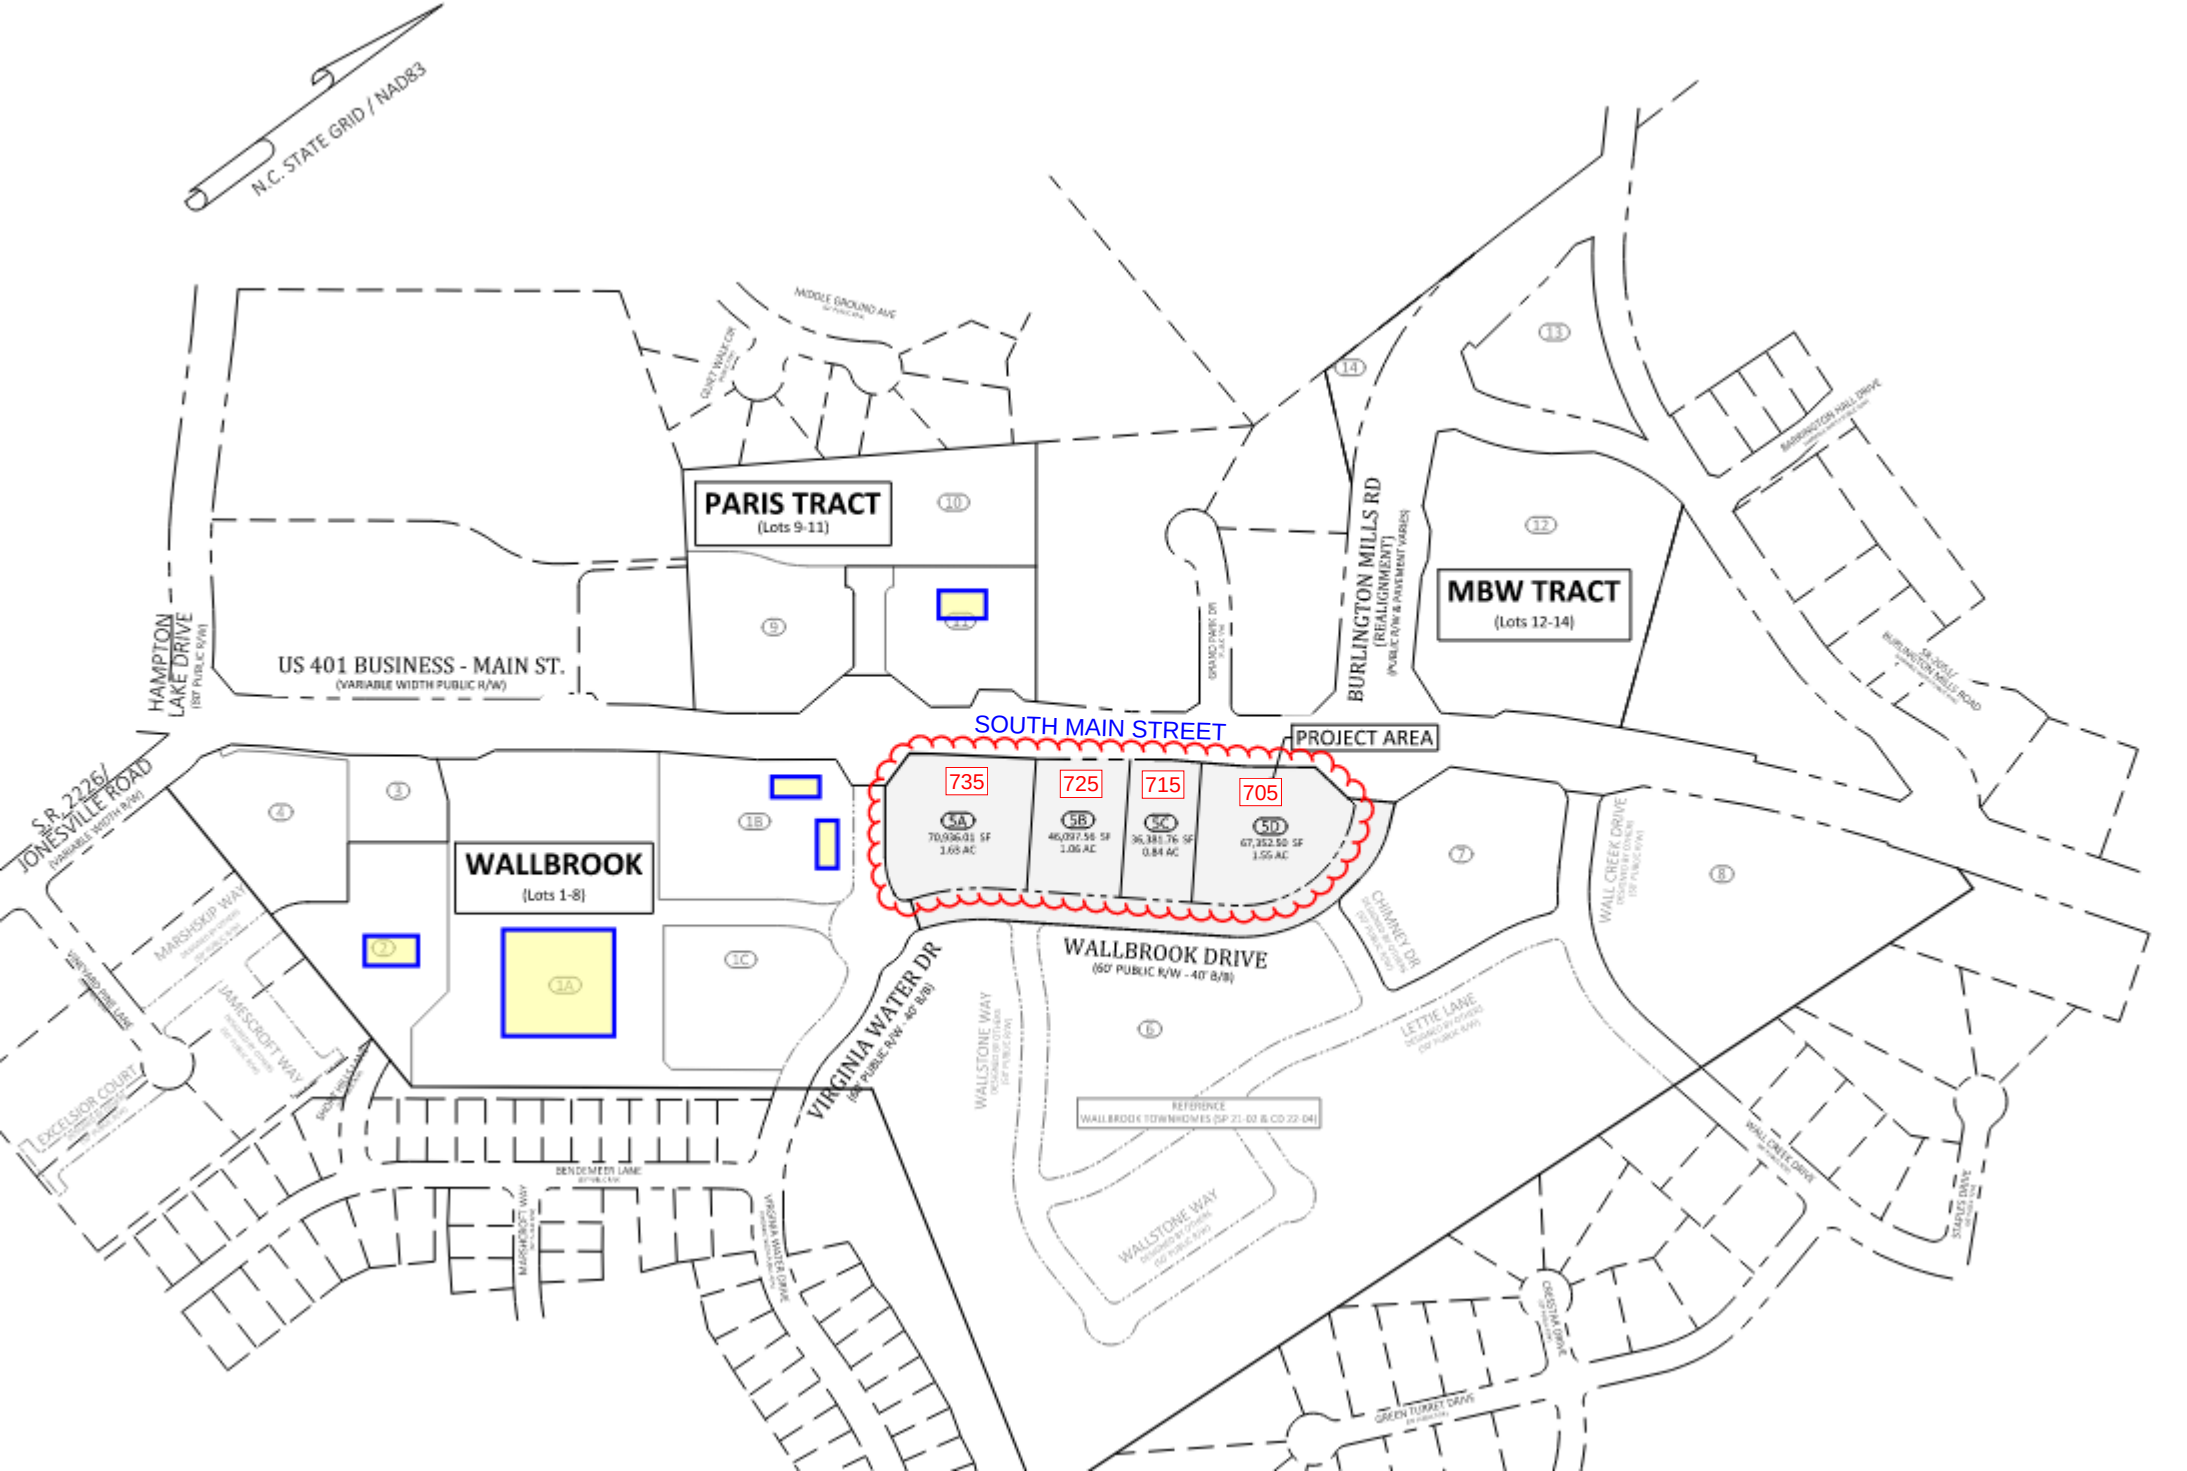

N.C. STATE GRID / NAD83
PARIS TRACT
(Lots 9-11)
MBW TRACT
(Lots 12-14)
US 401 BUSINESS - MAIN ST.
(VARIABLE WIDTH PUBLIC R/W)
HAMPTON LAKE DRIVE
(80' PUBLIC R/W)
BURLINGTON MILLS RD
(REALIGNMENT)
(PUBLIC R/W & PAVEMENT VARIES)
SOUTH MAIN STREET
PROJECT AREA
735
725
715
705
5A
70,936.01 SF
1.63 AC
5B
46,097.56 SF
1.06 AC
5C
36,381.76 SF
0.84 AC
5D
67,352.50 SF
1.55 AC
WALLBROOK
(Lots 1-8)
S.R. 2226/
JONESVILLE ROAD
(VARIABLE WIDTH R/W)
WALLBROOK DRIVE
(60' PUBLIC R/W - 40' B/B)
VIRGINIA WATER DR
(60' PUBLIC R/W - 40' B/B)
WALLSTONE WAY
CHIMNEY DR
LETTIE LANE
WALL CREEK DRIVE
MARSHSKIP WAY
JAMESCROFT WAY
EXCELSIOR COURT
BENDEMEER LANE
MARSHCROFT WAY
VIRGINIA WATER DRIVE
GREEN TURKEY DRIVE
CRESTAN DRIVE
STAPLES DRIVE
BARRINGTON HALL DRIVE
MIDDLE GROUND AVE
GRAND PARK DR
REFERENCE
WALLBROOK TOWNHOMES (SP 21-02 & CD 22-04)