

CONSTRUCTION INFRASTRUCTURE DRAWINGS

PARKER RIDGE

82 SCHOOL STREET  
ROLESVILLE, NORTH CAROLINA 27571

| SITE DATA TABLE                                                |                                                       |           |
|----------------------------------------------------------------|-------------------------------------------------------|-----------|
| OWNER                                                          | W. HAROLD PARKER JR. /<br>ROLESVILLE DEVELOPMENT, LLC |           |
| DEVELOPER                                                      | LENNAR OF CAROLINAS, LLC                              |           |
| PIN #                                                          | AREA (SF)                                             | AREA (AC) |
| 1758988411                                                     | 2,592,300                                             | 59.51     |
| 1758983710                                                     | 17,121                                                | 0.39      |
| 1758884270 E                                                   | 310,215                                               | 7.12      |
| 1758884270 W                                                   | 865,243                                               | 19.86     |
| GROSS AREA                                                     | 3,784,879                                             | 86.89     |
| PARCEL A - PARK EXPANSION AREA                                 | 65,340                                                | 1.50      |
| NET AREA                                                       | 3,719,539                                             | 85.39     |
| IMPERVIOUS EXISTING                                            | 2,885                                                 | 0.07      |
| IMPERVIOUS PROPOSED                                            | 1,819,937                                             | 41.78     |
| PREVIOUS ZONING                                                | RL                                                    |           |
| USE                                                            | VACANT / AG                                           |           |
| FUTURE LAND USE DESIGNATION<br>(ROLESVILLE COMP PLAN)          | HDR                                                   |           |
| CURRENT ZONING                                                 | RH/RM CLUSTER CONDITIONAL                             |           |
| PROPOSED USE                                                   | RESIDENTIAL                                           |           |
| SETBACKS MINIMUM RM (CLUSTER) SINGLE-FAMILY DETACHED           |                                                       |           |
| FRONT                                                          | 20'                                                   |           |
| SIDE                                                           | 5'                                                    |           |
| CORNER SIDE                                                    | 10'                                                   |           |
| REAR                                                           | 20'                                                   |           |
| MIN FRONT LOT WIDTH                                            | 40'                                                   |           |
| MIN LOT AREA                                                   | 5,000 SF                                              |           |
| MIN LOT AREA PROPOSED:                                         | 5,021 SF                                              |           |
| RM-CZ CLUSTER (SINGLE FAMILY DETACHED)                         |                                                       |           |
|                                                                | AREA (SF)                                             | AREA (AC) |
| FINAL TRACT AREA                                               | 2,521,614                                             | 57.89     |
| TOTAL UNITS                                                    | 161                                                   |           |
| PROPOSED DENSITY (DU/AC)                                       | 2.8                                                   |           |
| MAXIMUM DENSITY (DU/AC)                                        | 5                                                     |           |
| PUBLIC GREENWAY (EST. 30' ESTM WIDTH)                          | 150,754                                               | 3.46      |
| CLUSTER OPEN SPACE PROVIDED 12%                                | 252,161                                               | 5.79      |
| PROVIDED OPEN SPACE                                            | 1,431,382                                             | 32.86     |
| MAX BUILDING HEIGHT                                            | 35                                                    | ft        |
| SETBACKS MINIMUM RH - CZ (TOWNHOMES)                           |                                                       |           |
| FRONT                                                          | 15'                                                   |           |
| PARKING SETBACK FOR TOWNHOMES*                                 | 19'                                                   |           |
| BUILDING SEPARATION                                            | 30'                                                   |           |
| SIDE                                                           | 10'                                                   |           |
| CORNER SIDE                                                    | 15'                                                   |           |
| REAR                                                           | 15'                                                   |           |
| MIN FRONT LOT WIDTH                                            | 20'                                                   |           |
| MIN LOT AREA                                                   | 2,000 SF                                              |           |
| MIN LOT AREA PROPOSED:                                         | 2,054 SF                                              |           |
| RH-CZ (TOWNHOMES)                                              |                                                       |           |
|                                                                | AREA (SF)                                             | AREA (AC) |
| FINAL TRACT AREA                                               | 1,197,925                                             | 27.50     |
| GROSS TRACT AREA                                               | 628,146                                               | 14.42     |
| NOTE: SEE PHASING PLAN (C2-7) FOR MAP VIEW OF GROSS TRACT AREA |                                                       |           |
| LOT AREA                                                       | 330,922                                               | 7.60      |
| TOTAL UNITS                                                    | 114                                                   |           |
| PROPOSED DENSITY (DU/AC)                                       | 4.1                                                   |           |
| MAXIMUM DENSITY (DU/AC)                                        | 9                                                     |           |
| MAX BUILDING HEIGHT                                            | 35                                                    | ft        |

PARKER RIDGE SUBDIVISION ZONING CONDITIONS

- DEVELOPMENT OF THE PROPERTY SHALL BE IN SUBSTANTIAL CONFORMANCE WITH THE ACCOMPANYING EXHIBIT C CONCEPT PLAN. LOCATIONS SHOWN FOR COMMITTED ELEMENTS INCLUDING, BUT NOT LIMITED TO GREENWAYS, STREETS, AND OPEN AREAS SHOWN ON EXHIBIT C, ARE CONCEPTUAL AND PROVIDED FOR ILLUSTRATION AND CONTEXT ONLY. FINAL LOCATIONS OF ELEMENTS SHALL BE DETERMINED AT SUBSEQUENT STAGES OF APPROVAL. DEVELOPER SHALL BE ENTITLED TO A CREDIT AGAINST THE PROJECTS PARKS AND RECREATION FEES FOR THE COSTS TO CONSTRUCT PUBLIC GREENWAYS.
- THE FOLLOWING USES SHALL BE PROHIBITED ON THE PORTION OF THE PROPERTY ZONED RESIDENTIAL HIGH DENSITY (THE "RH PARCEL"):
  - LIVE-WORK UNIT
  - RESIDENTIAL CARE (ALF, ILF, CCF)
  - TELECOMMUNICATIONS TOWER
- THE RH PARCEL SHALL HAVE A MAXIMUM OF 120 TOWNHOUSE DWELLINGS.
- THE FOLLOWING USES SHALL BE PROHIBITED ON THE PORTION OF THE PROPERTY ZONED RESIDENTIAL MEDIUM DENSITY (THE "RM PARCEL"):
  - TELECOMMUNICATIONS TOWER
- THE RM PARCEL SHALL HAVE A MAXIMUM OF 170 SINGLE-FAMILY DETACHED DWELLINGS.
- A SINGLE FAMILY DETACHED HOME SHALL BE DEVELOPED AND DONATED AS PART OF WOUNDED WARRIOR HOMES. OPERATION COMING HOME, OPERATION FINALLY HOME, OR SIMILAR ORGANIZATION PROVIDING HOMES TO VETERANS. DEVELOPER SHALL BE ENTITLED TO A WAIVER OF ALL TOWN OF ROLESVILLE PERMIT FEES FOR THIS HOME.
- THE DEVELOPMENT SHALL INCLUDE AT LEAST ONE POLLINATOR GARDEN. THE POLLINATOR GARDEN SHALL BE A LANDSCAPED GARDEN IN WHICH AT LEAST SEVENTY FIVE PERCENT (75%) OF ALL PLANTS, INCLUDING GRASSES, ARE NATIVE MILKWEEDS AND OTHER NECTAR-RICH FLOWERS.
- PERMITTER BUFFERS SHALL BE PROVIDED AS SHOWN ON THE CONCEPT PLAN. TYPE 3 AND TYPE 4 PERMITTER BUFFERS MAY INCLUDE FENCES INSTEAD OF WALLS.
- ALL SINGLE FAMILY DETACHED DWELLINGS SHALL HAVE THE FOLLOWING FEATURES:
  - A 2 CAR GARAGE.
  - ALL GARAGE DOORS SHALL HAVE WINDOWS.
  - C. GROUND FLOOR ELEVATION AT THE FRONT DOOR SHALL BE A MINIMUM OF 12" ABOVE AVERAGE GRADE ACROSS THE FRONT FACADE OF THE HOUSE.
  - D. A MINIMUM 24" STONE OR MASONRY WATER TABLE ALONG THE FRONT ELEVATION;

- E. IF MASONRY IS NOT THE PREDOMINANT FIRST FLOOR FINISH, THEN THE FRONT ELEVATION SHALL HAVE 2 TYPES OF SIDING, FOR EXAMPLE, HORIZONTAL SIDING MAY BE COMBINED WITH SHAKEBOARD AND BATTEN.
- F. ROOF PITCHES ON THE MAIN ROOF WILL HAVE A PITCH BETWEEN 5 ON 12 AND 12 ON 12.
- G. ROOF MATERIALS SHALL BE ASPHALT SHINGLES, METAL, COPPER OR WOOD.
- H. MINIMUM 12" FRONT OVERHANGS.
- I. A COVERED STOOP OR PORCH AT LEAST 20 SF AND 5 FT DEEP.
- J. ALL WINDOWS ON FRONT FACADES SHALL HAVE SHUTTERS OR WINDOW TRIM.
- K. A MINIMUM 5% REAR PATIO.
- L. AT LEAST ONE WINDOW ON EACH SIDE ELEVATION.
- M. NO SINGLE FAMILY DETACHED HOME SHALL BE CONSTRUCTED WITH A FRONT ELEVATION OR COLOR PALETTE THAT IS IDENTICAL TO THE HOME ON EITHER SIDE OF IT OR DIRECTLY ACROSS FROM IT; AND
- N. A VARIED COLOR PALETTE SHALL BE USED THROUGHOUT THE SUBDIVISION.
- ALL TOWNHOUSE DWELLINGS SHALL HAVE THE FOLLOWING FEATURES:
  - A 1 OR 2 CAR GARAGE.
  - B. A MINIMUM 24" STONE OR MASONRY WATER TABLE ALONG THE FRONT ELEVATION.
  - C. IF MASONRY IS NOT THE PREDOMINANT FIRST FLOOR FINISH, THEN THE FRONT ELEVATION SHALL HAVE 2 TYPES OF SIDING, FOR EXAMPLE, HORIZONTAL SIDING MAY BE COMBINED WITH SHAKEBOARD AND BATTEN.
  - D. ROOF MATERIALS SHALL BE ASPHALT SHINGLES, METAL, COPPER OR WOOD.
  - E. MINIMUM 12" FRONT OVERHANGS.
  - F. A COVERED STOOP OR PORCH AT LEAST 20 SF AND 5 FT DEEP.
  - G. SHUTTERS OR WINDOW TRIM SHALL BE ON FRONT FACADE WINDOWS.
  - H. A MINIMUM 5% REAR PATIO SHALL BE PROVIDED ON FRONT LOADED TOWNHOUSES.
  - I. AT LEAST ONE WINDOW ON EACH SIDE ELEVATION (EXCLUDING INTERIOR UNITS).
  - J. NO TOWNHOUSE SHALL BE PAINTED A COLOR THAT IS IDENTICAL TO THE HOME ADJACENT ON EITHER SIDE OF IT; AND
  - K. A VARIED COLOR PALETTE SHALL BE USED THROUGHOUT THE SUBDIVISION.
- THE DEVELOPER SHALL OFFER TO DEDICATE THE SECTION OF LAND LABELED AS "PARCEL - A - TOWN OF ROLESVILLE PARK EXPANSION" ON THE CONCEPT PLAN FOR USE AS A PUBLIC PARK. THIS LAND SHALL COUNT TOWARD OPEN SPACE REQUIREMENTS FOR THE OVERALL DEVELOPMENT.
- THE PROJECT SHALL HAVE A PUBLIC GREENWAY STUBBED TO THE 307 S. MAIN STREET PROPERTY LINE.

- NEAR "ACCESS C" AS SHOWN ON THE "PARKER RIDGE TRAFFIC IMPACT ANALYSIS" PREPARED BY STANTEC CONSULTING SERVICES, INC., DATED FEBRUARY 2, 2023 (THE "TIA"), NOTWITHSTANDING THE FOREGOING, THE PROJECT SHALL NOT HAVE A PUBLIC STREET ACCESS TO SCHOOL STREET.
- DEVELOPER SHALL DESIGN AND CONSTRUCT: (1) THE PUBLIC COLLECTOR STREET IDENTIFIED AS ACCESS D IN THE TIA THAT EXTENDS THE STREET NETWORK WITHIN THE DEVELOPMENT THROUGH WAKE COUNTY PIN 1768-09-8727 (THE "CAMPUS SITE") TO E YOUNG STREET ("ACCESS D ROUTE"); AND (2) A NORTHBOUND LEFT TURN LANE WITH 75 FEET OF FULL-WIDTH STORAGE AND APPROPRIATE TAPER FROM YOUNG STREET TO ACCESS D AS RECOMMENDED BY THE TIA ("TURN LANE"). (ACCESS D ROUTE AND TURN LANE ARE COLLECTIVELY REFERRED TO AS THE "YOUNG STREET CONNECTION"). THE YOUNG STREET CONNECTION SHALL BE DESIGNED AND CONSTRUCTED TO TOWN OF ROLESVILLE AND NCDOT STANDARDS AND ACCESS D SHALL BE LOCATED IN SUBSTANTIAL CONFORMANCE WITH THE CORRIDOR SHOWN IN THE ATTACHED EXHIBIT E. THE STREET SECTION FOR ACCESS D SHALL BE CONSTRUCTED AS SHOWN IN THE ATTACHED EXHIBIT E. DEVELOPER SHALL BE RESPONSIBLE FOR ALL COSTS TO DESIGN AND CONSTRUCT THE YOUNG STREET CONNECTION (THE "COSTS") AND DEVELOPER SHALL BE ENTITLED TO A CREDIT AGAINST THE PROJECT'S TRANSPORTATION IMPACT FEES FOR THE COSTS. CONSTRUCTION OF THE YOUNG STREET CONNECTION SHALL COMMENCE PRIOR TO APPROVAL OF THE 105TH DWELLING UNIT BUILDING PERMIT FOR THE PROJECT.
- WHILE IT IS ANTICIPATED THAT THIS CONDITION WILL BE CLARIFIED BY A FORMAL DEVELOPMENT AGREEMENT, REIMBURSEMENT AGREEMENT, OR OTHER WRITTEN AGREEMENT BETWEEN THE DEVELOPER AND THE TOWN, THE ABSENCE OF SUCH A SUBSEQUENT WRITTEN AGREEMENT SHALL NOT BE DEEMED TO INVALIDATE THIS CONDITION. THIS CONDITION IS SUBJECT TO THE FOLLOWING CAVEATS:
- IN THE EVENT THE CAMPUS SITE, AN APPROVED ALIGNMENT WITHIN THE EXHIBIT E CORRIDOR, OR NECESSARY RIGHTS-OF-WAY, EASEMENTS, OR OTHER PROPERTY RIGHTS ARE MADE UNAVAILABLE TO THE PROJECT, THIS CONDITION SHALL BE DEEMED EXTINGUISHED.
  - IN THE EVENT THE TOWN COMMENCES DESIGN AND/OR DEVELOPMENT OF ANY PART OF THE YOUNG STREET CONNECTION, THE DEVELOPERS OBLIGATIONS FOR DESIGN AND/OR DEVELOPMENT, AS APPROPRIATE, FOR THOSE PORTIONS OF THE YOUNG STREET CONNECTION SHALL BE DEEMED EXTINGUISHED. FOR PURPOSES OF CLARITY, DEVELOPER SHALL REMAIN ENTITLED TO A CREDIT AGAINST THE PROJECT'S TRANSPORTATION IMPACT FEES FOR REMAINING COSTS.
- "PROJECT" SHALL MEAN "PARKER RIDGE" AS DESCRIBED BY MA 22-03 AND ANX 22-06.
- "DEVELOPER" SHALL MEAN LENNAR CAROLINAS LLC, AND ITS SUCCESSORS AND ASSIGNS.

PROJECT OWNER AND CONSULTANT INFORMATION

DEVELOPER:  
LENNAR CORPORATION  
1100 PERIMETER PARK DRIVE, SUITE 112  
MORRISVILLE, NC 27560  
(919) 863-6461

CONTACT: MICHAEL TAYLOR, PE LEED AP

ENGINEER:  
BGE, INC  
1100 WADE PARK BOULEVARD  
RALEIGH, NORTH CAROLINA 27607  
(919) 276-0111

CONTACT: DEBRA FERM, P.E.

BOUNDARY SURVEYOR:  
JOHNSON, MIRIMAN & THOMPSON, INC.  
9201 ARBORETUM PARKWAY SUITE 310  
RICHMOND, VA 23236  
(804) 267-1258

CONTACT MICHAEL ZMUDA, L.S., P.S.

TOPOGRAPHIC SURVEYOR:  
ADVANCED CIVIL DESIGN, INC.  
51 KILMAYNE DRIVE SUITE 102  
CARY, NC 27511  
(919) 460-2024

CONTACT: JAMES WHITACRE, P.E., L.S.



CID-23-06 / Construction Infrastructure Drawing  
/ Parker Ridge

APPROVED

Date: March 12, 2024

*Meredith Shuler*

Town of Rolesville Planning Department

TOWN OF ROLESVILLE

1ST SUBMITTAL: JUNE 1, 2023

FINAL SUBMITTAL: MARCH 4, 2024

WAKE COUNTY


1ST SUBMITTAL: OCTOBER 12, 2023

FINAL SUBMITTAL: JANUARY 12, 2024

CID REVISION (ROLESVILLE)

1ST SUBMITTAL: JANUARY 2, 2025

2ND SUBMITTAL: MARCH 24, 2025

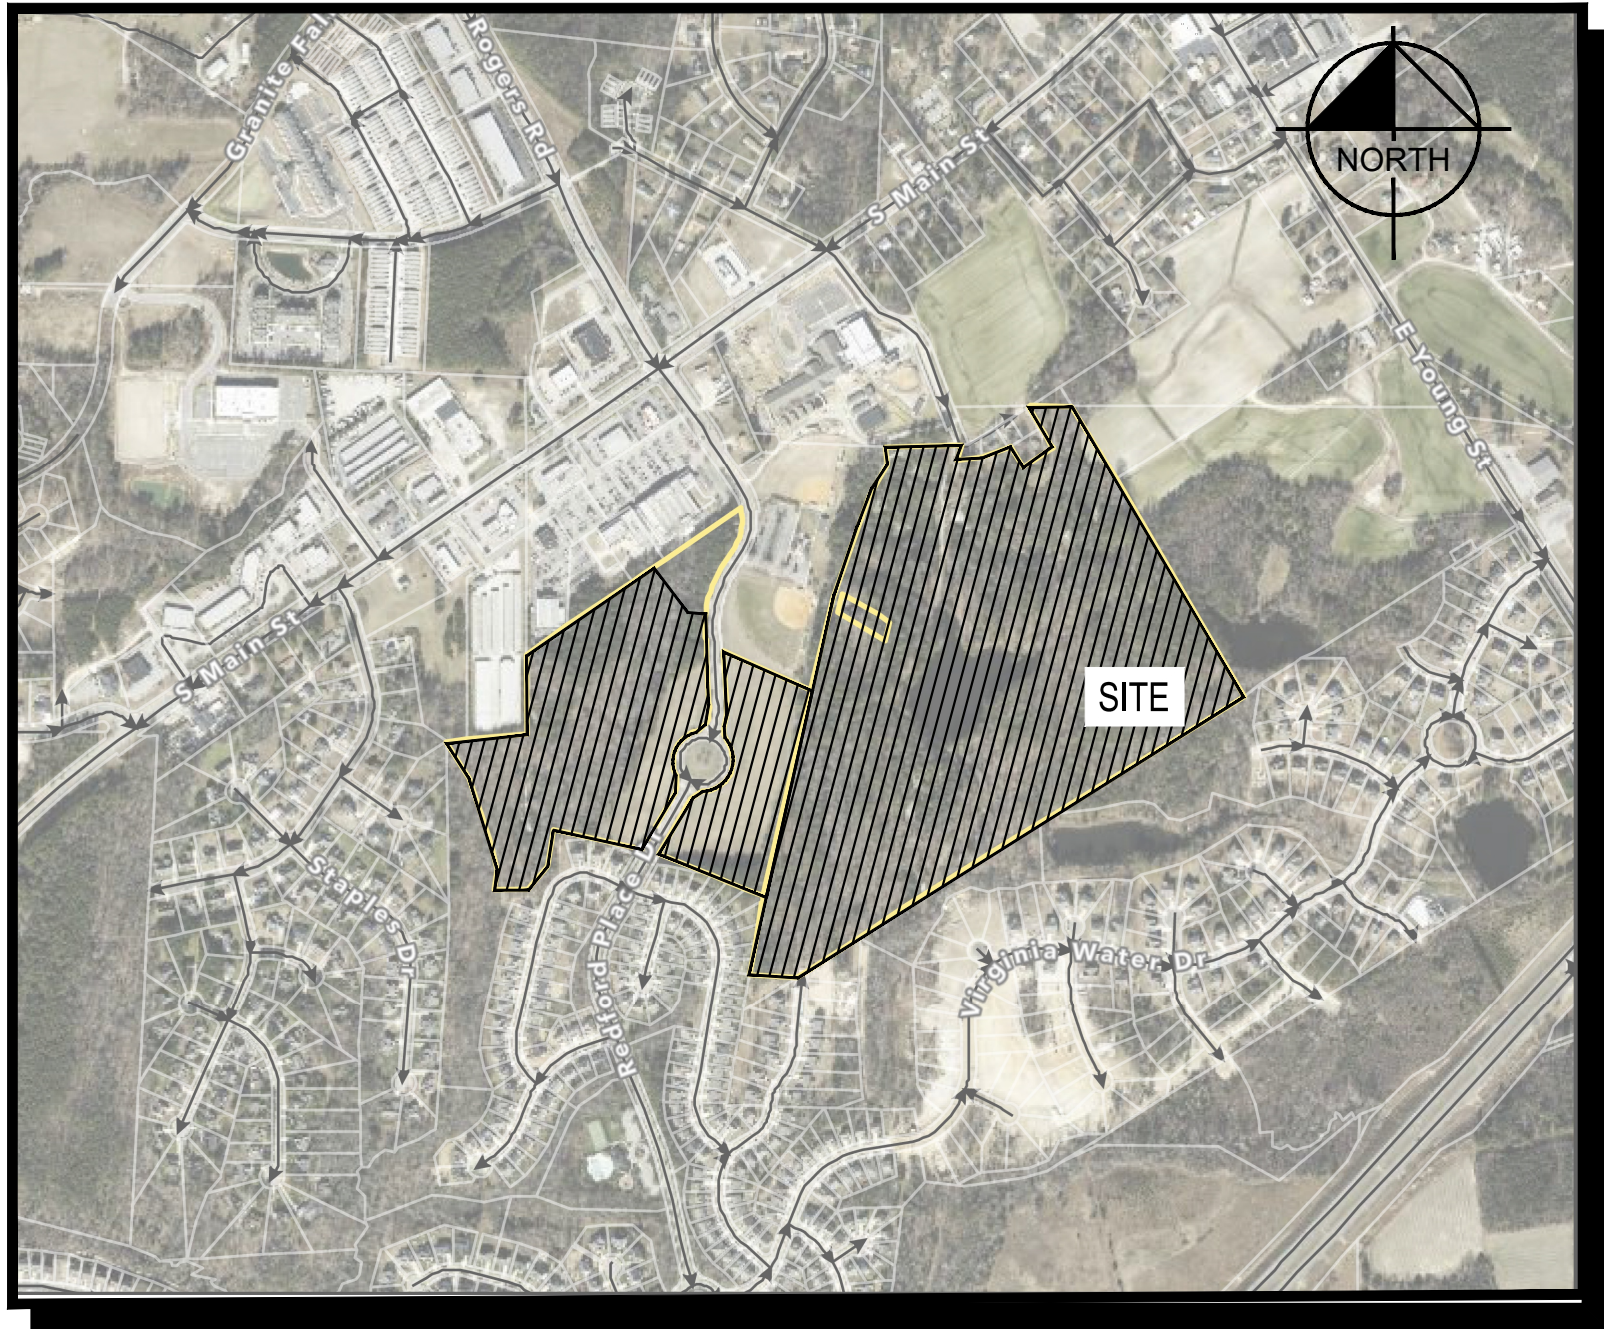

ATTENTION CONTRACTORS

The *Construction Contractor* responsible for the extension of water, sewer, and/or reuse, as approved in these plans, is responsible for contacting the **Public Utilities Department** at (919) 996-4540 at least *twenty four hours* prior to beginning any of their construction.

**Failure** to notify both *City Departments* in advance of beginning construction, will result in the issuance of *monetary fines*, and require reinstallation of any water or sewer facilities not inspected as a result of this notification failure.

**Failure** to call for *Inspection*, *Install a Downstream Plug*, have *Permitted Plans* on the *Job site*, or any other *Violation of City of Raleigh Standards* will result in a *Fine and Possible Exclusion* from future work in the *City of Raleigh*.

CORPUD APPROVAL CONDITION:  
CONVEYANCE OF SEWAGE FROM LOTS WITHIN PHASES 1B AND 2A ARE RELYING ON IMPROVEMENTS TO THE HARRIS CREEK INTERCEPTOR THAT ARE BEING DESIGNED BY MCADAMS (THE POINT) AND AMERICAN ENGINEERING (KALLAS FALLS). THE PLAN SET BY MCADAMS IS TITLED HARRIS CREEK INTERCEPTOR IMPROVEMENTS AND HAS AN ASSIGNED PERMIT NUMBER OF S-4979. THE PLAN SET BY AMERICAN ENGINEERING IS TITLED HARRIS CREEK SANITARY SEWER REPLACEMENT AND HAS AN ASSIGNED PERMIT NUMBER OF S-5037. LOTS WITHIN PARKER RIDGE PHASES 1B AND 2A WILL NOT BE RECORDED AND THE ONSITE WATER/SEWER UTILITIES WILL NOT BE ACCEPTED BY RALEIGH UNTIL THE HARRIS CREEK INTERCEPTOR IMPROVEMENTS UNDER PERMITS S-4979 AND S-5037 ARE APPROVED, INSTALLED AND ACCEPTED BY RALEIGH FOR MAINTENANCE.

CITY OF RALEIGH - PLANS AUTHORIZED FOR CONSTRUCTION

Plans for the proposed use have been reviewed for general compliance with applicable codes. This limited review, and authorization for construction is not to be considered to represent total compliance with all legal requirements for development and construction. The property owner, design consultants, and contractors are each responsible for compliance with all applicable City, State and Federal laws. This specific authorization below is not a permit, nor shall it be construed to permit any violation of City, State or Federal Law. All Construction must be in accordance with all Local, State, and Federal Rules and Regulations.

Electronic Approval: This approval is being issued electronically. This approval is valid only upon the signature of a City of Raleigh Review Officer below. The City will retain a copy of the approved plans. Any work authorized by this approval must proceed in accordance with the plans kept on file with the City. This electronic approval may not be edited once issued. Any modification to this approval once issued will invalidate this approval.

City of Raleigh Development Approval \_\_\_\_\_

City of Raleigh Review Officer \_\_\_\_\_

Water and Sewer Permits (If applicable)

The City of Raleigh consents to the connection and extension of the City's **Public Sewer System** as shown on this plan. The material and Construction methods used for this project shall conform to the standards and specifications of the City's Public Utilities Handbook.

City of Raleigh Public Utilities Department Permit # S-5439

The City of Raleigh consents to the connection and extension of the City's **Public Water System** as shown on this plan. The material and Construction methods used for this project shall conform to the standards and specifications of the City's Public Utilities Handbook.

City of Raleigh Public Utilities Department Permit # W-4107

EROSION CONTROL, STORMWATER AND FLOODPLAIN MANAGEMENT

APPROVED  
EROSION CONTROL ☐ S-  
STORMWATER MGMT. ☐ S-  
FLOOD STUDY ☐ S-  
DATE \_\_\_\_\_

ENVIRONMENTAL CONSULTANT SIGNATURE



| SHEET LIST TABLE |                                                |
|------------------|------------------------------------------------|
| SHEET NUMBER     | SHEET TITLE                                    |
| C0-0             | COVER SHEET                                    |
| C0-1             | GENERAL NOTES                                  |
| C0-2             | NC601 STABILIZATION NOTES                      |
| C1-0             | EXISTING CONDITIONS (1 OF 4)                   |
| C1-1             | EXISTING CONDITIONS (2 OF 4)                   |
| C1-2             | EXISTING CONDITIONS (3 OF 4)                   |
| C1-3             | EXISTING CONDITIONS (4 OF 4)                   |
| C1-4             | OVERALL DEMOLITION PLAN                        |
| C1-5             | ENLARGED DEMOLITION PLAN (1 OF 6)              |
| C1-6             | ENLARGED DEMOLITION PLAN (2 OF 6)              |
| C1-7             | ENLARGED DEMOLITION PLAN (3 OF 6)              |
| C1-8             | ENLARGED DEMOLITION PLAN (4 OF 6)              |
| C1-9             | ENLARGED DEMOLITION PLAN (5 OF 6)              |
| C1-10            | ENLARGED DEMOLITION PLAN (6 OF 6)              |
| C2-0             | OVERALL SITE PLAN                              |
| C2-1             | ENLARGED SITE PLAN (1 OF 6)                    |
| C2-2             | ENLARGED SITE PLAN (2 OF 6)                    |
| C2-3             | ENLARGED SITE PLAN (3 OF 6)                    |
| C2-4             | ENLARGED SITE PLAN (4 OF 6)                    |
| C2-5             | ENLARGED SITE PLAN (5 OF 6)                    |
| C2-6             | ENLARGED SITE PLAN (6 OF 6)                    |
| C2-7             | PHASING PLAN                                   |
| C2-8             | SIGNAGE AND STRIPING PLAN                      |
| C3-0             | OVERALL UTILITY PLAN                           |
| C3-1             | ENLARGED UTILITY PLAN (1 OF 6)                 |
| C3-2             | ENLARGED UTILITY PLAN (2 OF 6)                 |
| C3-3             | ENLARGED UTILITY PLAN (3 OF 6)                 |
| C3-4             | ENLARGED UTILITY PLAN (4 OF 6)                 |
| C3-5             | ENLARGED UTILITY PLAN (5 OF 6)                 |
| C3-6             | ENLARGED UTILITY PLAN (6 OF 6)                 |
| C4-0             | OVERALL GRADING PLAN                           |
| C4-1             | ENLARGED GRADING PLAN (1 OF 6)                 |
| C4-2             | ENLARGED GRADING PLAN (2 OF 6)                 |
| C4-3             | ENLARGED GRADING PLAN (3 OF 6)                 |
| C4-4             | ENLARGED GRADING PLAN (4 OF 6)                 |
| C4-5             | ENLARGED GRADING PLAN (5 OF 6)                 |
| C4-6             | ENLARGED GRADING PLAN (6 OF 6)                 |
| C4-7             | STORM SEWER TABLE (1 OF 2)                     |
| C4-8             | STORM SEWER TABLE (2 OF 2)                     |
| C5-0             | OVERALL PHASE 1 EROSION CONTROL PLAN (1 OF 6)  |
| C5-1             | ENLARGED PHASE 1 EROSION CONTROL PLAN (2 OF 6) |
| C5-2             | ENLARGED PHASE 1 EROSION CONTROL PLAN (3 OF 6) |
| C5-3             | ENLARGED PHASE 1 EROSION CONTROL PLAN (4 OF 6) |
| C5-4             | ENLARGED PHASE 1 EROSION CONTROL PLAN (5 OF 6) |
| C5-5             | ENLARGED PHASE 1 EROSION CONTROL PLAN (6 OF 6) |
| C5-6             | OVERALL PHASE 2 EROSION CONTROL PLAN (1 OF 6)  |
| C5-7             | ENLARGED PHASE 2 EROSION CONTROL PLAN (2 OF 6) |
| C5-8             | ENLARGED PHASE 2 EROSION CONTROL PLAN (3 OF 6) |
| C5-9             | ENLARGED PHASE 2 EROSION CONTROL PLAN (4 OF 6) |
| C5-10            | ENLARGED PHASE 2 EROSION CONTROL PLAN (5 OF 6) |
| C5-11            | ENLARGED PHASE 2 EROSION CONTROL PLAN (6 OF 6) |
| C5-12            | OVERALL PHASE 3 EROSION CONTROL PLAN (1 OF 6)  |
| C5-13            | ENLARGED PHASE 3 EROSION CONTROL PLAN (2 OF 6) |
| C5-14            | OVERALL PHASE 3 EROSION CONTROL PLAN (3 OF 6)  |
| C5-15            | ENLARGED PHASE 3 EROSION CONTROL PLAN (4 OF 6) |
| C5-16            | ENLARGED PHASE 3 EROSION CONTROL PLAN (5 OF 6) |
| C5-17            | ENLARGED PHASE 3 EROSION CONTROL PLAN (6 OF 6) |
| C5-18            | ENLARGED PHASE 3 EROSION CONTROL PLAN (7 OF 6) |
| C5-19            | ENLARGED PHASE 3 EROSION CONTROL PLAN (8 OF 6) |
| C5-20            | ENLARGED PHASE 3 EROSION CONTROL PLAN (9 OF 6) |
| C6-0             | CARVED STONE CT PLAN AND PROFILE               |
| C6-1             | CAVALERA WAY PLAN AND PROFILE                  |
| C6-2             | GRANITE KNOLL CT PLAN AND PROFILE (1 OF 2)     |
| C6-3             | GRANITE KNOLL CT PLAN AND PROFILE (2 OF 2)     |
| C6-4             | STONE OVERLOOK CT PLAN AND PROFILE             |

PSP-23-02  
CID-23-06

|       |                                              |
|-------|----------------------------------------------|
| C6-5  | WATER NEST DR PLAN AND PROFILE               |
| C6-6  | TREE MOSS CT PLAN AND PROFILE                |
| C6-7  | QUARRY POND CT PLAN AND PROFILE              |
| C6-8  | ZANNING DR PLAN AND PROFILE                  |
| C6-9  | LONG Melford Drive Plan and Profile (1 OF 5) |
| C6-10 | LONG Melford Drive Plan and Profile (2 OF 5) |
| C6-11 | LONG Melford Drive Plan and Profile (3 OF 5) |
| C6-12 | LONG Melford Drive Plan and Profile (4 OF 5) |
| C6-13 | LONG Melford Drive Plan and Profile (5 OF 5) |
| C6-14 | ALLEY 1 PLAN AND PROFILE                     |
| C6-15 | ALLEY 2 PLAN AND PROFILE                     |
| C6-16 | ALLEY 3 PLAN AND PROFILE                     |
| C6-17 | ALLEY 4 PLAN AND PROFILE                     |
| C6-18 | GW1A GREENWAY PLAN AND PROFILE (1 OF 2)      |
| C6-19 | GW1A GREENWAY PLAN AND PROFILE (2 OF 2)      |
| C6-20 | GW2 GREENWAY PLAN AND PROFILE (1 OF 2)       |
| C6-21 | GW2 GREENWAY PLAN AND PROFILE (2 OF 2)       |
| C6-22 | GW3 GREENWAY PLAN AND PROFILE (1 OF 1)       |
| C6-23 | GW4 GREENWAY PLAN AND PROFILE (1 OF 2)       |
| C6-24 | GW4 GREENWAY PLAN AND PROFILE (2 OF 2)       |
| C6-25 | SEWER OUTFALL 1 AND 2 PLAN AND PROFILE       |
| C6-26 | SEWER OUTFALL 3 AND 4 PLAN AND PROFILE       |
| C6-27 | SEWER OUTFALL 6 PLAN AND PROFILE             |
| C7-0  | SCM 1 PLAN AND PROFILE                       |
| C7-1  | SCM 2 PLAN AND PROFILE                       |
| C7-2  | SCM 3 PLAN AND PROFILE                       |
| C7-3  | SCM 4 PLAN AND PROFILE                       |
| C7-4  | CULVERT 1 PLAN                               |
| C7-5  | CULVERT 2 PLAN                               |
| C7-6  | CULVERT 3 PLAN                               |
| C7-7  | CULVERT 4 PLAN                               |
| C7-8  | SCM DETAILS                                  |
| C8-0  | SITE DETAILS (1 OF 3)                        |
| C8-1  | SITE DETAILS (2 OF 3)                        |
| C8-2  | SITE DETAILS (3 OF 3)                        |
| C8-3  | EROSION CONTROL DETAILS (1 OF 2)             |
| C8-4  | EROSION CONTROL DETAILS (2 OF 2)             |
| C8-5  | SEWER DETAIL                                 |
| C8-6  | STORM DETAILS (1 OF 2)                       |
| C8-7  | STORM DETAILS (2 OF 2)                       |
| C8-8  | WATER DETAIL (1 OF 2)                        |
| C8-9  | WATER DETAIL (2 OF 2)                        |
| C9-0  | OPEN SPACE PLAN                              |
| C9-1  | OPEN SPACE DETAILS (1 OF 2)                  |
| C9-2  | OPEN SPACE DETAILS (2 OF 2)                  |
| L1-0  | OVERALL LANDSCAPE PLAN                       |
| L1-1  | ENLARGED LANDSCAPE PLAN (1 OF 6)             |
| L1-2  | ENLARGED LANDSCAPE PLAN (2 OF 6)             |
| L1-3  | ENLARGED LANDSCAPE PLAN (3 OF 6)             |
| L1-4  | ENLARGED LANDSCAPE PLAN (4 OF 6)             |
| L1-5  | ENLARGED LANDSCAPE PLAN (5 OF 6)             |
| L1-6  | ENLARGED LANDSCAPE PLAN (6 OF 6)             |
| L1-7  | SCM PLANTINGS                                |
| L2-0  | LANDSCAPE DETAILS                            |
| L3-0  | OVERALL TREE CONSERVATION PLAN               |
| L3-1  | ENLARGED TCA PLAN (1 OF 6)                   |
| L3-2  | ENLARGED TCA PLAN (2 OF 6)                   |
| L3-3  | ENLARGED TCA PLAN (3 OF 6)                   |
| L3-4  | ENLARGED TCA PLAN (4 OF 6)                   |
| L3-5  | ENLARGED TCA PLAN (5 OF 6)                   |
| L3-6  | ENLARGED TCA PLAN (6 OF 6)                   |
| L4-0  | SITE LIGHTING PLAN (GRID)                    |
| L4-1  | SITE LIGHTING PLAN (NO GRID)                 |

03/24/2025  
SUBPHASING, SEWER, & CURB TYPES

1/04/2024  
AMENITY CENTER REVISIONS

06/06/2024  
RETAINING WALL LOCATION REVISION

06/04/2024  
STORM STRUCTURE REVISIONS

04/08/2024  
EROSION CONTROL REVISION

DESIGNED BY: DF/CD  
DRAWN BY: DF/JWM  
REVIEWED BY: DF

BCE

5438 WADE PARK BLVD, SUITE 420  
WWW.BCEINC.COM  
NC LICENSE #C-4397

LENNAR

CORPORAION

1100 PERIMETER PARK DRIVE, SUITE 112  
MORRISVILLE / NORTH CAROLINA / 27571

PARKER RIDGE

82 SCHOOL STREET  
ROLESVILLE / NORTH CAROLINA / 27571

COVER SHEET

3/25/2025


FILE NUMBER:  
8430-03

DATE: 3/24/2025

C0-0



THE TOWN OF ROLESVILLE  
DB 5134 PG 618  
BM 1991 PG 1333  
PIN# 1758980948  
ZONE: PUD  
USE: CLUB HSE

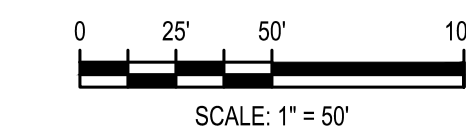


Know what's below.  
Call before you dig.


|                         |
|-------------------------|
| FILE NUMBER:<br>8430-03 |
| DATE: 3/24/2025         |

C1-5



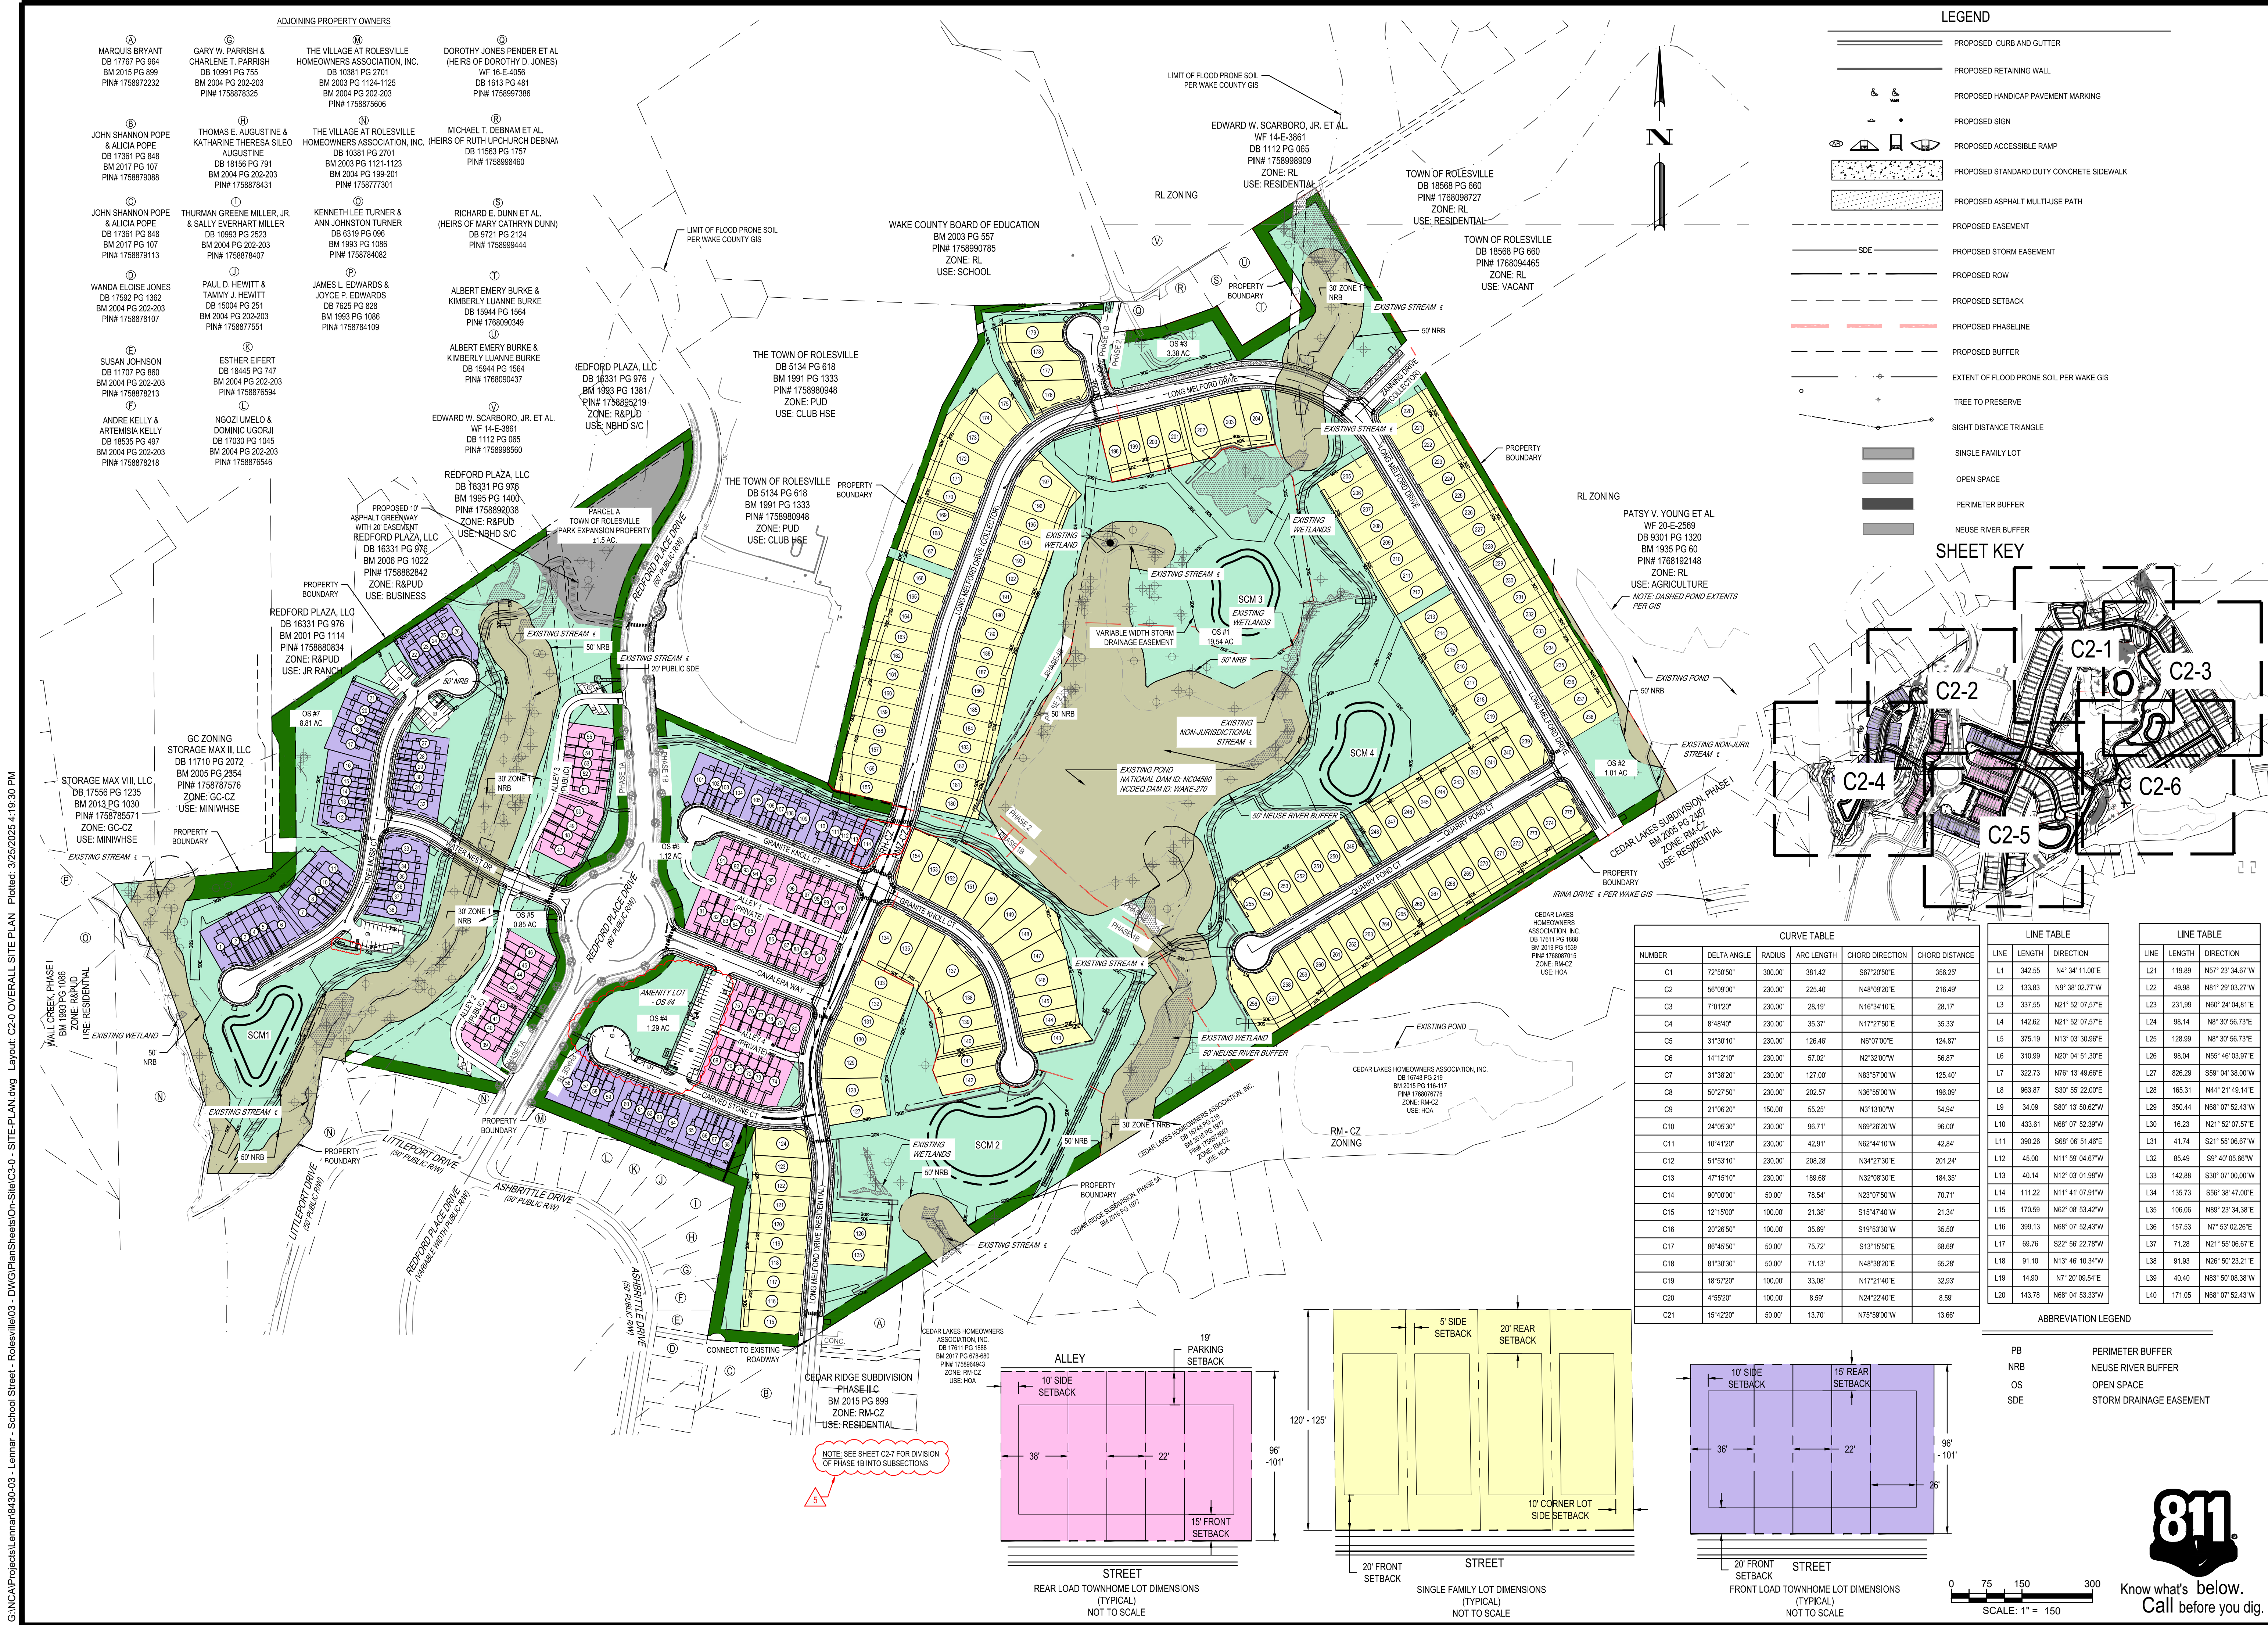



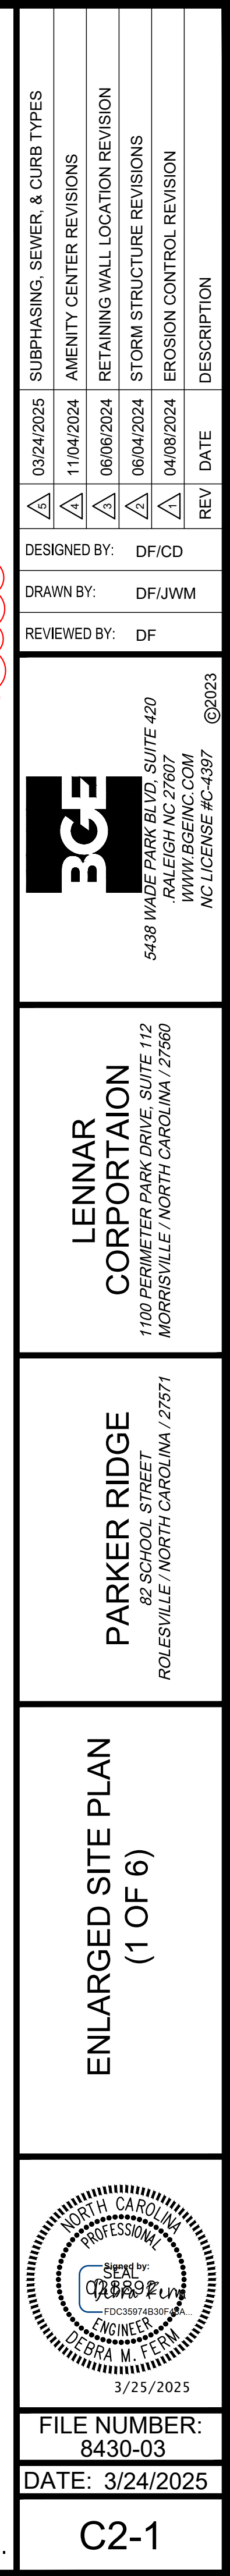





**BGE**


5438 WADE PARK BLVD. SUITE 420  
RALEIGH NC 27607  
WWW.BGEINC.COM  
NC LICENSE #C-4397 ©2023

**PARKER RIDGE**  
82 SCHOOL STREET  
ROLESVILLE / NORTH CAROLINA / 27571

A circular professional engineer seal for the State of North Carolina. The outer ring contains the text "NORTH CAROLINA" at the top and "PROFESSIONAL" at the bottom. In the center, it reads "SEAL" above the number "028892". Below the number is a blue ink signature, and at the bottom of the seal, it reads "ENGINEER" above the name "DEBRA M. FERM".

|                         |
|-------------------------|
| FILE NUMBER:<br>8430-03 |
| DATE: 3/24/2025         |
| C2-2                    |



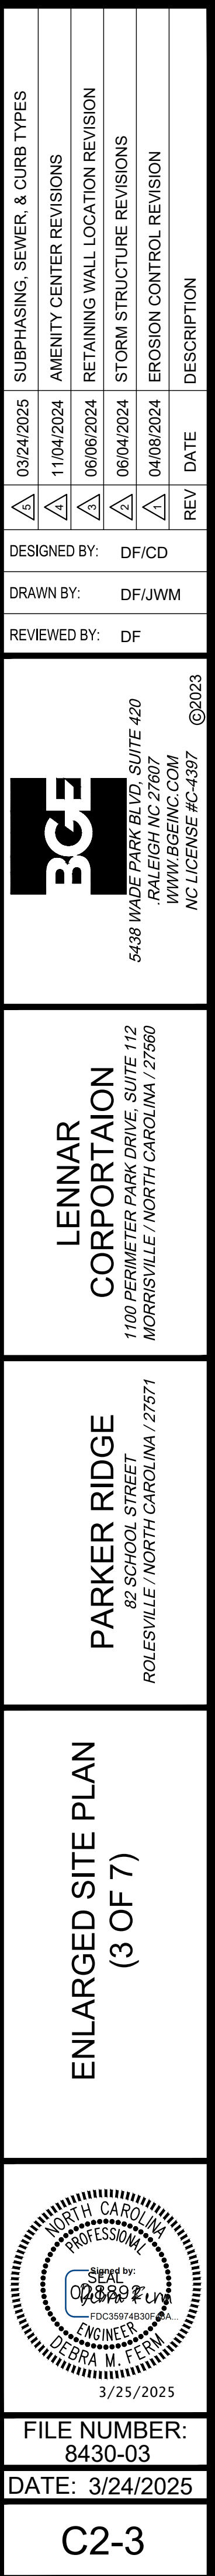







| CURB LEGEND |                            |
|-------------|----------------------------|
| (S)         | 30" STANDARD CURB & GUTTER |
| (V)         | 30" VALLEY CURB & GUTTER   |

### SITE PLAN LEGEND

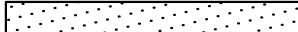
- 
-  PROPOSED CURB AND GUTTER  
 PROPOSED RETAINING WALL  
 PROPOSED HANDICAP PAVEMENT MARKING  
 PROPOSED SIGN  
 PROPOSED ACCESSIBLE RAMP  
 PROPOSED STANDARD DUTY CONCRETE SIDEWALK  
 PROPOSED ASPHALT MULTI-USE PATH  
 PROPOSED EASEMENT  
 PROPOSED STORM EASEMENT  
 PROPOSED ROW  
 PROPOSED SETBACK  
 PROPOSED PHASELINE  
 PROPOSED BUFFER  
 EXTENT OF FLOOD PRONE SOIL PER WAKE GIS  
 TREE TO PRESERVE  
 SIGHT DISTANCE TRIANGLE

### ABBREVIATION LEGEND

- |     |                         |
|-----|-------------------------|
| PB  | PERIMETER BUFFER        |
| NRB | NEUSE RIVER BUFFER      |
| OS  | OPEN SPACE              |
| SDE | STORM DRAINAGE EASEMENT |

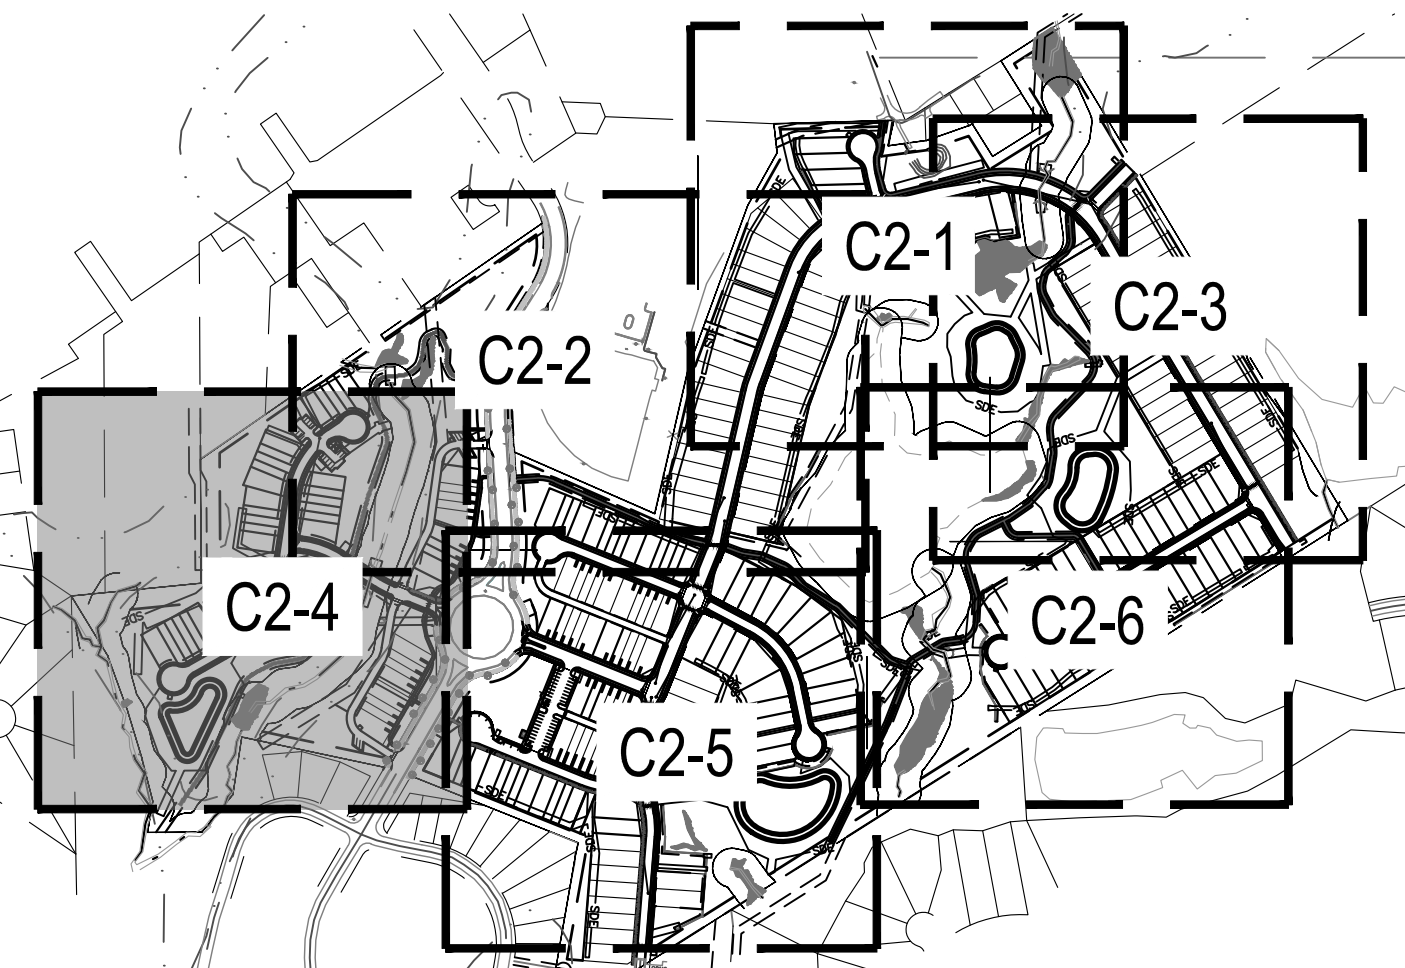





## SHEET KEY

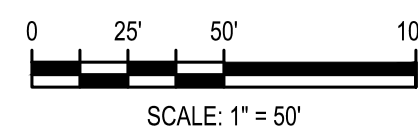

Know what's below.  
Call before you dig.

|                                                                                       |                                         |  |                                                                         |  |   |  |   |  |                                                           |  |   |   |
|---------------------------------------------------------------------------------------|-----------------------------------------|--|-------------------------------------------------------------------------|--|---|--|---|--|-----------------------------------------------------------|--|---|---|
|  | ENLARGED SITE PLAN<br>(4 OF 6)          |  | PARKER RIDGE<br>82 SCHOOL STREET<br>ROLESVILLE / NORTH CAROLINA / 27571 |  | LENNAR<br>CORPORAION<br>1100 PERIMETER PARK DRIVE, SUITE 112<br>MORRISVILLE / NORTH CAROLINA / 27560 |  | <br>5438 WADE PARK BLVD, SUITE 420<br>RALEIGH NC 27607<br>WWW.BGE.COM<br>NC LICENSE PC-4397 |  | DESIGNED BY: DF/CD<br>DRAWN BY: DF/JWM<br>REVIEWED BY: DF |  | <div>03/24/2025</div> <div>11/04/2024</div> <div>06/06/2024</div> <div>06/04/2024</div> <div>04/09/2024</div> | SUBPHASING, SEWER, & CURB TYPES<br>AMENITY CENTER REVISIONS<br>RETAINING WALL LOCATION REVISION<br>STORM STRUCTURE REVISIONS<br>EROSION CONTROL REVISION |
|                                                                                       | REV. DATE DESCRIPTION                   |  |                                                                         |  |   |  |   |  |                                                           |  |   |   |
|                                                                                       | ©2023                                   |  |                                                                         |  |   |  |   |  |                                                           |  |   |   |
|                                                                                       | C2-4                                    |  |                                                                         |  |   |  |   |  |                                                           |  |   |   |
|                                                                                       | FILE NUMBER: 8430-03<br>DATE: 3/24/2025 |  |                                                                         |  |   |  |   |  |                                                           |  |   |   |



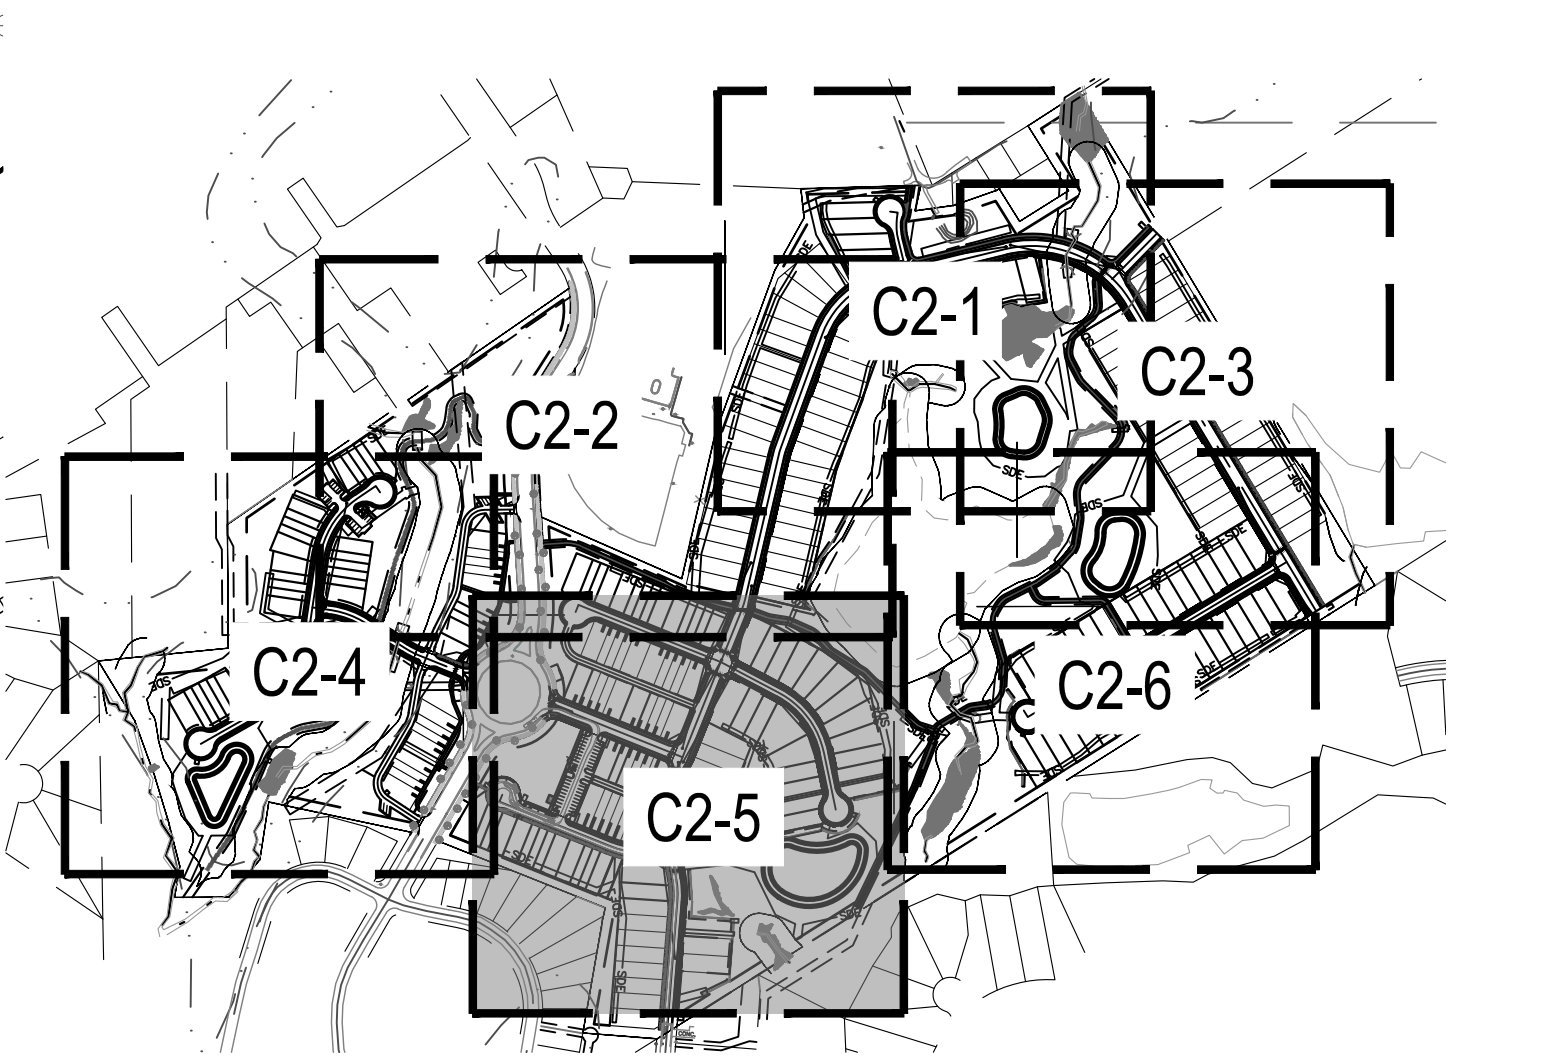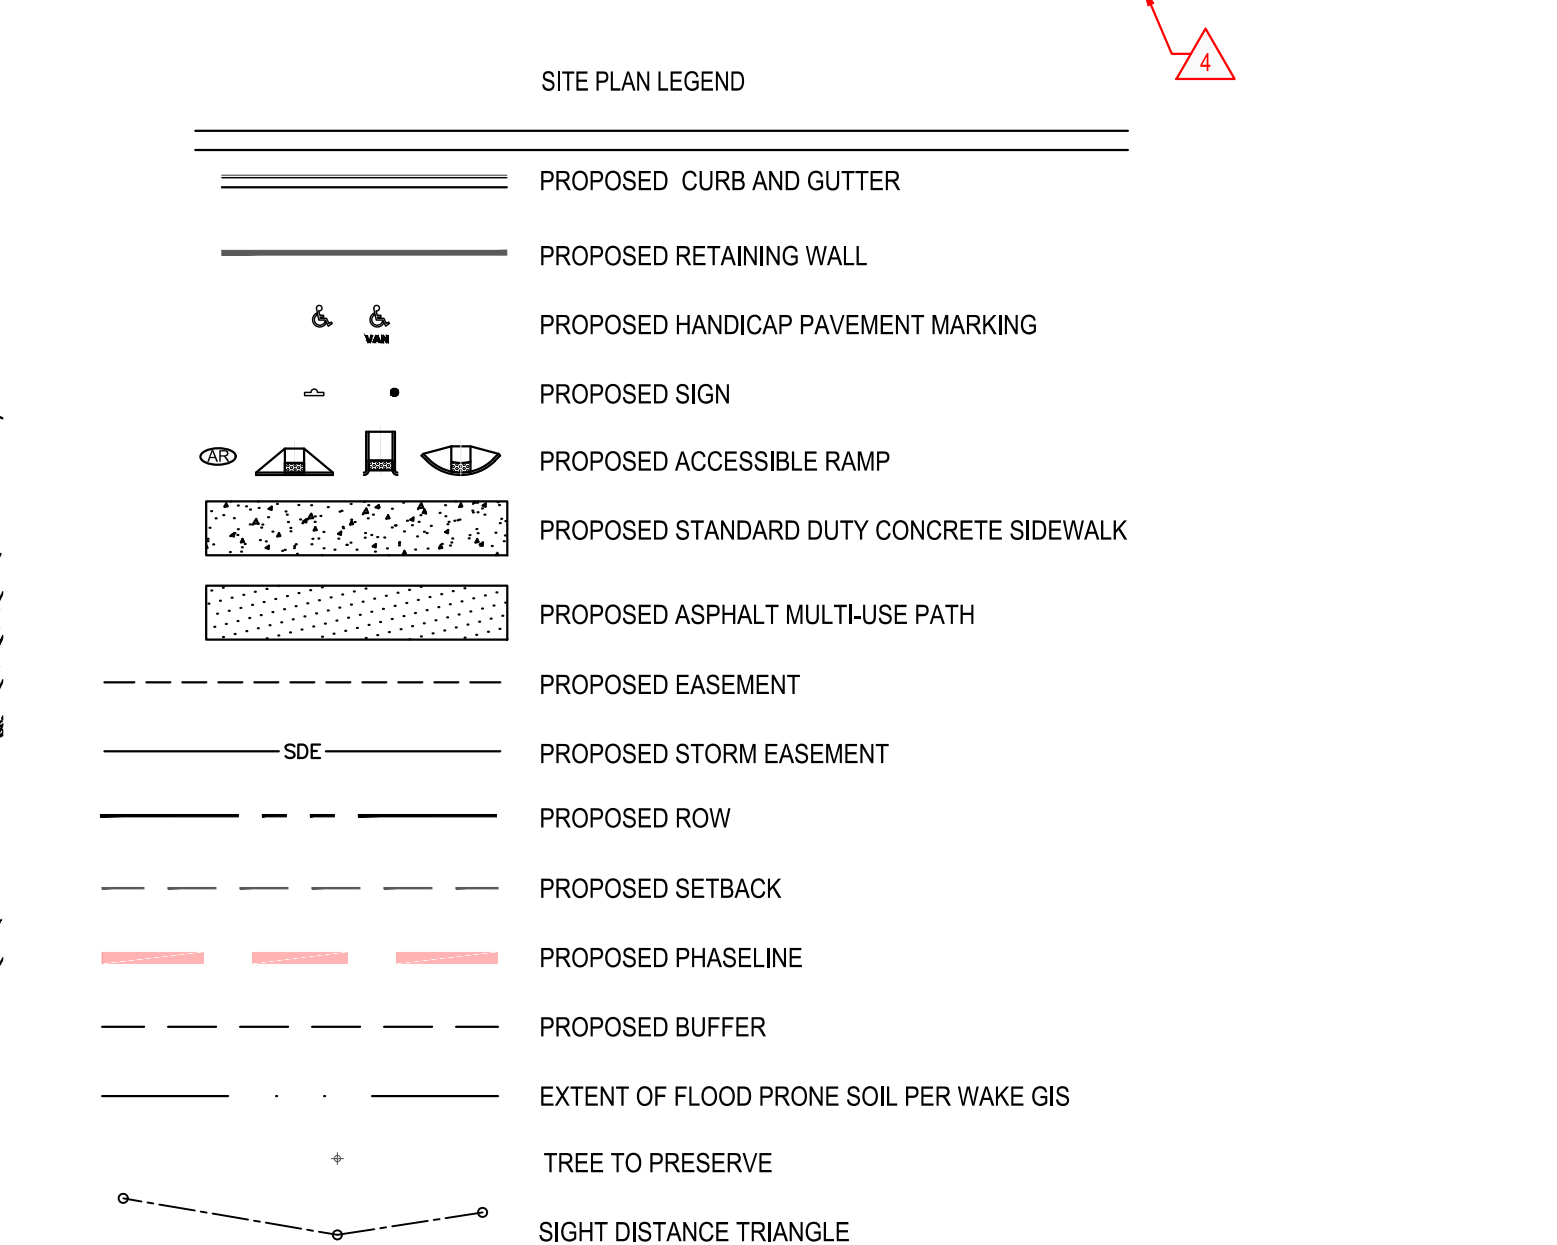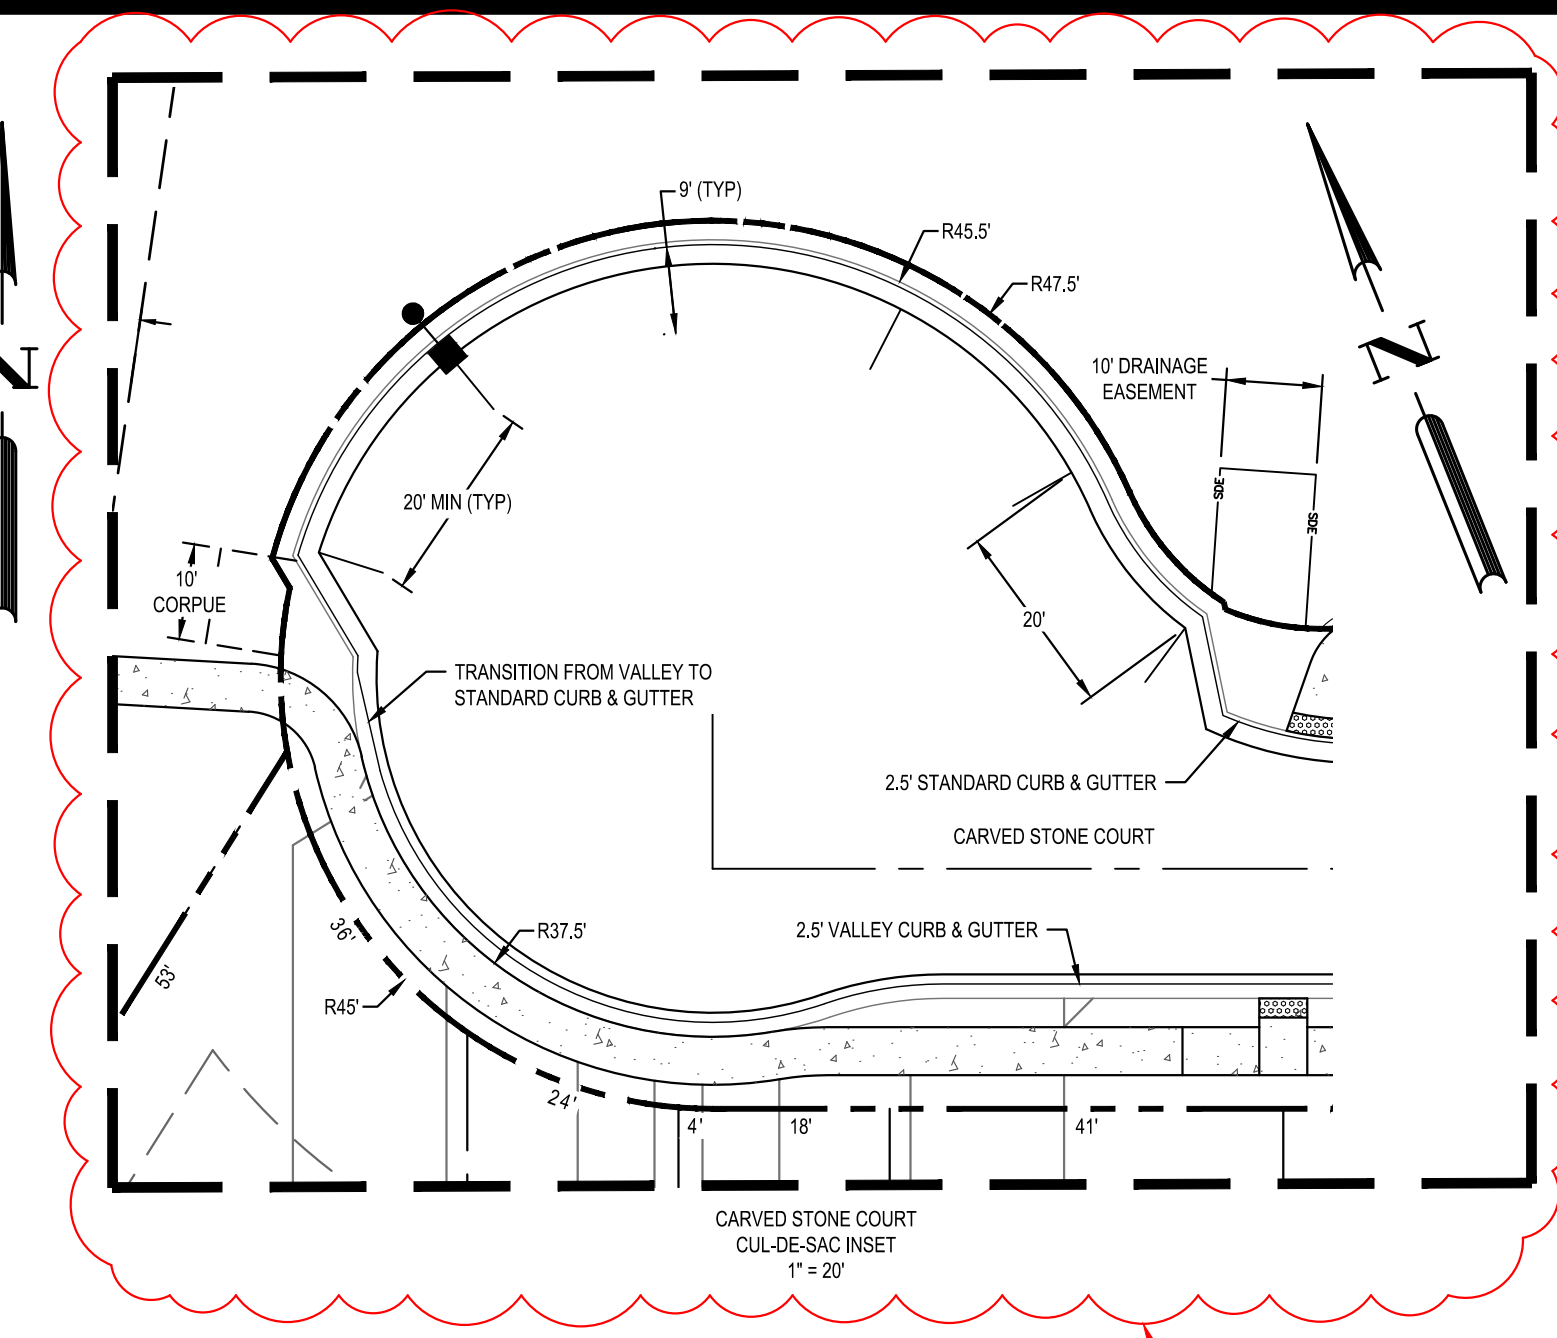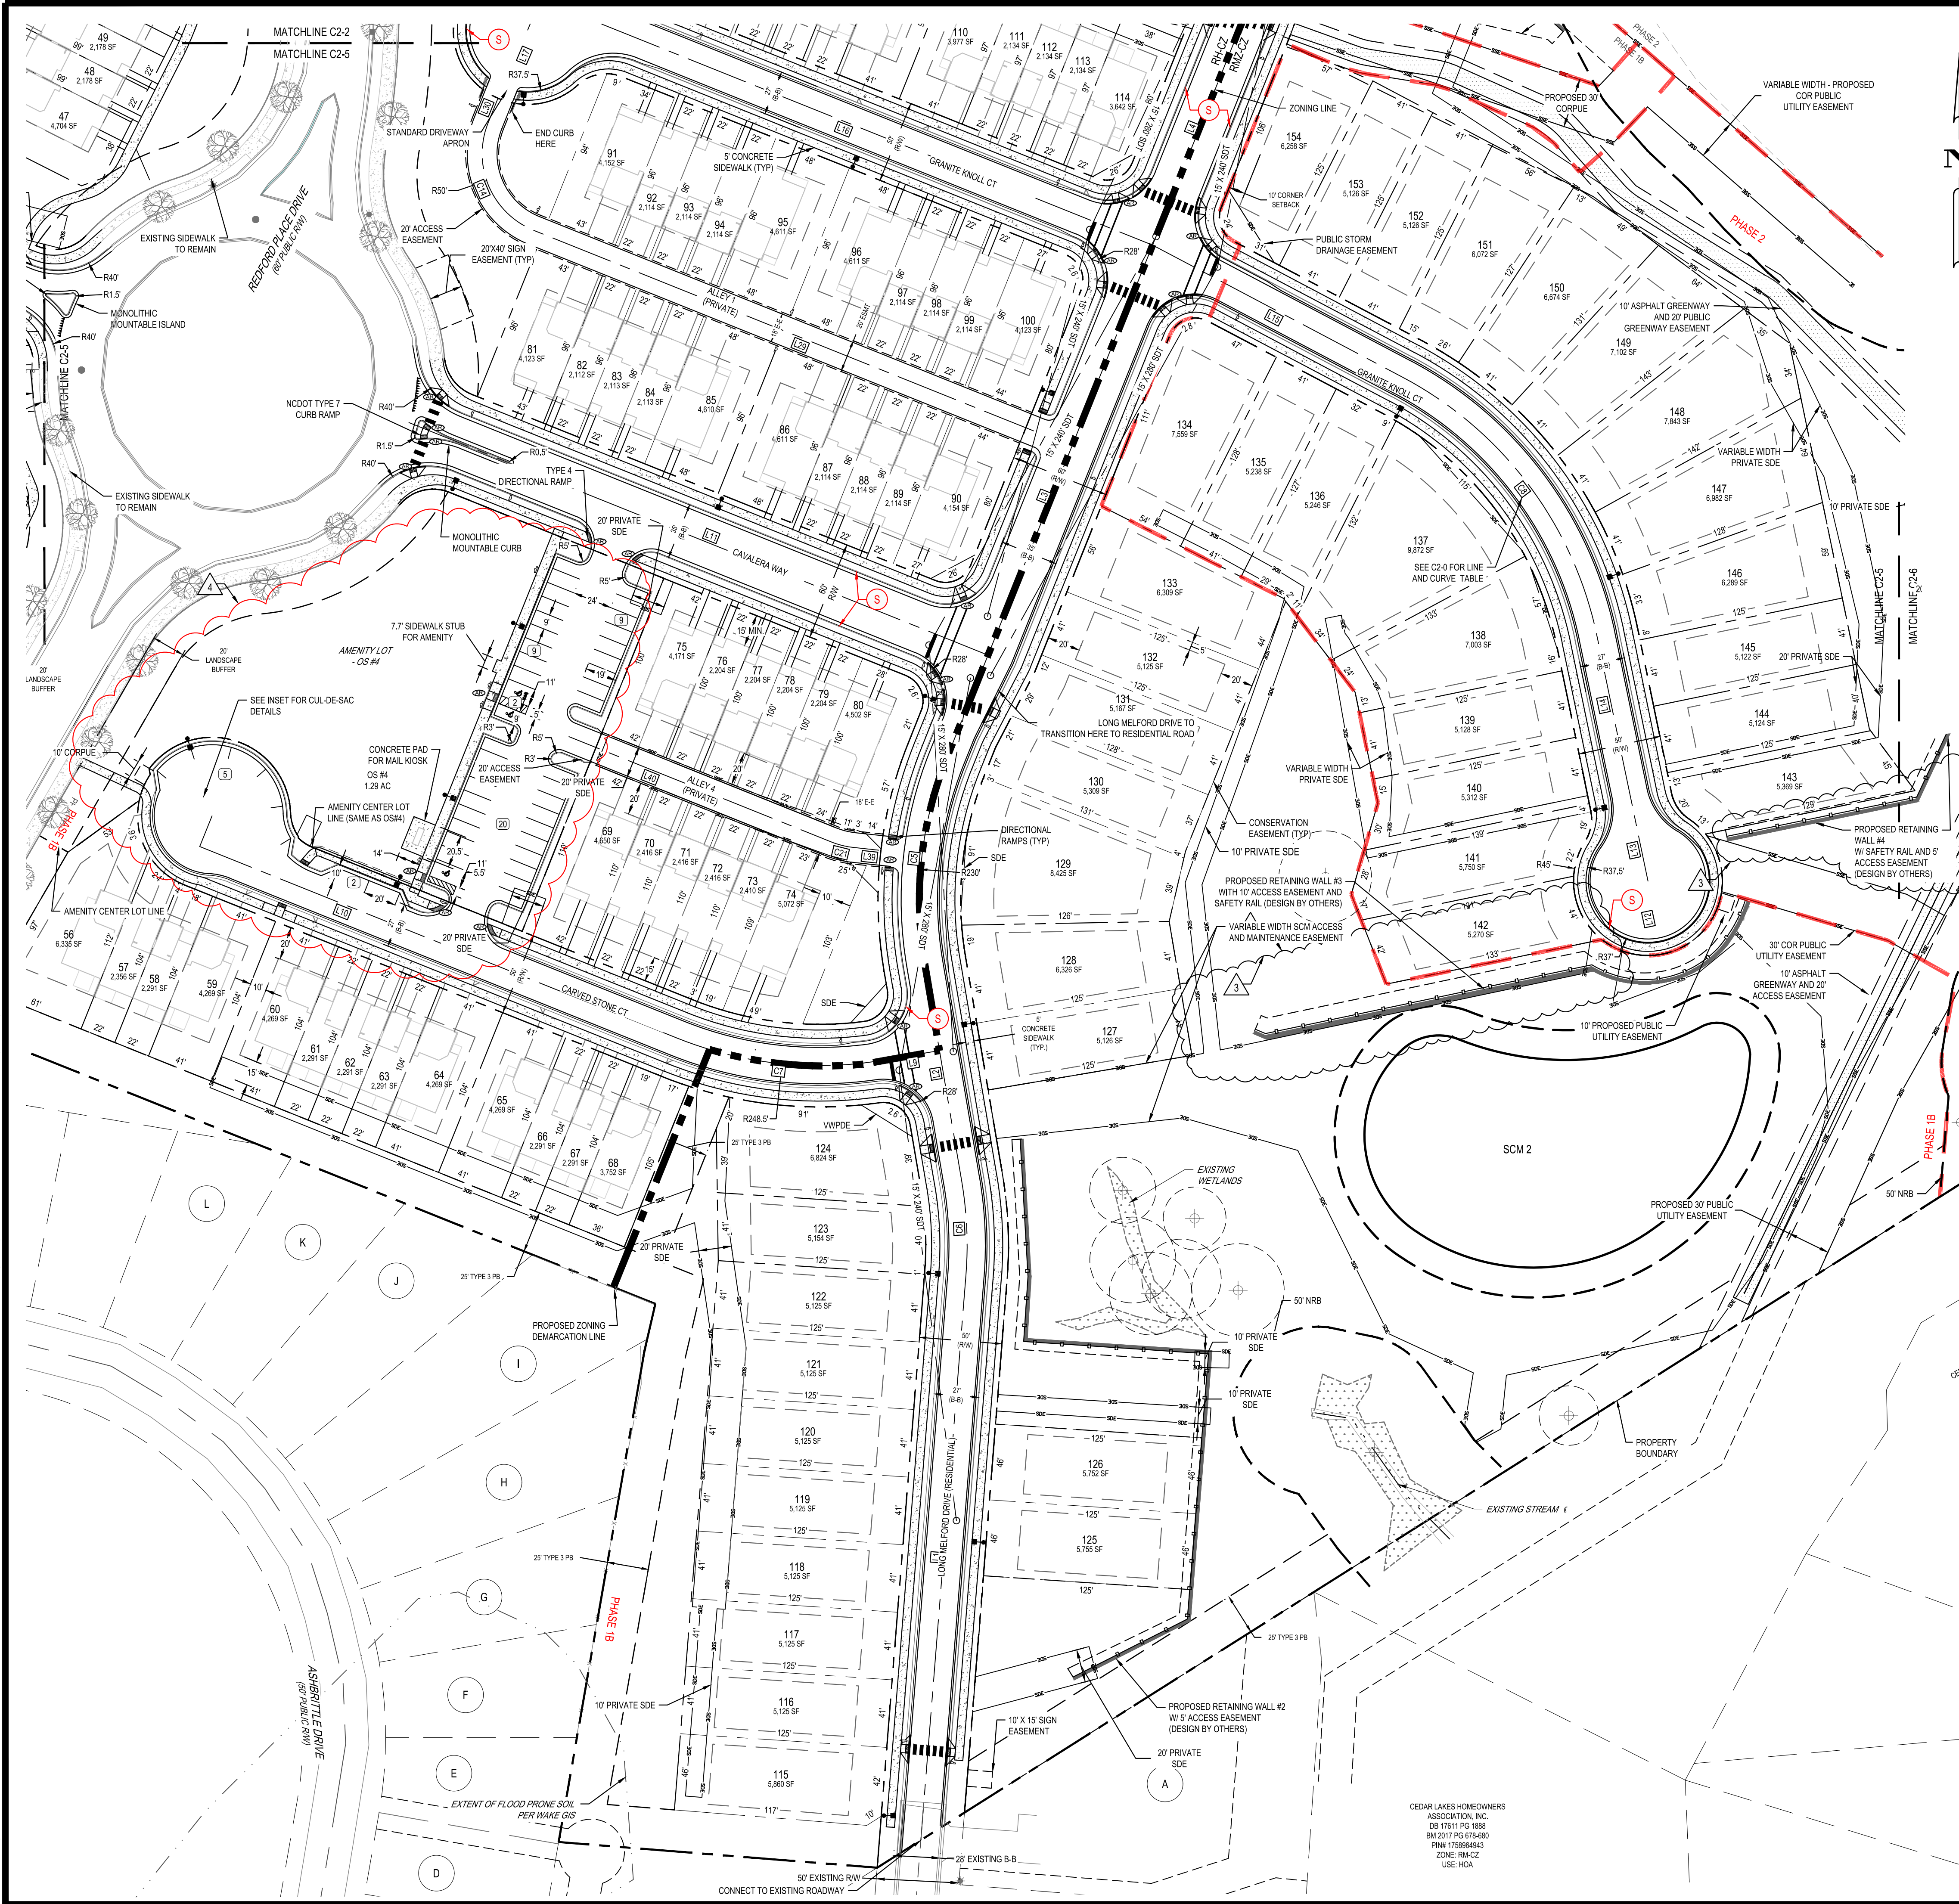

AMENITY CENTER LOT NOTES:  
1. OPEN SPACE #4 WILL BE A SEPARATE PARCEL THAT CONTAINS THE FUTURE AMENITY CENTER  
2. SIGNAGE TO BE PROVIDED FOR THE 6 SPACES THAT FRONT THE AMENITY CENTER  
SEE SHEET C2-8 FOR DETAILS REGARDING SIGNAGE.

| CURB LEGEND |                            |
|-------------|----------------------------|
| (S)         | 30" STANDARD CURB & GUTTER |
| (V)         | 30" VALLEY CURB & GUTTER   |

0 25' 50' 100'  
SCALE: 1" = 50'

811  
Know what's below.  
Call before you dig.

| SUBPHASING, SEWER, & CURB TYPES |                                  |
|---------------------------------|----------------------------------|
| 03/24/2025                      | AMENITY CENTER REVISIONS         |
| 11/04/2024                      | RETAINING WALL LOCATION REVISION |
| 06/06/2024                      | STORM STRUCTURE REVISIONS        |
| 06/04/2024                      | EROSION CONTROL REVISION         |
| 04/08/2024                      |                                  |
| REV                             | DATE                             |

| DESIGNED BY: | DF/CD  |
|--------------|--------|
| DRAWN BY:    | DF/JWM |
| REVIEWED BY: | DF     |

**BCE**  
5438 WADE PARK BLVD, SUITE 420  
RALEIGH NC 27607  
WWW.BCEINC.COM  
NC LICENSE #C-4397

**LENNAR**  
**CORPORAION**  
1100 PERIMETER PARK DRIVE, SUITE 112  
MORRISVILLE / NORTH CAROLINA / 27560


**PARKER RIDGE**  
82 SCHOOL STREET  
ROLESVILLE / NORTH CAROLINA / 27571

**ENLARGED SITE PLAN**  
(5 OF 6)

**FILE NUMBER:**  
8430-03  
**DATE:** 3/24/2025

**C2-5**



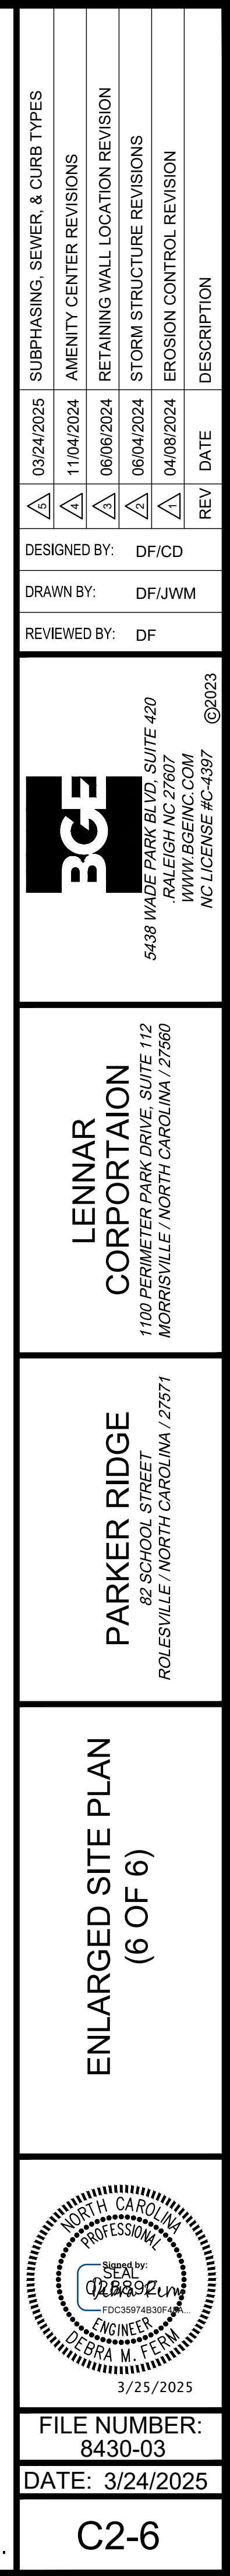





03/24/2025  
11/04/2024  
06/06/2024  
06/04/2024  
04/08/2024

SUBPHASING, SEWER, & CURB TYPES  
AMENITY CENTER REVISIONS  
RETAINING WALL LOCATION REVISION  
STORM STRUCTURE REVISIONS  
EROSION CONTROL REVISION

DESIGNED BY: DF/CD  
DRAWN BY: DF/JWM  
REVIEWED BY: DF

DATE  
REV  
DESCRIPTION

BCE

5438 WADE PARK BLVD, SUITE 420  
RALEIGH NC 27607  
WWW.BCEINC.COM  
NC LICENSE #C-4397

LENNAR  
CORPORAION  
1100 PERIMETER PARK DRIVE, SUITE 112  
MORRISVILLE / NORTH CAROLINA / 27560

PARKER RIDGE  
82 SCHOOL STREET  
ROLESVILLE / NORTH CAROLINA / 27571


PHASING PLAN

NORTH CAROLINA  
PROFESSIONAL  
ENGINEER  
3/25/2025


FILE NUMBER:  
8430-03  
DATE: 3/24/2025

C2-7



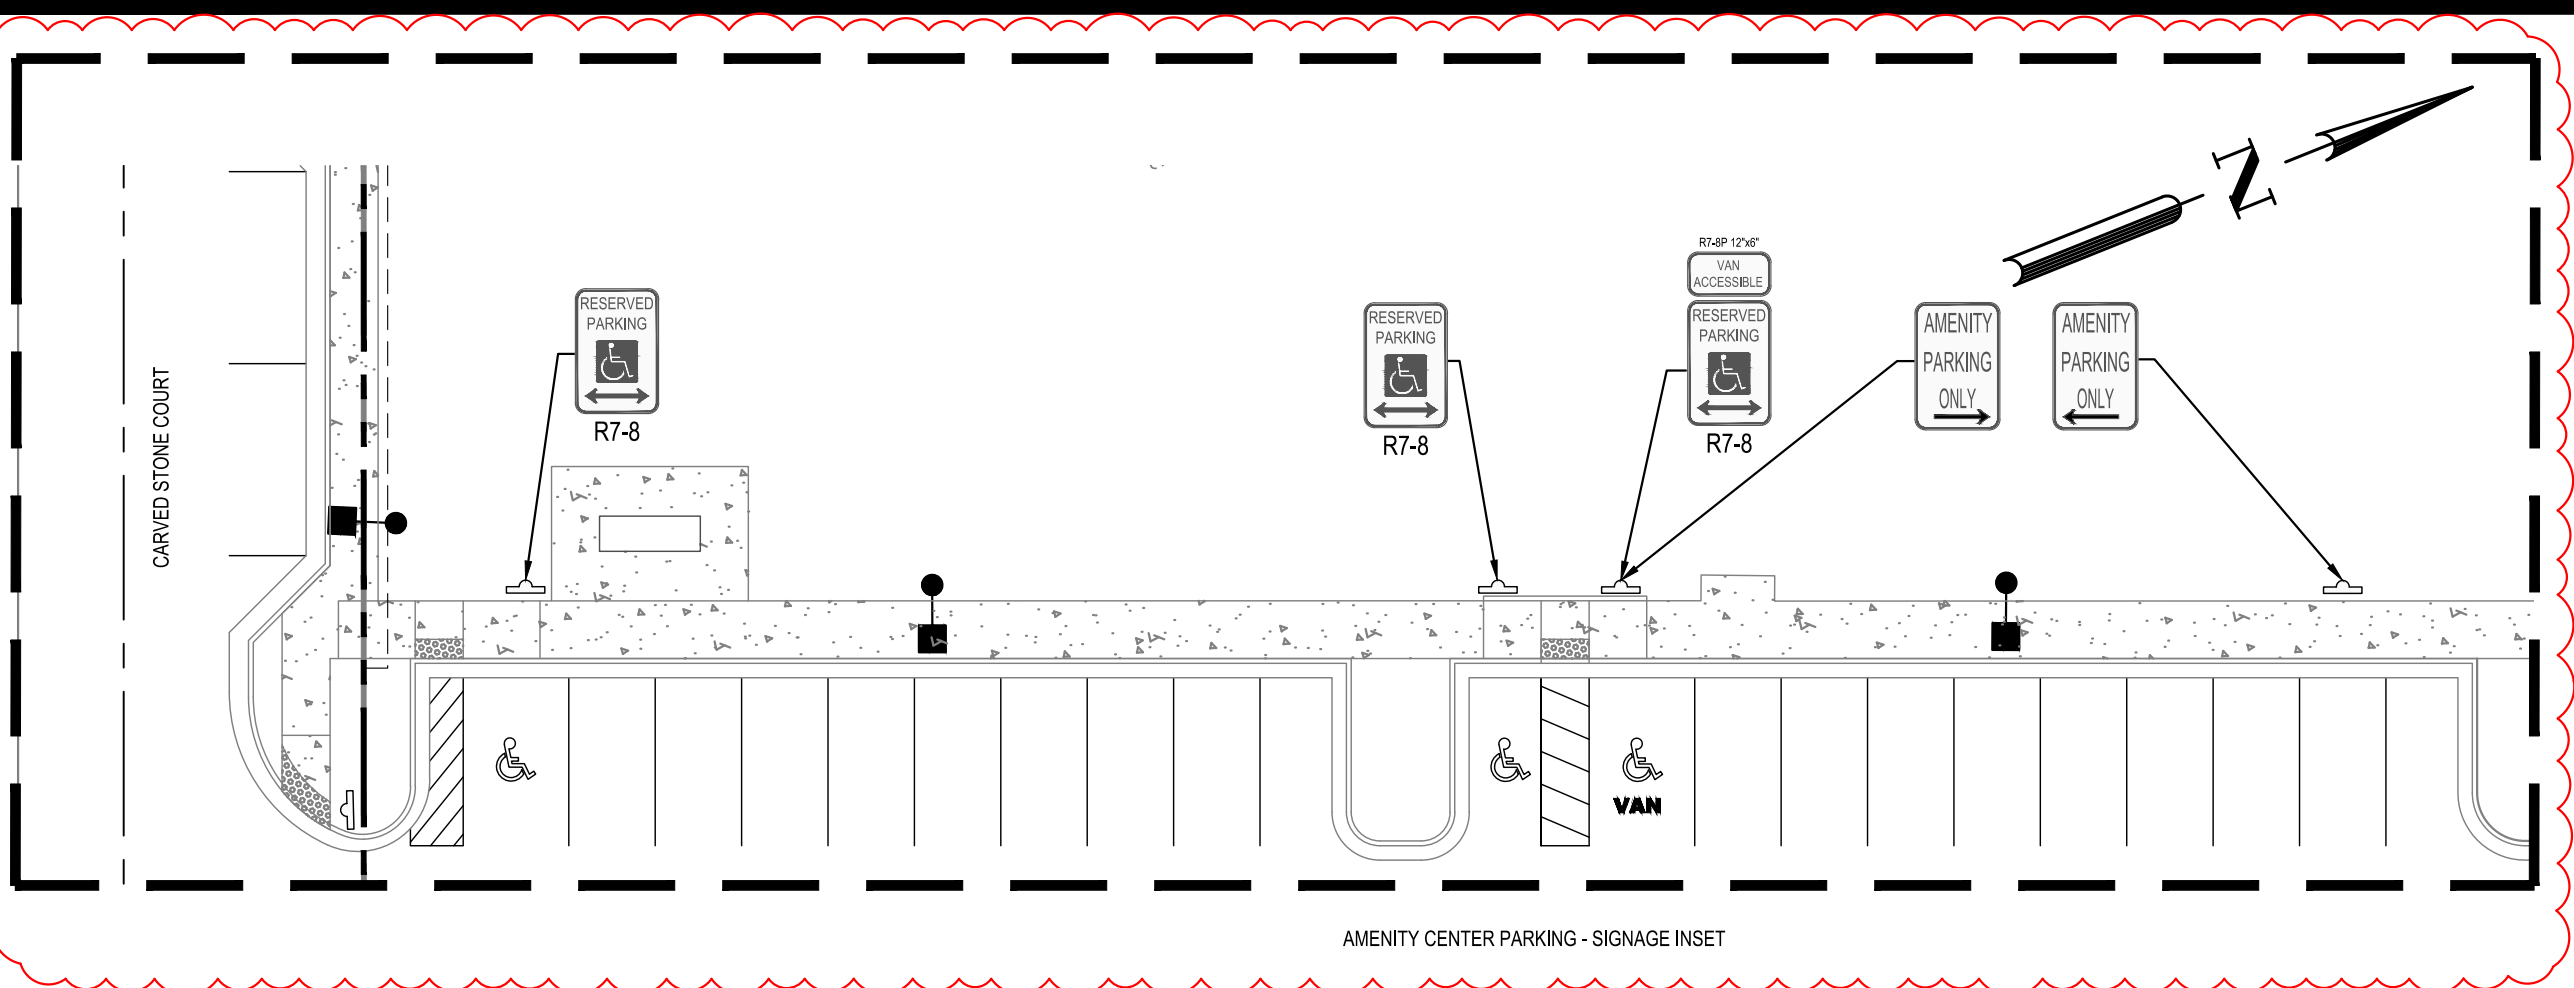

AMENITY CENTER PARKING - SIGNAGE INSET

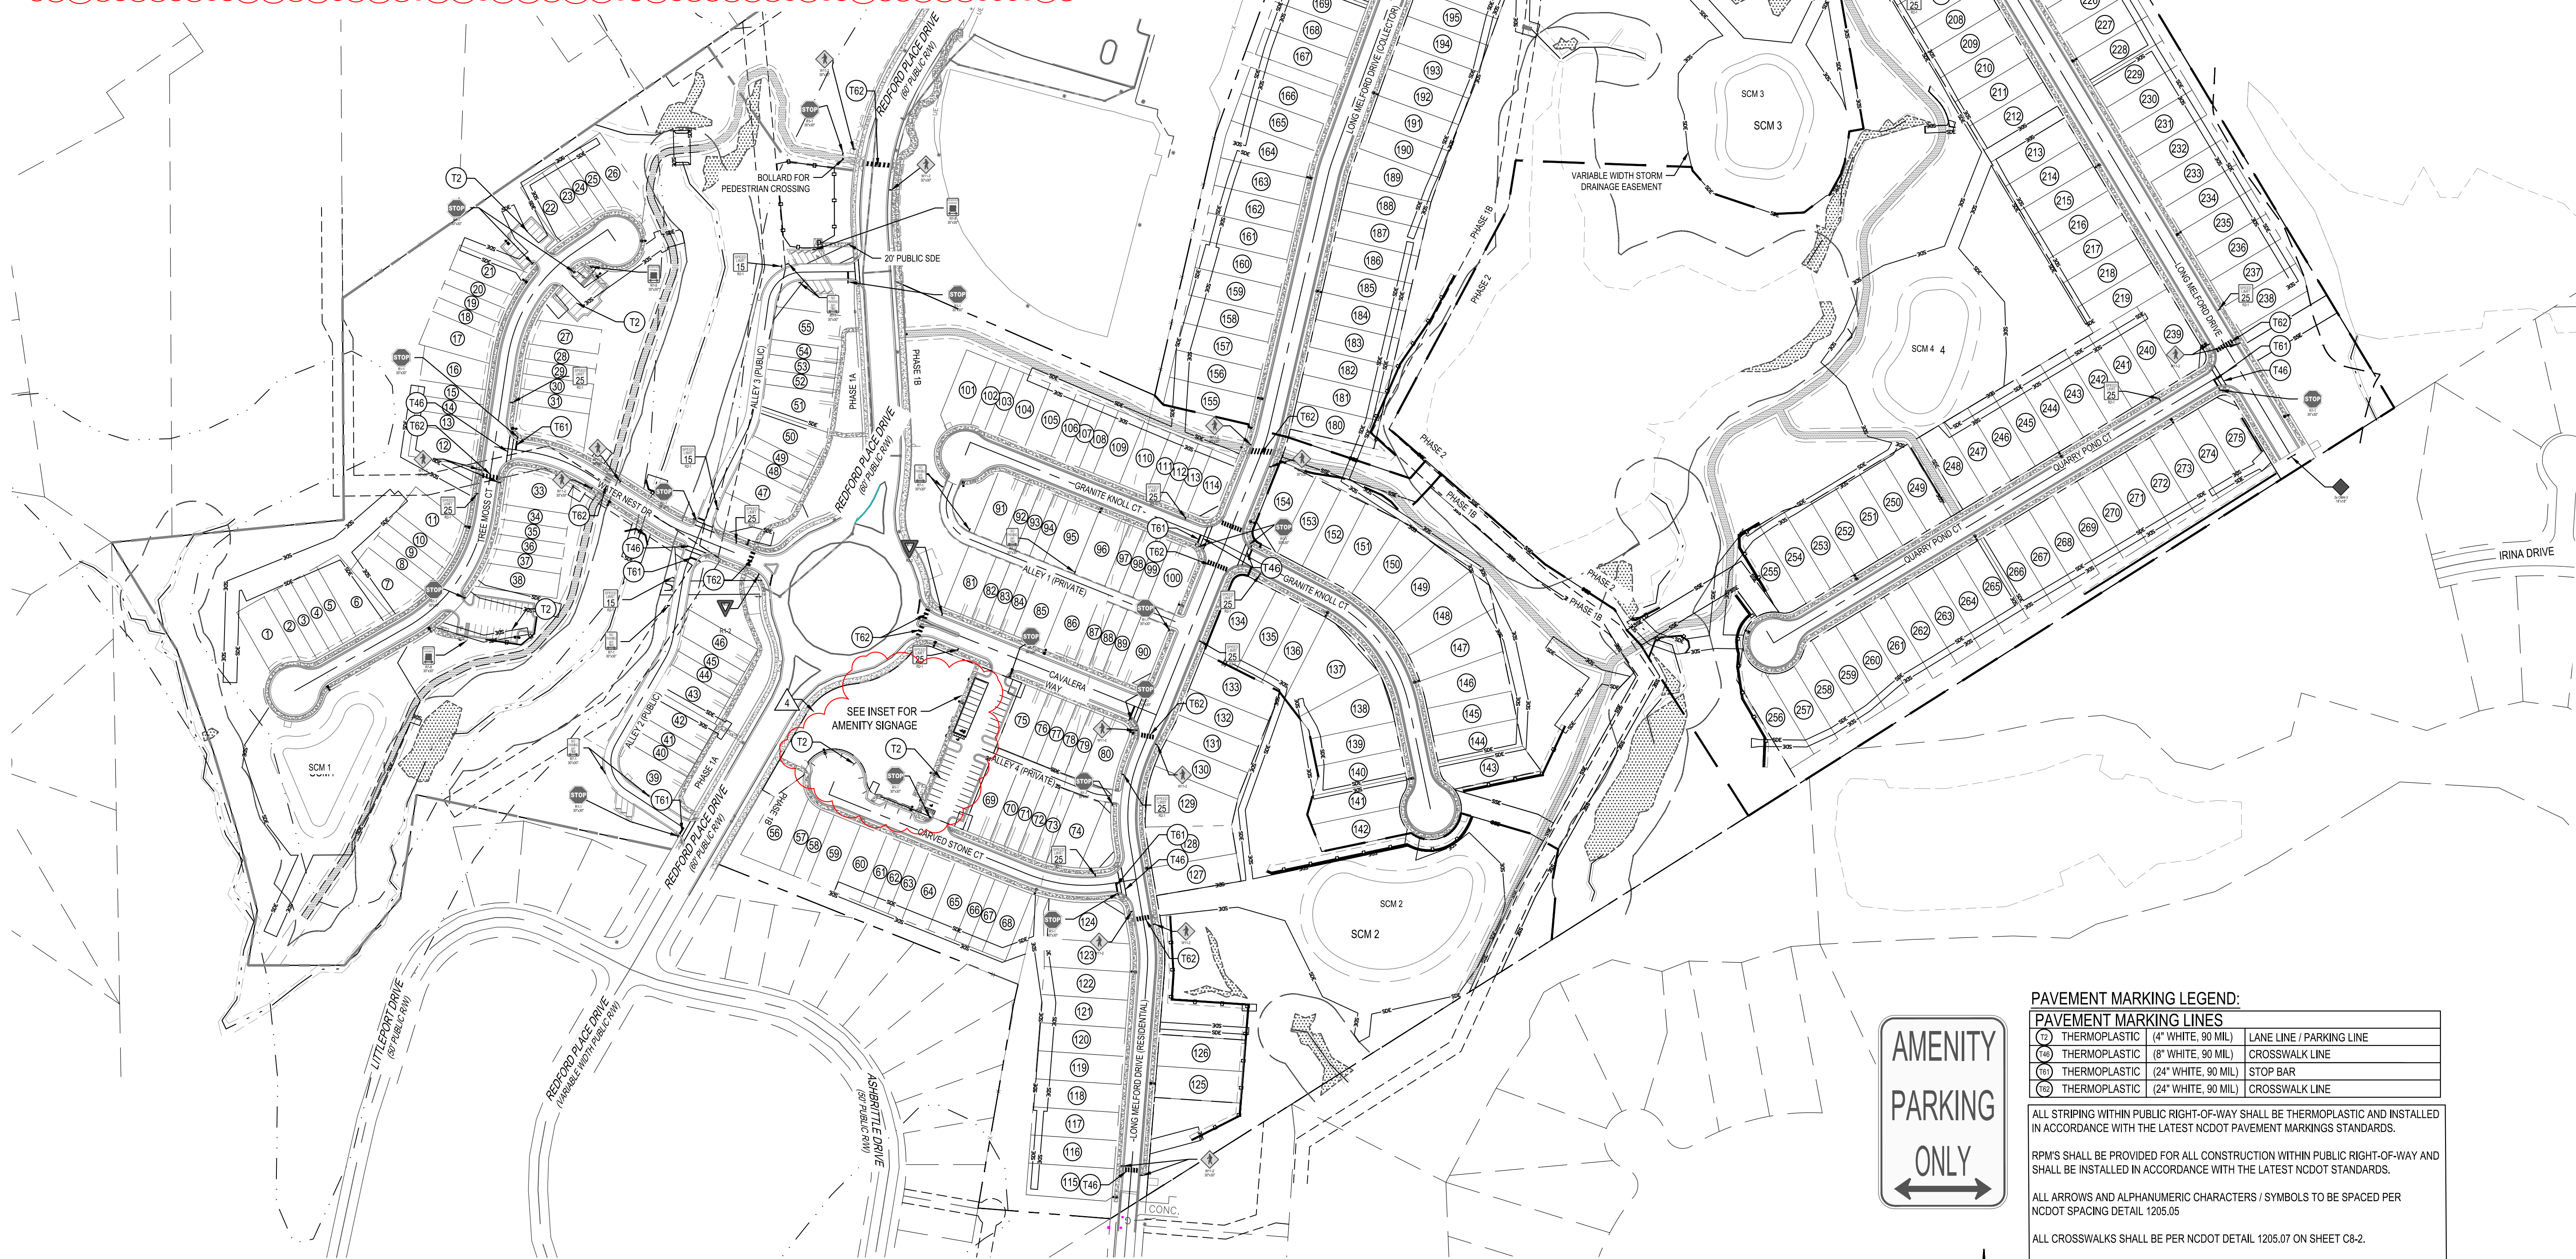

PAVEMENT MARKING LEGEND:

| PAVEMENT MARKING LINES |               |                                             |
|------------------------|---------------|---------------------------------------------|
| (T)                    | THERMOPLASTIC | (4" WHITE, 90 MIL) LANE LINE / PARKING LINE |
| (WB)                   | THERMOPLASTIC | (8" WHITE, 90 MIL) CROSSWALK LINE           |
| (TB)                   | THERMOPLASTIC | (24" WHITE, 90 MIL) STOP BAR                |
| (T2)                   | THERMOPLASTIC | (24" WHITE, 90 MIL) CROSSWALK LINE          |

ALL STRIPING WITHIN PUBLIC RIGHT-OF-WAY SHALL BE THERMOPLASTIC AND INSTALLED IN ACCORDANCE WITH THE LATEST NCDOT PAVEMENT MARKINGS STANDARDS.

RPM'S SHALL BE PROVIDED FOR ALL CONSTRUCTION WITHIN PUBLIC RIGHT-OF-WAY AND SHALL BE INSTALLED IN ACCORDANCE WITH THE LATEST NCDOT STANDARDS.

ALL ARROWS AND ALPHANUMERIC CHARACTERS / SYMBOLS TO BE SPACED PER NCDOT SPACING DETAIL 1205.05

ALL CROSSWALKS SHALL BE PER NCDOT DETAIL 1205.07 ON SHEET C8-2.



03/24/2025

11/04/2024

06/06/2024

06/04/2024

04/08/2024

SUBPHASING, SEWER, & CURB TYPES

AMENITY CENTER REVISIONS

RETAINING WALL LOCATION REVISION

STORM STRUCTURE REVISIONS

EROSION CONTROL REVISION

△

△

△

△

△

DESIGNED BY:

DRAWN BY:

REVIEWED BY:

DF/CD

DF/JWM

DF

BCE

5438 WADE PARK BLVD, SUITE 420  
RALEIGH NC 27607  
WWW.BCEINC.COM  
NC LICENSE #C-4397

LENNAR

CORPORAION

1100 PERIMETER PARK DRIVE, SUITE 112  
MORRISVILLE / NORTH CAROLINA / 27560

SIGNAGE AND STRIPING

PLAN

NORTH CAROLINA

PROFESSIONAL

SEAL BY

3/25/2025

ENGINEER

DEBRA M. FERN

FILE NUMBER:


DATE:

8430-03

3/24/2025

C2-8



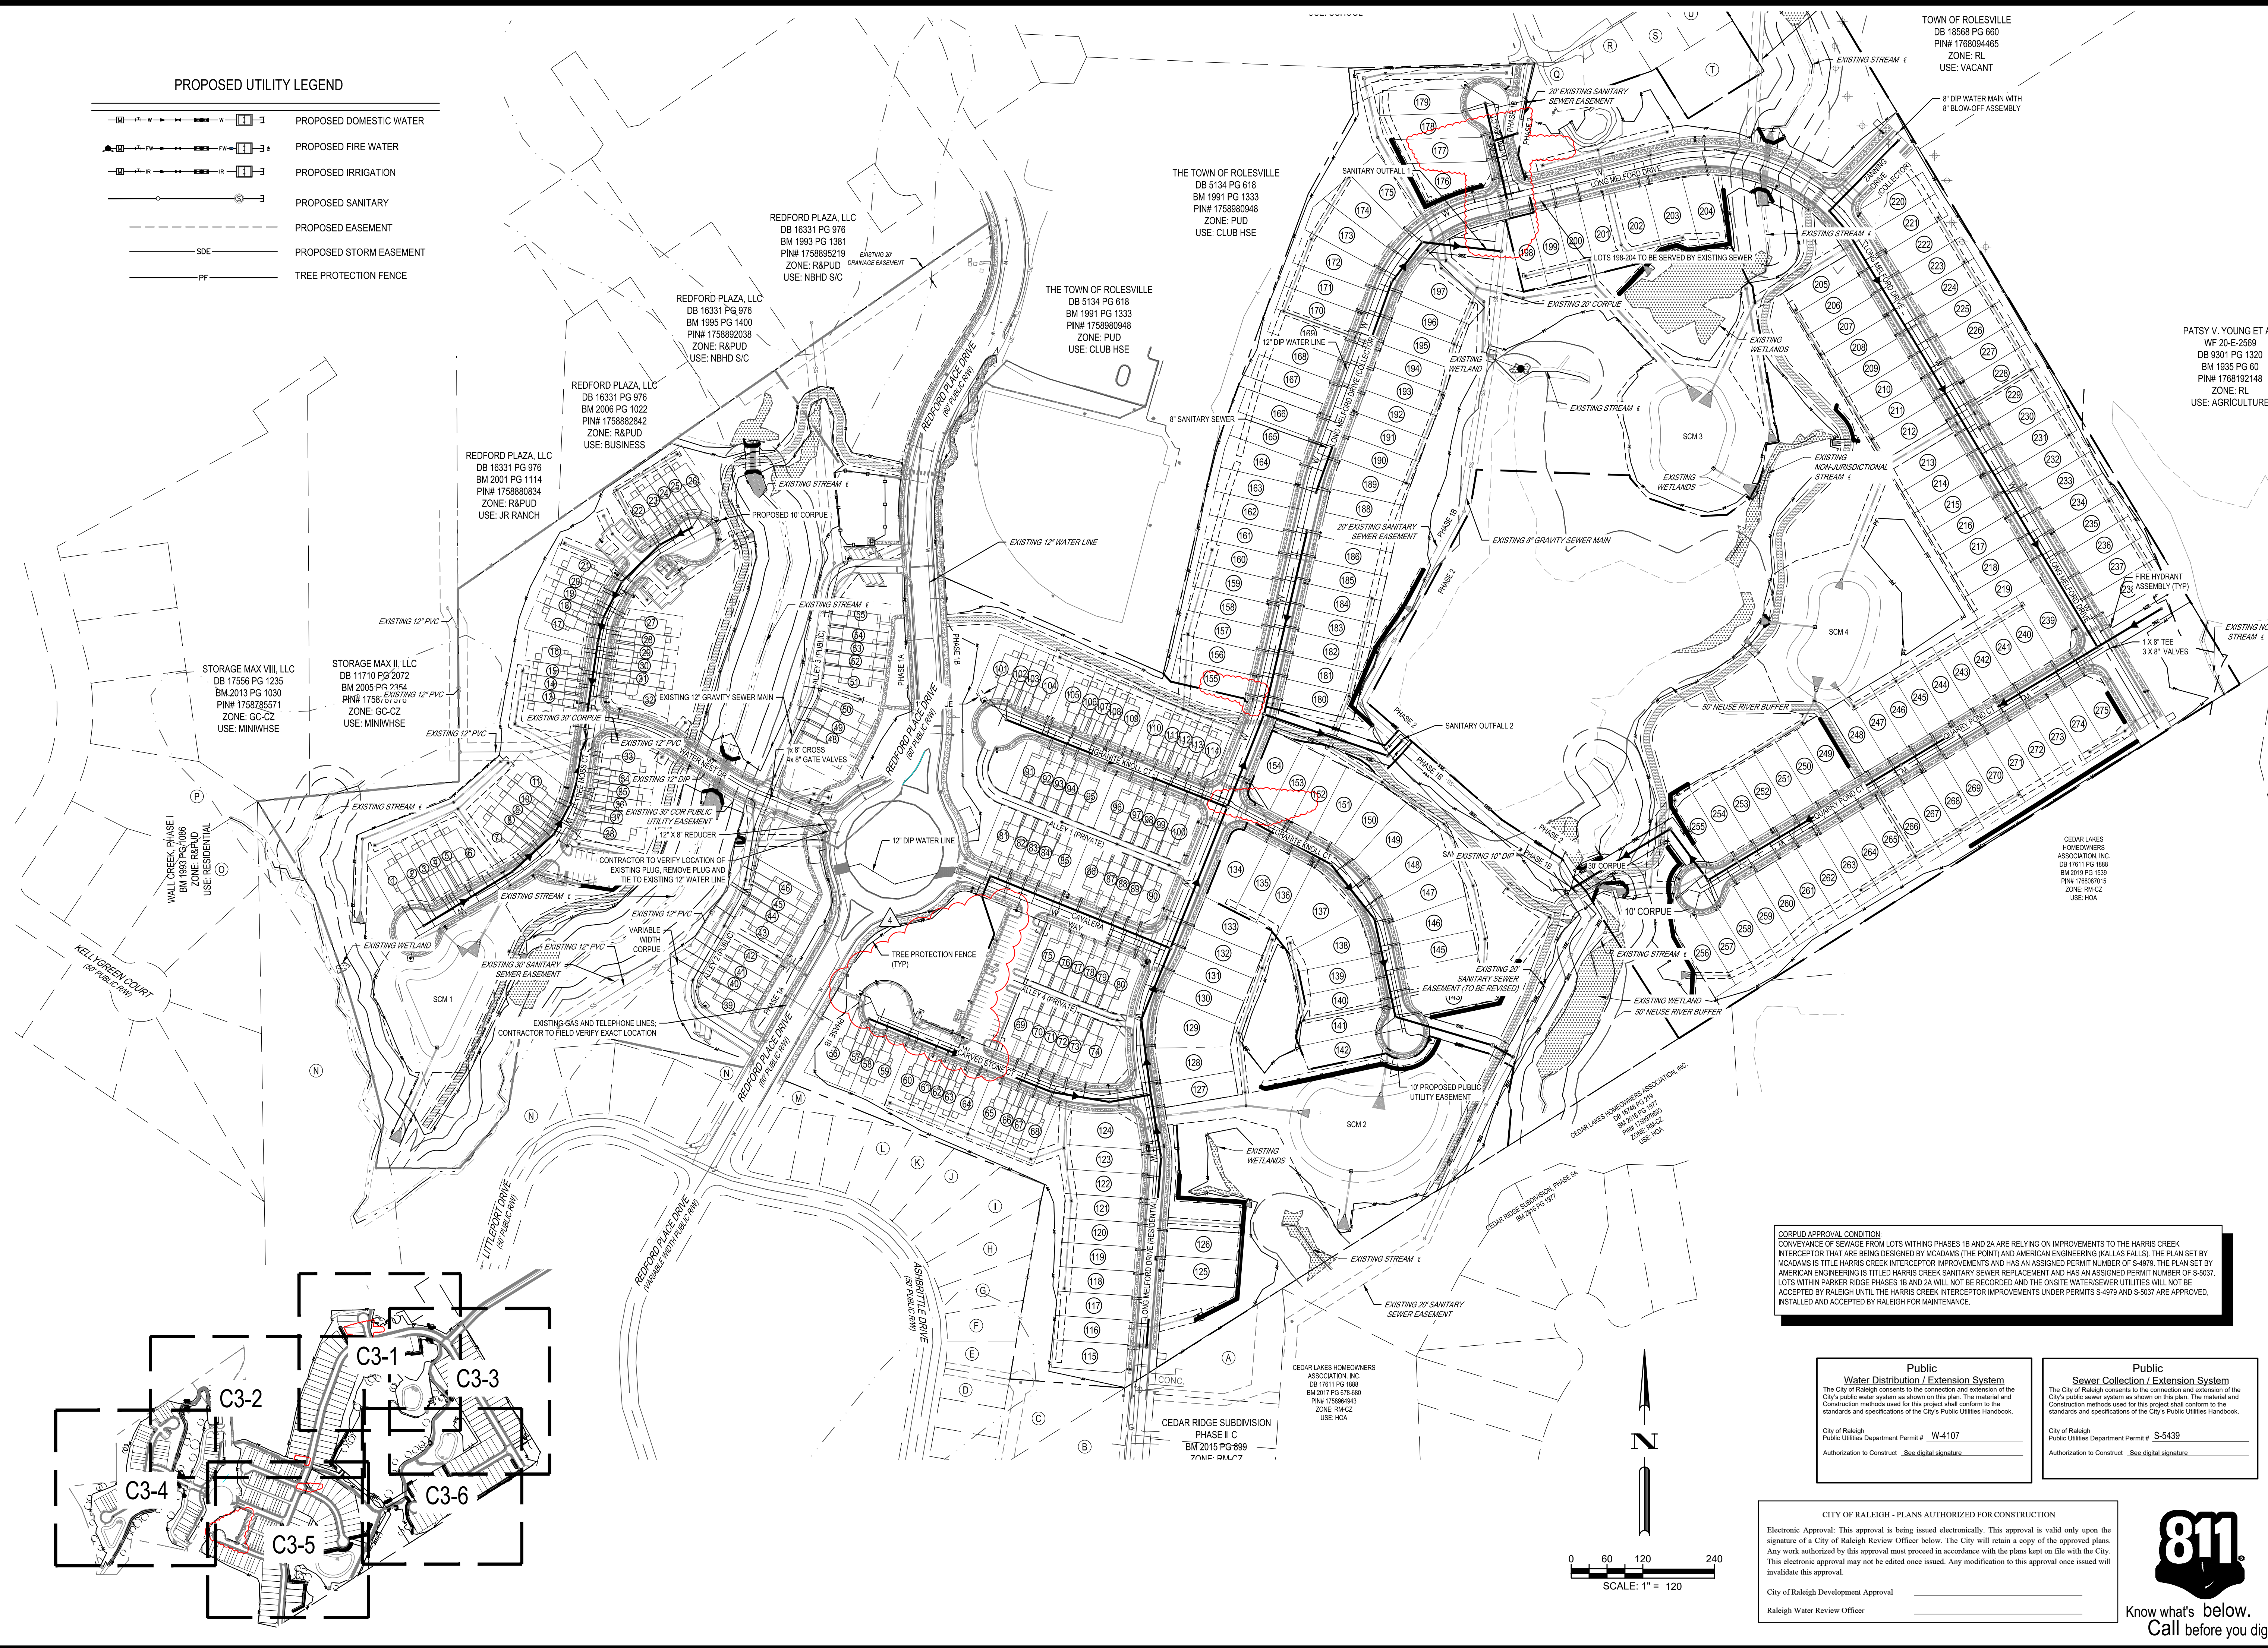

**CORPUS APPROVAL CONDITION:**  
CONVEYANCE OF SEWAGE FROM LOTS WITHIN PHASES 1B AND 2A ARE RELYING ON IMPROVEMENTS TO THE HARRIS CREEK INTERCEPTOR THAT ARE BEING DESIGNED BY MACADAMS (THE POINT) AND AMERICAN ENGINEERING (KALLAS FALLS). THE PLAN SET BY MACADAMS IS TITLED HARRIS CREEK INTERCEPTOR IMPROVEMENTS AND HAS AN ASSIGNED PERMIT NUMBER OF S-4978. THE PLAN SET BY AMERICAN ENGINEERING IS TITLED HARRIS CREEK SANITARY SEWER REPLACEMENT AND HAS AN ASSIGNED PERMIT NUMBER OF S-5037. LOTS WITHIN PARKER RIDGE PHASES 1B AND 2A WILL NOT BE RECORDED AND THE ONSITE WATERSSEWER UTILITIES WILL NOT BE ACCEPTED BY RALEIGH UNTIL THE HARRIS CREEK INTERCEPTOR IMPROVEMENTS UNDER PERMITS S-4978 AND S-5037 ARE APPROVED, INSTALLED AND ACCEPTED BY RALEIGH FOR MAINTENANCE.

| Public<br>Water Distribution / Extension System   | Public<br>Sewer Collection / Extension System   |
|---|---|
| The City of Raleigh consents to the connection and extension of the City's public water system as shown on this plan. The material and Construction methods used for this project shall conform to the standards and specifications of the City's Public Utilities Handbook. | The City of Raleigh consents to the connection and extension of the City's public sewer system as shown on this plan. The material and Construction methods used for this project shall conform to the standards and specifications of the City's Public Utilities Handbook. |
| City of Raleigh<br>Public Utilities Department Permit # <b>W-4107</b><br>Authorization to Construct: <u>See digital signature</u>   | City of Raleigh<br>Public Utilities Department Permit # <b>S-5439</b><br>Authorization to Construct: <u>See digital signature</u>   |

**CITY OF RALEIGH - PLANS AUTHORIZED FOR CONSTRUCTION**  
Electronic Approval: This approval is being issued electronically. This approval is valid only upon the signature of a City of Raleigh Review Officer below. The City will retain a copy of the approved plans. Any work authorized by this approval must proceed in accordance with the plans kept on file with the City. This electronic approval may not be edited once issued. Any modification to this approval once issued will invalidate this approval.  
City of Raleigh Development Approval \_\_\_\_\_  
Raleigh Water Review Officer \_\_\_\_\_



| SUBPHASING, SEWER, & CURB TYPES |     | AMENITY CENTER REVISIONS |     | RETAINING WALL LOCATION REVISION |     | STORM STRUCTURE REVISIONS |     | EROSION CONTROL REVISION |     | DESCRIPTION |     |
|---------------------------------|-----|--------------------------|-----|----------------------------------|-----|---------------------------|-----|--------------------------|-----|-------------|-----|
| DATE                            | REV | DATE                     | REV | DATE                             | REV | DATE                      | REV | DATE                     | REV | DATE        | REV |
| 03/24/2025                      | 1   | 11/04/2024               | 1   | 06/06/2024                       | 1   | 06/04/2024                | 1   | 04/08/2024               | 1   |             |     |

DESIGNED BY: DFC/CD  
DRAWN BY: DFC/JWM  
REVIEWED BY: DFC

**LENNA**  
CORPORAION  
1100 PERMETER PARK DRIVE, SUITE 112  
MORRISVILLE / NORTH CAROLINA / 27560




**PARKER RIDGE**  
82 SCHOOL STREET  
ROLESVILLE / NORTH CAROLINA / 27571

**OVERALL UTILITY PLAN**

**FILE NUMBER:**  
8430-03  
**DATE:** 3/24/2025  
**C3-0**

**811**  
Know what's below.  
Call before you dig.



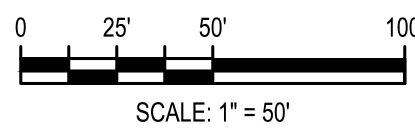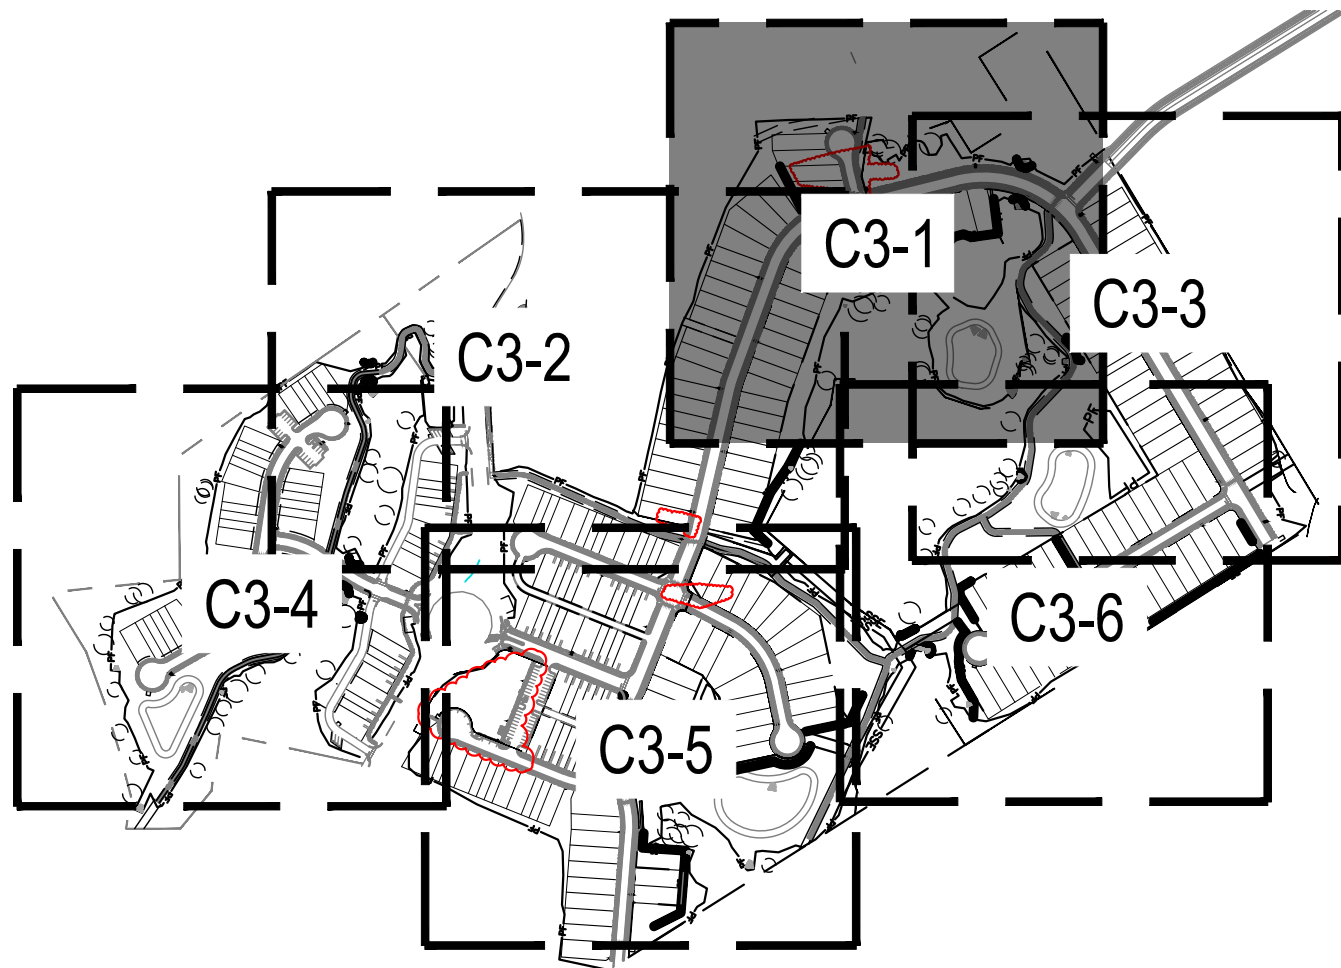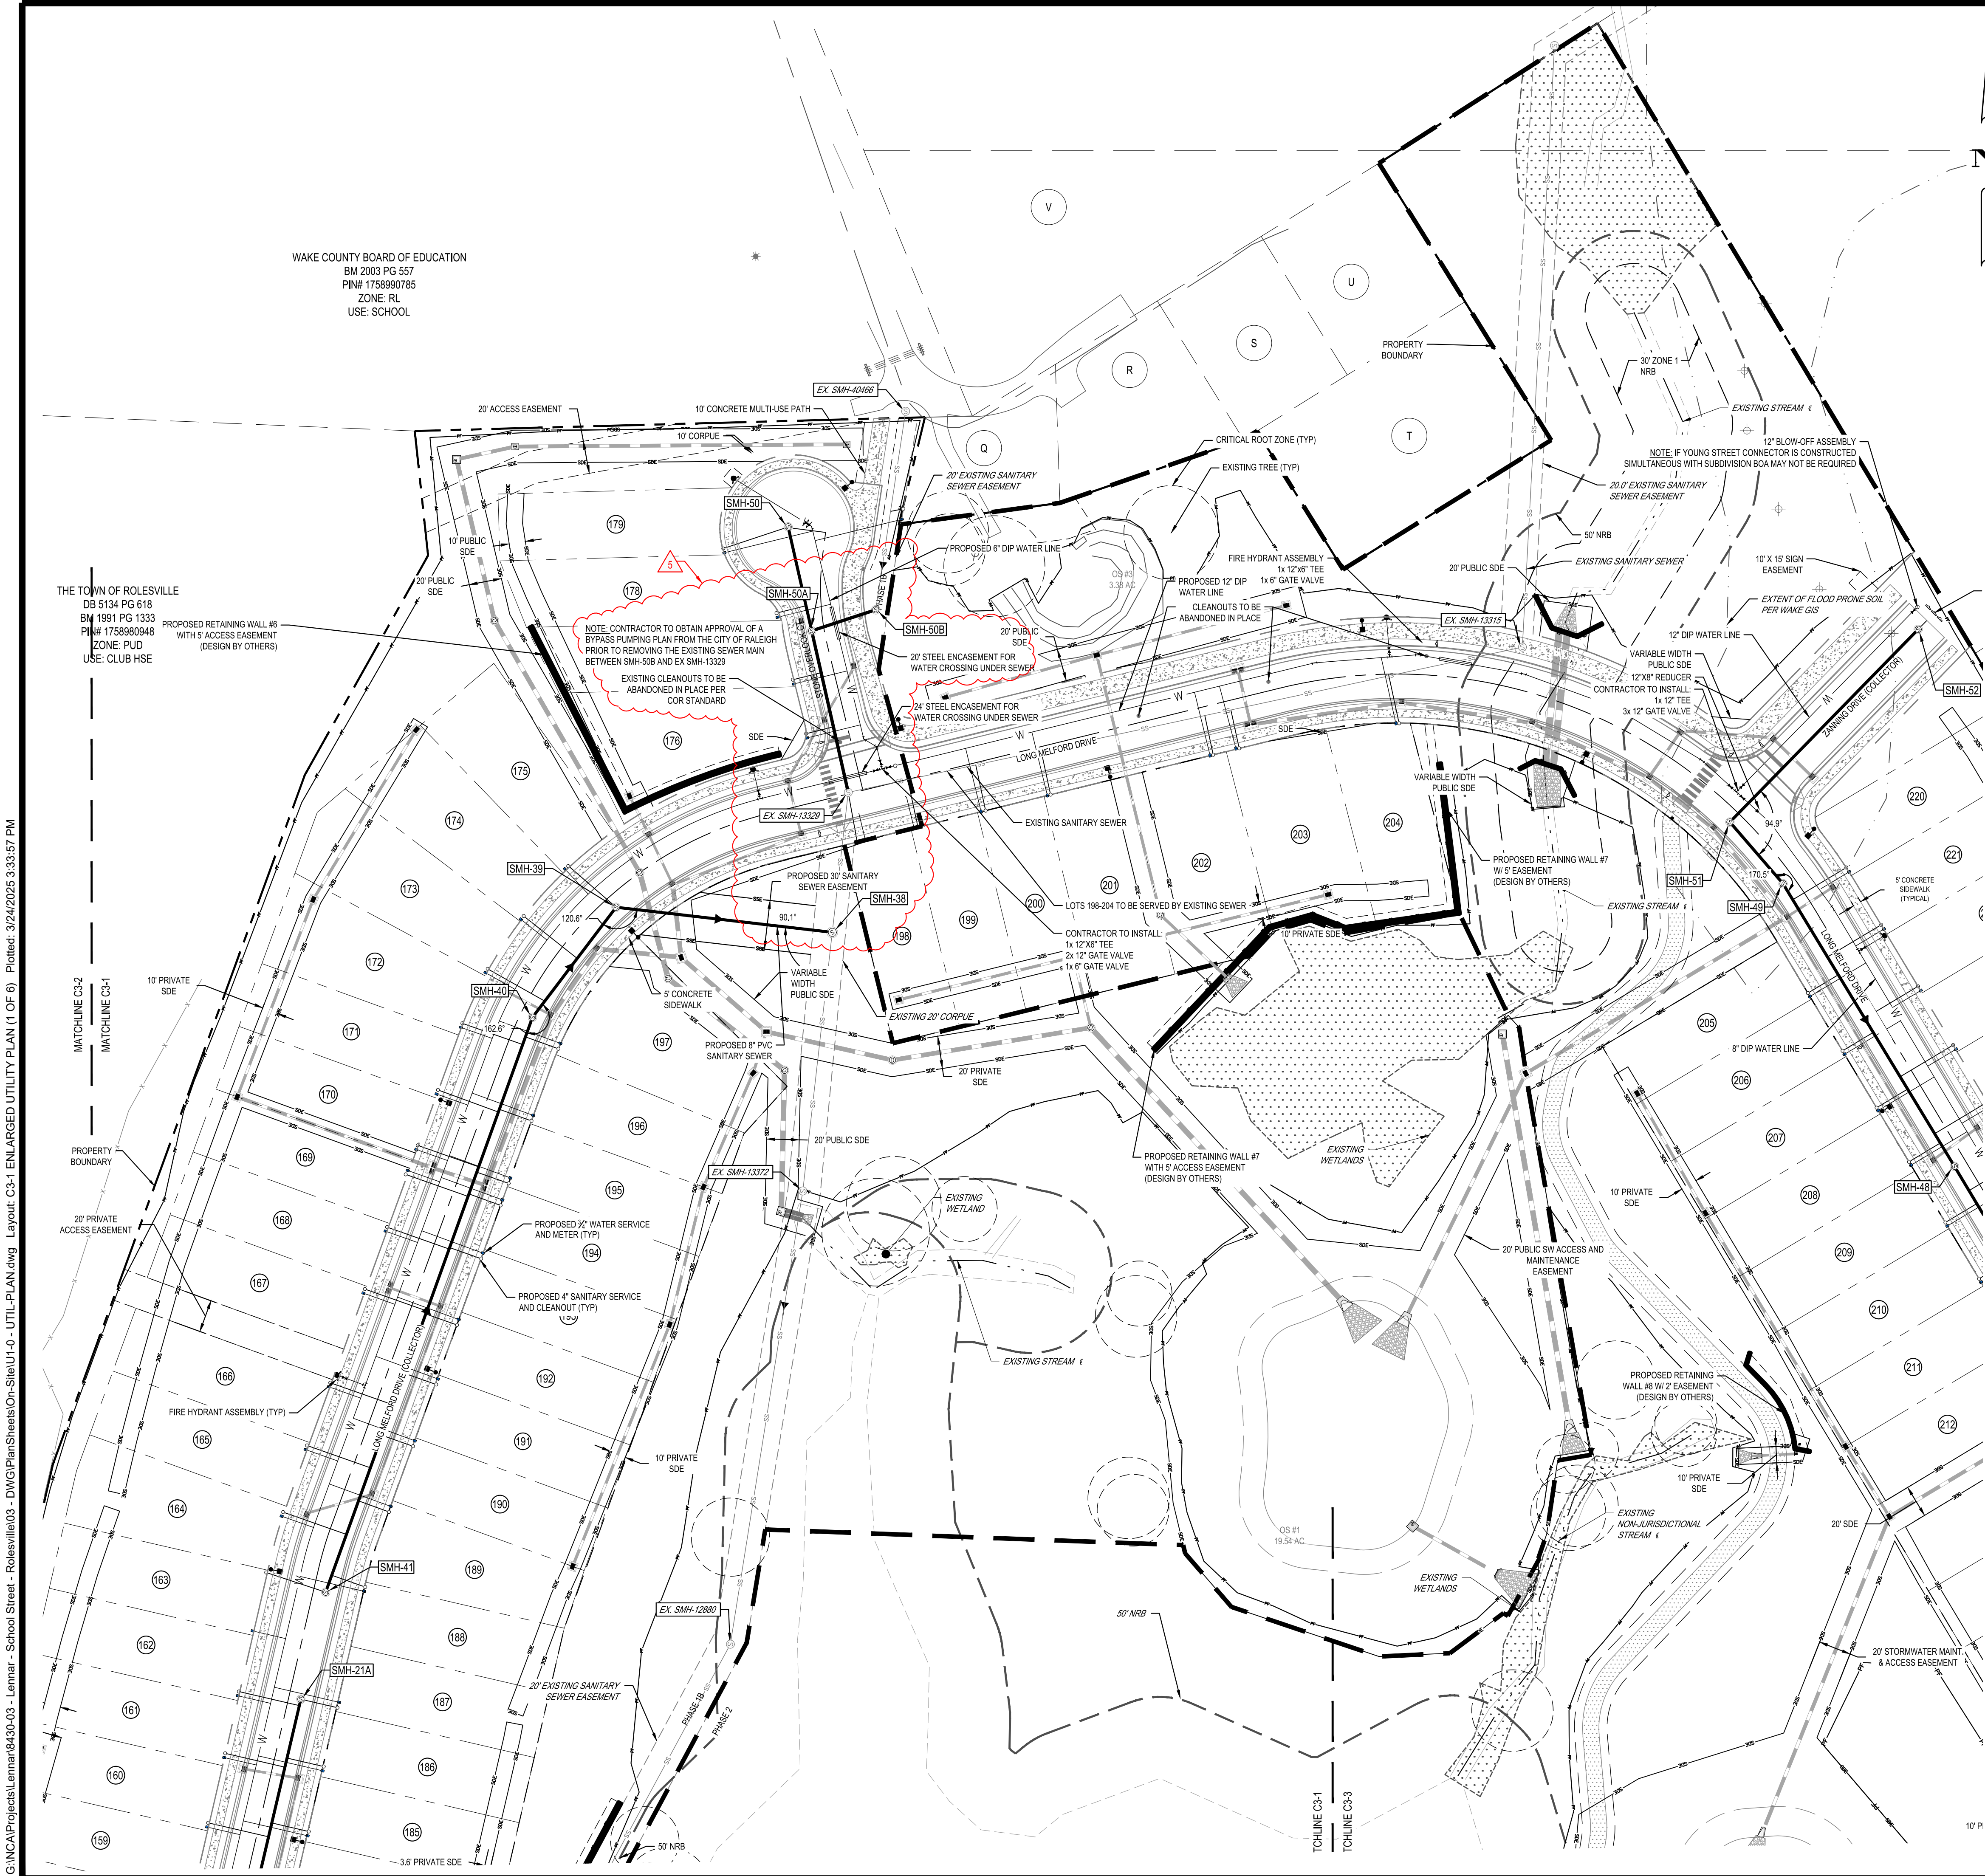

**Public**  
**Water Distribution / Extension System**  
The City of Raleigh consents to the connection and extension of the City's public water system as shown on this plan. The material and Construction methods used for this project shall conform to the standards and specifications of the City's Public Utilities Handbook.  
City of Raleigh  
Public Utilities Department Permit # W-4107  
Authorization to Construct: See digital signature


**Public**  
**Sewer Collection / Extension System**  
The City of Raleigh consents to the connection and extension of the City's public sewer system as shown on this plan. The material and Construction methods used for this project shall conform to the standards and specifications of the City's Public Utilities Handbook.  
City of Raleigh  
Public Utilities Department Permit # S-5439  
Authorization to Construct: See digital signature

**CITY OF RALEIGH - PLANS AUTHORIZED FOR CONSTRUCTION**  
Electronic Approval: This approval is being issued electronically. This approval is valid only upon the signature of a City of Raleigh Review Officer below. The City will retain a copy of the approved plans. Any work authorized by this approval must proceed in accordance with the plans kept on file with the City. This electronic approval may not be edited once issued. Any modification to this approval once issued will invalidate this approval.  
City of Raleigh Development Approval: \_\_\_\_\_  
Raleigh Water Review Officer: \_\_\_\_\_




|   |                                 |            |                          |            |                                  |            |                           |            |                          |                   |             |
|---|---------------------------------|------------|--------------------------|------------|----------------------------------|------------|---------------------------|------------|--------------------------|-------------------|-------------|
| 03/24/2025   | SUBPHASING, SEWER, & CURB TYPES | 11/04/2024 | AMENITY CENTER REVISIONS | 06/06/2024 | RETAINING WALL LOCATION REVISION | 06/04/2024 | STORM STRUCTURE REVISIONS | 04/08/2024 | EROSION CONTROL REVISION | DATE              | DESCRIPTION |
| △   |                                 | △          |                          | △          |                                  | △          |                           | △          |                          | REV               |             |
| DESIGNED BY: DFC/CD   |                                 |            |                          |            |                                  |            |                           |            |                          | DRAWN BY: DFC/JWM |             |
| REVIEWED BY: DFC   |                                 |            |                          |            |                                  |            |                           |            |                          |                   |             |
| <div><div><b>BCE</b></div><div>5438 WADE PARK BLVD, SUITE 420<br/>RALEIGH NC 27607<br/>WWW.BCEINC.COM<br/>NC LICENSE #C-4397</div></div>                |                                 |            |                          |            |                                  |            |                           |            |                          |                   |             |
| <div><div><b>LENNAR</b></div><div><b>CORPORAION</b></div><div>1100 PERIMETER PARK DRIVE, SUITE 112<br/>MORRISVILLE / NORTH CAROLINA / 27560</div></div> |                                 |            |                          |            |                                  |            |                           |            |                          |                   |             |
| <div><div><b>PARKER RIDGE</b></div><div>82 SCHOOL STREET<br/>ROLESVILLE / NORTH CAROLINA / 27571</div></div>                                            |                                 |            |                          |            |                                  |            |                           |            |                          |                   |             |
| <div><div><b>ENLARGED UTILITY</b></div><div><b>PLAN (1 OF 6)</b></div></div>                                                                            |                                 |            |                          |            |                                  |            |                           |            |                          |                   |             |
| <div><div><b>811</b></div><div>Know what's below.<br/>Call before you dig.</div></div>                                                                  |                                 |            |                          |            |                                  |            |                           |            |                          |                   |             |
| <div><div><b>FILE NUMBER:</b><br/>8430-03</div><div><b>DATE:</b> 3/24/2025</div><div><b>C3-1</b></div></div>                                            |                                 |            |                          |            |                                  |            |                           |            |                          |                   |             |



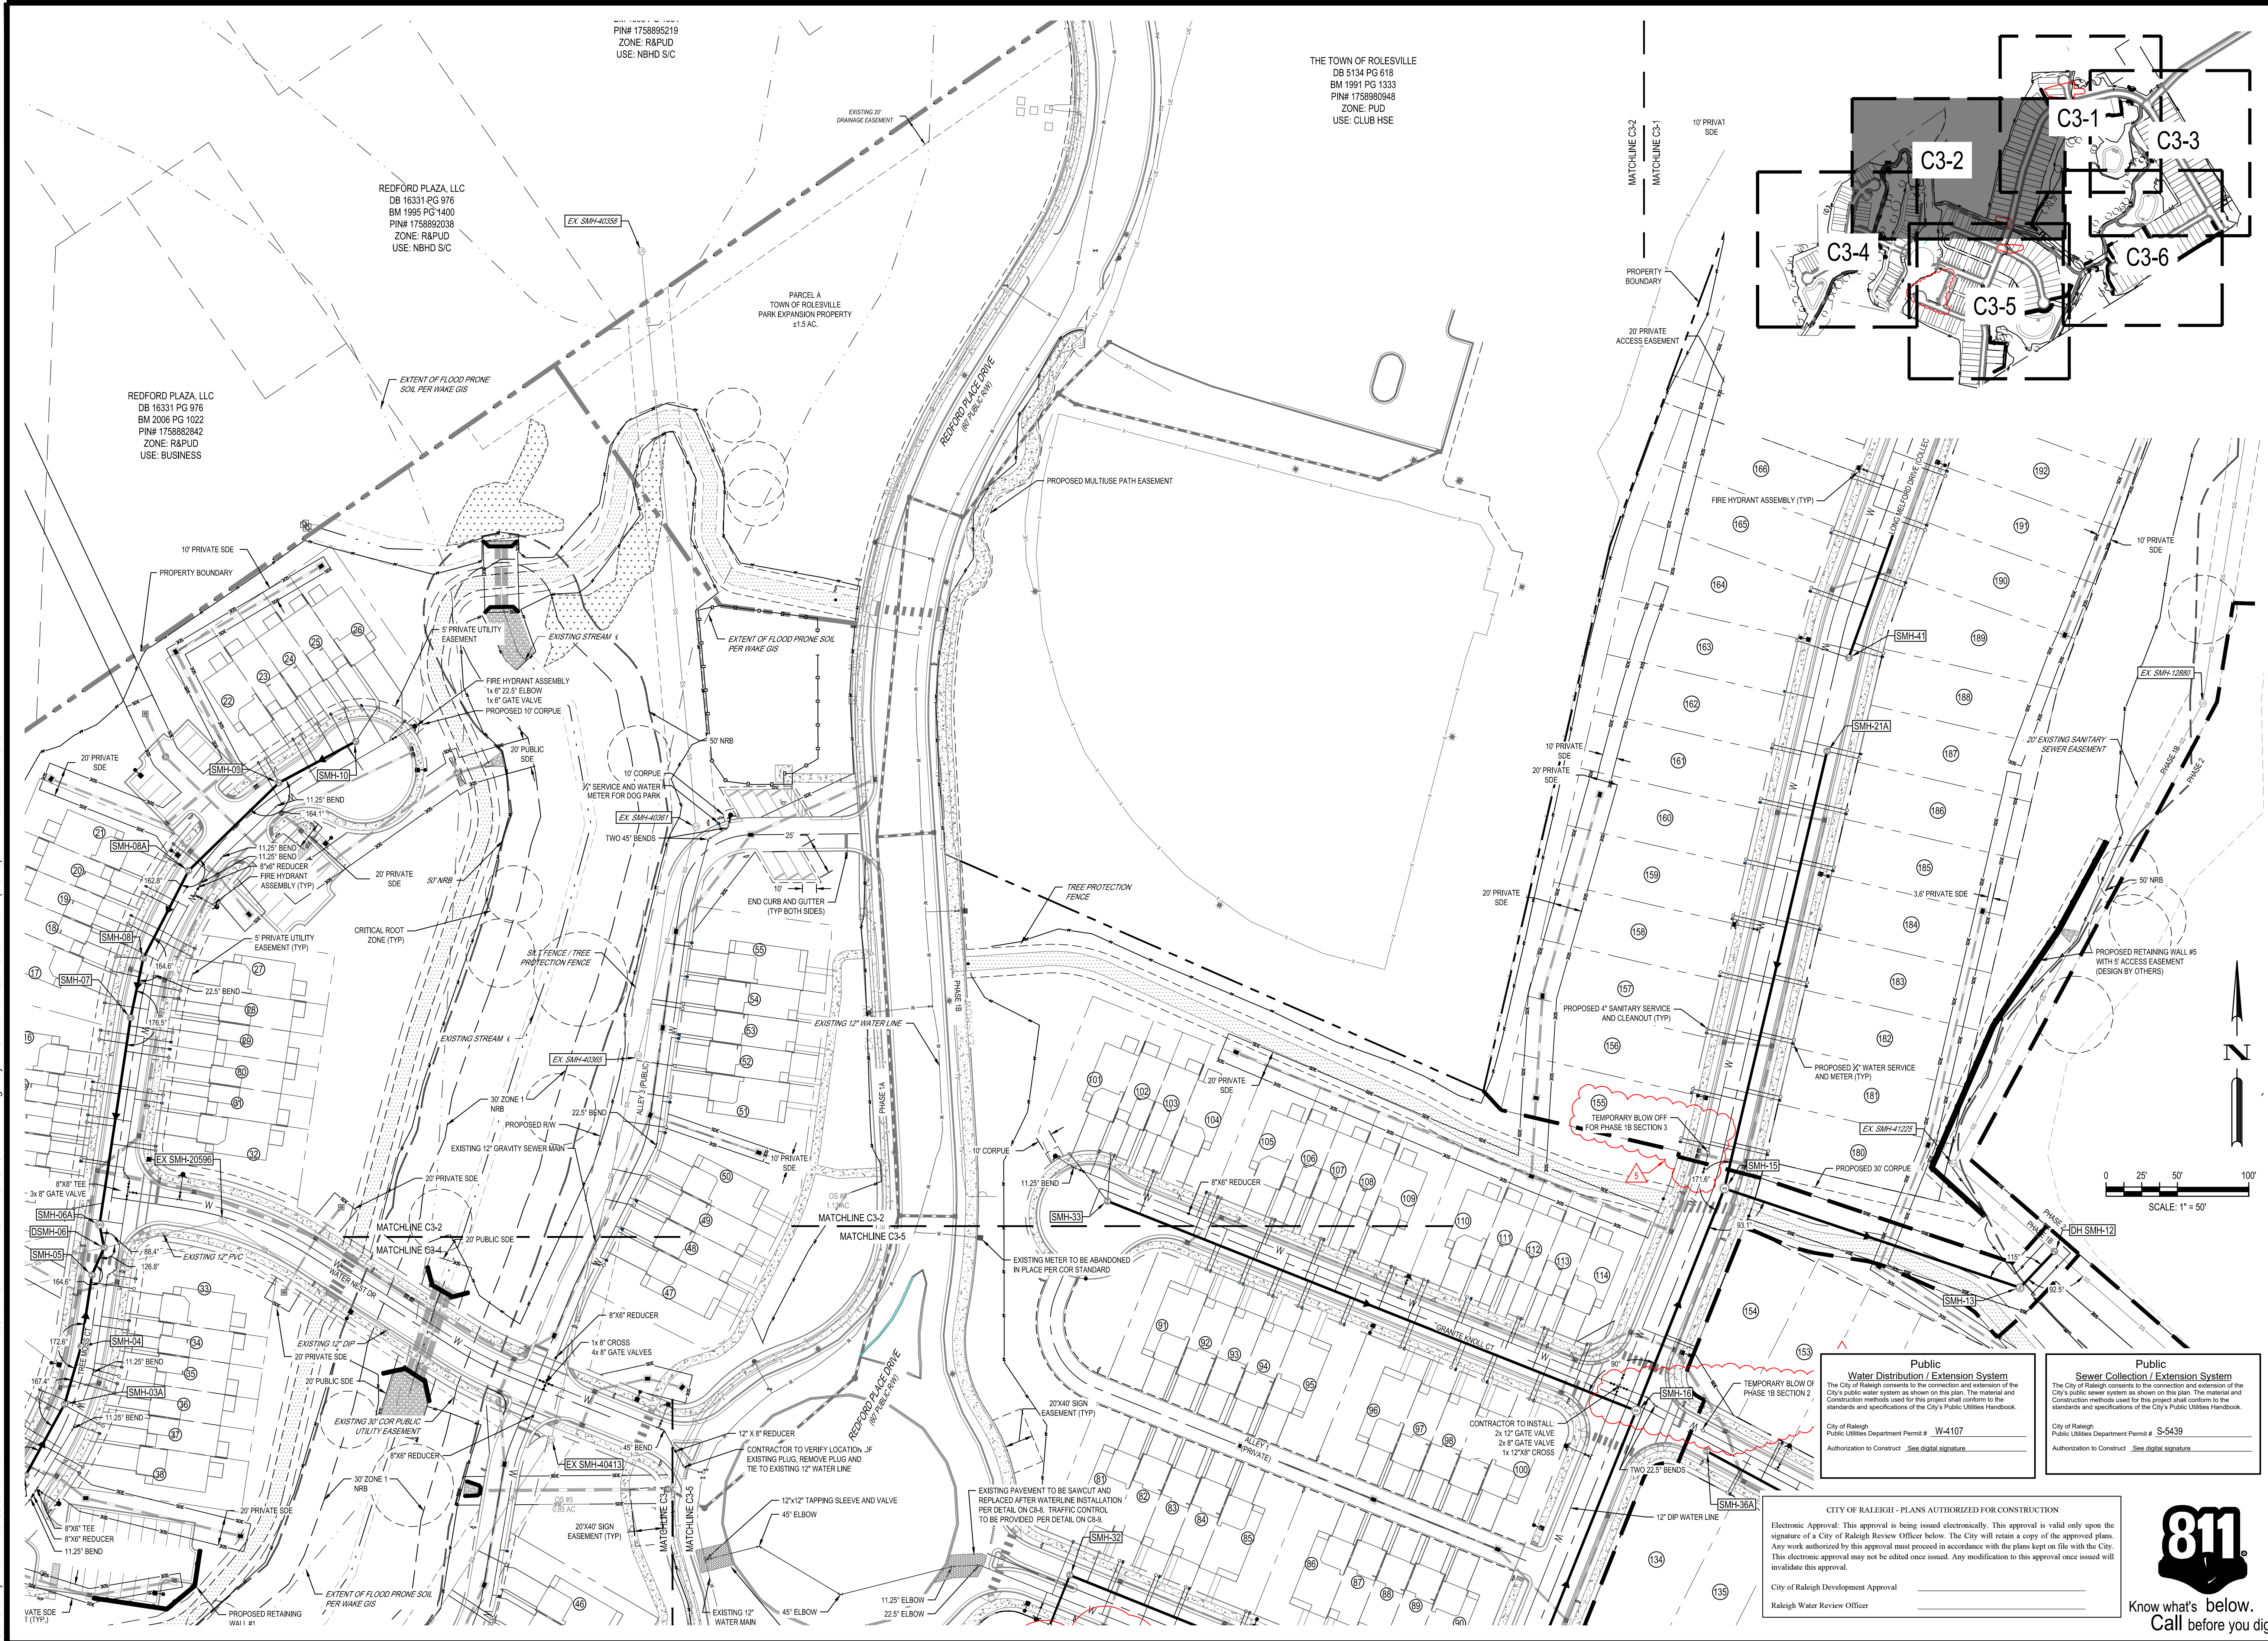

|   |  |                                  |  |                 |  |  |  |      |  |  |  |
|---|--|----------------------------------|--|-----------------|--|--|--|------|--|--|--|
| <div>03/24/2025</div> <div>△</div>   |  | SUBPHASING, SEWER, & CURB TYPES  |  |                 |  |  |  |      |  |  |  |
| <div>11/04/2024</div> <div>△</div>   |  | AMENITY CENTER REVISIONS         |  |                 |  |  |  |      |  |  |  |
| <div>08/06/2024</div> <div>△</div>   |  | RETAINING WALL LOCATION REVISION |  |                 |  |  |  |      |  |  |  |
| <div>06/04/2024</div> <div>△</div>   |  | STORM STRUCTURE REVISIONS        |  |                 |  |  |  |      |  |  |  |
| <div>04/08/2024</div> <div>△</div>   |  | EROSION CONTROL REVISION         |  |                 |  |  |  |      |  |  |  |
| REV   |  | DATE                             |  |                 |  |  |  |      |  |  |  |
| DESCRIPTION   |  |                                  |  |                 |  |  |  |      |  |  |  |
| DESIGNED BY:   |  | DF/CD                            |  |                 |  |  |  |      |  |  |  |
| DRAWN BY:   |  | DF/JWM                           |  |                 |  |  |  |      |  |  |  |
| REVIEWED BY:   |  | DF                               |  |                 |  |  |  |      |  |  |  |
| <div><div><div><div><div><div></div><div>BGE</div></div></div><div><div>5438 WADE PARK BLVD, SUITE 420</div><div>RALEIGH NC 27607</div><div>WWW.BGE.COM</div><div>NC LICENSE PC-4397</div></div></div><div><div>LENNAR</div><div>CORPORAION</div><div>1100 PERMETER PARK DRIVE, SUITE 112</div><div>MORRISVILLE / NORTH CAROLINA / 27560</div></div><div><div>PARKER RIDGE</div><div>82 SCHOOL STREET</div><div>ROLESVILLE / NORTH CAROLINA / 27571</div></div><div><div>ENLARGED UTILITY</div><div>PLAN (2 OF 6)</div></div><div><div><div><div><div><div></div><div>NORTH CAROLINA</div><div>PROFESSIONAL</div></div><div><div>SEAL</div><div>026892</div><div>SIGNED</div><div>DEBRA M. FELTZ</div></div></div><div><div>3/25/25</div></div></div></div><div>FILE NUMBER:</div><div>8430-03</div></div><tr><td colspan="4">DATE: 3/24/2025</td></tr><tr><td colspan="4">C3-2</td></tr></div></div> |  |                                  |  | DATE: 3/24/2025 |  |  |  | C3-2 |  |  |  |
| DATE: 3/24/2025   |  |                                  |  |                 |  |  |  |      |  |  |  |
| C3-2   |  |                                  |  |                 |  |  |  |      |  |  |  |



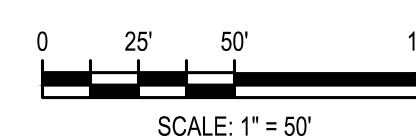

**Public  
Sewer Collection / Extension System**

The City of Raleigh consents to the connection and extension of the City's public sewer system as shown on this plan. The material and Construction methods used for this project shall conform to the standards and specifications of the City's Public Utilities Handbook.

City of Raleigh  
Public Utilities Department Permit # **S-5439**

Authorization to Construct: See digital signature



Know what's below.  
Call before you dig.

## ENLARGED UTILITY PLAN (5 OF 6)



3/25/2025

**FILE NUMBER:**  
8430-03

**DATE:** 3/24/2025

C3-5

**PARKER RIDGE**

82 SCHOOL STREET  
ROLESVILLE / NORTH CAROLINA / 27571

**LENNAR  
CORPORAION**




**DESIGNED BY:** DF/CD

**DRAWN BY:** DF/JWM

**REVIEWED BY:** DF

**03/24/2025**

**11/04/2024**

**06/09/2024**

**06/04/2024**

**04/09/2024**

| SUBPHASING, SEWER, & CURB TYPES | AMENITY CENTER REVISIONS | RETAINING WALL LOCATION REVISION | STORM STRUCTURE REVISIONS | EROSION CONTROL REVISION | DESCRIPTION |
|---------------------------------|--------------------------|----------------------------------|---------------------------|--------------------------|-------------|
| △                               | △                        | △                                | △                         | △                        | REV DATE    |










PROPOSED GRADING AND DRAINAGE LEGEND

|  |                          |
|--|--------------------------|
|  | PROPOSED BORING          |
|  | PROPOSED DETENTION       |
|  | PROPOSED CLEARING LIMITS |
|  | PROPOSED MAJOR CONTOUR   |
|  | PROPOSED MINOR CONTOUR   |
|  | PROPOSED SPOT            |
|  | PROPOSED GRADING ARROW   |
|  | PROPOSED SWALE           |
|  | PROPOSED STORM           |
|  | PROPOSED STORM SYMBOL    |
|  | PROPOSED BUILDING SPOT   |
|  | PROPOSED STEM WALL       |
|  | FINISHED PAD ELEVATION   |

INSET - AMENITY CENTER ADA GRADING

1" = 30'

NOTE: DRAINAGE PIPE FROM FES-200 TO CB-214 TO BE INSTALLED WITH PHASE 1B SECTION 1

0 25' 50' 100'

SCALE: 1" = 50'

811

Know what's below.  
Call before you dig.

LENNAR CORPORATION  
CORPORATION  
1100 PERIMETER PARK DRIVE, SUITE 112  
MORRISVILLE / NORTH CAROLINA / 27560

PARKER RIDGE  
82 SCHOOL STREET  
ROLESVILLE / NORTH CAROLINA / 27571

ENLARGED GRADING  
PLAN (5 OF 6)

FILE NUMBER:  
8430-03

DATE: 3/24/2025

C4-5

|            |                                  |              |             |
|------------|----------------------------------|--------------|-------------|
| 03/24/2025 | SUBPHASING, SEWER, & CURB TYPES  | DESIGNED BY: | DF/CD       |
| 11/04/2024 | AMENITY CENTER REVISIONS         | DRAWN BY:    | DF/JWM      |
| 06/06/2024 | RETAINING WALL LOCATION REVISION | REVIEWED BY: | DF          |
| 06/04/2024 | STORM STRUCTURE REVISIONS        |              |             |
| 04/08/2024 | EROSION CONTROL REVISION         |              |             |
|            |                                  | REV          | DATE        |
|            |                                  |              | DESCRIPTION |

**BCE**

5438 WADE PARK BLVD, SUITE 420  
RALEIGH NC 27607  
WWW.BCEINC.COM  
NC LICENSE #C-4397

**LENNAR CORPORATION**

1100 PERIMETER PARK DRIVE, SUITE 112  
MORRISVILLE / NORTH CAROLINA / 27560

**PARKER RIDGE**

82 SCHOOL STREET  
ROLESVILLE / NORTH CAROLINA / 27571

**ENLARGED GRADING PLAN (5 OF 6)**

**FILE NUMBER:**  
8430-03

**DATE:** 3/24/2025

**C4-5**



| STRUCTURE DATA TABLE |           |                   |                                           |             |               |                  |
|----------------------|-----------|-------------------|-------------------------------------------|-------------|---------------|------------------|
| STRUCTURE NAME       | RM. ELEV. | PIPE IN SIZE      | INV. IN                                   | INV. OUT    | PIPE OUT SIZE | PIPE OUT TO NODE |
| AD-165               | 394.70    | 15"               | 391.40 (NE)                               | 391.20 (NW) | 15"           | DI-146           |
| AD-166               | 394.67    |                   |                                           | 391.57 (SW) | 15"           | AD-165           |
| CB-101               | 395.63    | 36"               | 383.10 (NW)                               | 383.00 (SW) | 36"           | FES-100          |
| CB-103               | 397.43    | 30"               | 384.11 (NE)                               | 384.01 (SW) | 36"           | DCB-102          |
| CB-104               | 397.62    | 18"               | 385.52 (SE)                               | 385.42 (W)  | 18"           | CB-103           |
| CB-105               | 398.98    | 18"               | 392.36 (E)                                | 384.41 (SW) | 30"           | CB-103           |
| CB-106               | 399.33    |                   |                                           | 392.50 (W)  | 18"           | CB-105           |
| CB-107               | 400.83    | 18"<br>30"        | 391.93 (E)<br>384.95 (N)                  | 384.85 (S)  | 30"           | CB-105           |
| CB-108               | 401.10    |                   |                                           | 392.50 (W)  | 18"           | CB-107           |
| CB-109               | 402.99    | 24"<br>30"        | 386.16 (NE)<br>385.69 (E)                 | 385.48 (S)  | 30"           | CB-107           |
| CB-110               | 403.70    | 24"               | 389.01 (N)                                | 386.38 (SW) | 24"           | CB-109           |
| CB-111               | 405.97    | 24"<br>15"        | 389.76 (NE)<br>400.94 (W)                 | 389.66 (S)  | 24"           | CB-110           |
| CB-112               | 405.99    |                   |                                           | 400.55 (E)  | 15"           | CB-111           |
| CB-113               | 405.45    | 24"<br>18"<br>15" | 390.42 (NW)<br>393.77 (NE)<br>399.13 (SE) | 390.22 (SW) | 24"           | CB-111           |
| CB-114               | 405.45    | 24"               | 392.16 (NW)                               | 390.56 (SE) | 24"           | CB-113           |
| CB-115               | 404.55    | 18"<br>15"        | 399.45 (SE)<br>396.46 (NE)                | 394.22 (SW) | 18"           | CB-113           |
| CB-117               | 404.75    |                   |                                           | 395.56 (NW) | 18"           | CB-115           |
| CB-118               | 406.13    | 15"<br>24"        | 398.03 (W)<br>392.48 (NE)                 | 392.28 (SE) | 24"           | CB-114           |
| CB-119               | 405.40    | 24"<br>15"        | 396.06 (NW)<br>399.80 (SE)                | 392.86 (SW) | 24"           | CB-118           |
| CB-127               | 400.50    | 30"               | 386.13 (E)                                | 386.03 (W)  | 30"           | CB-109           |
| CB-128               | 397.85    | 30"<br>15"<br>18" | 386.69 (SE)<br>390.00 (SW)<br>388.25 (NE) | 386.59 (W)  | 30"           | CB-127           |
| CB-130               | 397.69    | 24"<br>18"        | 387.80 (SW)<br>389.50 (SW)                | 387.60 (NW) | 24"           | TCB-129          |
| CB-131               | 398.13    | 18"<br>18"        | 388.04 (S)<br>388.44 (E)                  | 387.94 (NE) | 24"           | CB-130           |

| STRUCTURE DATA TABLE |           |                   |                                           |             |               |                  |
|----------------------|-----------|-------------------|-------------------------------------------|-------------|---------------|------------------|
| STRUCTURE NAME       | RM. ELEV. | PIPE IN SIZE      | INV. IN                                   | INV. OUT    | PIPE OUT SIZE | PIPE OUT TO NODE |
| CB-132               |           |                   | 390.73 (N)                                | 390.53 (W)  | 18"           | CB-131           |
| CB-133               | 398.32    | 15"               | 391.20 (E)                                | 391.00 (S)  | 18"           | CB-132           |
| CB-140               | 404.25    |                   | 393.55 (SW)                               |             | 18"           | DI-139           |
| CB-147               | 396.08    | 18"               | 387.38 (E)                                | 387.18 (SW) | 18"           | CB-101           |
| CB-153               | 396.67    | 18"               | 385.20 (SW)                               | 385.00 (SE) | 18"           | FES-152          |
| CB-153A              | 396.35    |                   |                                           | 388.00 (NE) | 18"           | CB-153           |
| CB-154               | 394.31    | 18"               | 388.00 (E)                                | 387.80 (W)  | 18"           | CB-147           |
| CB-155               | 393.43    |                   |                                           | 388.41 (W)  | 18"           | CB-154           |
| CB-163               | 404.63    |                   |                                           | 399.88 (NW) | 15"           | CB-119           |
| CB-164               | 396.22    |                   |                                           | 391.47 (NE) | 15"           | DCB-102          |
| DCB-102              | 395.83    | 30"<br>18"<br>15" | 383.44 (NE)<br>385.77 (NW)<br>390.16 (SW) | 383.24 (SE) | 36"           | CB-101           |
| DDI-143              | 393.41    | 15"<br>15"        | 389.45 (SW)<br>389.56 (SE)                | 389.35 (NE) | 18"           | DI-142           |
| DI-120               | 394.64    | 15"<br>18"        | 386.64 (SW)<br>386.64 (NE)                | 386.44 (SE) | 18"           | DCB-102          |
| DI-121               | 394.97    |                   |                                           | 387.53 (NE) | 15"           | DI-120           |
| DI-122               | 389.71    |                   |                                           | 386.50 (W)  | 18"           | DI-156           |
| DI-123               | 402.15    | 15"               | 391.77 (N)                                | 391.57 (SE) | 15"           | CB-107           |
| DI-124               | 404.23    |                   |                                           | 386.04 (S)  | 15"           | DI-123           |
| DI-125               | 405.16    |                   |                                           | 399.44 (E)  | 15"           | CB-118           |
| DI-126               | 403.10    | 18"               | 398.71 (NE)                               | 398.51 (SE) | 24"           | CB-119           |
| DI-134               | 397.76    | 15"               | 392.14 (E)                                | 391.94 (W)  | 18"           | CB-133           |
| DI-135               | 397.67    | 18"               | 389.87 (NE)                               | 389.77 (SW) | 18"           | CB-130           |
| DI-136               | 399.36    | 18"<br>15"        | 391.00 (N)<br>391.00 (E)                  | 390.80 (SW) | 18"           | DI-135           |
| DI-137               | 399.98    | 18"               | 391.87 (N)                                | 391.77 (S)  | 18"           | DI-136           |

| STRUCTURE DATA TABLE |           |              |             |             |               |                  |
|----------------------|-----------|--------------|-------------|-------------|---------------|------------------|
| STRUCTURE NAME       | RM. ELEV. | PIPE IN SIZE | INV. IN     | INV. OUT    | PIPE OUT SIZE | PIPE OUT TO NODE |
| DI-138               | 400.66    | 18"          | 392.55 (NE) | 392.45 (S)  | 18"           | DI-137           |
| DI-139               | 401.93    | 18"          | 393.08 (NE) | 392.98 (SW) | 18"           | DI-138           |
| DI-141               | 396.32    | 18"          | 388.38 (S)  | 388.29 (N)  | 18"           | CB-131           |
| DI-142               | 394.25    | 18"          | 388.92 (SW) | 388.82 (N)  | 18"           | DI-141           |
| DI-144               | 394.20    | 15"          | 390.08 (S)  | 389.98 (NE) | 15"           | DDI-143          |
| DI-145               | 394.60    |              |             | 390.61 (N)  | 15"           | DI-144           |
| DI-146               | 394.59    | 15"          | 390.95 (SE) | 390.85 (NW) | 15"           | DDI-143          |
| DI-150               | 402.80    |              |             | 399.30 (SW) | 18"           | DI-126           |
| DI-151               | 404.38    |              |             | 400.13 (NW) | 15"           | CB-113           |
| DI-156               | 393.38    | 18"          | 385.94 (E)  | 385.74 (NW) | 18"           | CB-104           |
| DI-158               | 397.22    |              |             | 389.00 (SW) | 18"           | DI-120           |
| DI-160               | 399.84    |              |             | 394.41 (W)  | 15"           | DI-136           |
| DI-161               | 396.96    |              |             | 392.64 (W)  | 15"           | DI-134           |
| FES-100              | 386.27    | 36"          | 382.44 (NE) |             | 24"           | FES-1000         |
| FES-152              | 386.71    | 18"          | 384.50 (NW) |             |               |                  |
| FES-1000             | 380.98    | 24"          | 378.23 (NE) |             |               |                  |
| R-1001               | 387.90    |              |             | 379.00 (SW) |               |                  |
| TCB-116              | 402.70    |              |             | 397.75 (SW) | 15"           | CB-115           |
| TCB-129              | 397.10    | 24"          | 387.18 (SE) | 387.08 (NW) | 30"           | CB-128           |
| YI-148               | 393.44    |              |             | 388.75 (SW) | 18"           | CB-128           |
| YI-157               | 396.90    |              |             | 392.35 (NE) | 15"           | CB-128           |

STORM STRUCTURE NOTES:

- FES = FLARED END SECTION
- DI = GRATED YARD INLET
- CB = CATCH BASIN
- DCB = DOUBLE CATCH BASIN
- TCB = TRIPLE CATCH BASIN
- HW = HEADWALL
- PE = PIPE END

- ALL YARD INLETS SHALL HAVE 4'X4' INSIDE DIMENSION UNLESS OTHERWISE NOTED.
- RM ELEVATION GIVEN FOR DI IS FLOW LINE.
- RM ELEVATION GIVEN FOR YI IS FLOW LINE, NOT TOP OF SLAB.
- RM ELEVATION GIVEN FOR CB IS TOP OF CURB, NOT FLOW LINE.
- PIPE LENGTH INCLUDES FES LENGTH.

NOTE: HP STORM (POLYPROPYLENE) PIPE THAT EXCEEDS OR MEETS ASTM F2881 AND AASHTO M330 MAY BE USED IN LIEU OF RCP IN ALL AREAS EXCEPT SCM OUTLET PIPE.

| RIP RAP DISSIPATOR SUMMARY TABLE |                                          |                      |               |              |                    |                 |
|----------------------------------|------------------------------------------|----------------------|---------------|--------------|--------------------|-----------------|
| OUTLET                           | MEDIAN STONE DIAMETER (D <sub>50</sub> ) | MINIMUM APRON LENGTH | WIDTH AT PIPE | WIDTH AT END | MAX STONE DIAMETER | APRON THICKNESS |
| FES100                           | 0.60 FT                                  | 19.00 FT             | 9.00 FT       | 22.00 FT     | 0.90 FT            | 1.35 FT         |
| FES152                           | 0.25 FT                                  | 9.00 FT              | 4.50 FT       | 10.50 FT     | 0.38 FT            | 0.56 FT         |
| FES200                           | 0.85 FT                                  | 19.00 FT             | 9.00 FT       | 22.00 FT     | 1.28 FT            | 1.91 FT         |
| FES250                           | 0.66 FT                                  | 12.00 FT             | 7.50 FT       | 14.50 FT     | 0.99 FT            | 1.49 FT         |
| FES300                           | 0.85 FT                                  | 19.00 FT             | 9.00 FT       | 22.00 FT     | 1.28 FT            | 1.91 FT         |
| FES350                           | 0.85 FT                                  | 19.00 FT             | 9.00 FT       | 22.00 FT     | 1.28 FT            | 1.91 FT         |
| FES400                           | 0.55 FT                                  | 11.00 FT             | 6.00 FT       | 13.00 FT     | 0.83 FT            | 1.24 FT         |
| FES450                           | 0.85 FT                                  | 16.00 FT             | 7.50 FT       | 18.50 FT     | 1.28 FT            | 1.91 FT         |
| FES475                           | 0.50 FT                                  | 9.00 FT              | 3.75 FT       | 10.25 FT     | 0.75 FT            | 1.13 FT         |
| FES1000                          | 0.60 FT                                  | 18.00 FT             | 6.00 FT       | 20.00 FT     | 0.90 FT            | 1.35 FT         |
| FES2000                          | 0.50 FT                                  | 20.00 FT             | 6.00 FT       | 22.00 FT     | 0.75 FT            | 1.13 FT         |
| HW3001                           |                                          | 19.00 FT             | 6.00 FT       | 24.00 FT     | 0.90 FT            | 2.81 FT         |
| FES3003                          | 0.33 FT                                  | 12.00 FT             | 9.00 FT       | 15.00 FT     | 0.50 FT            | 0.74 FT         |
| HW4000                           | 0.40 FT                                  | 12.00 FT             | 6.00 FT       | 14.00 FT     | 0.60 FT            | 0.90 FT         |
| HW4020                           | 0.55 FT                                  | 12.00 FT             | 6.00 FT       | 14.00 FT     | 0.83 FT            | 1.24 FT         |
| FES4100                          | 0.33 FT                                  | 12.00 FT             | 3.75 FT       | 13.25 FT     | 0.50 FT            | 0.74 FT         |
| CULVERT 1                        | 0.83 FT                                  | 40.00 FT             | 30.00 FT      | 30.00 FT     | 1.25 FT            | 1.88 FT         |
| CULVERT 2                        | 0.67 FT                                  | 30.00 FT             | 20.00 FT      | 15.00 FT     | 1.00 FT            | 1.50 FT         |
| CULVERT 3                        | 0.67 FT                                  | 18.80 FT             | 12.00 FT      | 10.00 FT     | 1.00 FT            | 1.50 FT         |
| CULVERT 4                        | 0.83 FT                                  | 40.00 FT             | 20.00 FT      | 20.00 FT     | 1.25 FT            | 1.88 FT         |
| FESB104                          | 0.25 FT                                  | 8.00 FT              | 3.75 FT       | 9.25 FT      | 0.38 FT            | 0.56 FT         |
| FESB106                          | 0.25 FT                                  | 8.00 FT              | 3.75 FT       | 9.25 FT      | 0.38 FT            | 0.56 FT         |
| FES606                           | 0.25 FT                                  | 8.00 FT              | 3.75 FT       | 9.25 FT      | 0.38 FT            | 0.56 FT         |
| FES609                           | 0.25 FT                                  | 8.00 FT              | 3.75 FT       | 9.25 FT      | 0.38 FT            | 0.56 FT         |
| PE600                            | 0.25 FT                                  | 8.00 FT              | 3.75 FT       | 9.25 FT      | 0.38 FT            | 0.56 FT         |
| PE6000                           | 0.25 FT                                  | 8.00 FT              | 3.75 FT       | 9.25 FT      | 0.38 FT            | 0.56 FT         |
| HW1101                           | 0.50 FT                                  | 9.00 FT              | 4.50 FT       | 10.50 FT     | 0.75 FT            | 1.13 FT         |
| FES1300                          | 0.50 FT                                  | 9.00 FT              | 4.50 FT       | 10.50 FT     | 0.75 FT            | 1.13 FT         |
| FES1400                          | 0.50 FT                                  | 12.00 FT             | 6.00 FT       | 14.00 FT     | 0.75 FT            | 1.13 FT         |
| PE-1500                          | 0.40 FT                                  | 12.00 FT             | 4.50 FT       | 13.50 FT     | 0.60 FT            | 0.90 FT         |

SCM 2

| STRUCTURE DATA TABLE |           |                   |                                         |             |               |                  |
|----------------------|-----------|-------------------|-----------------------------------------|-------------|---------------|------------------|
| STRUCTURE NAME       | RM. ELEV. | PIPE IN SIZE      | INV. IN                                 | INV. OUT    | PIPE OUT SIZE | PIPE OUT TO NODE |
| CB-203               | 380.72    | 24"<br>18"<br>15" | 371.00 (N)<br>365.54 (NE)<br>374.64 (W) | 364.54 (S)  | 30"           | DCB-202          |
| CB-204               | 381.20    | 18"               | 365.92 (E)                              | 365.82 (SW) | 18"           | CB-203           |
| CB-205               | 383.25    | 24"<br>15"        | 375.27 (N)<br>379.07 (NE)               | 375.17 (S)  | 24"           | CB-203           |
| CB-206               | 383.54    |                   |                                         | 379.50 (SW) | 15"           | CB-205           |
| CB-207               | 385.65    | 24"<br>15"        | 378.70 (NW)<br>386.78 (NE)              | 378.60 (S)  | 24"           | CB-205           |
| CB-208               | 385.72    |                   |                                         | 380.92 (SW) | 15"           | CB-207           |
| CB-209               | 389.00    | 24"<br>15"        | 382.66 (NW)<br>383.51 (NE)              | 382.46 (SE) | 24"           | CB-207           |
| CB-210               | 389.01    |                   |                                         | 383.81 (SW) | 15"           | CB-209           |
| CB-212               | 391.83    | 24"               | 385.14 (N)                              | 385.04 (SE) | 24"           | CB-209           |
| CB-213               | 392.64    | 24"               | 385.63 (NW)                             | 385.53 (S)  | 24"           | CB-212           |
| CB-214               | 394.54    | 18"<br>24"        | 387.30 (W)<br>386.75 (N)                | 386.55 (SE) | 24"           | CB-213           |
| CB-215               | 394.55    | 18"               | 389.80 (SW)                             | 387.70 (E)  | 18"           | CB-214           |
| CB-216               | 395.25    | 18"<br>15"        | 391.00 (W)<br>391.00 (SW)               | 390.80 (NE) | 18"           | CB-215           |
| CB-217               | 395.26    |                   |                                         | 391.17 (NE) | 15"           | CB-216           |
| CB-218               | 396.49    | 15"               | 392.37 (SW)                             | 392.12 (E)  | 18"           | CB-216           |
| CB-219               | 401.08    | 15"               | 396.24 (SW)                             | 396.04 (E)  | 15"           | CB-218           |
| CB-220               | 401.45    |                   |                                         | 396.41 (NE) | 15"           | CB-219           |
| CB-223               | 393.30    | 24"               | 388.16 (W)                              | 388.96 (N)  | 24"           | TCB-222          |
| CB-224               | 394.48    | 15"<br>15"        | 390.07 (W)<br>390.90 (S)                | 389.00 (S)  | 24"           | DCB-221          |
| CB-225               | 394.37    |                   |                                         | 390.25 (E)  | 15"           | CB-224           |

| STRUCTURE DATA TABLE |           |              |                           |             |               |                  |
|----------------------|-----------|--------------|---------------------------|-------------|---------------|------------------|
| STRUCTURE NAME       | RM. ELEV. | PIPE IN SIZE | INV. IN                   | INV. OUT    | PIPE OUT SIZE | PIPE OUT TO NODE |
| CB-226               | 400.65    | 15"          | 396.57 (W)                | 396.37 (S)  | 15"           | CB-224           |
| CB-227               | 400.58    |              |                           | 396.75 (E)  | 15"           | CB-226           |
| CB-252               | 384.38    | 30"<br>24"   | 373.28 (W)<br>376.79 (N)  | 373.08 (E)  | 30"           | DMH-251          |
| CB-253               | 386.49    | 24"          | 380.95 (N)                | 379.20 (S)  | 24"           | CB-252           |
| CB-254               | 388.52    | 24"          | 382.40 (NE)               | 382.30 (S)  | 24"           | CB-253           |
| CB-255               | 390.80    | 24"<br>24"   | 384.85 (W)<br>394.38 (N)  | 384.28 (SW) | 24"           | CB-254           |
| CB-256               | 391.87    | 15"<br>18"   | 386.66 (NW)<br>385.41 (N) | 384.91 (S)  | 24"           | CB-255           |
| CB-257               | 393.39    |              |                           | 387.54 (S)  | 18"           | CB-256           |
| CB-259               | 391.20    | 15"<br>18"   | 386.47 (S)<br>386.47 (N)  | 386.27 (NE) | 18"           | DCB-258          |
| CB-260               | 391.21    |              |                           | 387.02 (N)  | 15"           | CB-259           |
| CB-261               | 394.52    | 18"          | 389.96 (NW)               | 389.86 (E)  | 18"           | CB-259           |
| CB-262               | 396.88    | 15"<br>15"   | 392.45 (S)<br>392.64 (W)  | 392.25 (SE) | 18"           | CB-261           |
| CB-263               | 396.86    | 15"          | 392.83 (S)                | 392.73 (N)  | 15"           | CB-262           |
| CB-264               | 396.56    |              |                           | 393.04 (N)  | 15"           | CB-263           |
| CB-265               | 397.85    | 15"          | 393.42 (S)                | 393.22 (E)  | 15"           | CB-262           |
| CB-266               | 397.84    |              |                           | 393.70 (N)  | 15"           | CB-265           |
| CB-267               | 384.37    | 24"<br>24"   | 373.75 (S)<br>373.70 (NW) | 373.50 (E)  | 30"           | CB-262           |
| CB-270               | 385.94    | 15"<br>15"   | 377.68 (E)<br>377.68 (S)  | 377.48 (N)  | 15"           | TCB-268          |
| CB-271               | 385.88    | 15"          | 376.15 (E)                | 377.95 (W)  | 15"           | CB-270           |
| CB-272               | 391.61    | 15"          | 378.77 (E)                | 378.57 (N)  | 15"           | CB-270           |

| STRUCTURE DATA TABLE |           |              |                            |             |               |                  |
|----------------------|-----------|--------------|----------------------------|-------------|---------------|------------------|
| STRUCTURE NAME       | RM. ELEV. | PIPE IN SIZE | INV. IN                    | INV. OUT    | PIPE OUT SIZE | PIPE OUT TO NODE |
| CB-273               | 391.63    | 15"          | 380.60 (E)                 | 378.90 (W)  | 15"           | CB-272           |
| CB-279               | 386.77    | 24"<br>18"   | 374.20 (N)<br>378.86 (W)   | 374.00 (SE) | 24"           | CB-267           |
| CB-280               | 386.78    | 18"          | 378.10 (NE)                | 374.50 (S)  | 24"           | CB-279           |
| CB-281               | 385.90    | 15"          | 379.67 (N)                 | 379.47 (SW) | 18"           | CB-280           |
| CB-282               | 387.00    | 15"          | 380.94 (NW)                | 380.74 (S)  | 15"           | CB-281           |
| CB-283               | 390.51    | 18"<br>18"   | 383.07 (N)<br>379.85 (S)   | 379.65 (E)  | 18"           | CB-279           |
| CB-285               | 392.15    | 18"          | 385.54 (N)                 | 385.44 (E)  | 18"           | CB-283           |
| CB-286               | 393.69    | 15"<br>15"   | 387.95 (NE)<br>387.95 (W)  | 387.64 (E)  | 18"           | CB-285           |
| CB-287               | 393.67    | 15"          | 388.20 (N)                 | 388.10 (SW) | 15"           | CB-286           |
| CB-288               | 393.68    |              |                            | 389.15 (S)  | 15"           | CB-287           |
| CB-289               | 396.65    | 15"<br>15"   | 390.35 (NE)<br>391.75 (NE) | 390.15 (E)  | 15"           | CB-286           |
| CB-2906              | 396.33    | 15"<br>15"   | 391.75 (NE)<br>391.10 (N)  | 390.51 (SW) | 15"           | CB-289           |
| DCB-202              | 379.67    | 30"          | 383.77 (N)                 | 383.07 (S)  | 30"           | DI-201           |
| DCB-221              | 393.48    | 24"<br>24"   | 388.29 (W)<br>388.32 (N)   | 388.09 (S)  | 24"           | CB-214           |
| DCB-258              | 390.80    | 18"          | 385.65 (SW)                | 385.15 (E)  | 24"           | CB-255           |
| DCB-269              | 384.04    |              |                            | 374.45 (W)  | 24"           | TCB-268          |
| DI-201               | 376.60    | 30"          | 383.22 (N)                 | 352.00 (S)  | 36"           | FES-200          |
| DI-228               | 379.24    | 18"          | 387.49 (N)                 | 387.29 (W)  | 18"           | CB-204           |
| DI-229               | 376.78    | 18"          | 388.24 (N)                 | 388.14 (S)  | 18"           | DI-228           |

| STRUCTURE DATA TABLE |           |              |                           |             |               |                  |
|----------------------|-----------|--------------|---------------------------|-------------|---------------|------------------|
| STRUCTURE NAME       | RM. ELEV. | PIPE IN SIZE | INV. IN                   | INV. OUT    | PIPE OUT SIZE | PIPE OUT TO NODE |
| DI-230               | 377.50    | 18"          | 369.26 (NW)               | 369.16 (S)  | 18"           | DI-229           |
| DI-231               | 376.31    | 18"          | 370.50 (NW)               | 370.40 (SE) | 18"           | DI-230           |
| DI-232               | 381.52    | 18"          | 375.50 (NW)               | 375.40 (SE) | 18"           | DI-231           |
| DI-233               | 386.73    | 15"          | 381.75 (N)                | 381.50 (SE) | 18"           | DI-232           |
| DI-234               | 392.16    | 15"          | 385.58 (N)                | 385.38 (S)  | 15"           | DI-233           |
| DI-235               | 398.17    |              |                           | 393.03 (S)  | 15"           | DI-234           |
| DI-236               | 396.56    | 18"<br>18"   | 389.88 (N)<br>391.78 (NW) | 389.88 (E)  | 24"           | CB-223           |
| DI-237               | 394.75    | 18"          | 391.10 (N)                | 390.17 (S)  | 18"           | DI-236           |
| DI-238               | 402.00    |              |                           | 398.50 (SE) | 18"           | DI-236           |
| DI-274               | 385.65    |              |                           | 381.00 (W)  | 15"           | CB-273           |
| DI-275               | 384.04    |              |                           | 380.00 (W)  | 15"           | CB-271           |
| DI-276               | 393.28    | 15"          | 388.68 (W)                | 388.48 (SE) | 15"           | CB-256           |
| DI-277               | 398.12    | 15"          | 391.95 (W)                | 391.85 (E)  | 15"           | DI-278           |
| DI-278               | 396.33    |              |                           | 394.10 (E)  | 15"           | DI-277           |
| DI-290               | 388.14    | 15"          | 383.53 (W)                | 383.33 (SE) | 15"           | CB-282           |
| DI-291               | 390.96    | 15"          | 386.98 (W)                | 386.78 (E)  | 15"           | DI-290           |
| DI-292               | 394.59    |              |                           | 390.75 (E)  | 15"           | DI-291           |
| DI-293               | 383.89    | 15"<br>18"   | 380.60 (W)<br>380.44 (S)  | 380.24 (N)  | 18"           | CB-283           |
| DI-294               | 388.67    | 15"          | 385.24 (W)                | 385.04 (E)  | 15"           | DI-293           |
| DI-295               | 392.33    | 15"          | 388.08 (W)                | 387.98 (E)  | 15"           | DI-294           |




| STRUCTURE DATA TABLE |           |              |                          |             |               |                  |
|----------------------|-----------|--------------|--------------------------|-------------|---------------|------------------|
| STRUCTURE NAME       | RM. ELEV. | PIPE IN SIZE | INV. IN                  | INV. OUT    | PIPE OUT SIZE | PIPE OUT TO NODE |
| DI-296               | 396.79    |              |                          | 392.54 (E)  | 15"           | DI-295           |
| DI-297               | 385.49    | 18"          | 381.70 (S)               | 381.50 (N)  | 18"           | DI-293           |
| DI-298               | 389.62    |              |                          | 385.12 (N)  | 18"           | DI-297           |
| DI-299               | 395.73    | 18"          | 391.70 (N)               | 391.50 (S)  | 18"           | DI-297           |
| DI-2000              | 401.37    |              |                          | 397.50 (S)  | 18"           | DI-299           |
| DI-2001              | 377.00    | 15"          | 371.80 (N)               | 371.60 (S)  | 15"           | DI-2008          |
| DI-2002              | 382.00    | 15"          | 378.20 (N)               | 378.00 (S)  | 15"           | DI-2001          |
| DI-2003              | 384.91    |              |                          | 380.19 (S)  | 15"           | DI-2002          |
| DI-2004              | 379.50    | 15"          | 375.85 (N)               | 375.65 (E)  | 15"           | CB-203           |
| DI-2005              | 385.58    |              |                          | 380.77 (S)  | 15"           | DI-2004          |
| DI-2007              | 396.61    |              |                          | 392.50 (SW) | 15"           | CB-206           |
| DI-2008              | 374.82    | 15"          | 365.88 (N)               | 365.68 (S)  | 15"           | DMH-251          |
| DMH-251              | 371.41    | 30"<br>15"   | 362.00 (W)<br>365.00 (N) | 355.00 (E)  | 30"           | FES-250          |
| FES-250              | 30"       |              | 351.25 (N)               |             |               |                  |
| FES-250              | 30"       |              | 351.50 (W)               |             |               |                  |
| FES-2000             | 24"       |              | 345.10 (N)               |             |               |                  |
| R-2001               |           |              |                          | 346.00 (S)  | 24"           | FES-2000         |
| TCB-222              | 393.48    | 24"          | 388.67 (S)               | 388.47 (E)  | 24"           | DCB-221          |
| TCB-268              | 384.00    | 24"<br>15"   | 374.20 (E)<br>376.25 (S) | 374.00 (N)  | 24"           | CB-267           |

| PIPE TABLE        |      |         |       |          |  |
|-------------------|------|---------|-------|----------|--|
| NAME              | SIZE | LENGTH  | SLOPE | MATERIAL |  |
| CB-203 TO CB-204  | 18"  | 28.28'  | 1.00% | 18" RCP  |  |
| CB-203 TO CB-205  | 24"  | 81.43'  | 5.12% | 24" RCP  |  |
| CB-203 TO DI-2004 | 15"  | 144.54' | 0.56% | 15" RCP  |  |
| CB-204 TO DI-228  | 18"  | 137.00' | 1.00% | 18" RCP  |  |
| CB-205 TO CB-206  | 15"  | 28.49'  | 1.50% | 15" RCP  |  |
| CB-205 TO CB-207  | 24"  | 76.88'  | 4.33% | 24" RCP  |  |
| CB-207 TO CB-208  | 15"  | 27.34'  | 0.51% | 15" RCP  |  |
| CB-207 TO CB-209  | 24"  | 106.77' | 3.52% | 24" RCP  |  |
| CB-209 TO CB-210  | 15"  | 27.00'  | 1.12% | 15" RCP  |  |
| CB-209 TO CB-212  | 24"  | 95.23'  | 2.50% | 24" RCP  |  |
| CB-212 TO CB-213  | 24"  | 38.74'  | 1.01% | 24" RCP  |  |
| CB-213 TO CB-214  | 24"  | 66.06'  | 1.39% | 24" RCP  |  |
| CB-214 TO CB-215  | 18"  | 35.00'  | 1.15% | 18" RCP  |  |
| CB-214 TO DCB-221 | 24"  | 139.26' | 0.96% | 24" RCP  |  |
| CB-215 TO CB-216  | 18"  | 42.03'  | 2.38% | 18" RCP  |  |
| CB-216 TO CB-217  | 15"  | 27.01'  | 0.84% | 15" RCP  |  |
| CB-216 TO CB-218  | 18"  | 66.89'  | 1.67% | 18" RCP  |  |
| CB-218 TO CB-219  | 15"  | 200.10' | 1.83% | 15" RCP  |  |
| CB-219 TO CB-220  | 15"  | 31.34'  | 0.54% | 15" RCP  |  |
| CB-223 TO DI-236  | 24"  | 104.31' | 0.50% | 24" RCP  |  |

| PIPE TABLE        |      |         |       |          |  |
|-------------------|------|---------|-------|----------|--|
| NAME              | SIZE | LENGTH  | SLOPE | MATERIAL |  |
| CB-224 TO CB-225  | 15"  | 35.32'  | 0.50% | 15" RCP  |  |
| CB-224 TO CB-227  | 15"  | 162.56' | 3.36% | 15" RCP  |  |
| CB-226 TO CB-228  | 15"  | 35.07'  | 0.50% | 15" RCP  |  |
| CB-252 TO CB-253  | 24"  | 112.80' | 2.13% | 24" RCP  |  |
| CB-252 TO CB-267  | 30"  | 27.04'  | 0.81% | 30" RCP  |  |
| CB-253 TO CB-254  | 24"  | 98.11'  | 1.38% | 24" RCP  |  |
| CB-254 TO CB-255  | 24"  | 121.84' | 1.54% | 24" RCP  |  |
| CB-255 TO CB-256  | 24"  | 55.22'  | 0.96% | 24" RCP  |  |
| CB-255 TO DCB-258 | 24"  | 35.00'  | 0.86% | 24" RCP  |  |
| CB-256 TO CB-257  | 18"  | 78.86'  | 2.70% | 18" RCP  |  |
| CB-257 TO DI-276  | 15"  | 69.90'  | 2.60% | 15" RCP  |  |
| CB-259 TO CB-260  | 15"  | 35.00'  | 1.57% | 15" RCP  |  |
| CB-259 TO CB-261  | 18"  | 82.20'  | 4.12% | 18" RCP  |  |
| CB-261 TO CB-262  | 18"  | 75.26'  | 3.04% | 18" RCP  |  |
| CB-262 TO CB-263  | 15"  | 35.02'  | 0.80% | 15" RCP  |  |
| CB-262 TO CB-265  | 15"  | 78.98'  | 0.73% | 15" RCP  |  |
| CB-263 TO CB-264  | 15"  | 26.33'  | 0.80% | 15" RCP  |  |
| CB-265 TO CB-266  | 15"  | 35.01'  | 0.80% | 15" RCP  |  |
| CB-267 TO CB-279  | 24"  | 46.29'  | 0.65% | 24" RCP  |  |
| CB-267 TO TCB-268 | 24"  | 49.30'  | 0.51% | 24" RCP  |  |

| PIPE TABLE         |      |         |       |          |  |
|--------------------|------|---------|-------|----------|--|
| NAME               | SIZE | LENGTH  | SLOPE | MATERIAL |  |
| CB-270 TO CB-271   | 15"  | 27.04'  | 1.00% | 15" RCP  |  |
| CB-270 TO CB-272   | 15"  | 178.50' | 0.50% | 15" RCP  |  |
| CB-271 TO DI-275   | 15"  | 133.35' | 1.39% | 15" RCP  |  |
| CB-272 TO DI-273   | 15"  | 26.99'  | 0.50% | 15" RCP  |  |
| CB-273 TO DI-274   | 15"  | 79.57'  | 0.50% | 15" RCP  |  |
| CB-279 TO CB-280   | 24"  | 27.00'  | 1.11% | 24" RCP  |  |
| CB-279 TO CB-283   | 18"  | 89.27'  | 0.88% | 18" RCP  |  |
| CB-280 TO CB-281   | 18"  | 44.85'  | 0.82% | 18" RCP  |  |
| CB-281 TO CB-282   | 15"  | 59.41'  | 1.80% | 15" RCP  |  |
| CB-282 TO DI-290   | 15"  | 34.75'  | 6.88% | 15" RCP  |  |
| CB-283 TO CB-287   | 15"  | 69.27'  | 3.43% | 18" RCP  |  |
| CB-283 TO DI-293   | 18"  | 77.38'  | 0.50% | 18" RCP  |  |
| CB-285 TO CB-286   | 18"  | 74.03'  | 2.84% | 18" RCP  |  |
| CB-286 TO CB-287   | 15"  | 27.01'  | 0.56% | 15" RCP  |  |
| CB-286 TO CB-289   | 15"  | 146.68' | 1.50% | 15" RCP  |  |
| CB-287 TO CB-288   | 15"  | 24.63'  | 3.86% | 15" RCP  |  |
| CB-288 TO CB-2006  | 15"  | 29.48'  | 0.53% | 15" RCP  |  |
| CB-2006 TO DI-2010 | 15"  | 57.48'  | 0.50% | 15" RCP  |  |
| CB-2006 TO CB-2007 | 15"  | 21.08'  | 3.56% | 15" RCP  |  |
| DCB-202 TO CB-203  | 30"  | 78.32'  | 0.98% | 30" RCP  |  |



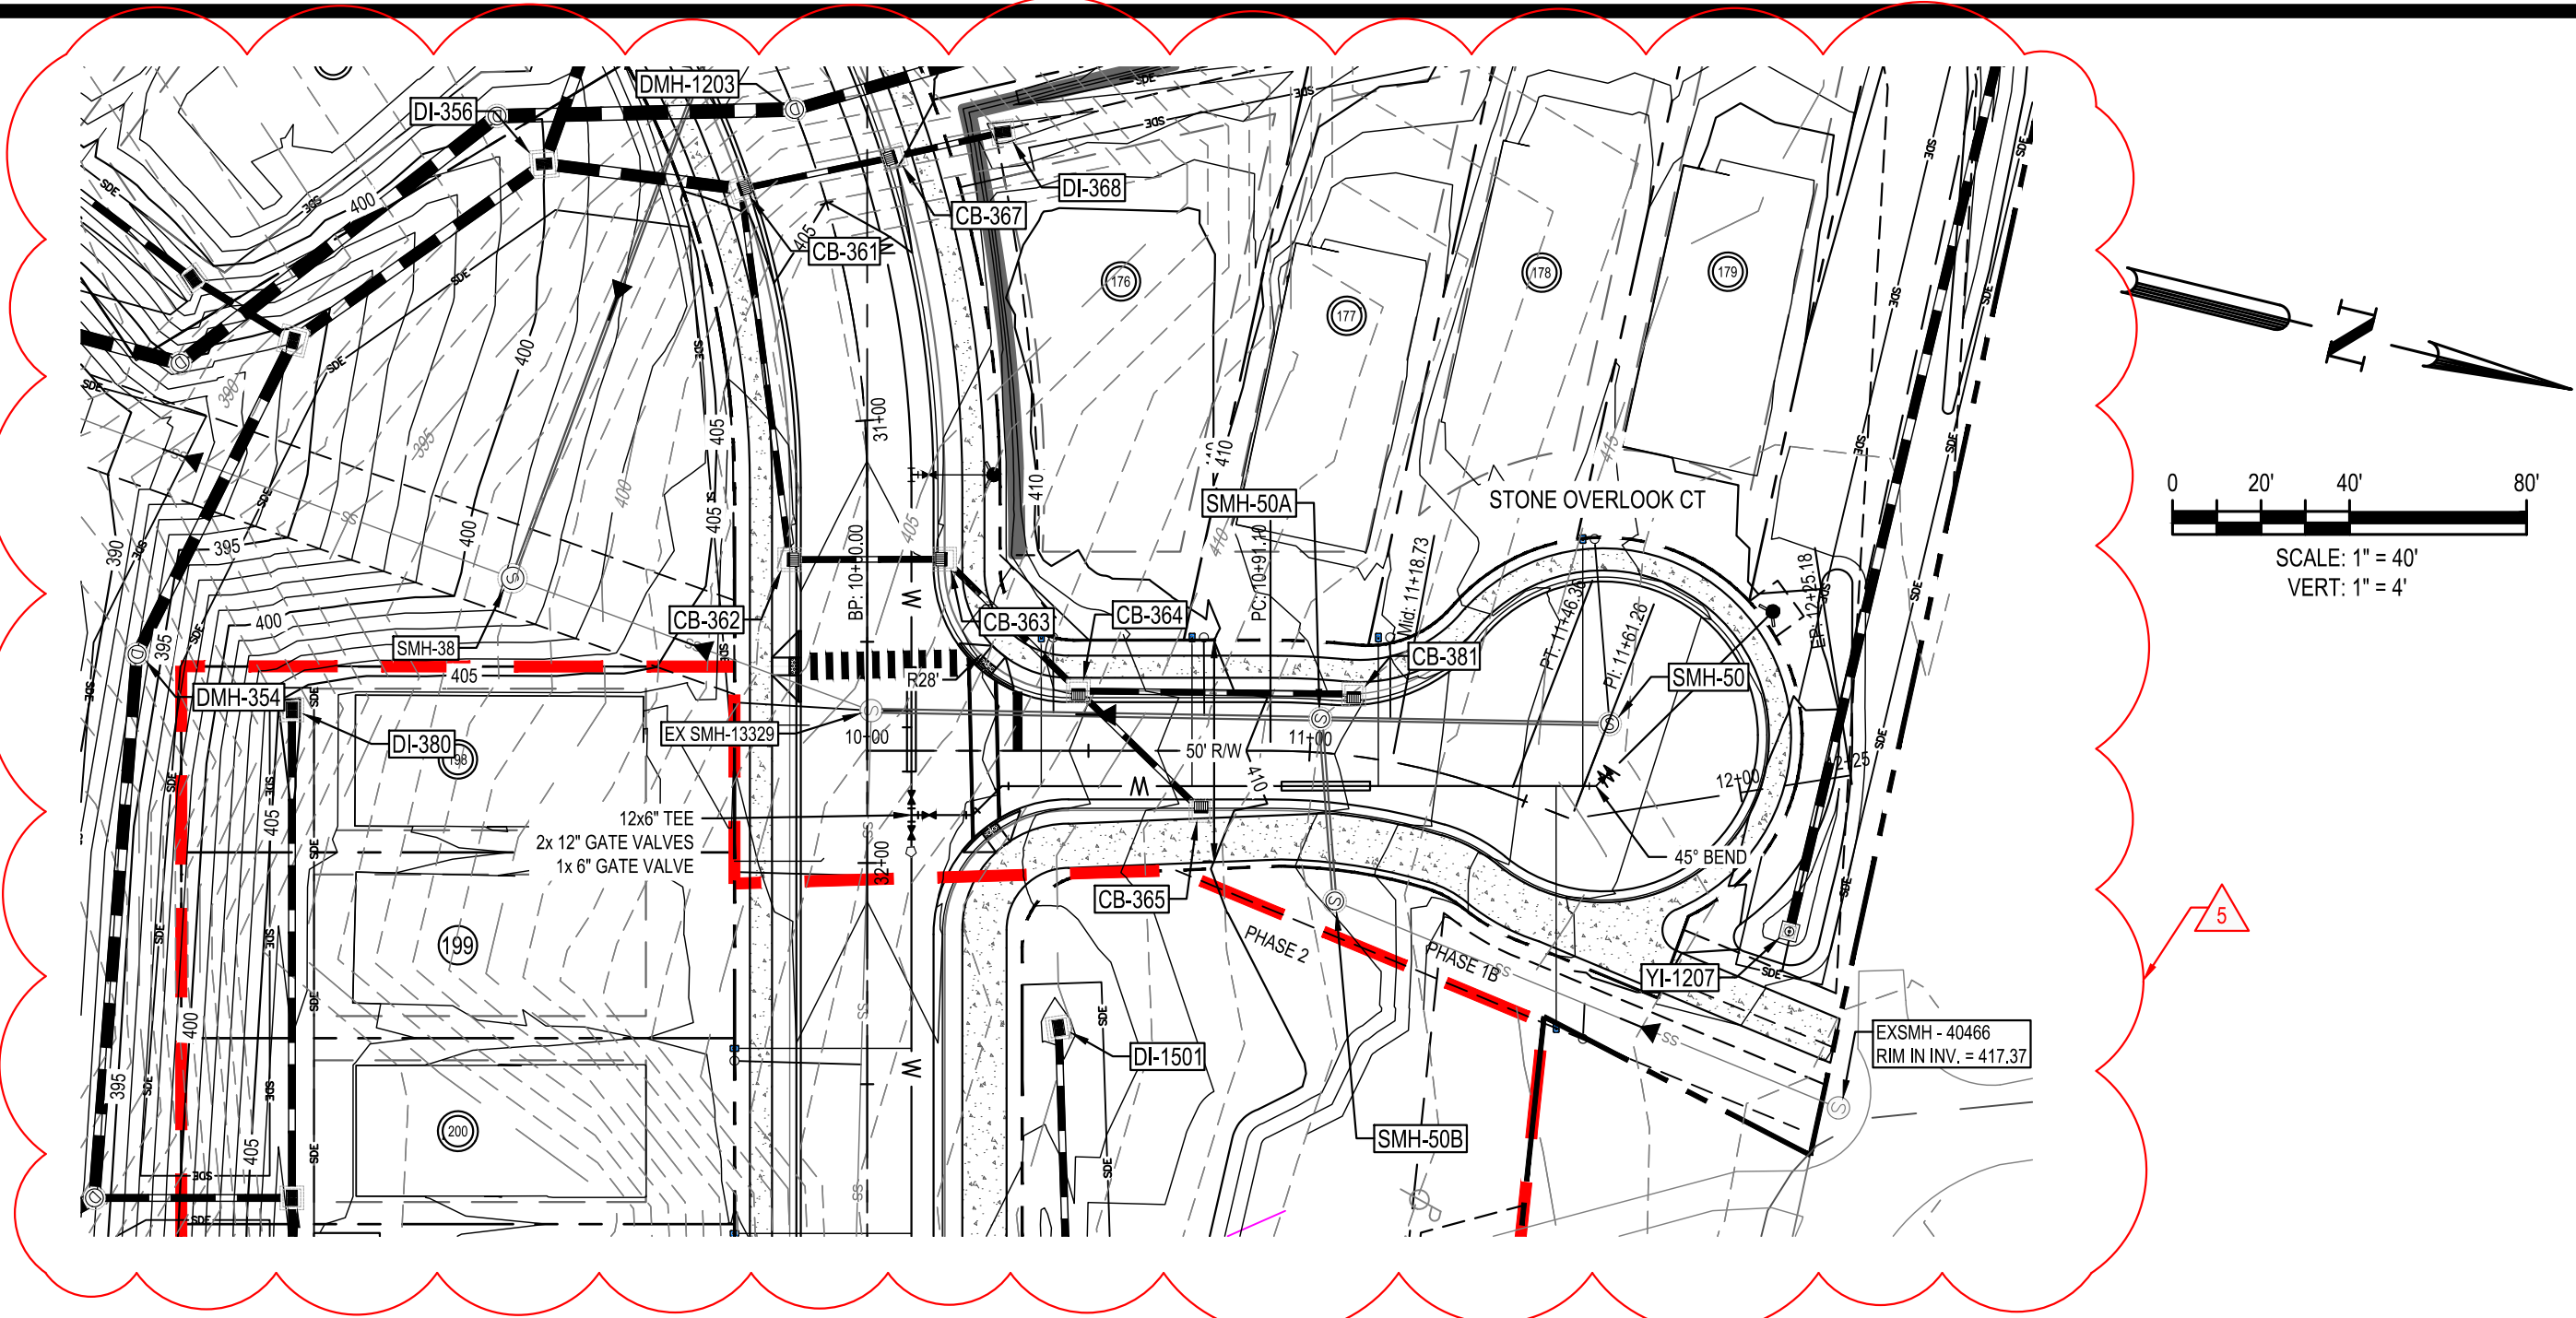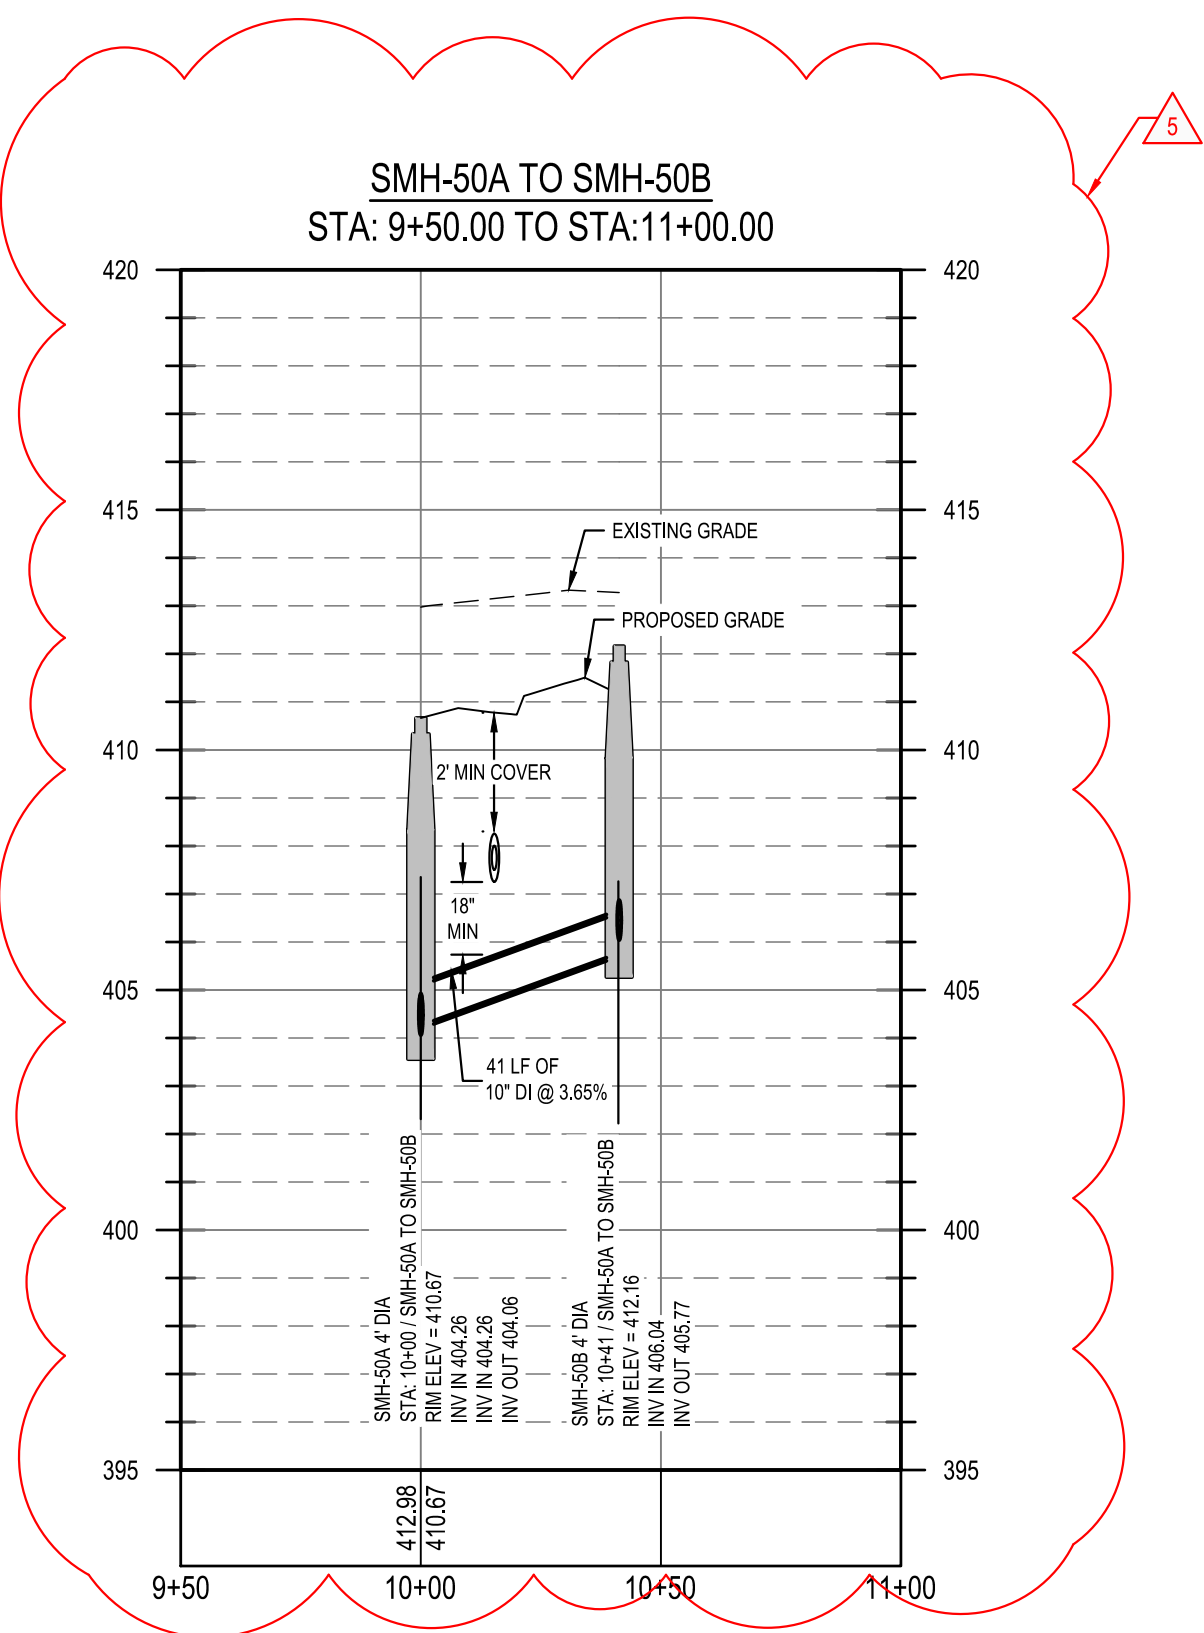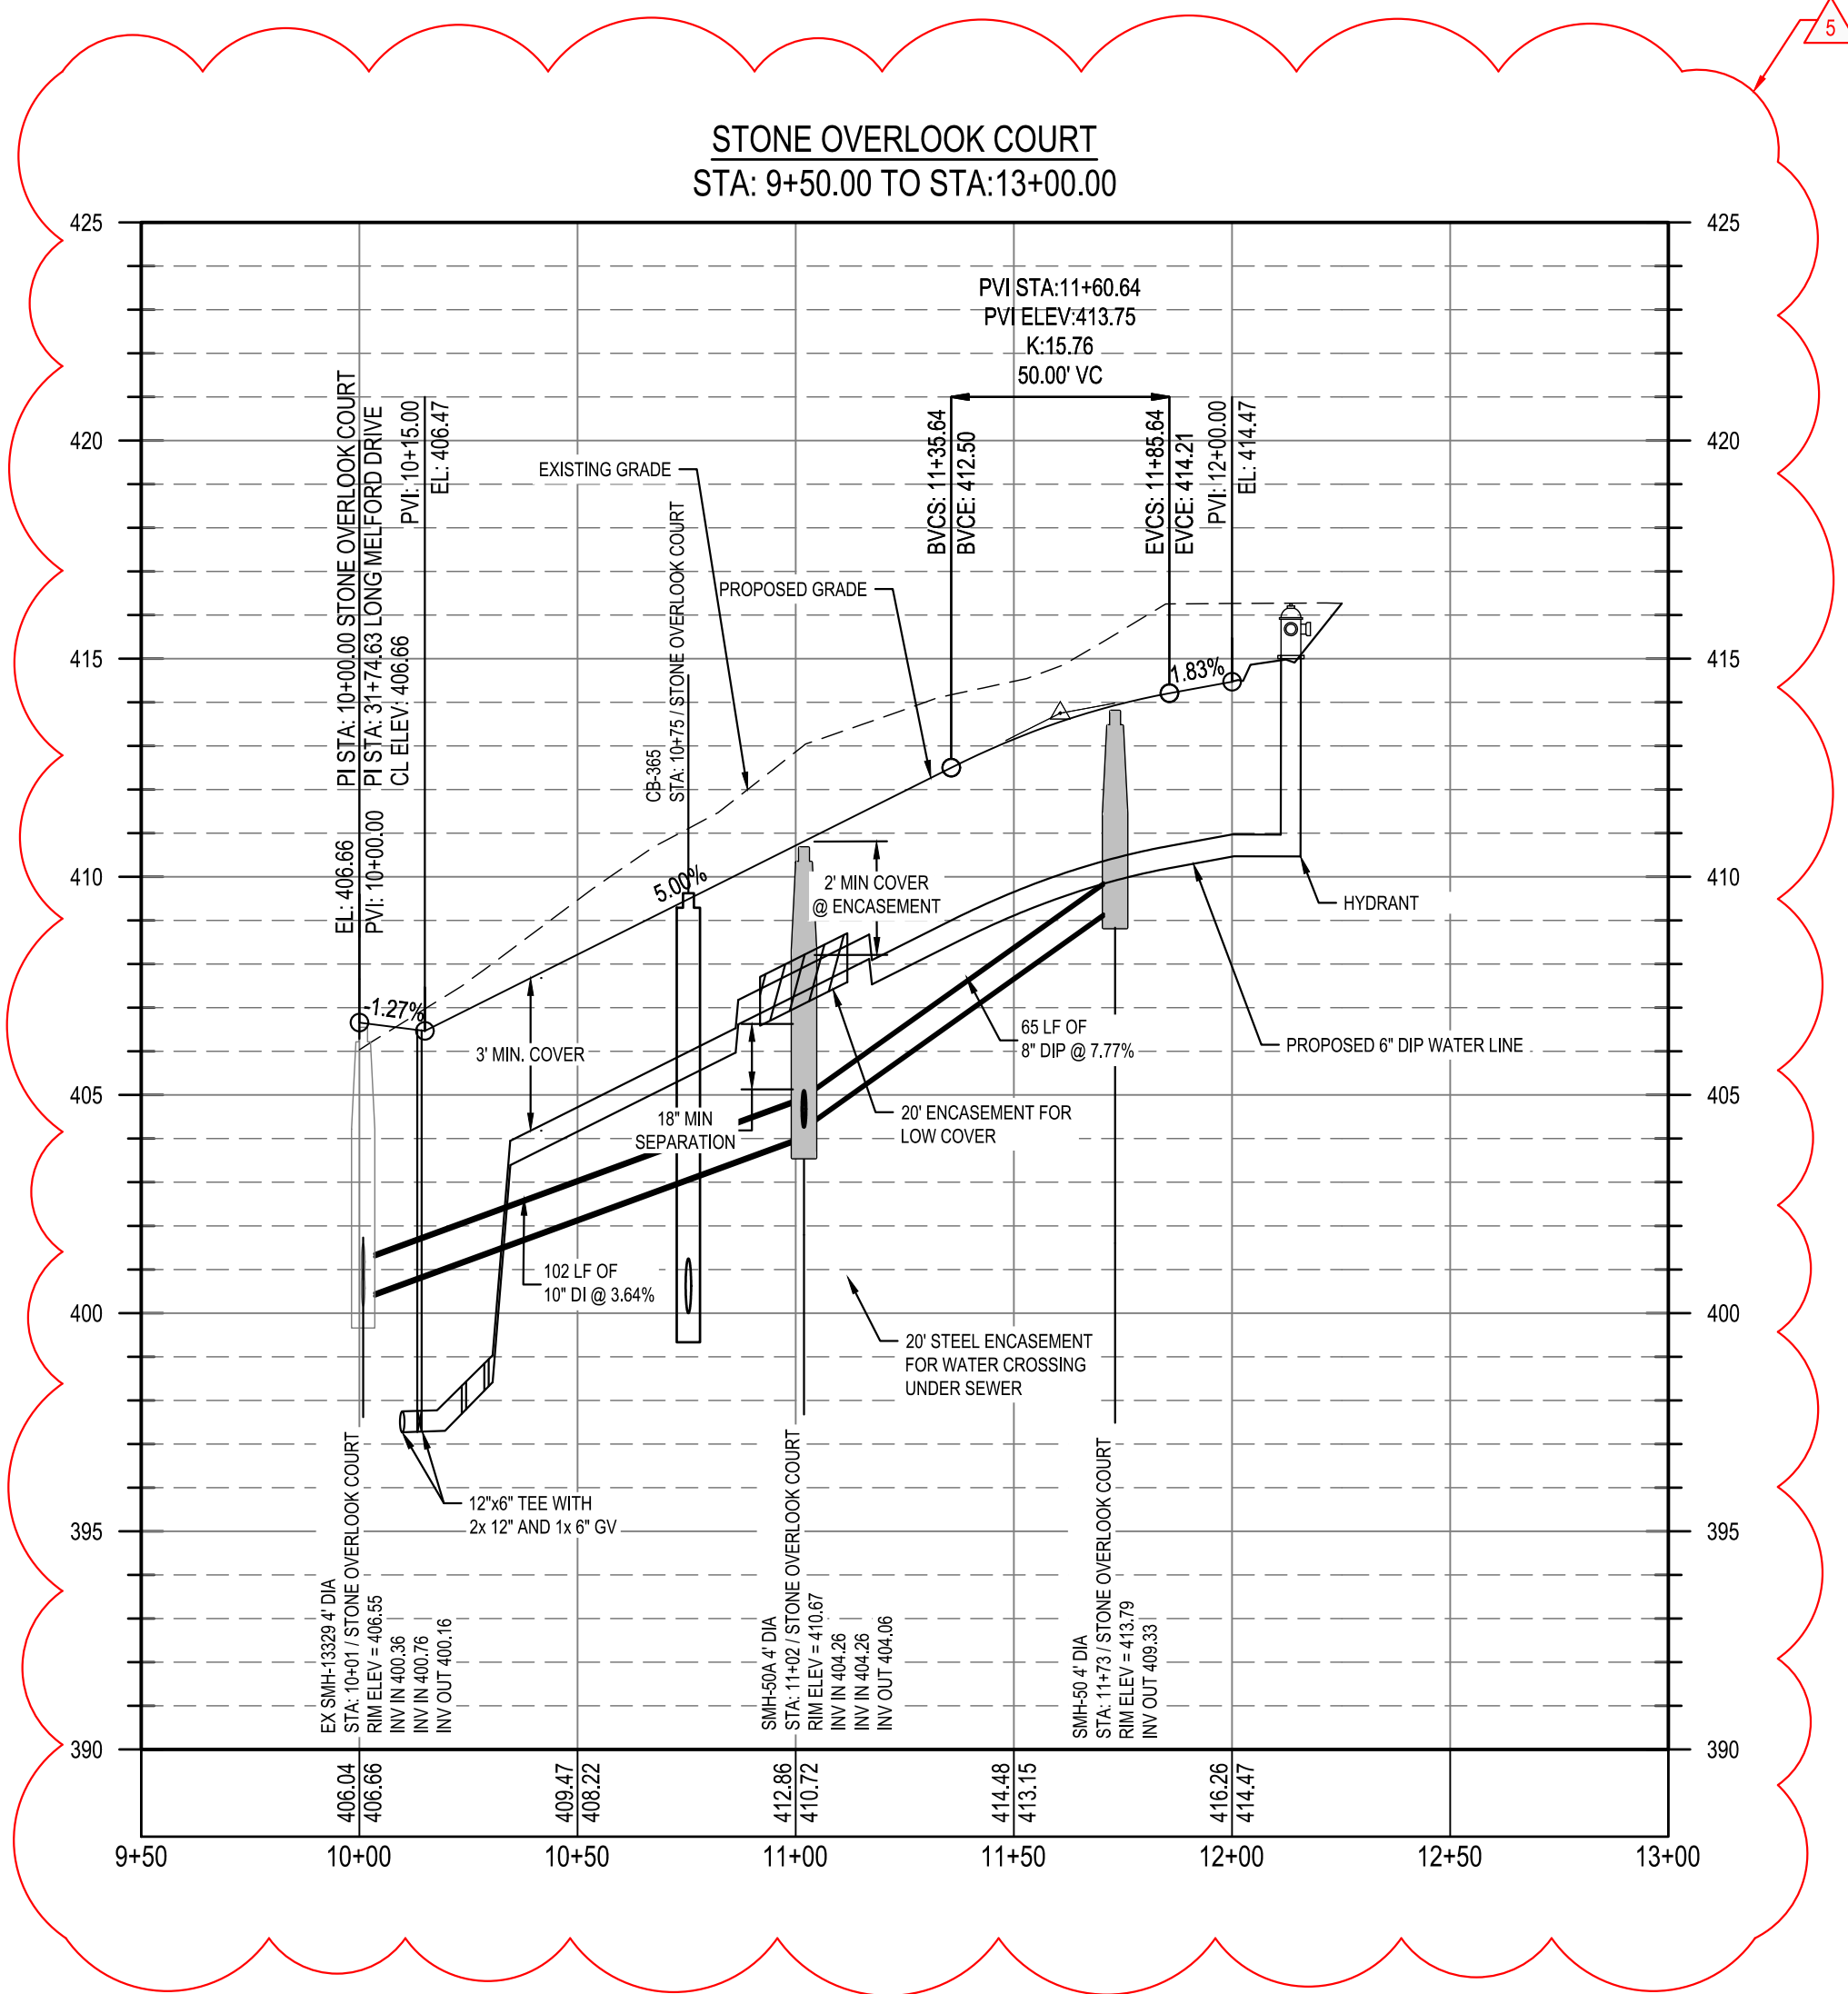

|   |   |
|---|---|
| <b>Public</b><br>Water Distribution / Extension System<br>The City of Raleigh consents to the connection and extension of the City's public water system as shown on this plan. The material and Construction methods used for this project shall conform to the standards and specifications of the City's Public Utilities Handbook.<br>City of Raleigh<br>Public Utilities Department Permit # WI-4107<br>Authorization to Construct: See digital signature | <b>Public</b><br>Sewer Collection / Extension System<br>The City of Raleigh consents to the connection and extension of the City's public sewer system as shown on this plan. The material and Construction methods used for this project shall conform to the standards and specifications of the City's Public Utilities Handbook.<br>City of Raleigh<br>Public Utilities Department Permit # S-5439<br>Authorization to Construct: See digital signature |
|---|---|

CITY OF RALEIGH - PLANS AUTHORIZED FOR CONSTRUCTION

Electronic Approval: This approval is being issued electronically. This approval is valid only upon the signature of a City of Raleigh Review Officer below. The City will retain a copy of the approved plans. Any work authorized by this approval must proceed in accordance with the plans kept on file with the City. This electronic approval may not be edited once issued. Any modification to this approval once issued will invalidate this approval.

City of Raleigh Development Approval \_\_\_\_\_



Raleigh Water Review Officer \_\_\_\_\_

**811**

Know what's below.  
Call before you dig.

|   |                    |                 |            |             |            |
|---|--------------------|-----------------|------------|-------------|------------|
| <br>5438 WADE PARK BLVD, SUITE 420<br>RALEIGH NC 27607<br>WWW.BCEINC.COM<br>NC LICENSE #C-4397              | DESIGNED BY: DF/CD | REVIEWED BY: DF | DATE       | DESCRIPTION |            |
|   | DRAWN BY: DF/JWM   |                 |            |             |            |
|   | REV                |                 |            |             |            |
|   | 03/24/2025         | 03/24/2025      | 03/24/2025 | 03/24/2025  | 03/24/2025 |



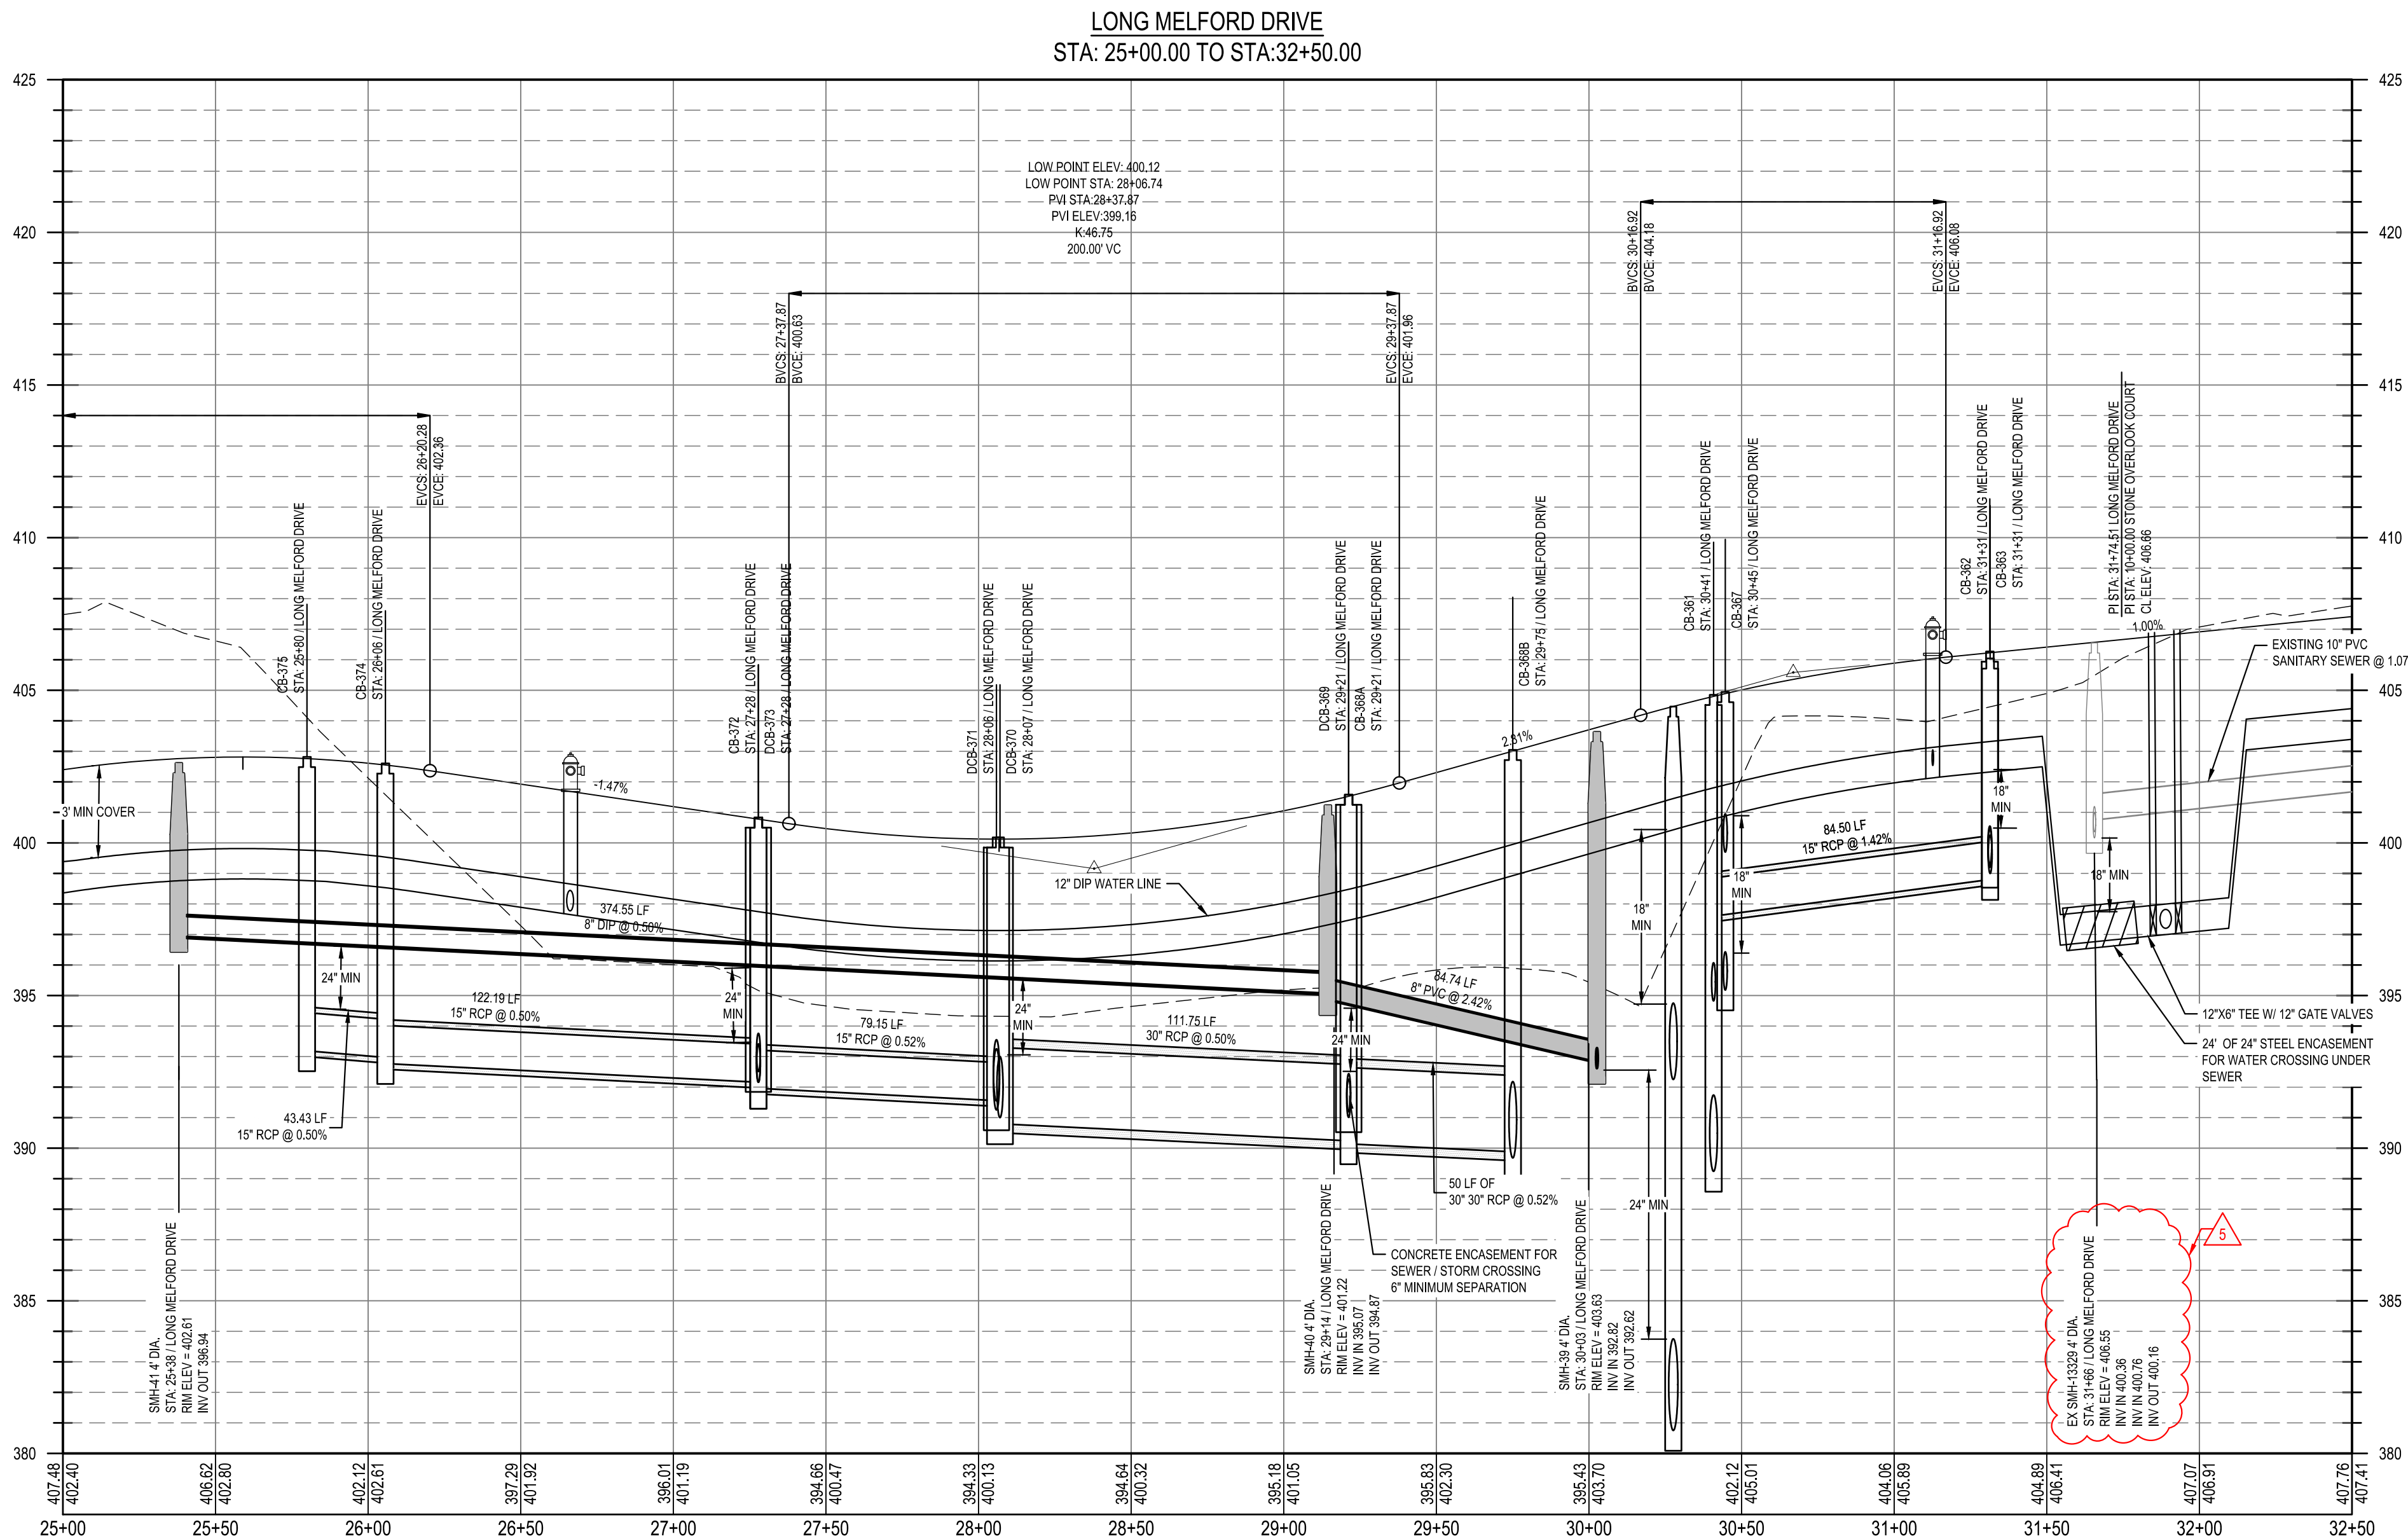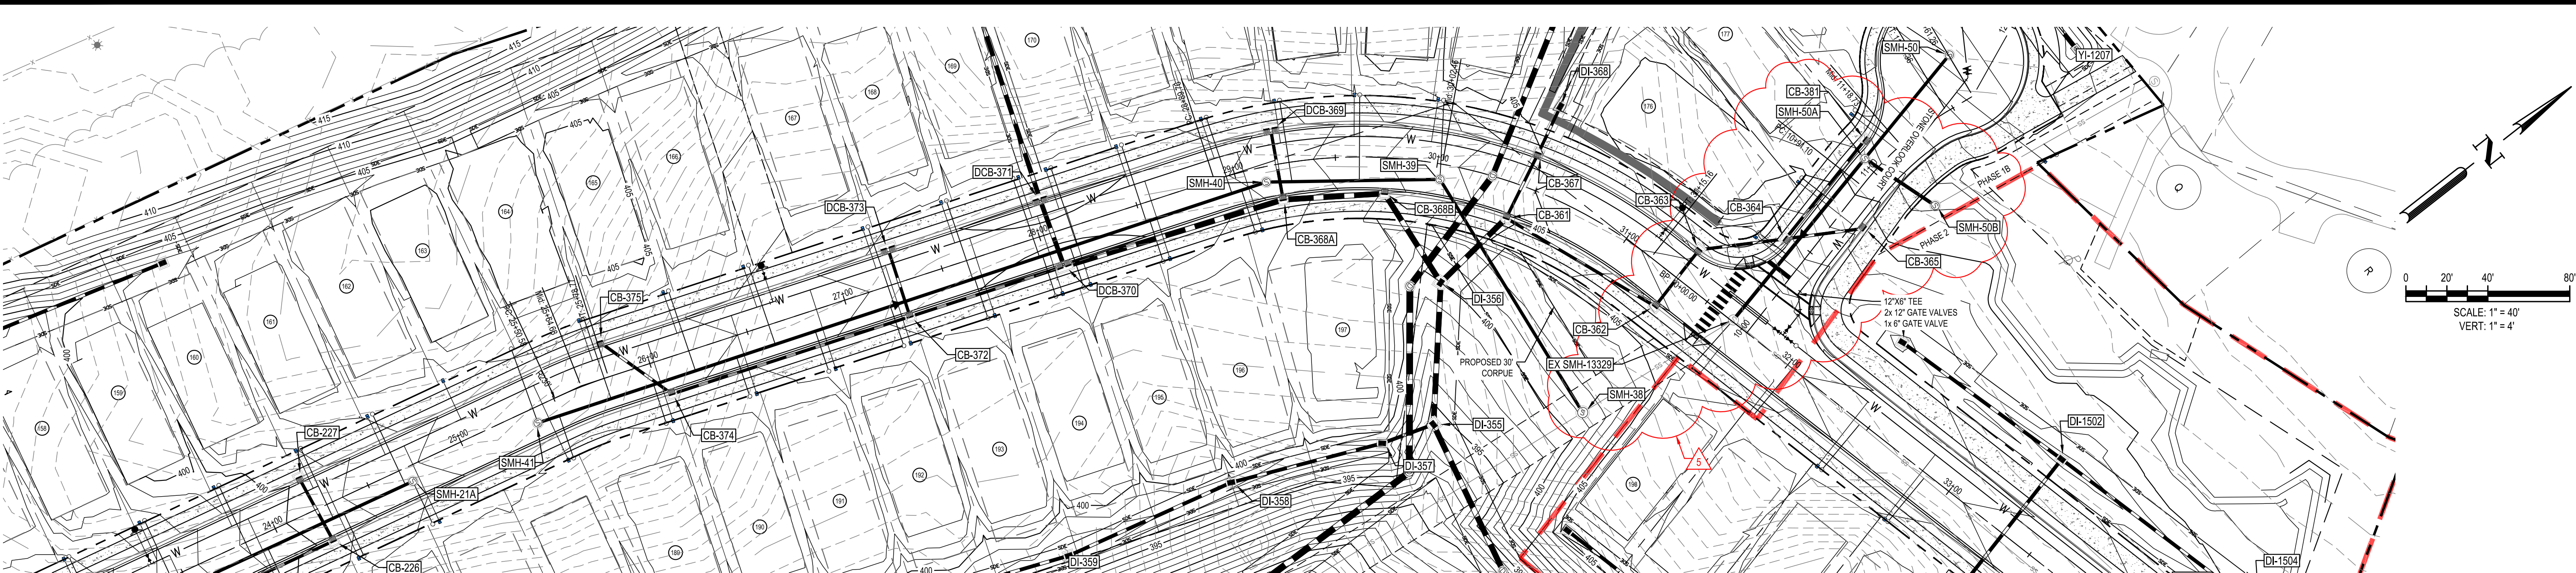

**Public**  
**Water Distribution / Extension System**  
The City of Raleigh consents to the connection and extension of the City's public water system as shown on this plan. The material and Construction methods used for this project shall conform to the standards and specifications of the City's Public Utilities Handbook.  
City of Raleigh  
Public Utilities Department Permit # **WI-4107**  
Authorization to Construct: See digital signature

**Public**  
**Sewer Collection / Extension System**  
The City of Raleigh consents to the connection and extension of the City's public sewer system as shown on this plan. The material and Construction methods used for this project shall conform to the standards and specifications of the City's Public Utilities Handbook.  
City of Raleigh  
Public Utilities Department Permit # **S-5439**  
Authorization to Construct: See digital signature

CITY OF RALEIGH - PLANS AUTHORIZED FOR CONSTRUCTION

Electronic Approval: This approval is being issued electronically. This approval is valid only upon the signature of a City of Raleigh Review Officer below. The City will retain a copy of the approved plans. Any work authorized by this approval must proceed in accordance with the plans kept on file with the City. This electronic approval may not be edited once issued. Any modification to this approval once issued will invalidate this approval.

City of Raleigh Development Approval \_\_\_\_\_  
Raleigh Water Review Officer \_\_\_\_\_



Know what's below.  
Call before you dig.



FILE NUMBER:  
**8430-03**  
DATE: **3/24/2025**

**C6-11**


**PARKER RIDGE**  
82 SCHOOL STREET  
ROLESVILLE / NORTH CAROLINA / 27571

**LENNAR**  
**CORPORAION**  
1100 PERIMETER PARK DRIVE, SUITE 112  
MORRISVILLE / NORTH CAROLINA / 27560

**BCE**  
5438 WALDE PARK BLVD, SUITE 420  
RALEIGH NC 27607  
WWW.BCEINC.COM  
NC LICENSE #C-4397

|              |     |            |                                  |
|--------------|-----|------------|----------------------------------|
| DESIGNED BY: | △   | 03/24/2025 | SUBPHASING, SEWER, & CURB TYPES  |
| DRAWN BY:    | △   | 11/04/2024 | AMENITY CENTER REVISIONS         |
| REVIEWED BY: | △   | 06/06/2024 | RETAINING WALL LOCATION REVISION |
|              | △   | 06/04/2024 | STORM STRUCTURE REVISIONS        |
|              | △   | 04/08/2024 | EROSION CONTROL REVISION         |
|              | REV | DATE       | DESCRIPTION                      |



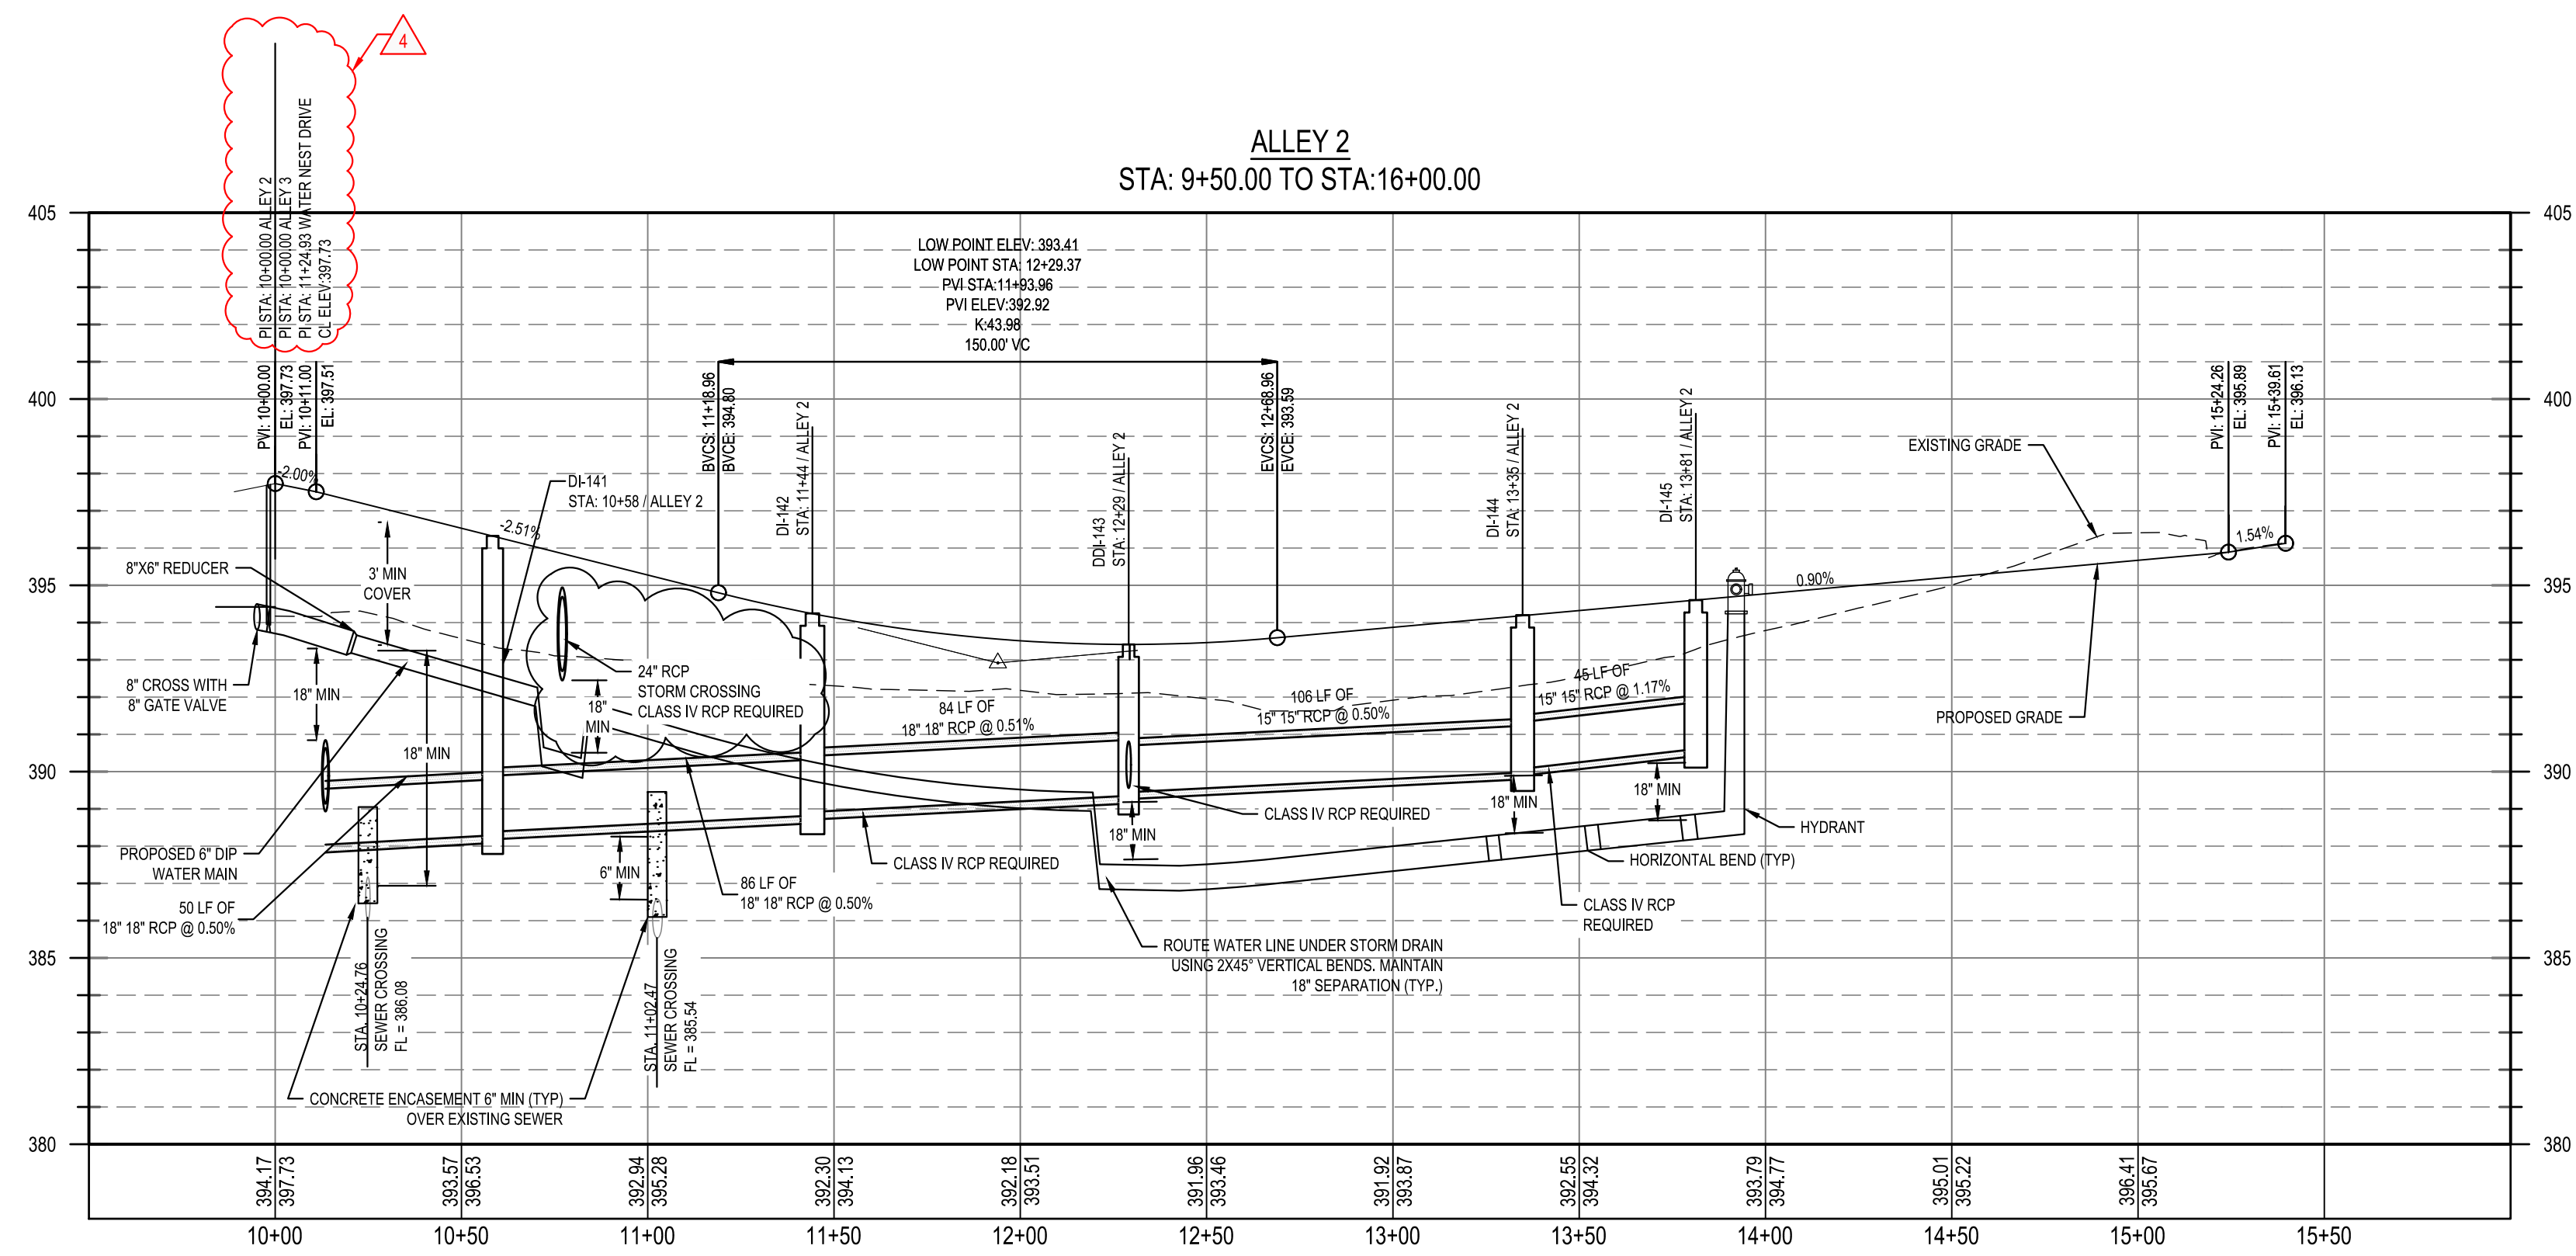

**CITY OF RALEIGH - PLANS AUTHORIZED FOR CONSTRUCTION**


Electronic Approval of this approval is being issued electronically. This approval is valid only upon the signature of a City of Raleigh Review Officer below. The City will retain a copy of the approved plans. Any work authorized by this approval must proceed in accordance with the plans kept on file with the City. This electronic approval may not be edited once issued. Any modification to this approval once issued will invalidate this approval.

City of Raleigh Development Approval \_\_\_\_\_

Raleigh Water Review Officer \_\_\_\_\_

[illegible]



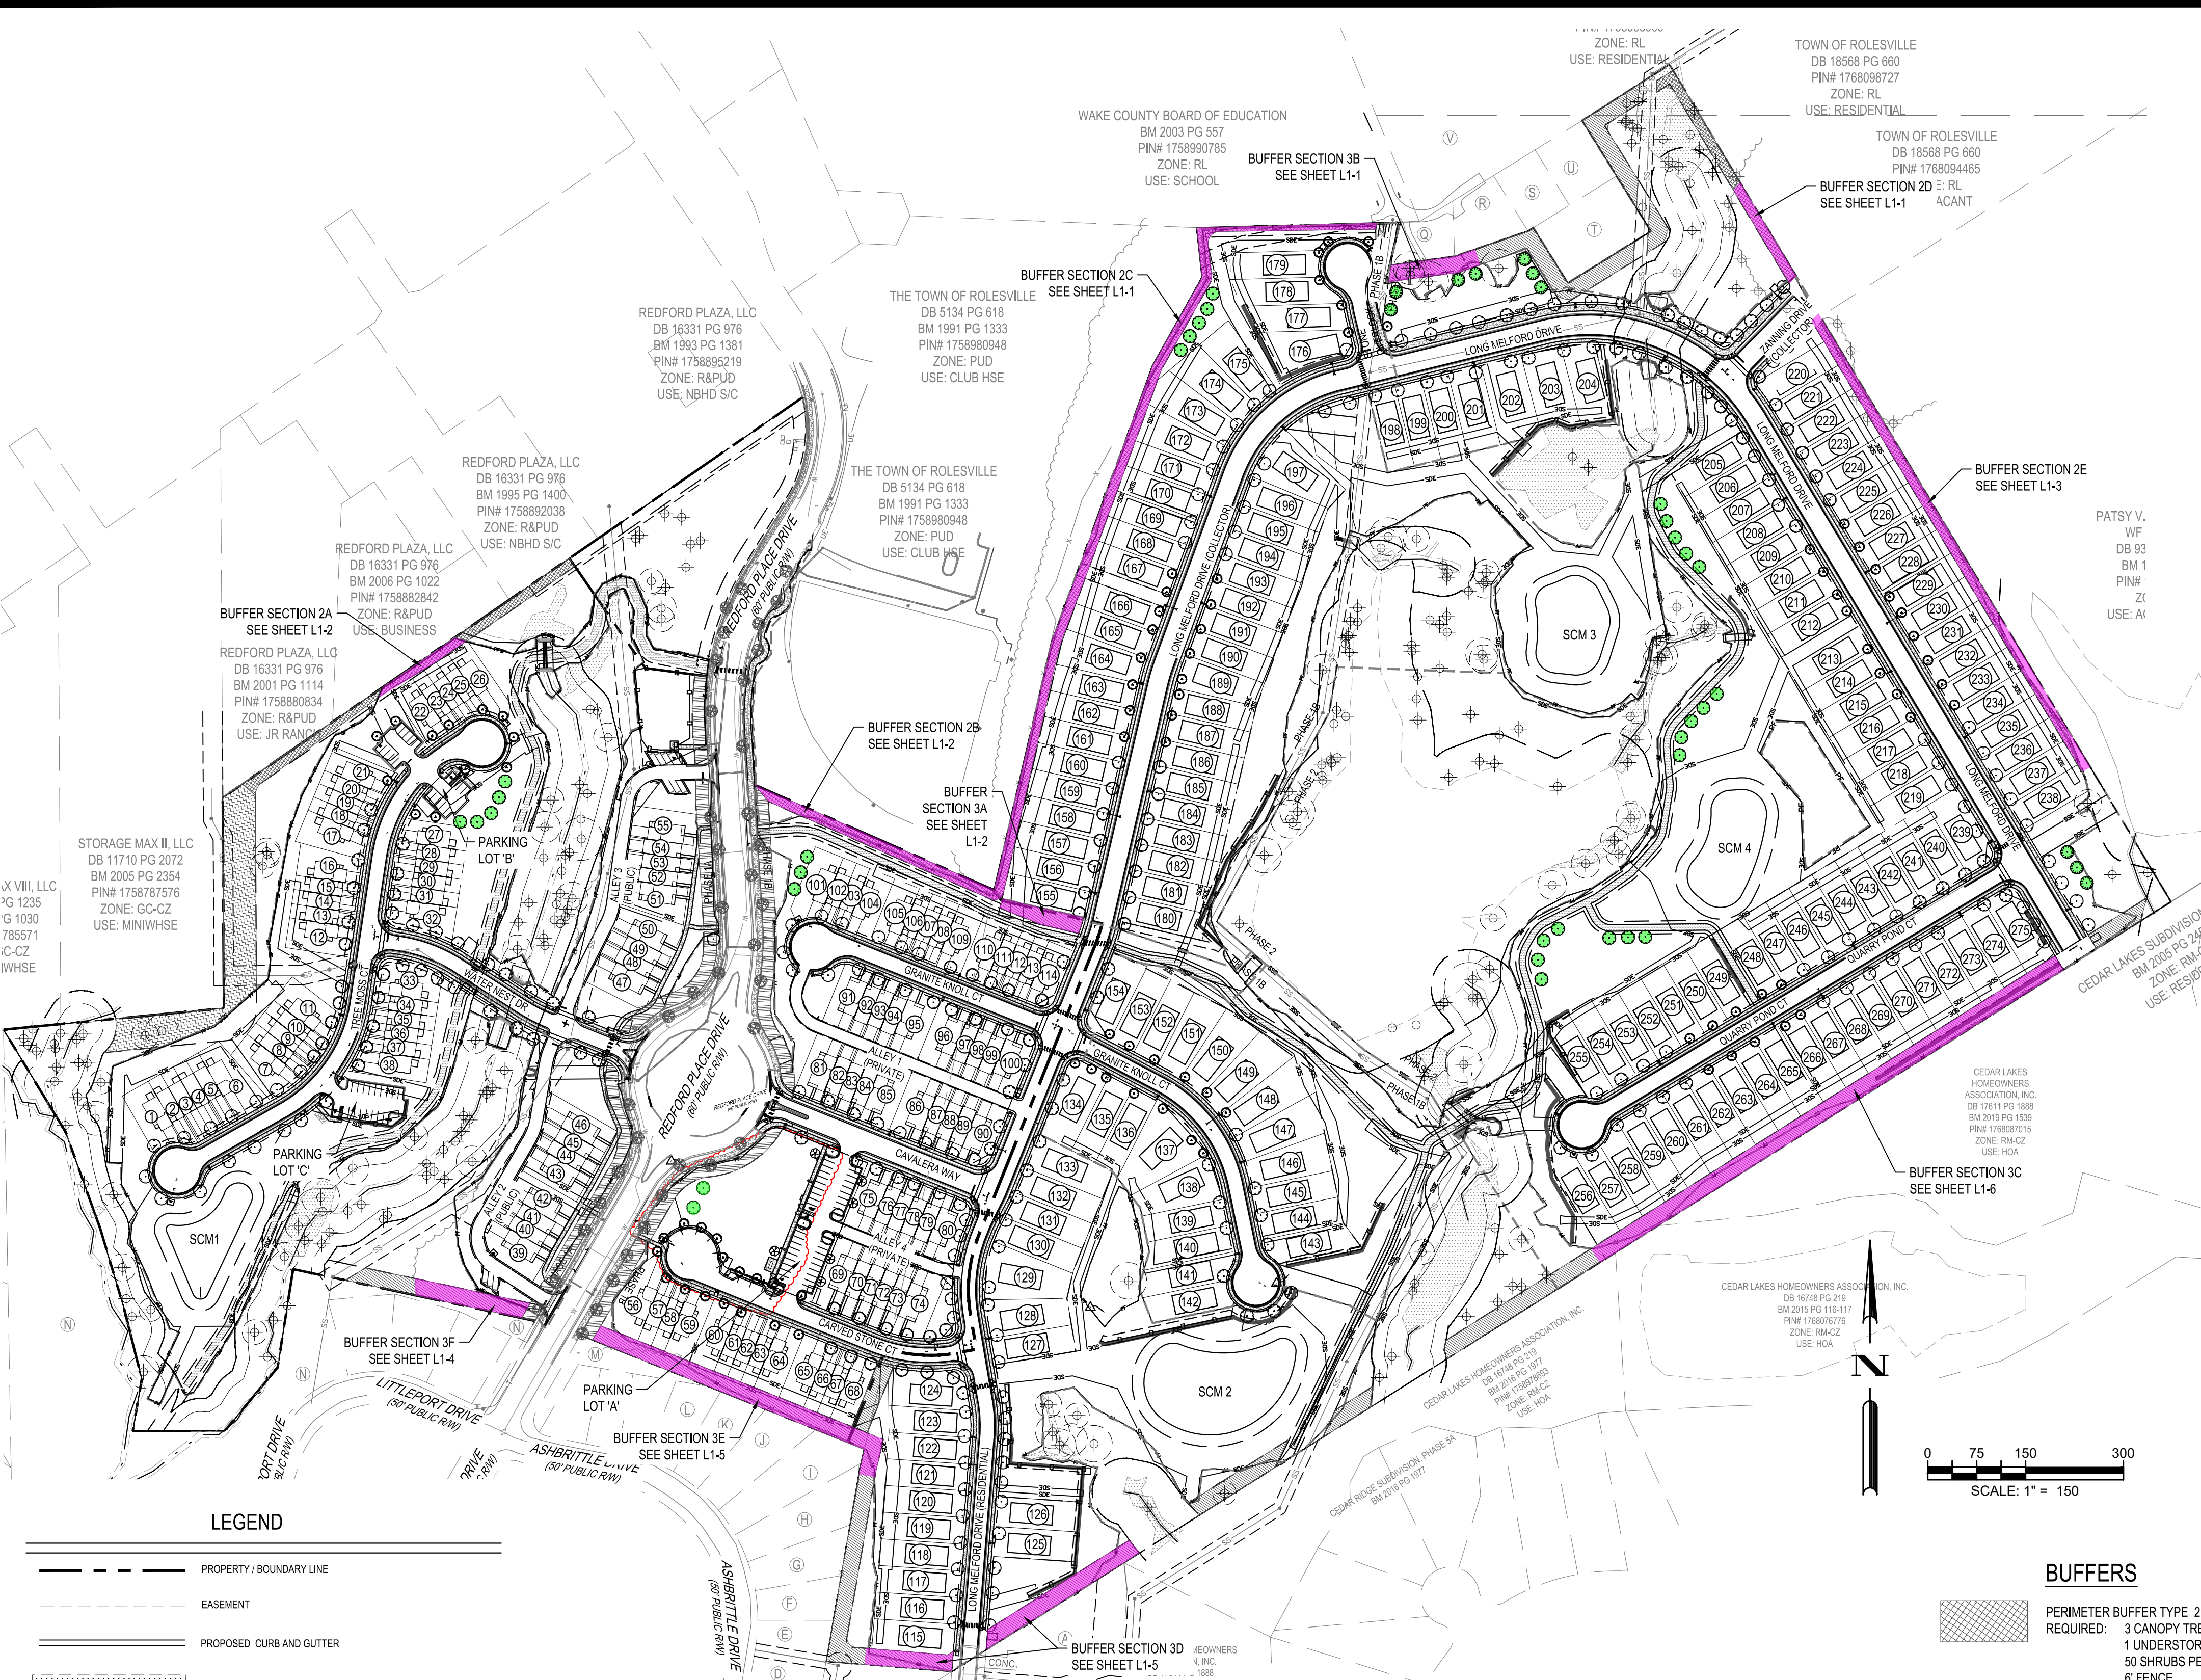

**LEGEND**

PROPERTY / BOUNDARY LINE

EASEMENT

PROPOSED CURB AND GUTTER

WETLANDS

50' STREAM BUFFER

TREE PROTECTION FENCE

LIMIT OF CONSTRUCTION

BUFFER SECTION TO BE PLANTED\*

EXISTING STREET TREE

PRESERVED TREE

PRESERVED TREE CLOSE TO CONSTRUCTION LIMIT  
(CRITICAL ROOT ZONE SHOWN)

\* BUFFER SECTION LACKING EXISTING VEGETATION OR  
DISTURBED BY GRADING. SEE ENLARGEMENT SHEETS  
FOR PLANT QUANTITIES.

TYPICAL BUFFER SECTION: TYPE 2  
SCALE: 1:30

TYPICAL BUFFER SECTION: TYPE 3  
SCALE: 1:30

| PLANT SCHEDULE: BUFFERS |      |     |                               |                       |                 |
|-------------------------|------|-----|-------------------------------|-----------------------|-----------------|
| CANOPY TREES            | CODE | QTY | BOTANICAL NAME                | COMMON NAME           | CAL HT          |
|                         | AS   | 47  | Acer saccharum                | Sugar Maple           | 2" MIN. 8' MIN. |
|                         | QN   | 70  | Quercus nuttallii             | Nuttall Oak           | 2" MIN. 8' MIN. |
|                         | UP   | 47  | Ulmus parvifolia              | Lacebark Elm          | 2" MIN. 8' MIN. |
| UNDERSTORY TREES        | CODE | QTY | BOTANICAL NAME                | COMMON NAME           | CAL HT          |
|                         | CC   | 21  | Cercis canadensis             | Eastern Redbud        | 1" MIN. 8' MIN. |
|                         | MS   | 47  | Magnolia stellata             | Star Magnolia         | 1" MIN. 8' MIN. |
| SHRUBS                  | CODE | QTY | BOTANICAL NAME                | COMMON NAME           | HT SPR          |
|                         | AG   | 687 | Abelia x grandiflora          | Glossy Abelia         | 18-24" 18-24"   |
|                         | IC   | 523 | Ilex cornuta 'Burfordii Nana' | Dwarf Burford Holly   | 18-24" 18-24"   |
|                         | IR   | 305 | Ilex crenata 'Rotundifolia'   | Japanese Holly        | 18-24" 18-24"   |
|                         | IG   | 349 | Ilex glabra                   | Inkberry Holly        | 18-24" 18-24"   |
|                         | IV   | 585 | Ilex vomitoria 'Nana'         | Dwarf Yaupon          | 18-24" 18-24"   |
|                         | LC   | 126 | Loropetalum chinense          | Chinese Fringe Flower | 18-24" 18-24"   |

| PLANT SCHEDULE: STREET TREES AND PARKING |      |     |                         |                  |                 |
|------------------------------------------|------|-----|-------------------------|------------------|-----------------|
| CANOPY TREES                             | CODE | QTY | BOTANICAL NAME          | COMMON NAME      | CAL HT          |
|                                          | AS   | 95  | Acer saccharum          | Sugar Maple      | 2" MIN. 8' MIN. |
|                                          | KP   | 6   | Koeleruteria paniculata | Golden Rain Tree | 2" MIN. 8' MIN. |
|                                          | PS   | 92  | Pistacia chinensis      | Chinese Pistache | 2" MIN. 8' MIN. |
|                                          | QF   | 10  | Quercus falcata         | Southern Red Oak | 2" MIN. 8' MIN. |
|                                          | QN   | 91  | Quercus nuttallii       | Nuttall Oak      | 2" MIN. 8' MIN. |
|                                          | UP   | 66  | Ulmus parvifolia        | Lacebark Elm     | 2" MIN. 8' MIN. |
|                                          | ZS   | 66  | Zelkova serrata         | Sawleaf Zelkova  | 2" MIN. 8' MIN. |
| SHRUBS                                   | CODE | QTY | BOTANICAL NAME          | COMMON NAME      | HT SPR          |
|                                          | AG   | 42  | Abelia x grandiflora    | Glossy Abelia    | 18-24" 18-24"   |
|                                          | IV   | 46  | Ilex vomitoria 'Nana'   | Dwarf Yaupon     | 18-24" 18-24"   |

| REPLACEMENT TREES |      |     |                 |                  |                 |
|-------------------|------|-----|-----------------|------------------|-----------------|
| CANOPY TREES      | CODE | QTY | BOTANICAL NAME  | COMMON NAME      | CAL HT          |
|                   | AS   | 32  | Acer saccharum  | Sugar Maple      | 2" MIN. 8' MIN. |
|                   | QF   | 10  | Quercus falcata | Southern Red Oak | 2" MIN. 8' MIN. |

**BUFFERS**

PERIMETER BUFFER TYPE 2: 15' WIDTH, 3,338 TOTAL LF  
REQUIRED: 3 CANOPY TREES PER 100 LF  
1 UNDERSTORY TREE PER 100 LF  
50 SHRUBS PER 100 LF  
6' FENCE  
PROVIDED: SEE SHEET ENLARGEMENTS

PERIMETER BUFFER TYPE 3: 25' WIDTH, 3,884 TOTAL LF  
REQUIRED: 4 CANOPY TREES PER 100 LF  
2 UNDERSTORY TREES PER 100 LF  
60 SHRUBS PER 100 LF  
6' WALL (6' FENCE PER ZONING)  
SEE SHEET ENLARGEMENTS

PERIMETER BUFFER TYPE 4: 50' WIDTH, 517 TOTAL LF  
REQUIRED: 8 CANOPY TREES PER 100 LF  
4 UNDERSTORY TREES PER 100 LF  
CONTINUOUS HEDGE  
3' WALL + 5' BERM (6' FENCE PER ZONING)  
EX. VEGETATION TO SATISFY REQUIREMENT

STREET BUFFER - REDFORD PLACE DRIVE (COLLECTOR):  
20' WIDTH, 2,037 LF OF FRONTAGE  
REQUIRED: 1 STREET TREE EVERY 50 LF OF FRONTAGE  
2,037 LF OF FRONTAGE / 50' = 41 TREES  
41 EXISTING CANOPY TREES TO COUNT  
TOWARD REQUIREMENT

**STREET TREES**

REQUIRED: 1 STREET TREE EVERY 40 LF OF FRONTAGE  
CARVED STONE CT  
REQUIRED: 918 LF OF FRONTAGE / 40' = 23 TREES  
PROVIDED: 28 TREES  
CALAVERA WAY  
REQUIRED: 554 LF OF FRONTAGE / 40' = 14 TREES  
PROVIDED: 14 TREES  
GRANITE KNOLL CT  
REQUIRED: 1,722 LF OF FRONTAGE / 40' = 43 TREES  
PROVIDED: 46 TREES  
STONE OVERLOOK  
REQUIRED: 292 LF OF FRONTAGE / 40' = 7 TREES  
PROVIDED: 7 TREES  
WATER NEST DR  
REQUIRED: 704 LF OF FRONTAGE / 40' = 18 TREES  
PROVIDED: 18 TREES  
TREE MOSS CT  
REQUIRED: 1,660 LF OF FRONTAGE / 40' = 41 TREES  
PROVIDED: 48 TREES  
ZANNING DRIVE  
REQUIRED: 264 LF OF FRONTAGE / 40' = 7 TREES  
PROVIDED: 7 TREES  
LONG MELFORD DRIVE  
REQUIRED: 6,800 LF OF FRONTAGE / 40' = 170 TREES  
PROVIDED: 171 TREES

**PARKING AREAS**

PARKING LOT 'A'  
REQUIRED: PERIMETER SHRUBS 3' O.C.  
ROADWAY SCREENING  
42 SHRUBS  
PROVIDED:  
REQUIRED: 1 TREE / 150 SF OF PARKING ISLANDS  
1,669 SF PARKING ISLANDS = 11 TREES  
PROVIDED: 12 TREES  
PARKING LOT 'B'  
REQUIRED: PERIMETER SHRUBS 3' O.C.  
ROADWAY SCREENING  
25 SHRUBS  
PROVIDED:  
PARKING LOT 'C'  
REQUIRED: PERIMETER SHRUBS 3' O.C.  
ROADWAY SCREENING  
21 SHRUBS  
PROVIDED:

AMENITY CENTER REVISIONS

RETAINING WALL LOCATION REVISION

STORM STRUCTURE REVISIONS

EROSION CONTROL REVISION

11/04/2024

06/06/2024

06/04/2024

04/08/2024

DATE

REV

DESIGNED BY: MC/RZ

DRAWN BY: MC

REVIEWED BY: RZ

5438 WADE PARK BLVD, SUITE 420  
RALEIGH NC 27607  
WWW.BCEINC.COM  
NC LICENSE #C-4397

**BCE**

LENARR  
CORPORAION  
1100 PERIMETER PARK DRIVE, SUITE 112  
MORRISVILLE / NORTH CAROLINA / 27560

PARKER RIDGE  
82 SCHOOL STREET  
ROLESVILLE / NORTH CAROLINA / 27571

OVERALL LANDSCAPE PLAN

3/25/2025

FILE NUMBER:  
8430-03

DATE: 3/11/2025

L1-0