
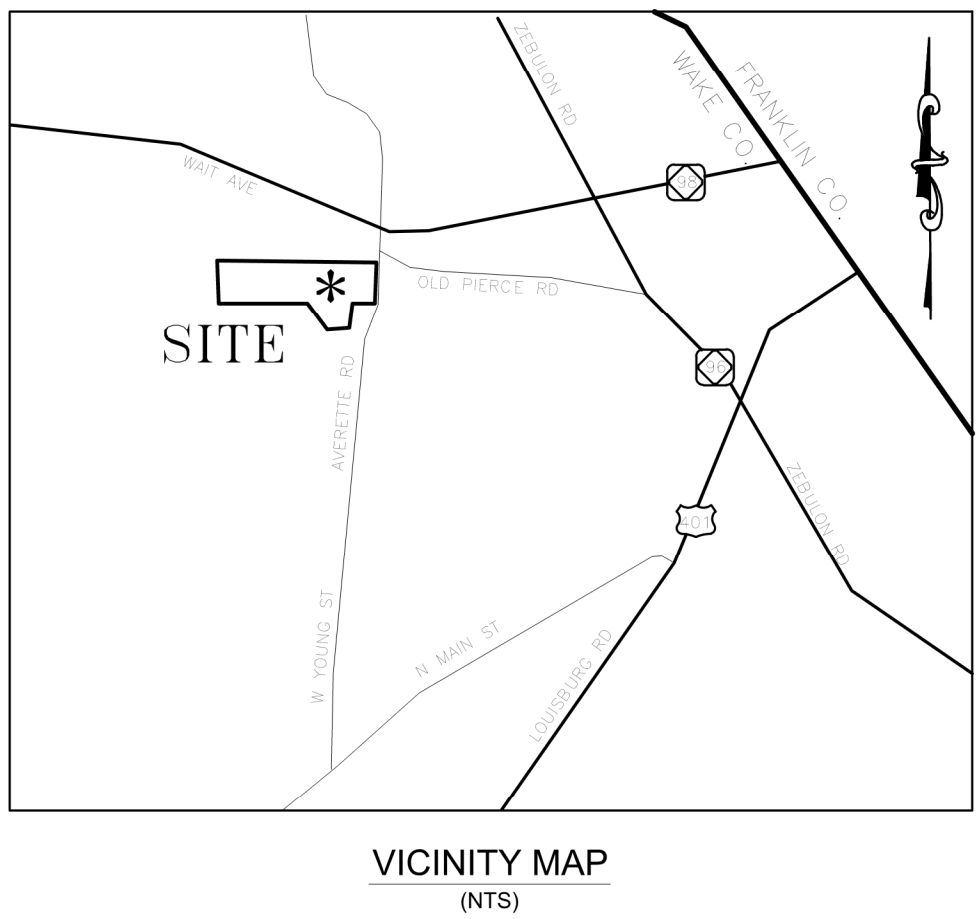


ELIZABETH HEIGHTS

CONSTRUCTION DRAWINGS

TRACT A

TOWN OF ROLESVILLE
WAKE COUNTY, NC

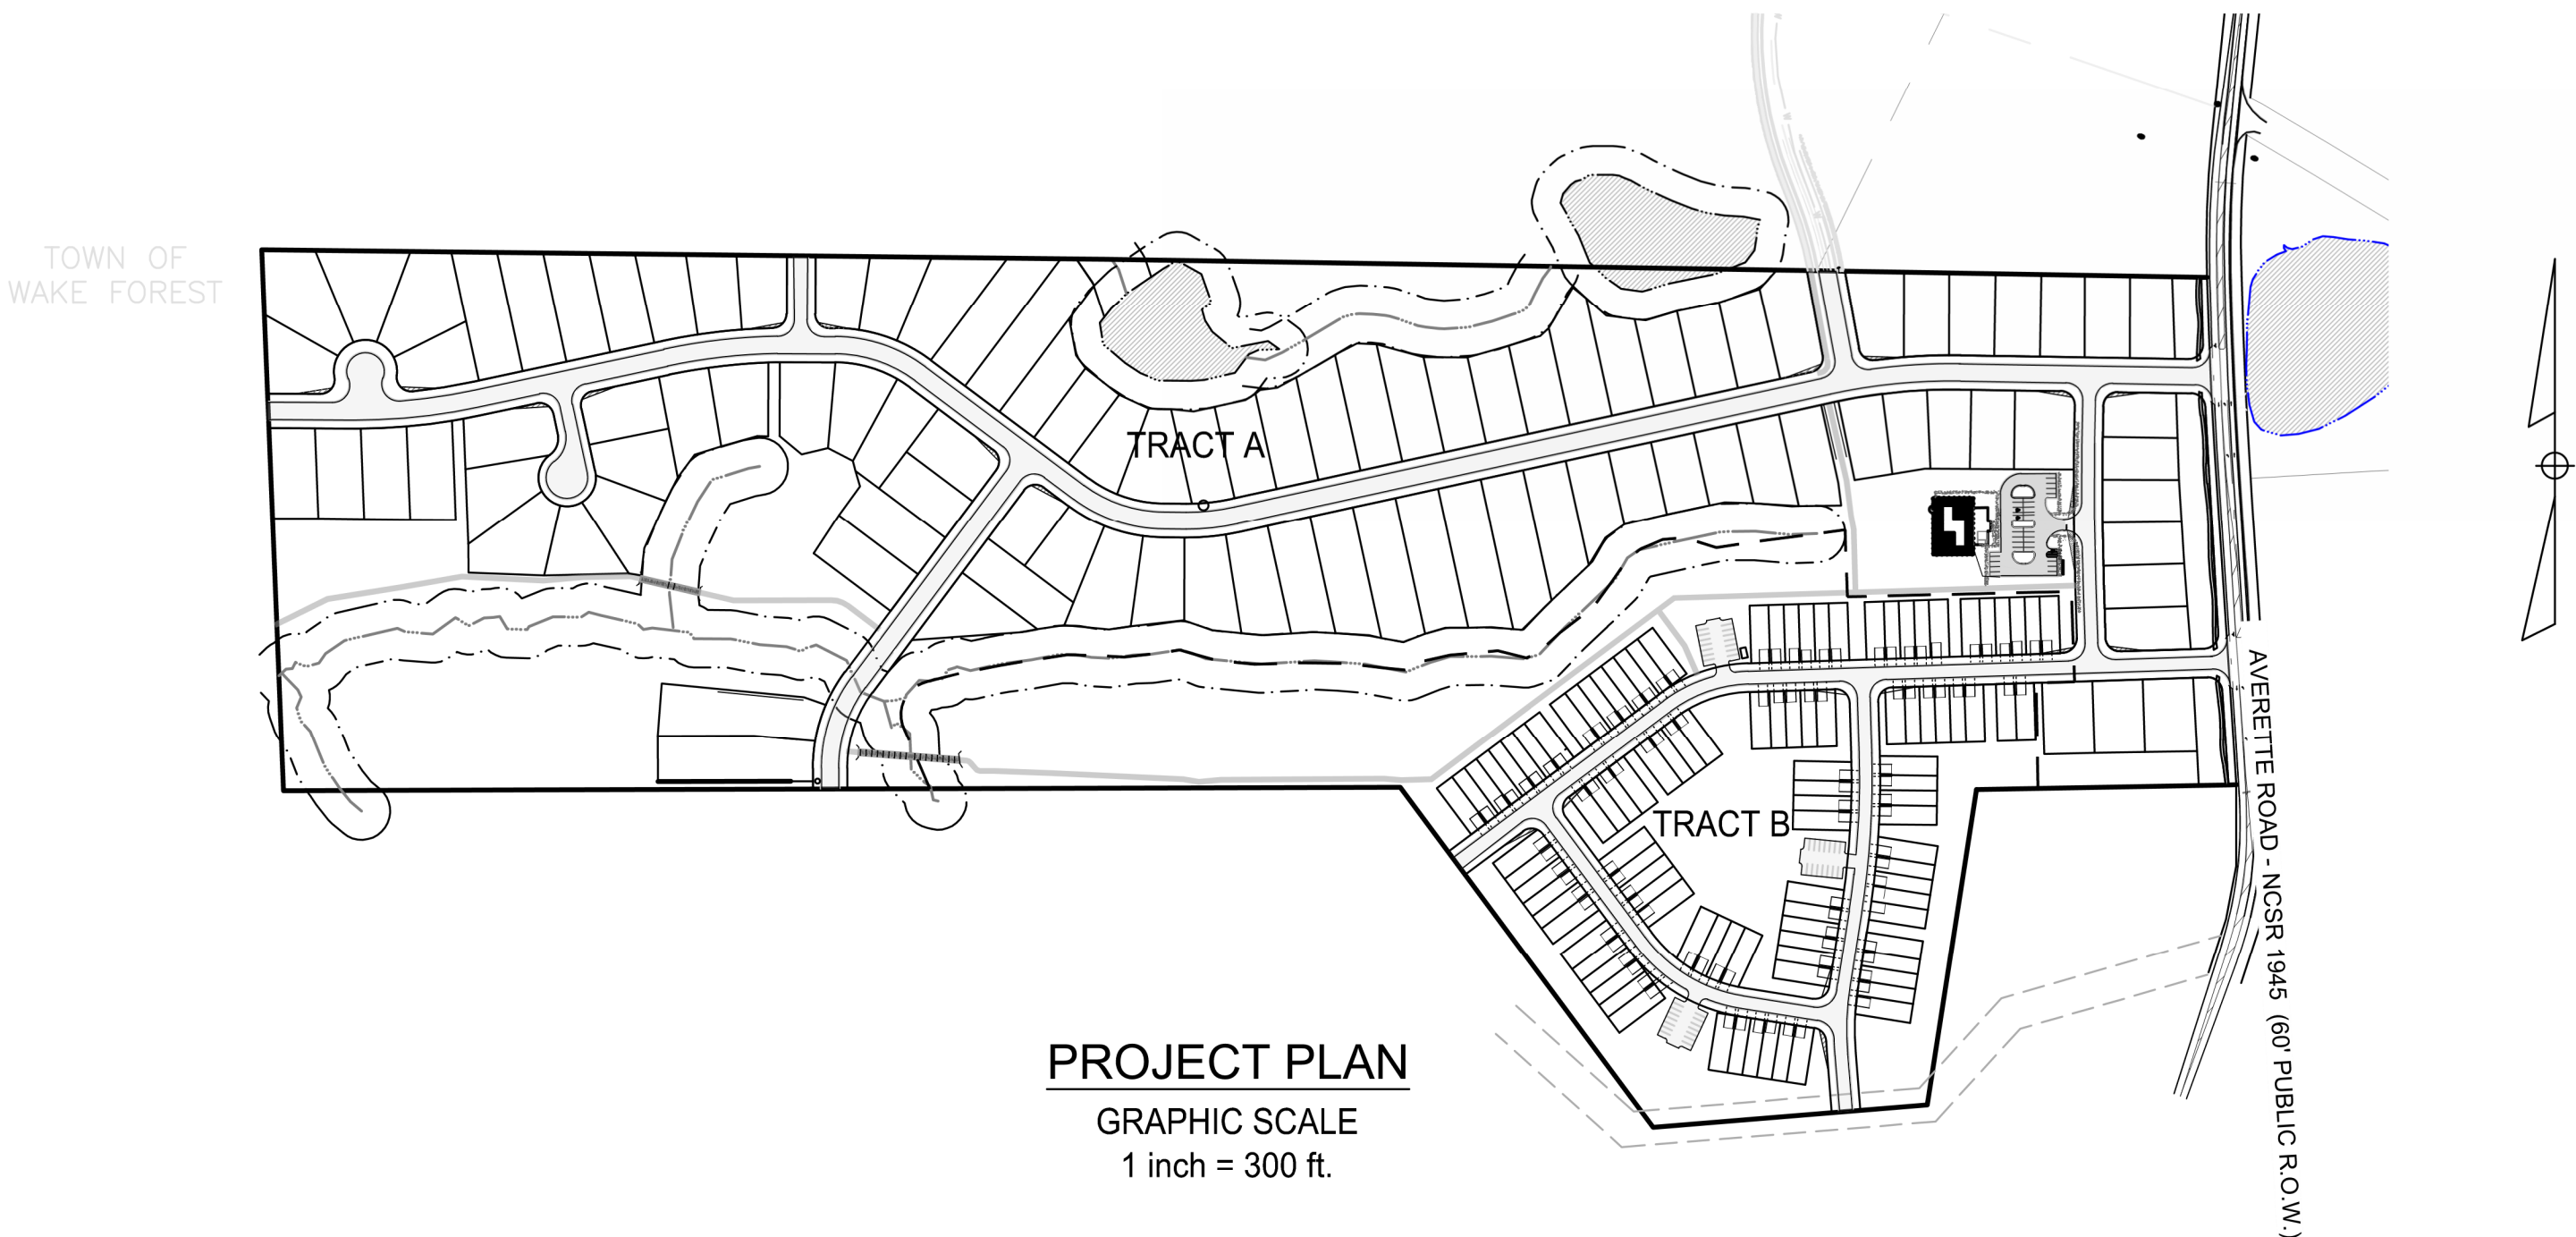

DEVELOPER:
WRIGHT-WHITLEY DEVELOPMENT COMPANY, LLC
1225 N WHITE ST
WAKE FOREST, NC 27583

OWNER:
DOUGLAS JONES
1109 AVERETTE RD
WAKE FOREST, NC 27587

SITE ADDRESS:
1205 AVERETTE ROAD
WAKE FOREST, NC 27587
WAKE COUNTY, NC



Bateman Civil Survey Company


Engineers • Surveyors • Planners

2524 Reliance Avenue, Apex, North Carolina 27539

Phone: 919.577.1080 Fax: 919.577.1081

NCBELS FIRM No. C-2378

NOT A CERTIFIED DOCUMENT AS TO THE ORIGINAL DOCUMENT ONLY AS TO THE REVISIONS CLOUDED AND LABELED "1" & "2" IN SHEETS C103, C302, C312, C402, C513B AND C811 OF THIS PLAN SET. THIS DOCUMENT WAS ISSUED AND SEALED BY THOMAS S. SPEIGHT JR., NC PE 020234 ON 05/29/2019 AND APPROVED UNDER SP19-01 BY THE TOWN OF ROLESVILLE BOARD OF COMMISSIONERS. THIS DOCUMENT IS ONLY CERTIFIED AS TO THE REVISIONS CLOUDED AND LABELED "1" & "2" IN SHEETS C103, C302, C312, C402, C513B AND C811 OF THIS PLAN SET.

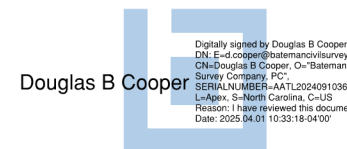

ATTENTION CONTRACTORS

The **Construction Contractor** responsible for the extension of water, sewer, and/or reuse, as approved in these plans, is responsible for **contacting the Public Utilities Department at (919) 996-4540** at least **twenty four hours** prior to beginning any of their construction.

Failure to notify both **City Departments** in advance of beginning construction, will result in the issuance of **monetary fines**, and require reinstallation of any water or sewer facilities not inspected as a result of this notification failure.

Failure to call for **Inspection, Install a Downstream Plug**, have **Permitted Plans** on the **Jobsite**, or any other **Violation of City of Raleigh Standards** will result in a **Fine and Possible Exclusion** from future work in the **City of Raleigh**.

Public

Water Distribution / Extension System

The City of Raleigh consents to the connection and extension of the City's public water system as shown on this plan. The material and Construction methods used for this project shall conform to the standards and specifications of the City's Public Utilities Handbook.

City of Raleigh
Public Utilities Department Permit # W-3599
Authorization to Construct PERMITTED IN TRACT A
SEE TRACT A CONSTRUCTION DRAWINGS
Date _____

Public

Sewer Collection / Extension System

The City of Raleigh consents to the connection and extension of the City's public sewer system as shown on this plan. The material and Construction methods used for this project shall conform to the standards and specifications of the City's Public Utilities Handbook.

City of Raleigh
Public Utilities Department Permit # S-4523
Authorization to Construct PERMITTED IN TRACT A
SEE TRACT A CONSTRUCTION DRAWINGS
Date _____

UTILITY IMPROVEMENTS

8" PVC PUBLIC SEWER	9,375 LF
8" DIP PUBLIC SEWER	2,085 LF
16" PVC PUBLIC SEWER	890 LF
CLASS III RCP STORM	11,445 LF 10,925 LF
4" DIP PUBLIC WATER	110 LF
6" DIP PUBLIC WATER	225 LF
8" DIP PUBLIC WATER	4,185 LF 3,725 LF
12" DIP PUBLIC WATER	4,646 LF
16" DIP PUBLIC WATER	900 LF

WAKE CO. STORMWATER NOTE:

Maximum Impervious Area Square Footage on each Individual Lot will be Stringently Enforced with no Exceptions into Perpetuity.
Plans approved with a maximum impervious surface of 4,500 SF (Single Family) 2,500 SF (Townhome) per lot.

EROSION CONTROL, STORMWATER AND FLOODPLAIN MANAGEMENT

APPROVED

EROSION CONTROL ☒ S- EC-011532-2019

STORMWATER MGMT. ☒ S- WF-011530

FLOOD STUDY ☐ S- -2019

DATE _____



ENVIRONMENTAL CONSULTANT SIGNATURE



KNOW WHAT IS BELOW
CALL BEFORE YOU DIG

C000 COVER - COVER

P:\2017 Projects\170348 Elizabeth Heights\Eng\CAD\DWG\Sheets\Construction Drawings\CD01 Notes and Abbreviations.dwg

ABBREVIATIONS			
@	AT	MAX.	MAXIMUM
A	AREA	MECH.	MECHANICAL
A.B.C.	AGGREGATE BASE COURSE	MFR.	MANUFACTURER
AG	AGRE	MH	MANHOLE
A.D.	ALGEBRAIC DIFFERENCE	MIN.	MINIMUM
A.F.F.	ABOVE FINISHED FLOOR	MI	MILE
AL	AREA LIGHT	MJ	MECHANICAL JOINT
APPROX.	APPROXIMATE	# / NO.	NUMBER
ARCH.	ARCHITECTURAL	N	NORTH
ASSY.	ASSEMBLY	NEMA	NATIONAL ELECTRICAL MANUFACTURERS ASSOCIATION
B-B	BACK TO BACK	N/F	NOW OR FORMERLY
BEAR.	BEARING	N.I.C.	NOT IN CONTRACT
BLDG.	BUILDING	NTS	NOT TO SCALE
BOC	BACK OF CURB	O.C.	ON CENTER(S)
BOT.	BOTTOM	O.D.	OUTSIDE DIAMETER
¢	CENTERLINE	OHE	OVERHEAD ELECTRIC
C.A.B.C.	CRUSHED AGGREGATE BASE COURSE	OPER	OPERATION
CB	CATCH BASIN	OPNG	OPENING
C-C	CENTER TO CENTER	PB	PLAT BOOK
CF	CUBIC FEET	PC	POINT OF CURVATURE
CFM	CUBIC FEET PER MINUTE	PERM.	PERMANENT
C&G	CURB AND GUTTER	PG	PAGE
CH	CHORD	PI	POINT OF INTERSECTION
CI	CURB INLET	PITO	POINT OF INTERSECTION - TURN OUT
CL	CLASS	PL	PROPERTY LINE
CNST	CONSTRUCTION	PROP.	PROPOSED
C.O.	CLEAN-OUT	PS	POINT OF SWITCH
CO.	COMPANY	PSI	POUNDS PER SQUARE INCH
COL	COLUMN	PT	POINT OF TANGENCY
CONC.	CONCRETE	PT	POINT
CONN	CONNECTION	PVC	POLYVINYL CHLORIDE
CPP	CORRUGATED PLASTIC PIPE	P.V.C.	POINT OF VERTICAL CURVATURE
CSP	CORRUGATED STEEL PIPE	P.V.I.	POINT OF VERTICAL INTERSECTION
CULV.	CULVERT	PVMT	PAVEMENT
*	DEGREE(S)	P.V.T.	POINT OF VERTICAL TANGENCY
△	DELTA ANGLE	R	RADIUS
Ø / DIA.	DIAMETER	RCP	REINFORCED CONCRETE PIPE
D	DEPTH / DEEP	RD	ROAD
DB	DEED BOOK	RED.	REDUCER
Dc	DEGREE OF CURVATURE	REQ'D	REQUIRED
DET	DETAIL	RJ	RESTRAINED JOINT
DI	DROP INLET	RR	RAILROAD
DIP	DUCTILE IRON PIPE	RT	RIGHT
DN	DOWN	R/W	RIGHT OF WAY
D/W	DRIVEWAY	S	SOUTH
DWG(S).	DRAWING(S)	SAN	SANITARY
E	EAST	SCH	SCHEDULE
EA	EACH	SDMH	STORM DRAIN MANHOLE
E/ELEV	ELEVATION	SEC	SECONDS
ELEC.	ELECTRICAL	SECT.	SECTION
EOP	EDGE OF PAVEMENT	SED.	SEDIMENT
ESMT	EASEMENT	SEV	SEWER
EXIST	EXISTING	SF	SQUARE FEET
F.D.	FLOOR DRAIN	SHT. / SH.	SHEET
FES	FLARED END SECTION	SP	SERVICE POLE
FFE	FINISHED FLOOR ELEVATION	SPEC.	SPECIFICATION
FH	FIRE HYDRANT	SQ.	SQUARE
FHA	FIRE HYDRANT ASSEMBLY	SR	STATE ROAD
FI	FLOW INDICATOR	SS	STAINLESS STEEL
FLEX.	FLEXIBLE	SSCO	SANITARY SEWER CLEANOUT
FL	FLANGE	SSMH	SANITARY SEWER MANHOLE
FM	FORCE MAIN	STA.	STATION
FO	FIBER OPTIC CABLE	STD.	STANDARD
FOP	FIBER OPTIC POST	STL	STEEL
FOSC	FIBER OPTIC SIGNAL CABLE	S/W	SIDEWALK
FOC	FACE OF CURB	T/C	TOP OF CURB
FT	FEET	TEL.	TELEPHONE
FUT	FUTURE	TEMP.	TEMPORARY
GA	GAUGE	TK	THICK
GAL.	GALLON	T/G	TOP OF GRATING
GALV.	GALVANIZED	T.O.	TOP OF...
GEN	GENERATOR	TP	TELEPHONE PEDESTAL
G/L	GUTTER LINE	T/S	TOP OF SLAB
GV	GATE VALVE	TSB	TRAFFIC SIGNAL BOX
GW	GUY WIRE/ANCHOR	TST	TEMPORARY SEDIMENT TRAP
HD	HEAVY DUTY	T/W	TOP OF WALL
HEX.	HEXAGONAL	TYP.	TYPICAL
HORIZ(Z).	HORIZONTAL	U/G	UNDER GROUND
HP	HIGH POINT	UGE	UNDER GROUND ELECTRIC
HWL	HIGH WATER LEVEL	UV	ULTRAVIOLET
HWY.	HIGHWAY	V	VALVE
ICV	IRRIGATION CONTROL VALVE	VC	VERTICAL CURVE
ID	INSIDE DIAMETER	VERT.	VERTICAL
IN	INCH(ES)	W	WIDTH
INV.	INVERT	W	WEST
JB	JUNCTION BOX	W/	WITH
K	CURVE COEFFICIENT	WD	WIDE
L	LENGTH	WL	WATER LEVEL
LB	POUND(S)	WL	WATER LINE
LD	LIGHT DUTY	WM	WATER METER
LF	LINEAR FEET	WSE	WATER SURFACE ELEVATION
LG	LONG	WV	WATER VALVE
LP	LIGHT POLE	WWF	WELDED WIRE FABRIC
LT	LEFT	YD	YARD
LWL	LOW WATER LEVEL	YI	YARD INLET
		YH	YARD HYDRANT
		YR	YEAR

2	REMOVE SWEETLEAF		07/31/2019
1	REVISED PER TOR COMMENTS		12/07/2018
REV/NO.	DESCRIPTIONS		
REVISIONS			

GENERAL NOTES

FOR THE PURPOSE OF THE FOLLOWING NOTES:

- "CONTRACTOR" REFERS TO GENERAL CONTRACTOR
- "OWNER" REFERS TO DOUGLAS JONES OR HIS AUTHORIZED AGENTS
- "ENGINEER" REFERS TO BATEMAN CIVIL SURVEY COMPANY

GENERAL SITE/CIVIL NOTES

1. THE CONTRACTOR IS RESPONSIBLE FOR OBTAINING ALL REQUIRED PERMITS. ALL CONSTRUCTION SHALL BE IN ACCORDANCE WITH PERMITS AS ISSUED, AND ANY AND ALL APPLICABLE STATE, COUNTY AND LOCAL CODES
2. THE CONTRACTOR SHALL OBTAIN AND PAY FOR ALL INSPECTIONS, CERTIFICATIONS, AND/OR ANY OTHER REQUIREMENTS WHICH MUST BE MET UNDER CONTRACT.
3. ALL DIMENSIONS ARE IN RADI, TO OUTSIDE FACE OF BUILDING, TO CENTERLINE, CENTER TO CENTER ON STRIPES, AND/OR TO FACE OF CURB, UNLESS OTHERWISE NOTED.
4. THE CONTRACTOR WILL BE HELD RESPONSIBLE FOR ALL DAMAGE CAUSED BY HIS OPERATIONS TO EXISTING UTILITIES AND FACILITIES WHICH ARE NOT INCLUDED AS PART OF THE INTENDED WORK. DAMAGED UTILITIES AND FACILITIES SHALL BE REPAIRED OR REPLACED BY THE CONTRACTOR, TO THE SATISFACTION OF THE OWNERS REPRESENTATIVE, AT NO ADDITIONAL COST TO THE OWNER.
5. THE CONTRACTOR SHALL COORDINATE CONSTRUCTION OPERATIONS WITH ANY AND ALL OTHER CONSTRUCTION ACTIVITIES WHICH MAY BE OCCURRING SIMULTANEOUSLY ON THE SITE. LACK OF COORDINATION ON THE CONTRACTORS PART RESULTING IN EXTRA WORK OR SCHEDULE DELAYS SHALL NOT CONSTITUTE A CHANGE ORDER.
6. THE CONTRACTOR SHALL VERIFY ALL DIMENSIONS IN THE FIELD. DISCREPANCIES SHALL BE BROUGHT TO THE ATTENTION OF THE ENGINEER IMMEDIATELY.
7. THE CONTRACTOR SHALL CONTACT THE NC ONE CALL CENTER, AT 1-800-432-4949, AT LEAST 48 HOURS BEFORE THE START OF CONSTRUCTION.
8. THE CONTRACTOR SHALL BE RESPONSIBLE AT NO ADDITIONAL COST TO THE OWNER, FOR MAINTENANCE OF ALL EROSION CONTROL MEASURES UNTIL SUCH TIME AS THE APPROPRIATE STATE, COUNTY, OR MUNICIPAL AUTHORITY RELEASES THE SITE AT WHICH TIME THE CONTRACTOR SHALL REMOVE ALL TEMPORARY EROSION CONTROL MEASURES AS DIRECTED BY THE ENGINEER.
9. CONSTRUCTION AND MAINTENANCE OF ALL EROSION CONTROL MEASURES SHALL BE IN ACCORDANCE WITH THE CORRESPONDING SECTIONS OF THE NORTH CAROLINA EROSION AND SEDIMENTATION CONTROL PLANNING AND DESIGN MANUAL, LATEST EDITION AND THE APPROVED EROSION AND SEDIMENTATION CONTROL PLAN.
10. THE LOCATION OF ALL STRUCTURES SHOWN REPRESENTS THE BEST INFORMATION AVAILABLE TO THE ENGINEER AT THE TIME OF THE SURVEY. IT IS THE CONTRACTOR'S RESPONSIBILITY TO VERIFY THE LOCATION, SIZE, AND TYPE OF ALL UNDERGROUND UTILITIES PRIOR TO CONSTRUCTION. THE CONTRACTOR SHALL BE RESPONSIBLE FOR THE RELOCATION (AS DIRECTED BY THE ENGINEER) OF ANY CONFLICTING UNDERGROUND UTILITIES, IF REQUIRED, AT NO ADDITIONAL COST TO THE OWNER. IT IS ADVISABLE THE CONTRACTOR VISIT THE SITE PRIOR TO BIDDING AND BECOME FAMILIAR WITH THE SITE AND ANY POTENTIAL CONFLICTS.
11. THE CONTRACTOR IS RESPONSIBLE FOR ALL SITE LAYOUTS AND STAKING AND THE COST THEREOF SHALL BE INCLUDED IN HIS BID.
12. THE CONTRACTOR AGREES THAT IN ACCORDANCE WITH GENERALLY ACCEPTED CONSTRUCTION PRACTICES THE CONTRACTOR SHALL BE REQUIRED TO ASSUME SOLE AND COMPLETE RESPONSIBILITY FOR THE JOB SITE CONDITIONS DURING THE COURSE OF CONSTRUCTION OF THE PROJECT, INCLUDING THE SAFETY OF ALL PERSONS AND PROPERTY. THIS REQUIREMENT SHALL BE MADE TO APPLY CONTINUOUSLY AND NOT BE LIMITED TO THE NORMAL WORKING HOURS. THE CONTRACTOR FURTHER AGREES TO DEFEND, INDEMNIFY AND HOLD OWNER AND ENGINEER HARMLESS FROM ANY AND ALL LIABILITY, REAL OR ALLEGED IN CONNECTION WITH THE PERFORMANCE OF WORK ON THIS PROJECT, EXEMPTING LIABILITY ARISING FROM THE SOLE NEGLIGENCE OF THE OWNER OR THE ENGINEER.
13. ALL EXISTING UTILITIES AND IMPROVEMENTS THAT BECOME DAMAGED DURING CONSTRUCTION SHALL BE COMPLETELY RESTORED TO THE SATISFACTION OF THE OWNER AND ENGINEER AT THE CONTRACTOR'S SOLE EXPENSE.
14. THE CONTRACT DRAWINGS AND SPECIFICATIONS REPRESENT THE FINISHED STRUCTURE AND DO NOT INDICATE THE METHOD OF CONSTRUCTION. THE CONTRACTOR SHALL SUPERVISE AND DIRECT THE WORK AND SHALL BE SOLELY RESPONSIBLE FOR CONSTRUCTION MEANS, METHODS, TECHNIQUES, SEQUENCES AND PROCEDURES, INCLUDING, BUT NOT LIMITED TO BRACING AND SHORING. OBSERVATION VISITS TO THE SITE BY THE ENGINEER AND/OR THE ENGINEER'S REPRESENTATIVE(S) SHALL NOT INCLUDE INSPECTION OF THE PROTECTIVE MEASURES OR THE CONSTRUCTION PROCEDURES.
15. ALL WORK WITHIN NCDOT RIGHTS-OF-WAY SHALL BE IN ACCORDANCE WITH THE LATEST EDITION OF NCDOT STANDARD SPECIFICATIONS FOR ROADS AND STRUCTURES. THE CONTRACTOR SHALL ABIDE BY THE NCDOT DRIVEWAY AND ENCROACHMENT PERMITS AND THEIR CONDITIONS.
16. SITE DEVELOPMENT SHALL BE IN ACCORDANCE WITH THE TOWN OF ROLESVILLE LAND DEVELOPMENT ORDINANCE.
17. THE CONTRACTOR SHALL BE SOLEY RESPONSIBLE FOR ADHERING TO ALL OSHA SAFETY REQUIREMENTS, INCLUDING TRENCH SAFETY DURING ALL PHASES OF CONSTRUCTION.
18. CONSTRUCTION TO BE IN ACCORDANCE WITH TOWN OF ROLESVILLE & NCDOT STANDARDS AND SPECIFICATIONS.

GENERAL UTILITY NOTES

1. THE APPROXIMATE LOCATION OF ALL KNOWN UNDERGROUND UTILITIES ARE SHOWN ON THE PLANS. THE CONTRACTOR SHALL VERIFY THE TRUE LOCATION PRIOR TO COMMENCING WORK. IN THE EVENT A CONFLICT OR POTENTIAL CONFLICT IS IDENTIFIED, THE CONTRACTOR SHALL NOTIFY THE ENGINEER IMMEDIATELY.
2. THE CONTRACTOR SHALL COORDINATE ALL WORK AFFECTING UTILITIES WITH THE RESPECTIVE UTILITY COMPANY OWNER. ALL DETAILS OF CONSTRUCTION AND/OR RELOCATION SHALL BE APPROVED BY THE UTILITY OWNERS AND OTHER APPROVING AGENCIES, IF REQUIRED.
3. PROTECTION OF ALL EXISTING STRUCTURES TO REMAIN DURING CONSTRUCTION SHALL BE THE RESPONSIBILITY OF THE GENERAL CONTRACTOR.
4. ALL UTILITY CONSTRUCTION SHALL BE IN ACCORDANCE WITH CITY OF RALEIGH STANDARDS AND SPECIFICATIONS.
5. RELATION BETWEEN WATER MAINS AND SEWER LINES:
 - A. HORIZONTAL AND VERTICAL SEPARATION:
 - 1.) WATERLINES SHALL BE LAID AT LEAST 10 FEET HORIZONATALLY FROM ANY EXISTING OR PROPOSED SEWER LINE. THE DISTANCE SHALL BE MEASURED FROM EDGE TO EDGE. IF AN OBSTRUCTION PROHIBITS A 10-FOOT SEPARATION, THE CONTRACTOR SHALL CONTACT THE ENGINEER. INSTALLATION OF THE WATER MAIN CLOSER TO A SEWER LINE IS ALLOWED PROVIDED THAT THE WATER MAIN IS IN A SEPARATE TRENCH OR ON AN UNDISTURBED EARTH SHELFLOCATED ON ONE SIDE OF THE SEWER AND AT AN ELEVATION SO THE BOTTOM OF THE WATER MAIN IS AT LEAST 18-INCHES ABOVE THE TOP OF THE SEWER.
 - 2.) IF IT IS IMPOSSIBLE TO OBTAIN PROPER HORIZONTAL AND VERTICAL SEPARATION AS DESCRIBED ABOVE OR ANY TIME THE SEWER IS OVER THE WATER MAIN, BOTH THE WATER MAIN AND SEWER LINE MUST BE CONSTRUCTED OF FERROUS PIPE COMPLYING WITH PUBLIC WATER SUPPLY DESIGN STANDARDS AND PRESSURE TESTED TO 150 PSI (MINIMUM) TO ASSURE WATERTIGHTNESS BEFORE BACKFILLING.
 - B. CROSSINGS
 - 1.) FOR WATER MAINS CROSSING UNDER SEWER LINES: LINES SHALL BE LAID TO PROVIDE A MINIMUM VERTICAL DISTANCE OF 18-INCHES BETWEEN THE OUTSIDE EDGE OF THE WATER MAIN AND THE OUTSIDE EDGE OF THE SEWER LINE. THE CROSSING SHALL BE ARRANGED SO THAT ONE 20-FOOT SECTION OF WATERLINE SHALL BE CENTERED AT THE CROSSING. ONE OF THE FOLLOWING METHODS MUST THEN BE UTILIZED AS DIRECTED BY THE ENGINEER.
 - I.) THE SEWER SHALL BE DESIGNED AND CONSTRUCTED OF FERROUS PIPE AND SHALL BE PRESSURE TESTED AT 150 PSI TO ASSURE WATERTIGHTNESS PRIOR TO BACKFILLING OR,
 - II.) EITHER THE WATER MAIN OR SEWER LINE MAY BE ENCASED IN A WATERTIGHT CARRIER PIPE WHICH EXTENDS 10- FEET BEYOND BOTH SIDES OF THE CROSSING, MEASURED PERPENDICULAR TO THE WATER MAIN. THE CARRIER PIPE SHALL BE OF A MATERIAL APPROVED BY THE REGULATORY AGENCY FOR USE IN WATER MAIN CONSTRUCTION.
 - 2.) FOR WATER MAINS CROSSING OVER A SEWER LINE: LINES SHALL BE LAID TO PROVIDE A MINIMUM VERTICAL DISTANCE OF 18-INCHES BETWEEN THE OUTSIDE EDGE OF THE WATER MAIN AND THE OUTSIDE EDGE OF THE SEWER. IN AN 18-INCH MINIMUM VERTICAL SEPARATION CANNOT BE MET, THEN THE WATERLINE SHALL BE CONSTRUCTED OF A FERROUS MATERIAL WITH ONE 20-FOOT SECTION OF PIPE CENTERED AT THE CROSSING. ONE OF THE CROSSING CONSTRUCTION METHODS ABOVE: 6.B.1.)II) OR II) SHALL BE UTILIZED.
6. CONTRACTOR SHALL BE RESPONSIBLE FOR KEEPING RECORDS AND SUBMIT AS BUILT DRAWINGS FOR UTILITIES.
7. CONTRACTOR SHALL SUBMIT SHOP DRAWINGS FOR ALL CONCRETE STRUCTURES, CASTINGS AND PIPING MATERIALS FOR APPROVAL PRIOR TO PURCHASING. ENGINEER SHALL HAVE 10 DAYS TO REVIEW INITIAL SUBMITTALS AND 5 DAYS FOR RESUBMITTALS.

DRAINAGE NOTES

1. CONTRACTOR SHALL EXERCISE CARE, ESPECIALLY AT INTERSECTIONS AND GUTTER LINES, TO PROVIDE POSITIVE DRAINAGE. ANY AREAS WHERE WATER IS IMPOUNDED AS A RESULT OF THIS CONSTRUCTION SHALL BE CORRECTED BY CONTRACTOR AT NO ADDITIONAL COST TO THE OWNER. POSITIVE DRAINAGE OF ALL ROADWAY AREAS TO THE STORM DRAIN INLETS OR OTHER ACCEPTABLE DRAINAGE CHANNELS SHALL BE MAINTAINED AT ALL TIMES.
2. CONTRACTOR SHALL MAINTAIN EXISTING STREAMS, DITCHES, DRAINAGE STRUCTURES, CULVERTS AND FLOWS AT ALL TIMES DURING THE WORK. CONTRACTOR SHALL PAY FOR ALL PERSONAL INJURY AND PROPERTY DAMAGE WHICH MAY OCCUR AS A RESULT OF FAILING TO MAINTAIN ADEQUATE DRAINAGE.
3. ALL PIPES, DRAINAGE INLETS AND OTHER STRUCTURES UNCOVERED DURING CONSTRUCTION SHALL BE INSPECTED BY THE ENGINEER BEFORE BEING BACKFILLED OR BURIED. THE ENGINEER MAY REQUIRE CONTRACTOR, AT NO ADDITIONAL COST TO THE OWNER, TO UNCOVER AND RE-COVER SUCH STRUCTURES IF THEY HAVE BEEN BACKFILLED OR BURIED WITHOUT SUCH INSPECTION.
4. ELEVATIONS GIVEN FOR CATCH BASINS ARE MEASURED AT THE TOP OF CURB AT TH CENTER OF STRUCTURE. ELEVATIONS FOR MANHOLES, JUNCTION BOXES AND DROP INLETS ARE MEASURED AT THE CENTER OF GRATE COVER.
5. CONTRACTOR SHALL SUBMIT SHOP DRAWINGS FOR ALL CONCRETE STRUCTURES, CASTINGS AND PIPING MATERIALS FOR APPROVAL PRIOR TO PURCHASING. ENGINEER SHALL HAVE 10 DAYS TO REVIEW INITIAL SUBMITTALS AND 5 DAYS FOR RESUBMITTALS.

GENERAL GRADING NOTES

1. ALL PROPOSED ELEVATIONS SHOWN HEREIN ARE FINISHED GRADE ELEVATIONS.
2. CONTRACTOR SHALL BE RESPONSIBLE FOR VERIFYING SEWER RIM ELEVATIONS IN RELATION TO PROPOSED GRADE PRIOR TO INSTALLATION. ALL EXISTING MANHOLE COVERS, CATCH BASINS, VALVE COVERS, ETC. THAT ARE TO REMAIN SHALL BE ADJUSTED (RAISED OR LOWERED) TO FINISHED GRADE.
3. CLEAR AND GRUB SITE TO GRADING LIMITS SHOWN ON THE SITE GRADING PLANS.
4. ALL TOPSOIL AND UNSUITABLE FILL MATERIAL SHALL BE REMOVED PRIOR TO PLACEMENT OF SUBBASE MATERIAL AS DIRECTED BY THE OWNER'S REPRESENTATIVE.
5. ALL EXCAVATED MATERIAL PLACEMENT TO BE COORDINATED WITH THE OWNER FOR AVAILABLE SPOIL LOCATIONS.
6. ALL MATERIAL THAT IS UNSUITABLE FOR GRADING/EMBANKMENT WILL BE RELOCATED OFF-SITE BY THE CONTRACTOR TO A SUITABLE LOCATION AS DIRECTED BY THE OWNER IN ACCORDANCE WITH ALL APPLICABLE REGULATIONS.
7. AREAS SCHEDULED FOR EMBANKMENT SHALL BE CLEARED, GRUBBED AND STRIPPED OF TOPSOIL TO REMOVE TREES, VEGETATION, ROOTS OR OTHER OBJECTIONABLE MATERIAL.
8. ALL EMBANKMENTS SHALL BE COMPACTED AS SPECIFIED TO REDUCE EROSION, SLIPPAGE, SETTLEMENT, SUBSIDENCE OR OTHER RELATED PROBLEMS.
9. FROZEN MATERIAL OR SOFT, MUCKY OR HIGHLY COMPRESSIBLE MATERIALS SHALL NOT BE INCORPORATED INTO EMBANKMENT SLOPES OF STRUCTURAL FILLS.
10. AREAS WHICH ARE TO BE TOPSOILED SHALL BE SCARIFIED TO A MINIMUM DEPTH OF THREE INCHES PRIOR TO PLACEMENT OF TOPSOIL.
11. THE PROPOSED CONTOURS AND GRADIENTS ARE APPROXIMATE. THE ELEVATIONS SHOWN ARE FOR FINISH GRADE ASPHALT AND FINISH GROUND.
12. ALL AREAS SHALL BE GRADED FOR POSITIVE DRAINAGE AND AS SHOWN ON THE PLANS. THE CONTRACTOR SHALL MAINTAIN ADEQUATE SITE DRAINAGE DURING ALL PHASES OF CONSTRUCTION.

TRAFFIC AND SIGNAGE

1. THE CONTRACTOR SHALL PROVIDE ALL LIGHTS, BARRICADES, SIGNS, FLAGGERS OR OTHER DEVICES AS NECESSARY TO PROVIDE FOR SAFETY.
2. THE CONTRACTOR SHALL MAINTAIN VEHICULAR AND PEDESTRIAN ACCESS TO ALL PROPERTY OWNERS ALONG THE PROJECT ALIGNMENT.
3. THE CONTRACTOR SHALL MAINTAIN EXISTING TRAFFIC PATTERNS WHEN POSSIBLE. IF CONSTRUCTION ACTIVITIES DEEM NECESSARY, THE CONTRACTOR SHALL UTILIZE TRAFFIC CONTROL DEVICES IN ACCORDANCE WITH THE FEDERAL, STATE AND LOCAL AGENCIES TO MAINTAIN SAFE TRAFFIC FLOW.
4. CONTRACTOR SHALL NOTIFY PROPERTY OWNER(S) FIVE (5) BUSINESS DAYS IN ADVANCE OF BLOCKING ANY ENTRANCE. NO ENTRANCE SHALL BE BLOCKED MORE THAN TWELVE (12) HOURS IN ANY 24 HOUR PERIOD WITHOUT APPROVAL OF THE PROPERTY OWNER.

EARTHWORK AND SITE CONDITIONS

1. UNLESS OTHERWISE NOTED ON THE PLANS OR IN THE SPECIFICATIONS, IN AREAS OUTSIDE OF NCDOT RIGHT-OF-WAYS, ALL FILL MATERIALS SHALL BE COMPACTED TO 95% OF THE THEORETICAL MAXIMUM DENSITY AS DETERMINED BY AASHTO-99 METHOD A, WITHIN PLUS OR MINUS 2% OF OPTIMUM MOISTURE, FOR THE FULL WIDTH AND DEPTH OF THE FILL. ALL FILL MATERIAL UNDER PAVED AREAS SHALL BE NCDOT #218 CRUSHED STONE, APPROVED SOIL, OR SELECTED MATERIAL, 95% COMPACTED WITH CBR OF 30, COMPACTED IN 6-INCH DEEP LIFTS AS DIRECTED BY THE PROJECT INSPECTOR.
2. CONTRACTOR SHALL VERIFY ALL DIMENSIONS, ELEVATIONS, AND LOCATIONS PRIOR TO BEGINNING WORK, AND IMMEDIATELY NOTIFY THE OWNER AND ENGINEER IN THE EVENT THERE ARE ANY DISCREPANCIES BETWEEN SUCH CONDITIONS AND THOSE SHOWN ON THE PLANS AND SPECIFICATIONS.
3. TOPSOIL STOCKPILED FROM CLEARING AND GRUBBING SHALL BE FREE FROM ROOTS, BRUSH, DEBRIS AND ROCKS. EXCESS STOCKPILED TOPSOIL MAY BE PLACED ON SITE AT THE DIRECTION OF THE ENGINEER OR DISPOSED OF OFFSITE.
4. THE CONTRACTOR SHALL USE QUALITY STRUCTURAL FILL DIRT AS REQUIRED TO COMPLETE THE WORK AS SOWN ON THE PLANS. IMPORTED FILL DIRT SHALL BE TESTED BY A REGISTERED GEOTECHNICAL ENGINEER IN NORTH CAROLINA AND THE RESULTS SUBMITTED TO THE ENGINEER PRIOR TO IMPORTING AND PLACING ANY FILL MATERIAL.
5. UNSUITABLE MATERIAL PLACED AS FILL WILL BE REMOVED AND REPLACED WITH APPROVED MATERIAL AT THE CONTRACTORS EXPENSE.
6. FILL SHALL BE PLACED AND COMPACTED ACCORDING TO NC DOT STANDARD SPECIFICATIONS. THIS ALSO APPLIES TO AREAS OUTSIDE OF THE DOT RIGHT-OF-WAY.

VEGETATION

1. PRIOR TO REMOVING ANY TREES, CONTRACTOR SHALL MEET WITH THE PROPERTY OWNERS AND THE ENGINEER TO REVIEW THE LIMITS OF CONSTRUCTION AND OBTAIN PERMISSION TO REMOVE TREES REQUIRED TO DO THE WORK.
2. TREE AND PLANT ROOTS OR BRANCHES THAT MAY INTERFERE WITH THE WORK SHALL BE TRIMMED OR CUT ONLY WITH THE APPROVAL OF THE OWNER. ANY TREES OR PLANTS WHICH ARE SHOWN TO REMAIN THAT DO NOT INTERFERE WITH THE WORK, BUT ARE DAMAGED BY CONTRACTOR OR HIS SUBCONTRACTORS, SHALL BE REPAIRED OR REPLACED BY CONTRACTOR AT NO ADDITIONAL COST.
3. TREES CUT DOWN SHALL BE COMPLETELY REMOVED, INCLUDING THEIR ROOTS.
4. ON-SITE BURNING IS NOT PERMITTED.
5. THE CONTRACTOR SHALL PROPERLY DISPOSE OF ALL DEBRIS OFF SITE AT AN APPROVED DISPOSAL FACILITY. DEBRIS INCLUDES, BUT IS NOT LIMITED TO, TREES, ROOTS AND STUMPS.

WORK IN NCDOT RIGHTS OF WAY

1. ALL WORK WITHIN NCDOT RIGHTS-OF-WAY SHALL BE PERFORMED IN ACCORDANCE WITH THE LATEST EDITION OF THE NCDOT "ROADWAY STANDARD DRAWING" AND "STANDARD SPECIFICATIONS FOR ROADS AND STRUCTURES." THIS INCLUDES LANE CLOSURES, ROAD CLOSURES, POSITIVE PROTECTION AND/OR ANY OTHER WARNING OR POSITIVE PROTECTION DEVICES NECESSARY FOR THE SAFETY OF THE ROAD USERS DURING CONSTRUCTION AND ANY SUBSEQUENT MAINTENANCE. WHEN THERE IS NO GUIDANCE PROVIDED IN THE ROADWAY STANDARD DRAWINGS OR SPECIFICATIONS, THE CONTRACTOR SHALL COMPLY WITH THE "MANUAL ON UNIFORM TRAFFIC CONTROL DEVICES FOR STREETS AND HIGHWAYS."
2. THE CONTRACTOR SHALL FOLLOW ALL SPECIAL PROVISIONS INCLUDED AS PART OF THE RIGHT-OF-WAY ENCROACHMENT AGREEMENT AND DRIVEWAY CONSTRUCTION PERMIT.
3. THE CONTRACTOR SHALL NOTIFY THE NORTH CAROLINA DEPARTMENT OF TRANSPORTATION (NCDOT) TEN WORKING DAYS IN ADVANCE OF INITIATING EITHER OPEN-CUT OR JACK-AND-BORE INSTALLATION OF PIPELINE WITHIN/UNDERNEATH ANY COUNTY ROAD FOR LAYING THE NEW WATER MAIN.
4. DURING NON-WORKING HOURS, EQUIPMENT SHALL NOT BE PARKED IN THE RIGHT-OF-WAY.
5. ALL FILL AREAS/BACKFILL IN NCDOT RIGHTS-OF-WAY SHALL BE COMPACTED TO 95% DENSITY IN ACCORDANCE WITH AASHTO T99 AS MODIFIED BY THE NCDOT. ALL MATERIAL TO A DEPTH OF 8-INCHES BELOW THE FINISHED SURFACE OF THE SUBGRADE SHALL BE COMPACTED TO A DENSITY EQUAL TO AT LEAST 100% OF THAT OBTAINED BY COMPACTING A SAMPLE OF THE MATERIAL IN ACCORDANCE WITH AASHTO T99 AS MODIFIED BY THE DEPARTMENT. THE SUBGRADE SHALL BE COMPACTED AT A MOISTURE CONTENT WHICH IS APPROXIMATELY THAT REQUIRED TO PRODUCE THE MAXIMUM DENSITY INDICATED BY THE ABOVE TEST METHOD. THE CONTRACTOR SHALL DRY OR ADD MOISTURE TO THE SUBGRADE WHEN REQUIRED TO PROVIDE A UNIFORMLY COMPACTED AND ACCEPTABLE SUBGRADE.
6. DISTURBED OR DAMAGED STRUCTURES WITHIN THE NCDOT RIGHT-OF-WAY INCLUDING SIGNAGE, GUIDERAILS, AND DRAINAGE STRUCTURES SHALL BE RESTORED TO ITS ORIGINAL CONDITION. RIGHT-OF-WAY MONUMENTS DISTURBED DURING CONSTRUCTION SHALL BE REFERENCED BY A REGISTERED LAND SURVEYOR AND RESET AFTER CONSTRUCTION.
7. ACCESS, PARKING, OR MATERIAL STORAGE SHALL NOT BE ALLOWED ALONG ANY STATE-MAINTAINED ROADWAY WITHOUT FIRST RECEIVING APPROVAL FROM THE NCDOT.
8. DIRECTIONAL DRILLING / BORING UNDER NCDOT ROADWAYS:
 - UNDER NO CONDITION SHALL JETTING ALONG OR WET BORING WITH WATER OF UTILITY PIPELINES BE ALLOWED.
 - DIRECTIONAL BORING USING JETTING WITH BENTONITE (OR EQUIVALENT MATERIAL) SLURRY IS APPROVED AT A MINIMUM DEPTH OF THREE- FEET (COVER) BELOW THE GROUND SURFACE AND OUTSIDE THE THEORETICAL 1:1 SLOPE FROM THE EXISTING EDGE OF PAVEMENT EXCEPT WHERE THE PARALLEL INSTALLATION CROSSES A PAVED ROADWAY.
 - DIRECTIONAL BORES ARE NOT ALLOWED BENEATH BRIDGE FOOTINGS, CULVERT WINGWALL FOOTINGS, OR RETAINING WALLS.
 - THE TIP OF THE DRILL STRING SHALL HAVE A CUTTER HEAD.
 - DETECTION WIRE SHALL BE INSTALLED WITH NON-FERROUS MATERIAL.
 - ALL DIRECTIONAL BORES SHALL MAINTAIN A MINIMUM DISTANCE OF 5- FEET FROM THE NEAREST PART OF PIPE CULVERTS AND BOX CULVERTS AND TEN-FOOT MINIMUM CLEARANCE FROM BRIDGES AND FOOTINGS.
 - OVERBORING SHALL NOT BE MORE THAN TWO-INCHES GREATER THAN THE DIAMETER OF EITHER THE PIPE OR ENCASEMENT. AN OVERBORE GREATER THAN TWO-INCHES WILL BE CONSIDERED IF THE ENCROACHMENT AGREEMENT INCLUDES A STATEMENT SIGNED AND SEALED BY A PROFESSIONAL ENGINEER REGISTERED IN THE STATE OF NORTH CAROLINA THAT SAID OVERBORE WILL NOT DAMAGE EITHER THE PAVEMENT OR SUBGRADE.
9. THE CONTRACTOR SHALL PERFORM AND PROVIDE COPIES TO THE ENGINEER OF ALL REQUIRED COMPACTION TESTS, CONCRETE CYLINDER TESTS AND ASPHALT TESTS.
10. ALL MATERIALS SHALL BE FROM A NCDOT CERTIFIED PLANT.
11. ENCROACHMENT AGREEMENT(S) SHALL BE OBTAINED FROM NCDOT FOR ANY WORK WITHIN NCDOT RIGHT OF WAY.

PROJECT SPECIFIC NOTES

- 1.

ELIZABETH HEIGHTS CONSTRUCTION DRAWINGS

1205 AVERETTE ROAD
WAKE FOREST, NC 27687
WAKE COUNTY, NC

NOTES

Project Engineer: TSS
Designed By: RAJ
Drawn By: RAJ
Checked By: TSS
Scale: NTS

Date: 07/31/2019
Project Number: 170348

SHEET

C001

Bateman Civil Survey Company
Engineers • Surveyors • Planners
2524 Reliance Avenue, Apex, North Carolina 27539
Phone: 919.577.1080 Fax: 919.577.1081
NCBELS FIRN No. C-2376




ELIZABETH HEIGHTS

REV. NO.	DESCRIPTIONS	REVISIONS
2	REMOVE SWEETLEAF	07/31/2019
1	REVISED PER TOR COMMENTS	12/07/2018

PARCEL LINE DATA		
SEGMENT	LENGTH	DIRECTION
L1	30.56	S89° 03' 14"E
L2	100.25	S1° 44' 46"E
L3	100.00	S2° 19' 26"E
L4	100.00	S3° 06' 18"E
L5	100.00	S3° 36' 38"E
L6	100.00	S3° 41' 51"E
L7	100.00	S3° 44' 15"E
L8	100.00	S3° 49' 56"E
L9	100.00	S3° 49' 58"E
L10	88.72	S3° 25' 52"E
L11	30.03	S88° 55' 16"W

LEGEND:	
	EXISTING POND
	EXISTING WETLAND
	EXISTING WATERSHED (R-40W)
	EXISTING STREAM / TOP OF BANK
	EXISTING 50' NEUSE RIVER BASIN RIPARIAN BUFFER

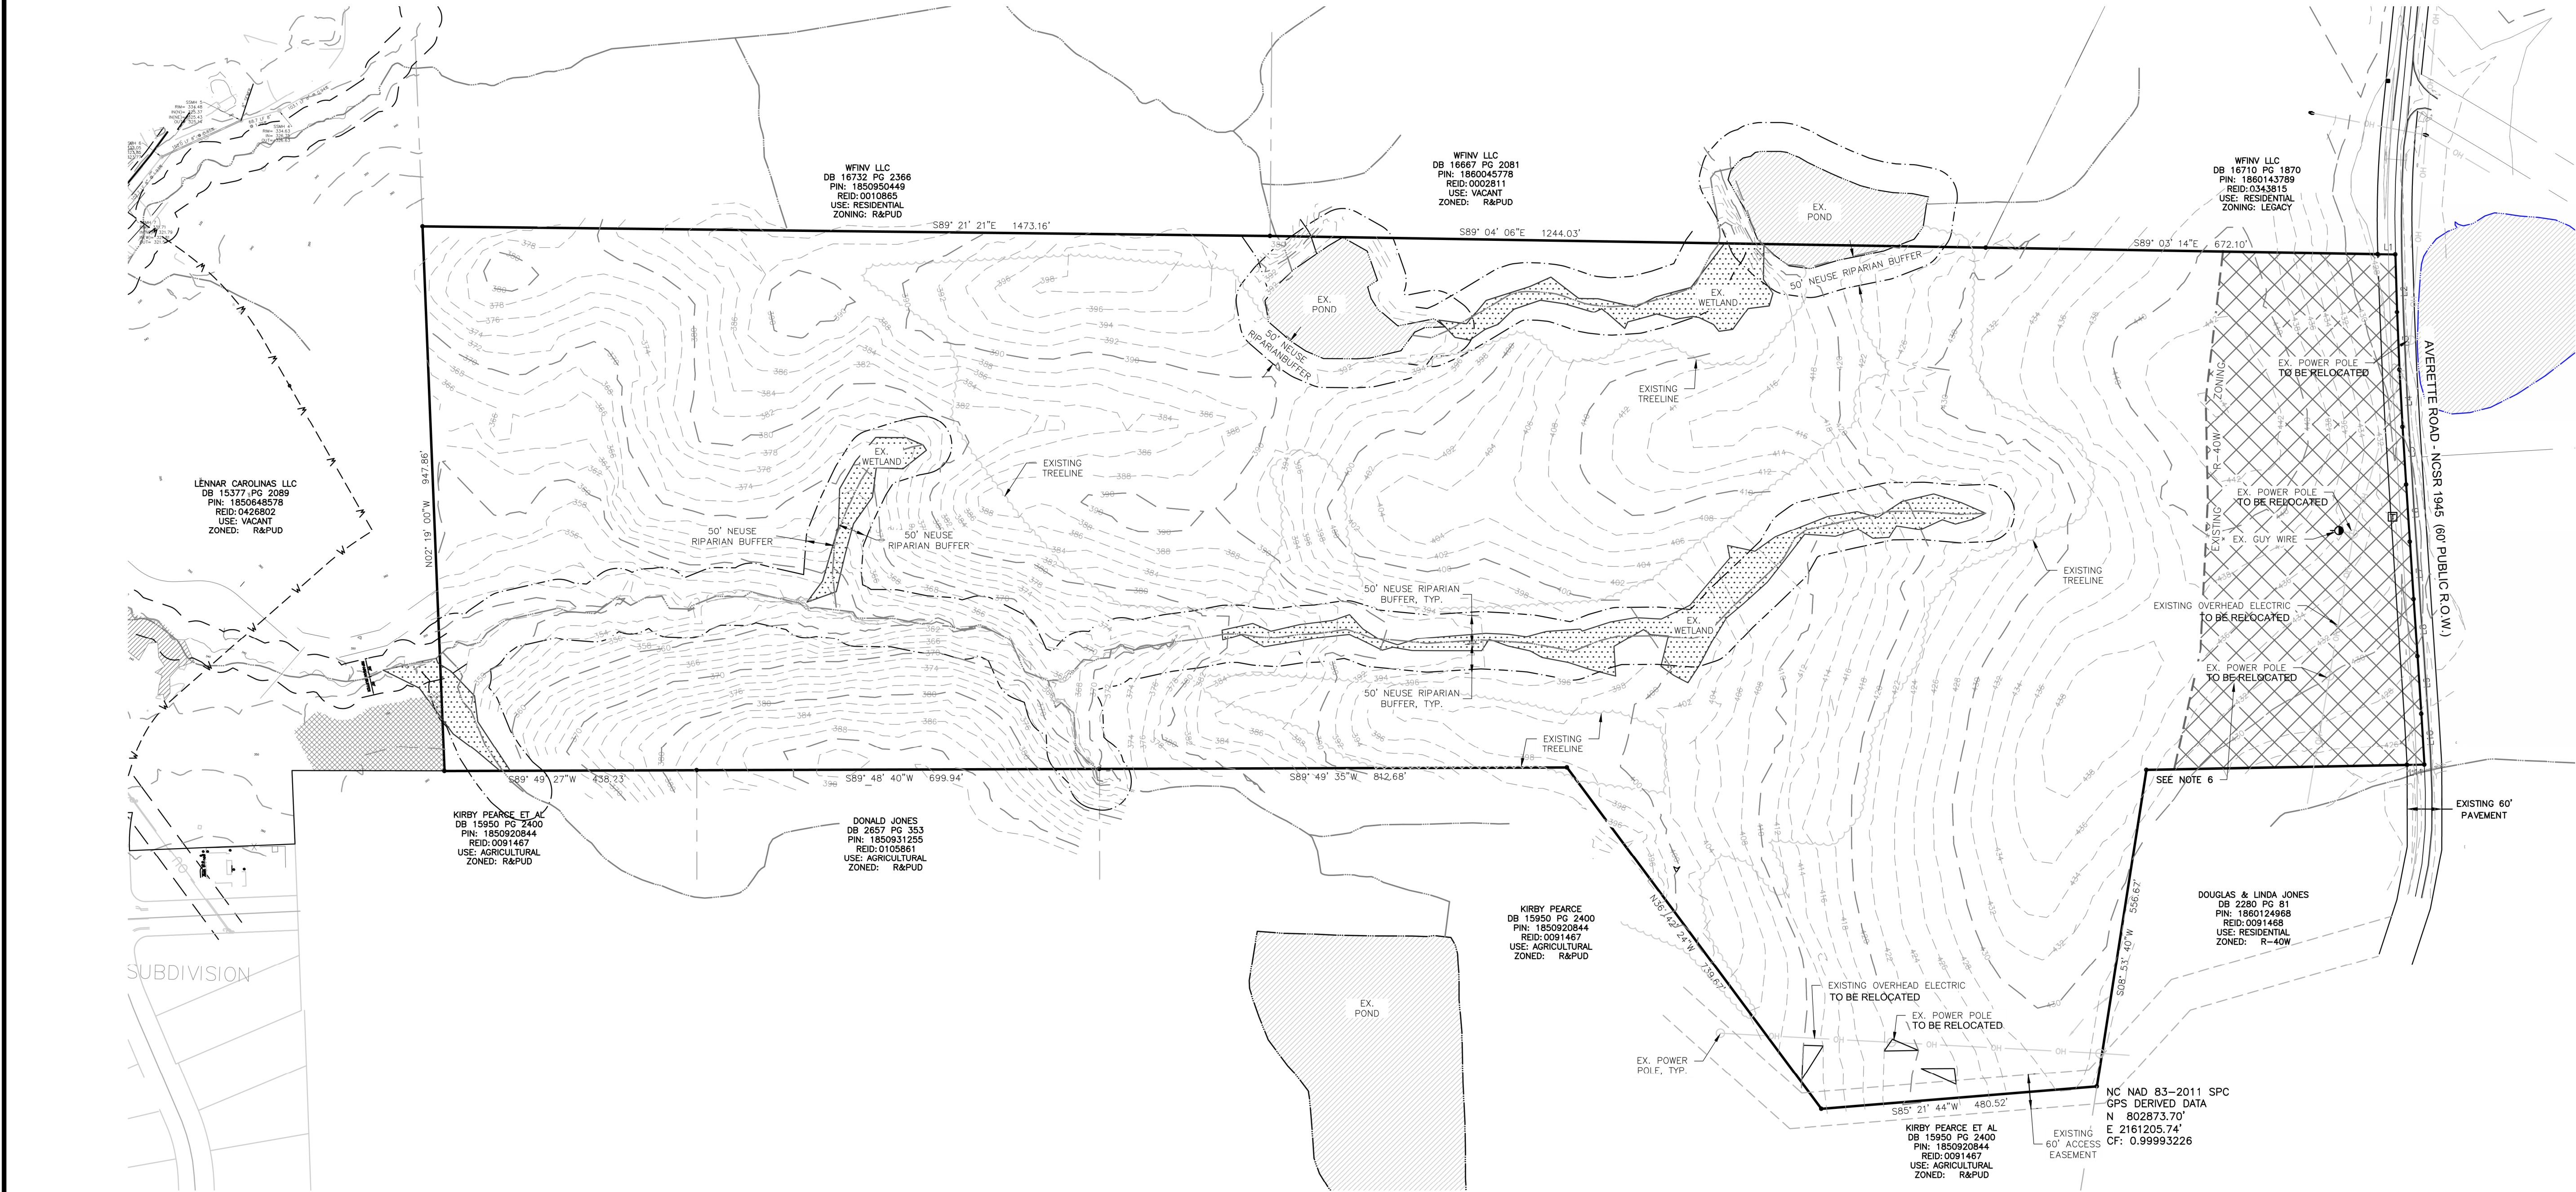

EXISTING TRACT DATA:

DEVELOPER:
WRIGHT-WHITLEY DEVELOPMENT COMPANY, LLC
1225 N. WHITE ST.
WAKE FOREST, NC 27588
CONTACT NO: (919) 349-5220
NC PIN: 1860-03-8619
DEED REFERENCE: DB 017035, PG 01542
REAL ESTATE ID: 0002813

TOTAL TRACT AREA : 82.22 AC
AREA WITHIN ROW: 0.61 AC
NEW TOAL AREA: 81.61 AC
ZONING: R & PUD, R40W
EXISTING USE: VACANT / UNDEVELOPED WOODS

OWNER:
DOUGLAS JONES
1109 AVERETTE RD
WAKE FOREST, NC 27587

- NOTES**
- PER FEMA MAPS 372018500J & 3720186000J FOR NORTH CAROLINA, THERE ARE NO FLOOD HAZARD AREAS WITHIN THE DEVELOPMENT BOUNDARIES.
 - EXISTING BOUNDARY TAKEN FROM A SURVEY BY BATEMAN CIVIL SURVEY COMPANY ON AUG. 8, 2017.
 - EXISTING TOPOGRAPHY DOWNLOADED FROM WAKE COUNTY GIS. WETLANDS AND STREAMS HAVE RECIEVED A PRELIMINARY JURISDICTIONAL DELINIATION FROM THE CORPS. (CURRENTLY PENDING).
 - ARRANGEMENTS HAVE BEEN MADE WITH AUSTIN CREEK DEVELOPER TO EXTEND UTILITIES TO SITE PROPERTY LINE. IN THE EVENT THIS DEVELOPMENT PRECEEDS THE AUSTIN CREEK DEVELOPMENT, PERMISSION HAS BEEN GRANTED TO TIE INTO EXISTING UTILITIES.
 - DUKE ENERGY COORDINATION



ELIZABETH HEIGHTS
CONSTRUCTION DRAWINGS

EXISTING CONDITIONS PLAN

Project Engineer:	TSS
Designed By:	LEG
Drawn By:	LEG
Checked By:	TSS
Scale:	1"=150'

Date:	07/31/2019
Project Number:	170348


SHEET
C101




Bateman Civil Survey Company
Engineers • Surveyors • Planners
2524 Reliance Avenue, Apex, North Carolina 27539
Phone: 919.577.1080 Fax: 919.577.1081
NCBELS FRM No. C-2376




p:\2017\p170348\Elizabeth Heights\GIS\DWG\DWGSheetRevisionP170348_C100_EAST.dwg

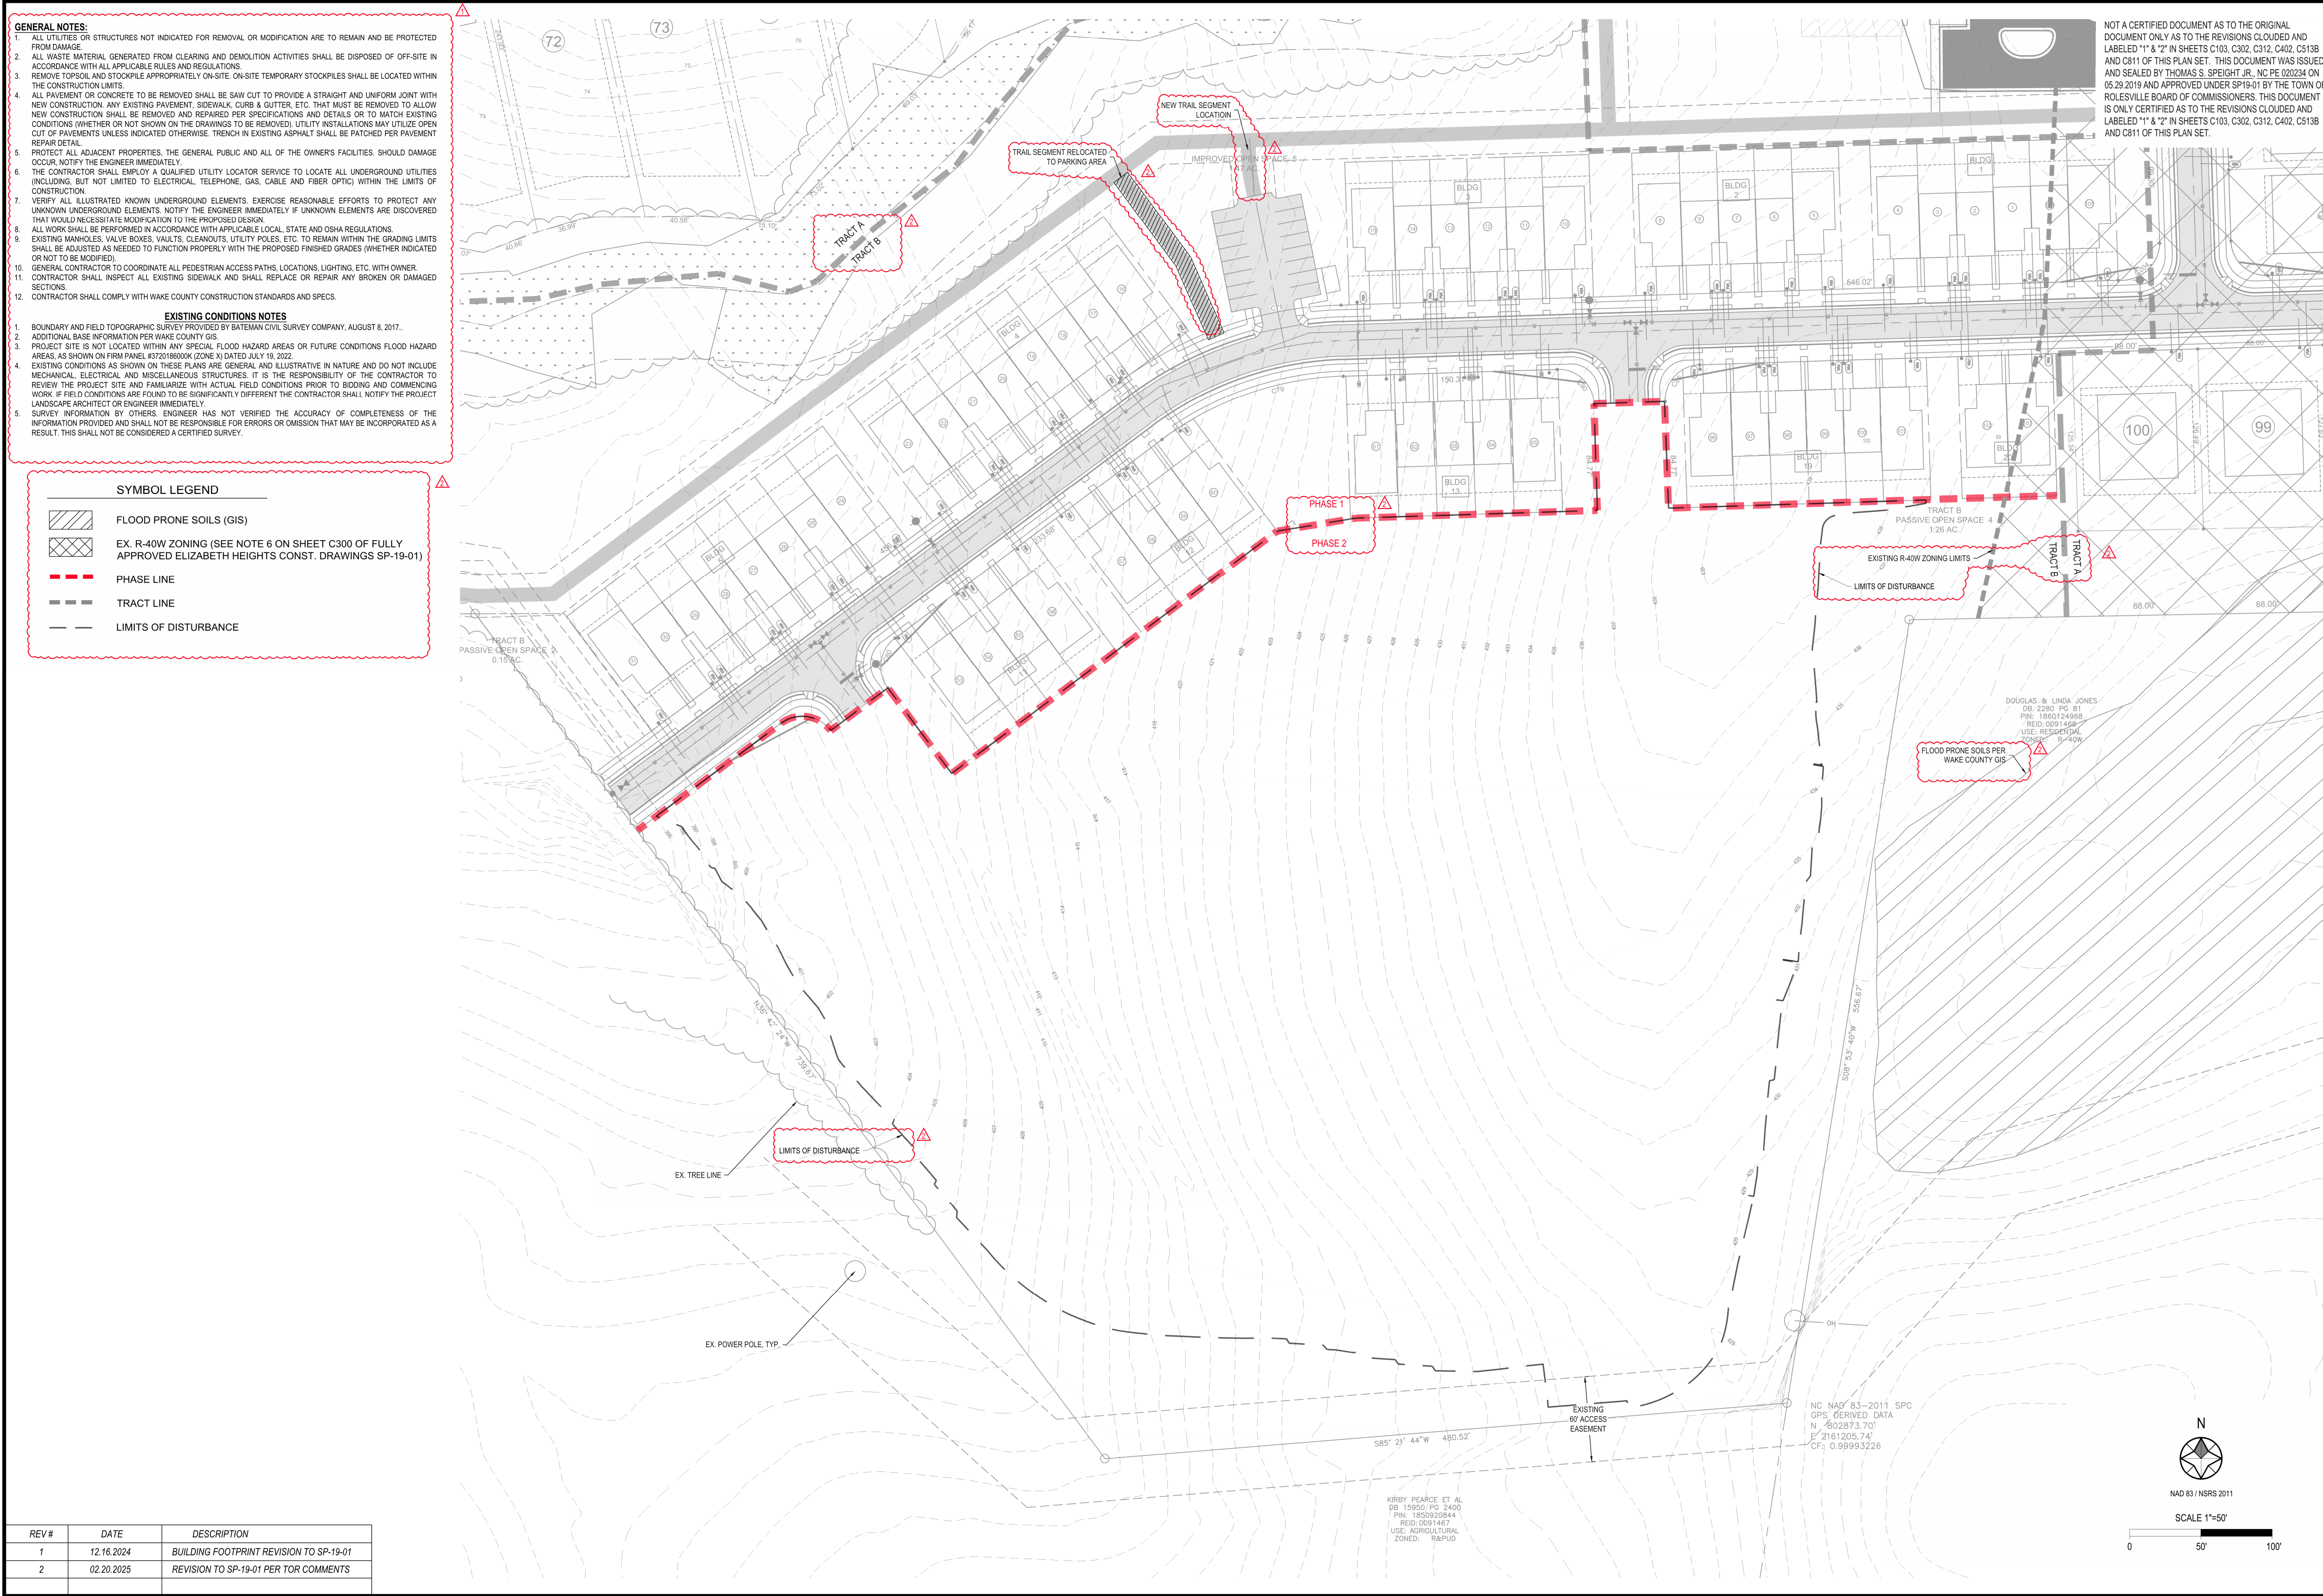

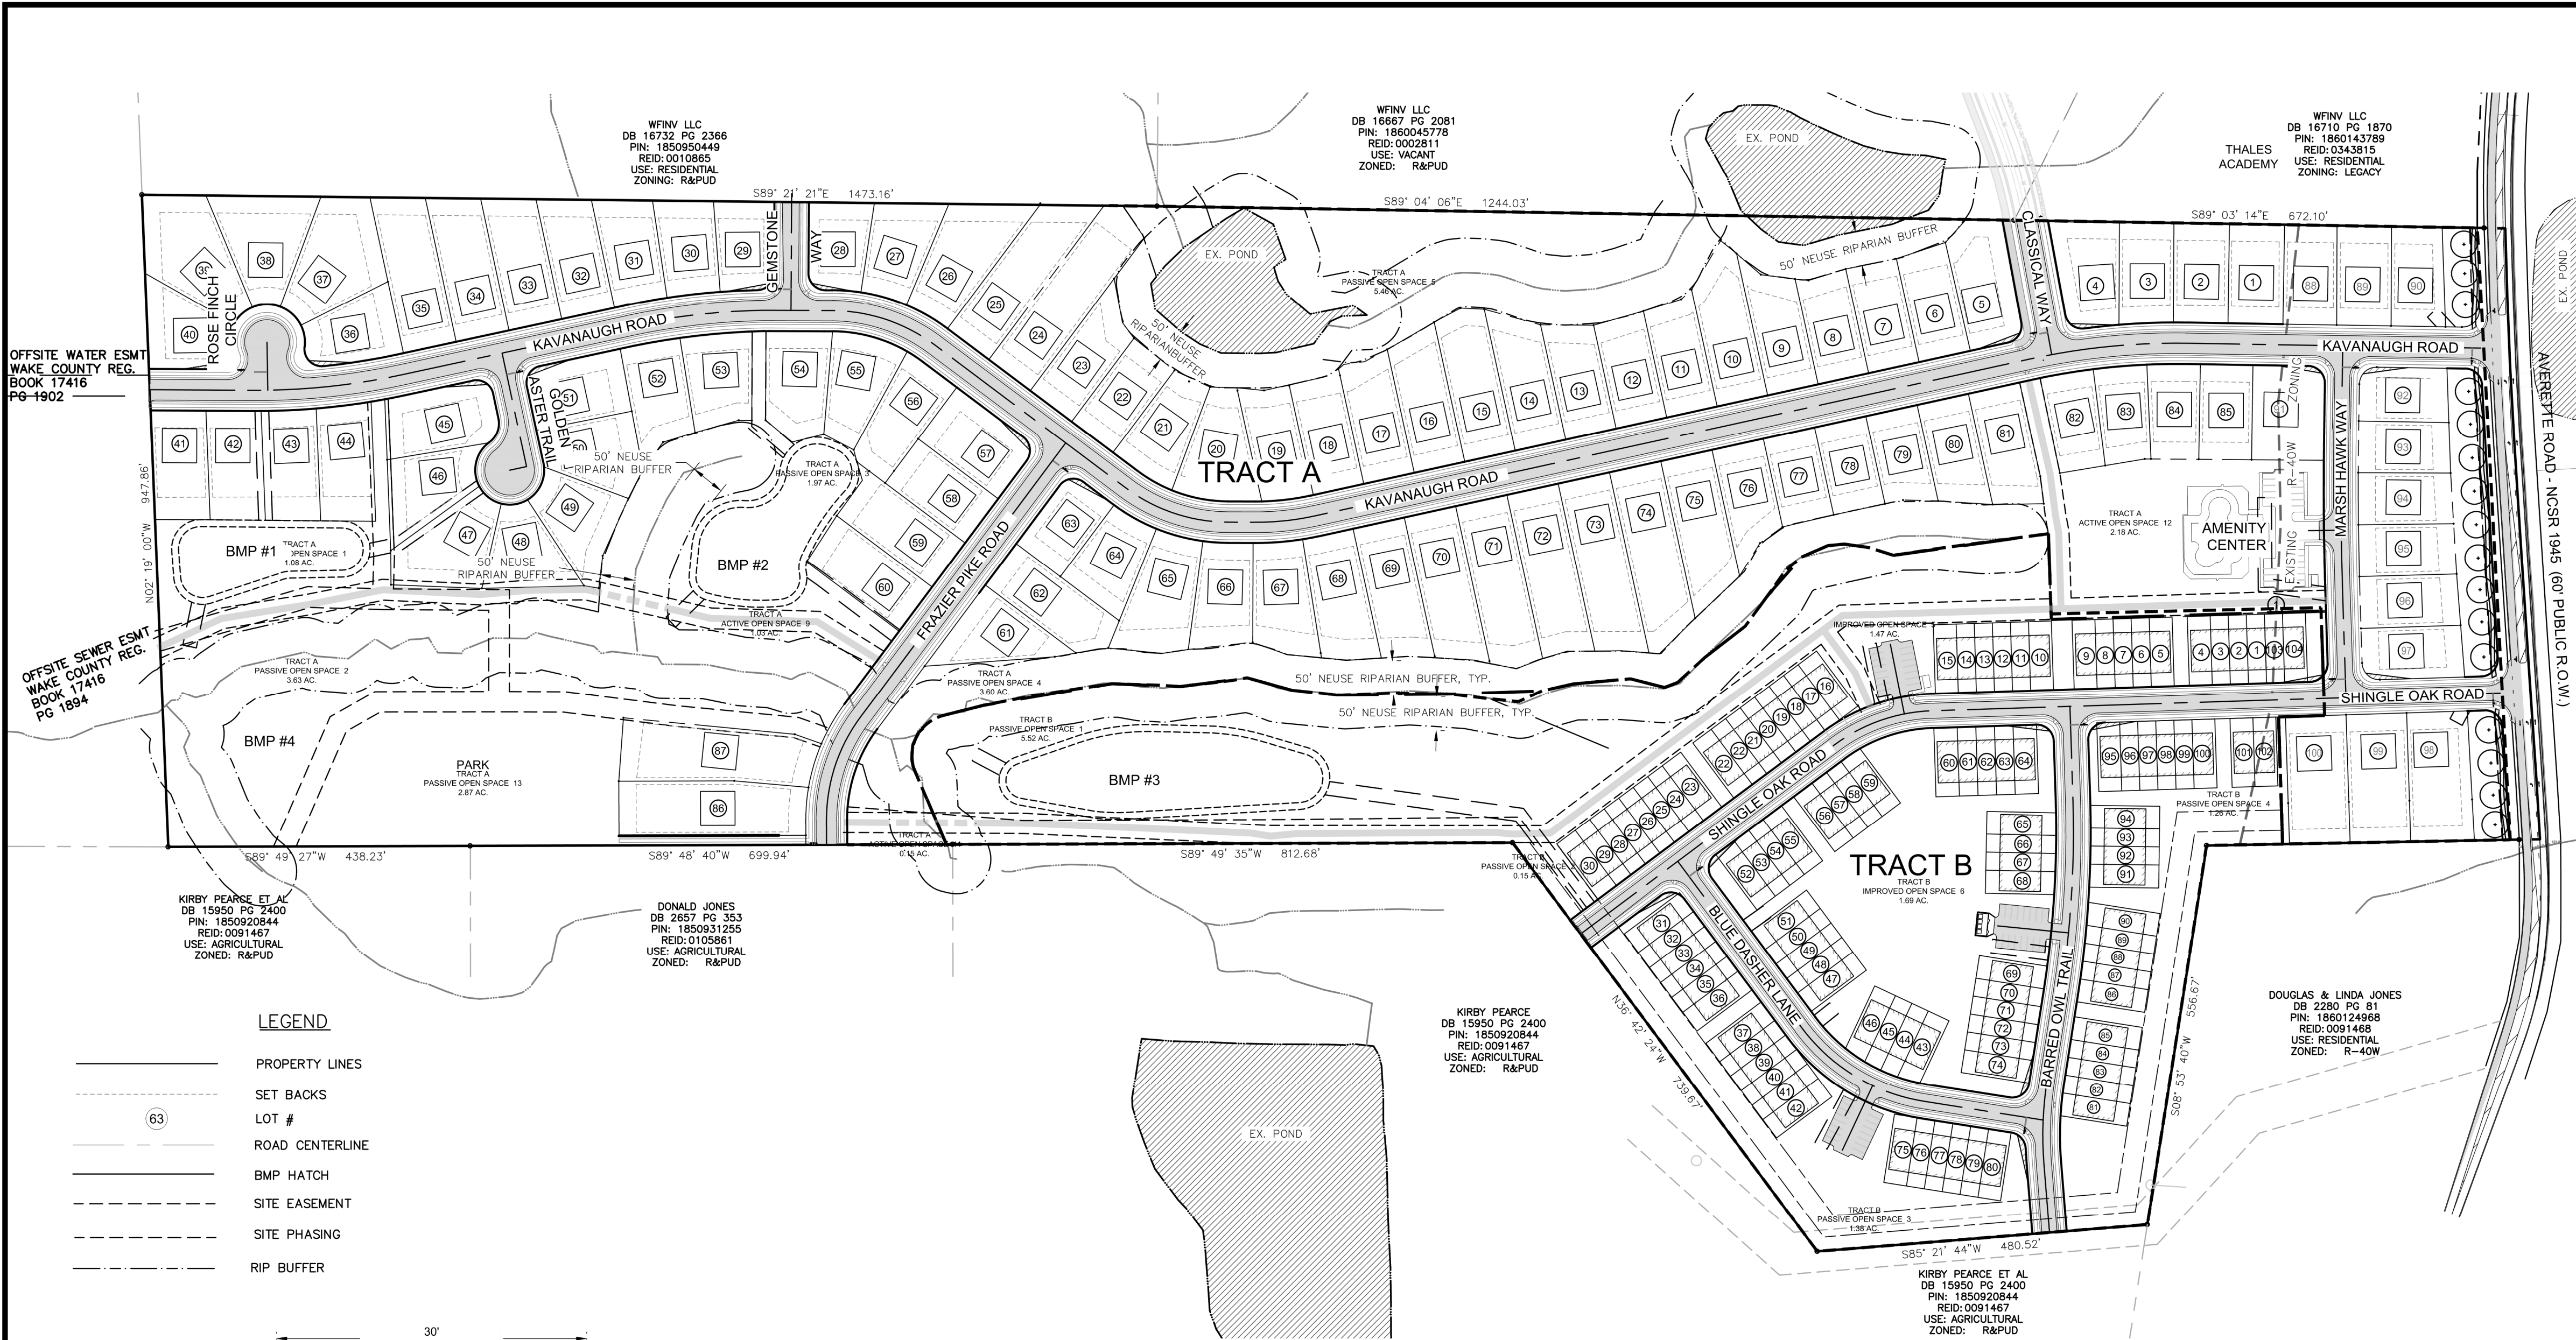


LEGEND


- PROPERTY LINES
- SET BACKS
- LOT #
- ROAD CENTERLINE
- BMP HATCH
- SITE EASEMENT
- SITE PHASING
- RIP BUFFER

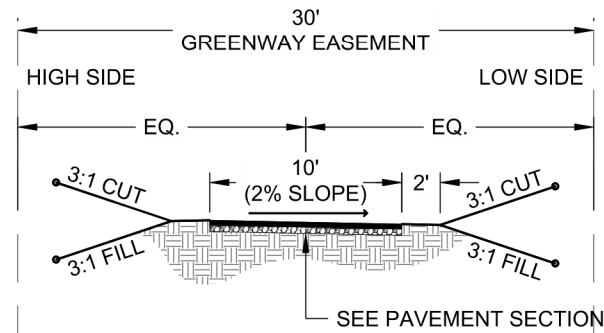

30' ROLESVILLE PUBLIC GREENWAY EASEMENT TYPICAL SECTION

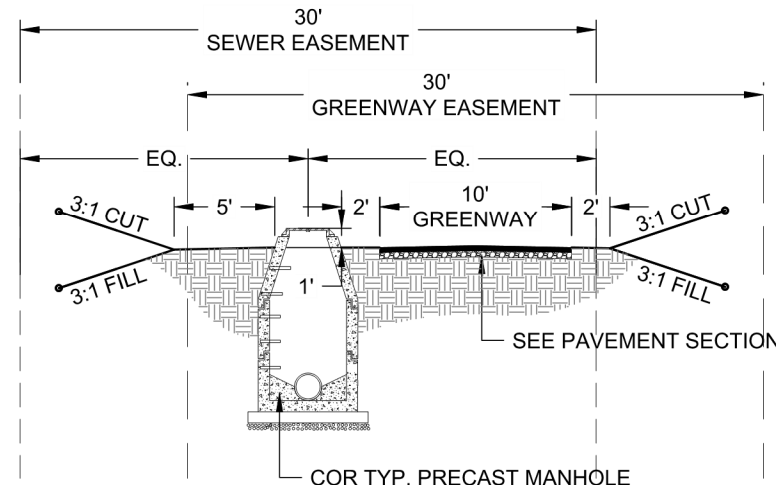

30' ROLESVILLE PUBLIC GREENWAY EASEMENT & 30' RALEIGH PUBLIC SEWER EASEMENT TYPICAL SECTION

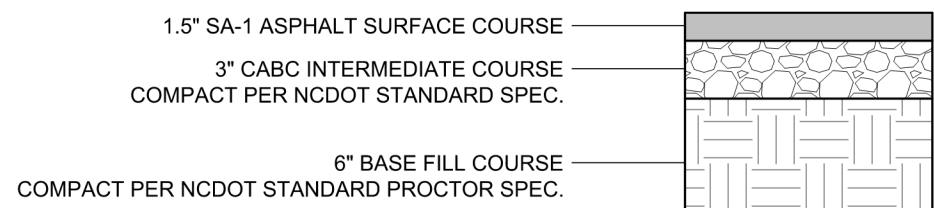

GREENWAY PAVEMENT SECTION DETAIL

SITE PLAN NOTES

- PER FEMA MAPS 3720185000J & 3720186000J FOR NORTH CAROLINA, THERE ARE NO FLOOD HAZARD AREAS WITHIN THE DEVELOPMENT BOUNDARIES.
- WATER SUPPLY AND WASTE WATER FOR ALL LOTS IN THIS DEVELOPMENT SHALL BE PROVIDED BY THE CITY OF RALEIGH THROUGH A MERGER AGREEMENT WITH THE TOWN OF ROLESVILLE.
- ROAD NAMES SHALL BE SUBMITTED AND APPROVED PRIOR TO APPROVAL OF THE FINAL PLAT.
- ALL OPEN SPACE PARCELS SHALL BE OWNED BY A LEGALLY ORGANIZED HOME OWNERS ASSOCIATION THAT WILL BE RESPONSIBLE FOR MANAGING AND ENSURING RESIDENTS' ACCESS.
- AS PER THE TOWN OF ROLESVILLE UDO 15.4.8.2.B.4, THE PROPOSED PASSIVE OPEN SPACE MAY CONTAIN ENVIRONMENTALLY SENSITIVE AREAS, LIKE BODIES OF WATER, NEUSE RIVER RIPARIAN BUFFERS, WETLANDS, SPECIAL FLOOD HAZARD AREAS, ROCK OUTCROPS AND STEEP SLOPES. PASSIVE OPEN SPACE WILL BE USED FOR CONSERVATION OF NATURAL RESOURCES, MEADOWS, WOODLANDS, WETLANDS, WILDLIFE CORRIDORS AND SIMILAR CONSERVATION ORIENTED ACTIVITIES.
- IT IS THE INTENT OF THIS PROJECT THAT THE 6.53 AC. ZONED R-40W WILL BE REGRADED AT CONSTRUCTION SO THAT IT CAN BE REMOVED FROM THE WATERSHED. FOLLOWING THE WATERSHED ADJUSTMENT, A REZONING REQUEST WILL BE FILED. THE 12 SINGLE FAMILY DETACHED LOTS AND 4 TOWNHOME LOTS CURRENTLY LOCATED IN THE R-40W HAVE NOT BEEN SHOWN ON THIS PRELIMINARY SUBDIVISION PLAT BUT, WILL BE SUBMITTED FOR TOWN APPROVAL ONCE THE WATERSHED ADJUSTMENT HAS BEEN FINALIZED AND THE REZONING APPROVED.
- FRONT FACING TOWNHOME GARAGES SHALL HAVE AT LEAST TWENTY FEET (20') SEPARATING THE NEIGHBORING DRIVEWAYS OR NO MORE THAN FIVE FEET (5') SEPARATING NEIGHBORING DRIVEWAYS. IF THE SEPARATION MEASURES FIVE FEET (5') OR LESS, THE NEXT SEPARATION MUST BE AT LEAST TWENTY FEET (20'). REAR FACING GARAGES MAY BE ACCESSED BY A PRIVATE ALLEY WITH NO SEPARATION REQUIREMENTS.
- HANDICAP RAMPS WILL BE INSTALLED AT ALL INTERSECTIONS NECESSARY FOR SIDEWALK CONNECTIVITY.

SITE DEVELOPMENT DATA

GROSS TRACT AREA:	82.399 AC.
AREA IN EXISTING ROW:	0.613 AC.
AREA IN NEW DEDICATED ROW:	0.261 AC.
NEW GROSS TRACT AREA:	81.525 AC.
PROPOSED USE:	RESIDENTIAL
MAXIMUM BUILDING HEIGHT:	45 FT, 3 STORIES

ALLOWED DENSITY

SINGLE FAMILY DWELLINGS (TRACT "A")	4 / AC.
TOWNHOUSES (TRACT "B")	8 / AC.
TOTAL TRACT	4 / AC.

PROPOSED DENSITY

AREA IN TRACT "A", SINGLE FAMILY DWELLINGS:	58.38 AC.
PROPOSED LOTS:	100 LOTS
PROPOSED DENSITY TRACT "A":	1.71 LOTS / AC.
AREA IN TRACT "B":	23.15 AC.
PROPOSED UNITS:	104 UNITS
PROPOSED DENSITY TRACT "B":	4.49 UNITS / AC.
TOTAL PROPOSED DENSITY:	2.53 UNITS / AC.

LOT DIMENSIONS

TRACT "A" (SINGLE FAMILY)	
MINIMUM WIDTH:	50'
PROPOSED:	80'
AVERAGE LOT SIZE:	11,382 SF
TRACT "B" (TOWNHOUSES)	
MINIMUM LOT WIDTH:	20'
PROPOSED:	26'

SETBACKS

TRACT "A" (SINGLE FAMILY)	
FRONT	25'
REAR	25'
SIDE	5'
TRACT "B" (TOWNHOUSES)	
FRONT	15' (FROM R.O.W.)
PROPOSED	20'
REAR	15' (FROM PROPERTY LINE)

IMPERVIOUS AREA SUMMARY

-EXISTING IMPERVIOUS AREA:	0 SF
-PROPOSED IMPERVIOUS AREA:	
-SITE AREA IN ROADS, PARKING, ETC. :	347,814 SF
-TOTAL AREA IN LOTS:	225,000 SF
AVERAGE IMPERVIOUS AREA PER LOT:	4,500 SF
-TOTAL IMPERVIOUS AREA:	572,814 SF

PARKING


TRACT "A" (SINGLE FAMILY DETACHED)	
NUMBER OF UNITS:	100
CLUSTER MAILBOX UNITS:	
REQUIRED:	4 SPACES (79-104 DWELLING UNITS)
PROPOSED:	5 SPACES AT AMENITY CENTER
TRACT "B" (TOWNHOUSES)	
NUMBER OF UNITS:	104
REQUIRED:	2.5 / TOWNHOUSE 104 x 2.5 = 260
PROPOSED:	324
REQUIRED GUEST PARKING:	1 / 4 TOWNHOUSES (104 / 4 = 26)
PROPOSED GUEST PARKING:	42
CLUSTER MAILBOX UNITS:	
REQUIRED PARKING SPACES:	4 SPACES (79-104 DWELLING UNITS)
PROVIDED PARKING SPACES:	6 SPACES AT NORTH PARKING LOT

PERIMETER LANDSCAPE BUFFERS

TRACT "A" (SINGLE FAMILY)	
CLASS II ADJOINING CLASS II:	NONE
STREETSCAPE AVERETTE ROAD:	50'
TRACT "B" (TOWNHOUSES)	
CLASS III ADJOINING CLASS II:	20' TYPE B LANDSCAPE
	50' PERIMETER YARD BUFFER

RECREATION & OPEN SPACE


REQUIRED	
TRACT "A" (SINGLE FAMILY)	
10% OF SFD (58.38 AC.):	5.84 AC.
PROPOSED:	21.43 AC
50% OF 5.84 AC. TO BE SUITABLE FOR ACTIVE:	2.92 AC.
PROPOSED ACTIVE OPEN SPACE:	4.17 AC.
(1.25 ACRES EXTRA)	
PROPOSED PASSIVE OPEN SPACE:	17.26 AC
TRACT "B" (TOWNHOUSES)	
15% OF TH (23.15 AC.):	3.47 AC.
PROPOSED:	11.47 AC.
35% OF REQUIRED SPACE TO BE IMPROVED:	1.22 AC.
PROPOSED IMPROVED OPEN SPACE:	1.25 AC.
(UNUSED FROM TRACT A AMENITY)	
PROPOSED PASSIVE OPEN SPACE:	8.31 AC.

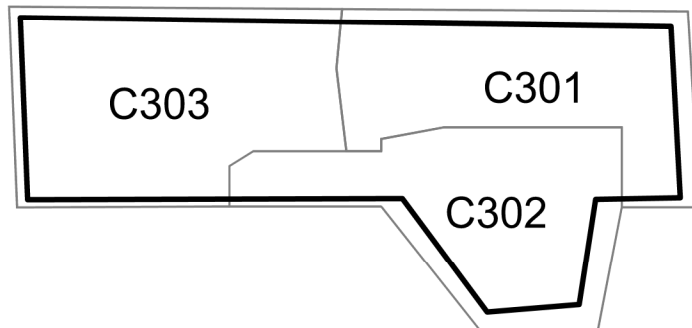

SITE PLAN SHEET KEY



KNOW WHAT IS BELOW
CALL BEFORE YOU DIG

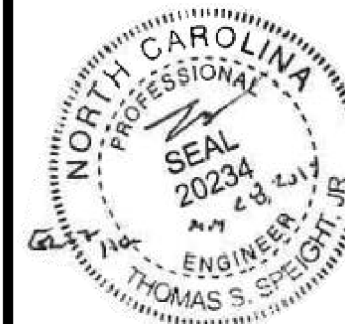

Bateman Civil Survey Company
Engineers • Surveyors • Planners
2524 Reliance Avenue, Apex, North Carolina 27539
Phone: 919.577.1080 Fax: 919.577.1081
NCBELS FRM No. C-2376



ELIZABETH HEIGHTS
CONSTRUCTION DRAWINGS
1205 AVERETTE ROAD
WAKE FOREST, NC 27587
WAKE COUNTY, NC

OVERALL SITE DATA


Project Engineer:	TSS
Designed By:	LEG
Drawn By:	LEG
Checked By:	TSS
Scale:	1"=150'

Date: 07/31/2019


Project Number: 170348

SHEET
C300

REV NO.	DESCRIPTIONS	REVISIONS
2	REMOVE SWEETLEAF	07/31/2019
1	REVISED PER TOR COMMENTS	12/07/2018

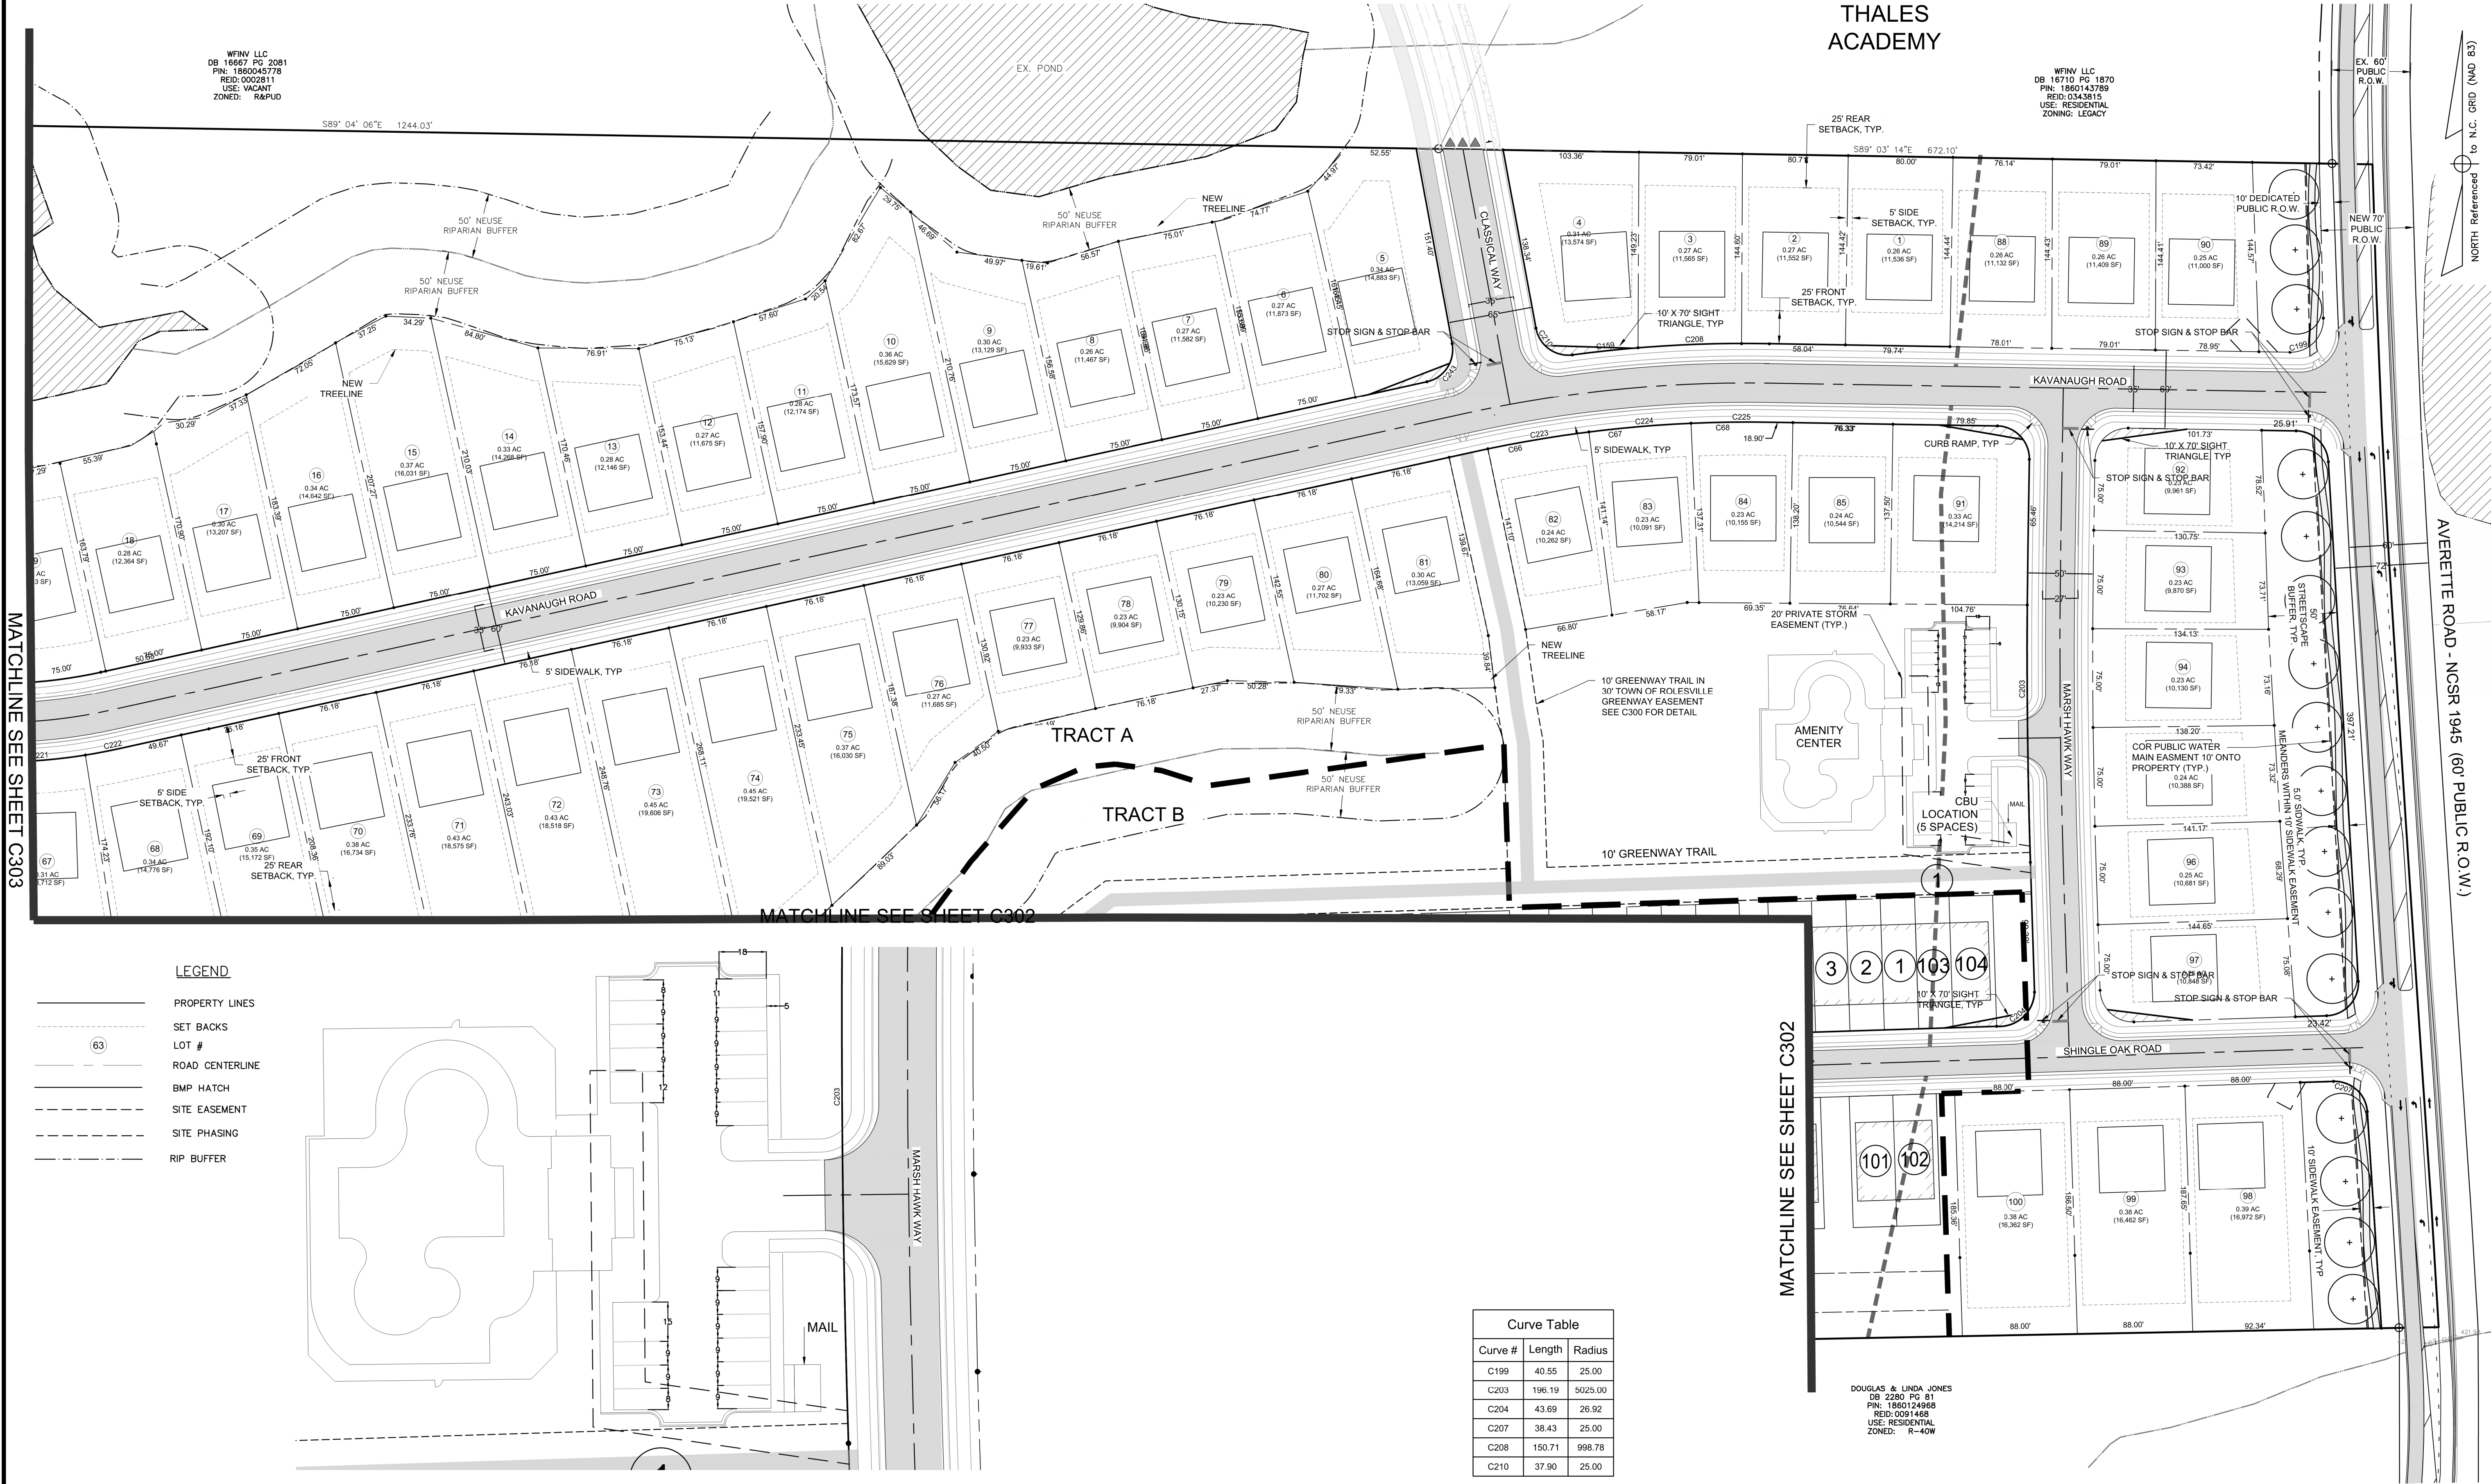

- LEGEND**
- PROPERTY LINES
 - SET BACKS
 - LOT #
 - ROAD CENTERLINE
 - BMP HATCH
 - SITE EASEMENT
 - SITE PHASING
 - RIP BUFFER

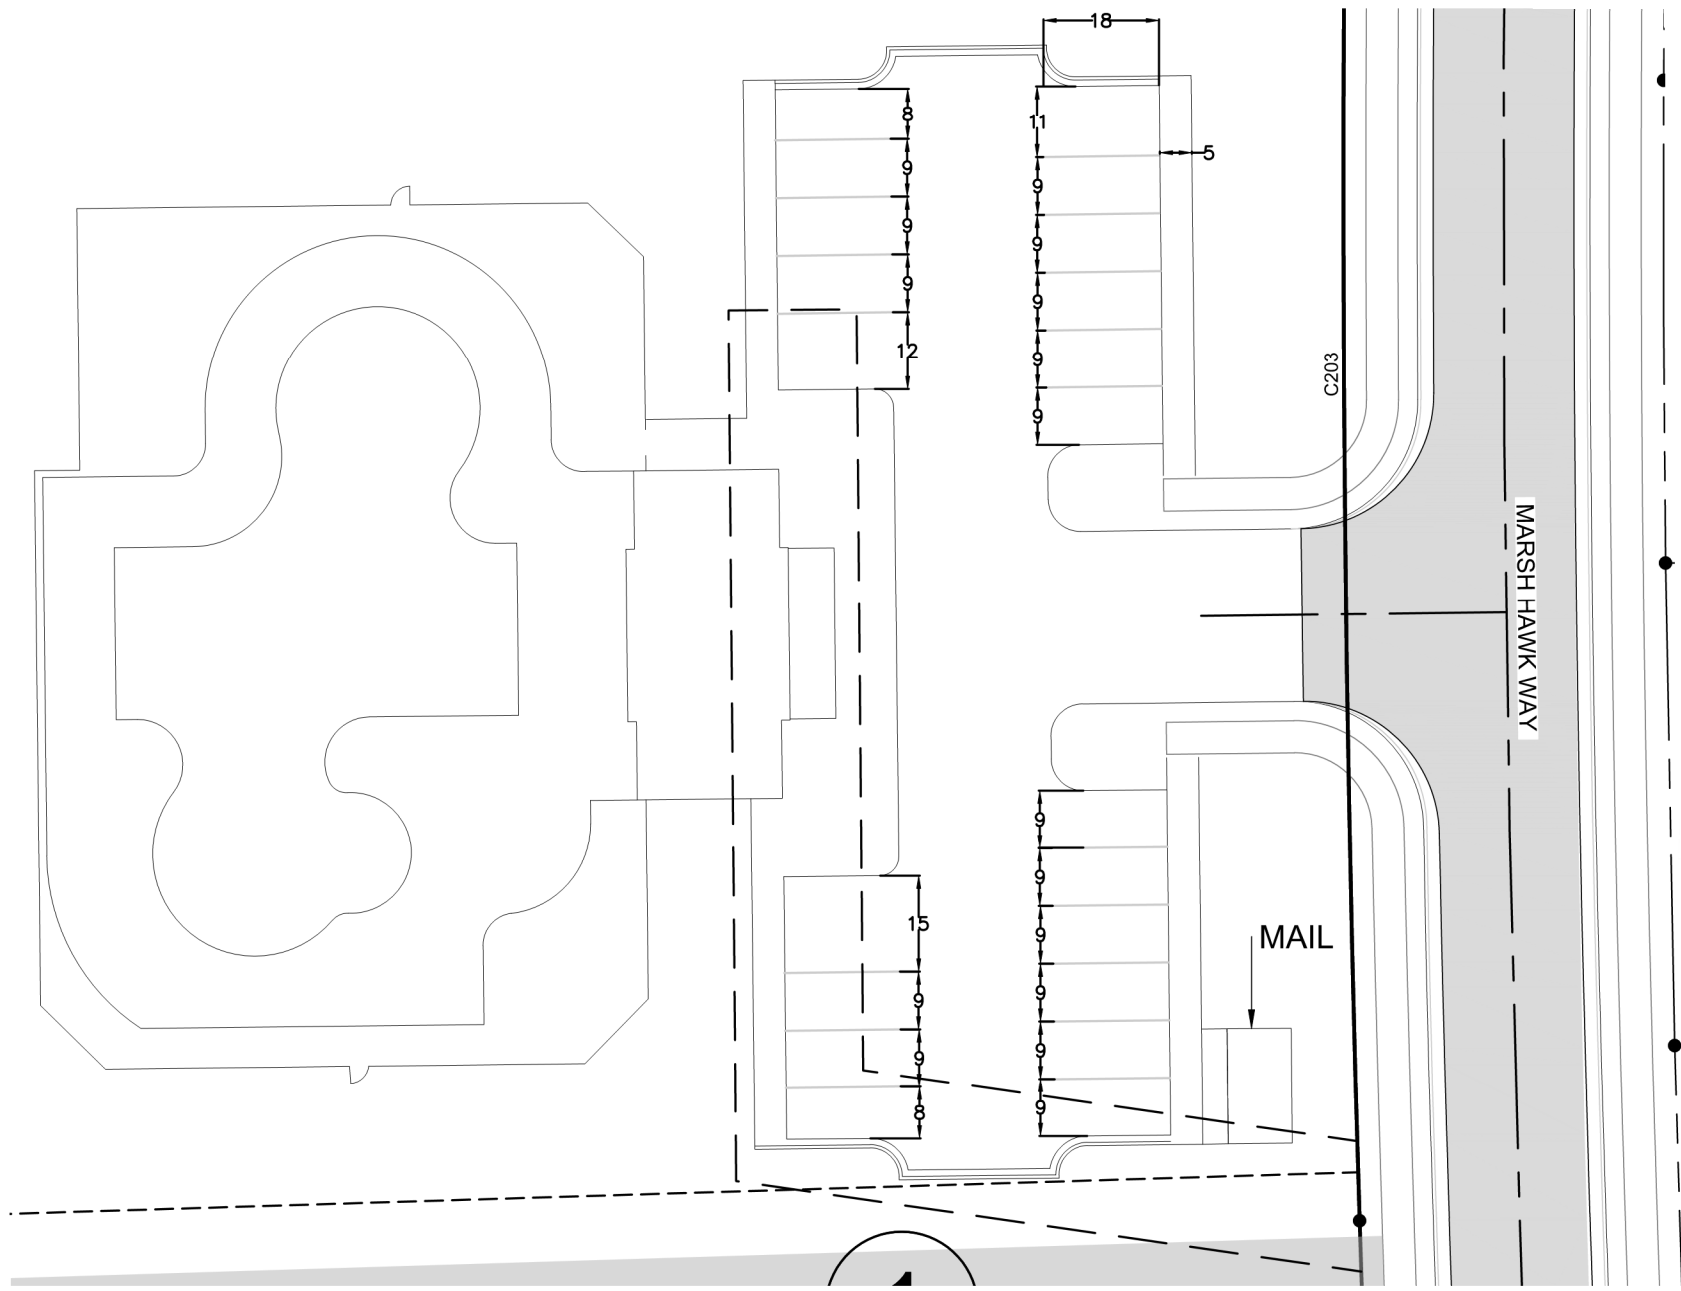

AMENITY CENTER
SCALE 1" = 30'

Curve Table		
Curve #	Length	Radius
C199	40.55	25.00
C203	196.19	5025.00
C204	43.69	26.92
C207	38.43	25.00
C208	150.71	998.78
C210	37.90	25.00

- SYMBOL LEGEND**
- END OF STREET SIGNAGE
 - STOP SIGN AND STREET NAME SIGN LOCATION
 - ACCESSIBILITY RAMP
 - LARGE STREET TREE, TYP
 - 2 1/2" CALIPER MIN

811
KNOW WHAT IS BELOW
CALL BEFORE YOU DIG

1"=60'

REV NO.	DESCRIPTIONS	REVISIONS
2	REMOVE SWEETLEAF	07/31/2019
1	REVISED PER TOR COMMENTS	12/07/2018



Bateman Civil Survey Company
Engineers • Surveyors • Planners
2524 Reliance Avenue, Apex, North Carolina 27539
Phone: 919.577.1080 Fax: 919.577.1081
NCBELS FRM No. C-2376



ELIZABETH HEIGHTS
CONSTRUCTION DRAWINGS
1205 AVERETTE ROAD
WAKE FOREST, NC 27587
WAKE COUNTY, NC

SITE PLAN


Project Engineer:	TSS
Designed By:	LEG
Drawn By:	LEG
Checked By:	TSS
Scale:	1"=60'
Date:	07/31/2019
Project Number:	170348
SHEET	C301

SITE DATA	
OWNER	EXPERIENCEONE HOMES LLC
SITE ADDRESS	PO BOX 5509 CARY, NC 27512
PIN	1860039129
OVERLAY	NAME
EXISTING USE	VACANT
PROPOSED USE	SFA DWELLINGS
ZONING	R&PD & R-40W
SP-19-01 APPROVED SFA DWELLING UNITS	51
PROPOSED SFA DWELLING UNITS	51
GROSS TRACT AREA	10.11 AC.
PHASE 2 PROPOSED ROADS	
BARRED OWL TRAIL (50' R/W WIDTH)	716 LF
BLUE DASHER LANE (50' R/W WIDTH)	636 LF

SYMBOL LEGEND

- ▲▲▲ END OF STREET SIGNAGE
- STOP SIGN AND STREET NAME SIGN LOCATION
- ACCESSIBILITY RAMP
- LARGE STREET TREE, TYP
2 1/2" CALIPER MIN


- ▨ FLOOD PRONE SOILS (GIS)
- ▤ EX. R-40W ZONING (SEE NOTE 6 ON SHEET C300 OF FULLY APPROVED ELIZABETH HEIGHTS CONST. DRAWINGS SP-19-01)
- PHASE LINE
- TRACT LINE

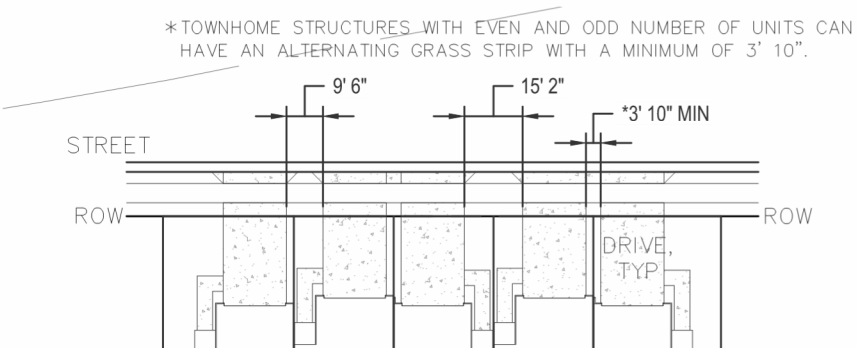


DRIVEWAY SEPARATION DETAIL
NOT TO SCALE



TOWNHOUSE SETBACK DETAIL
NOT TO SCALE

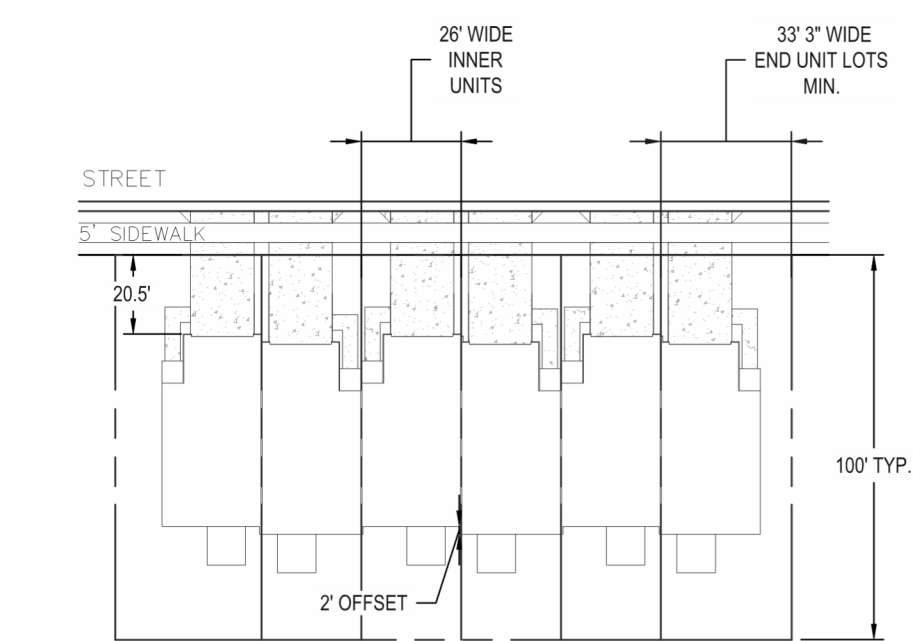

TOWNHOUSE LOT DIMENSIONS
NOT TO SCALE

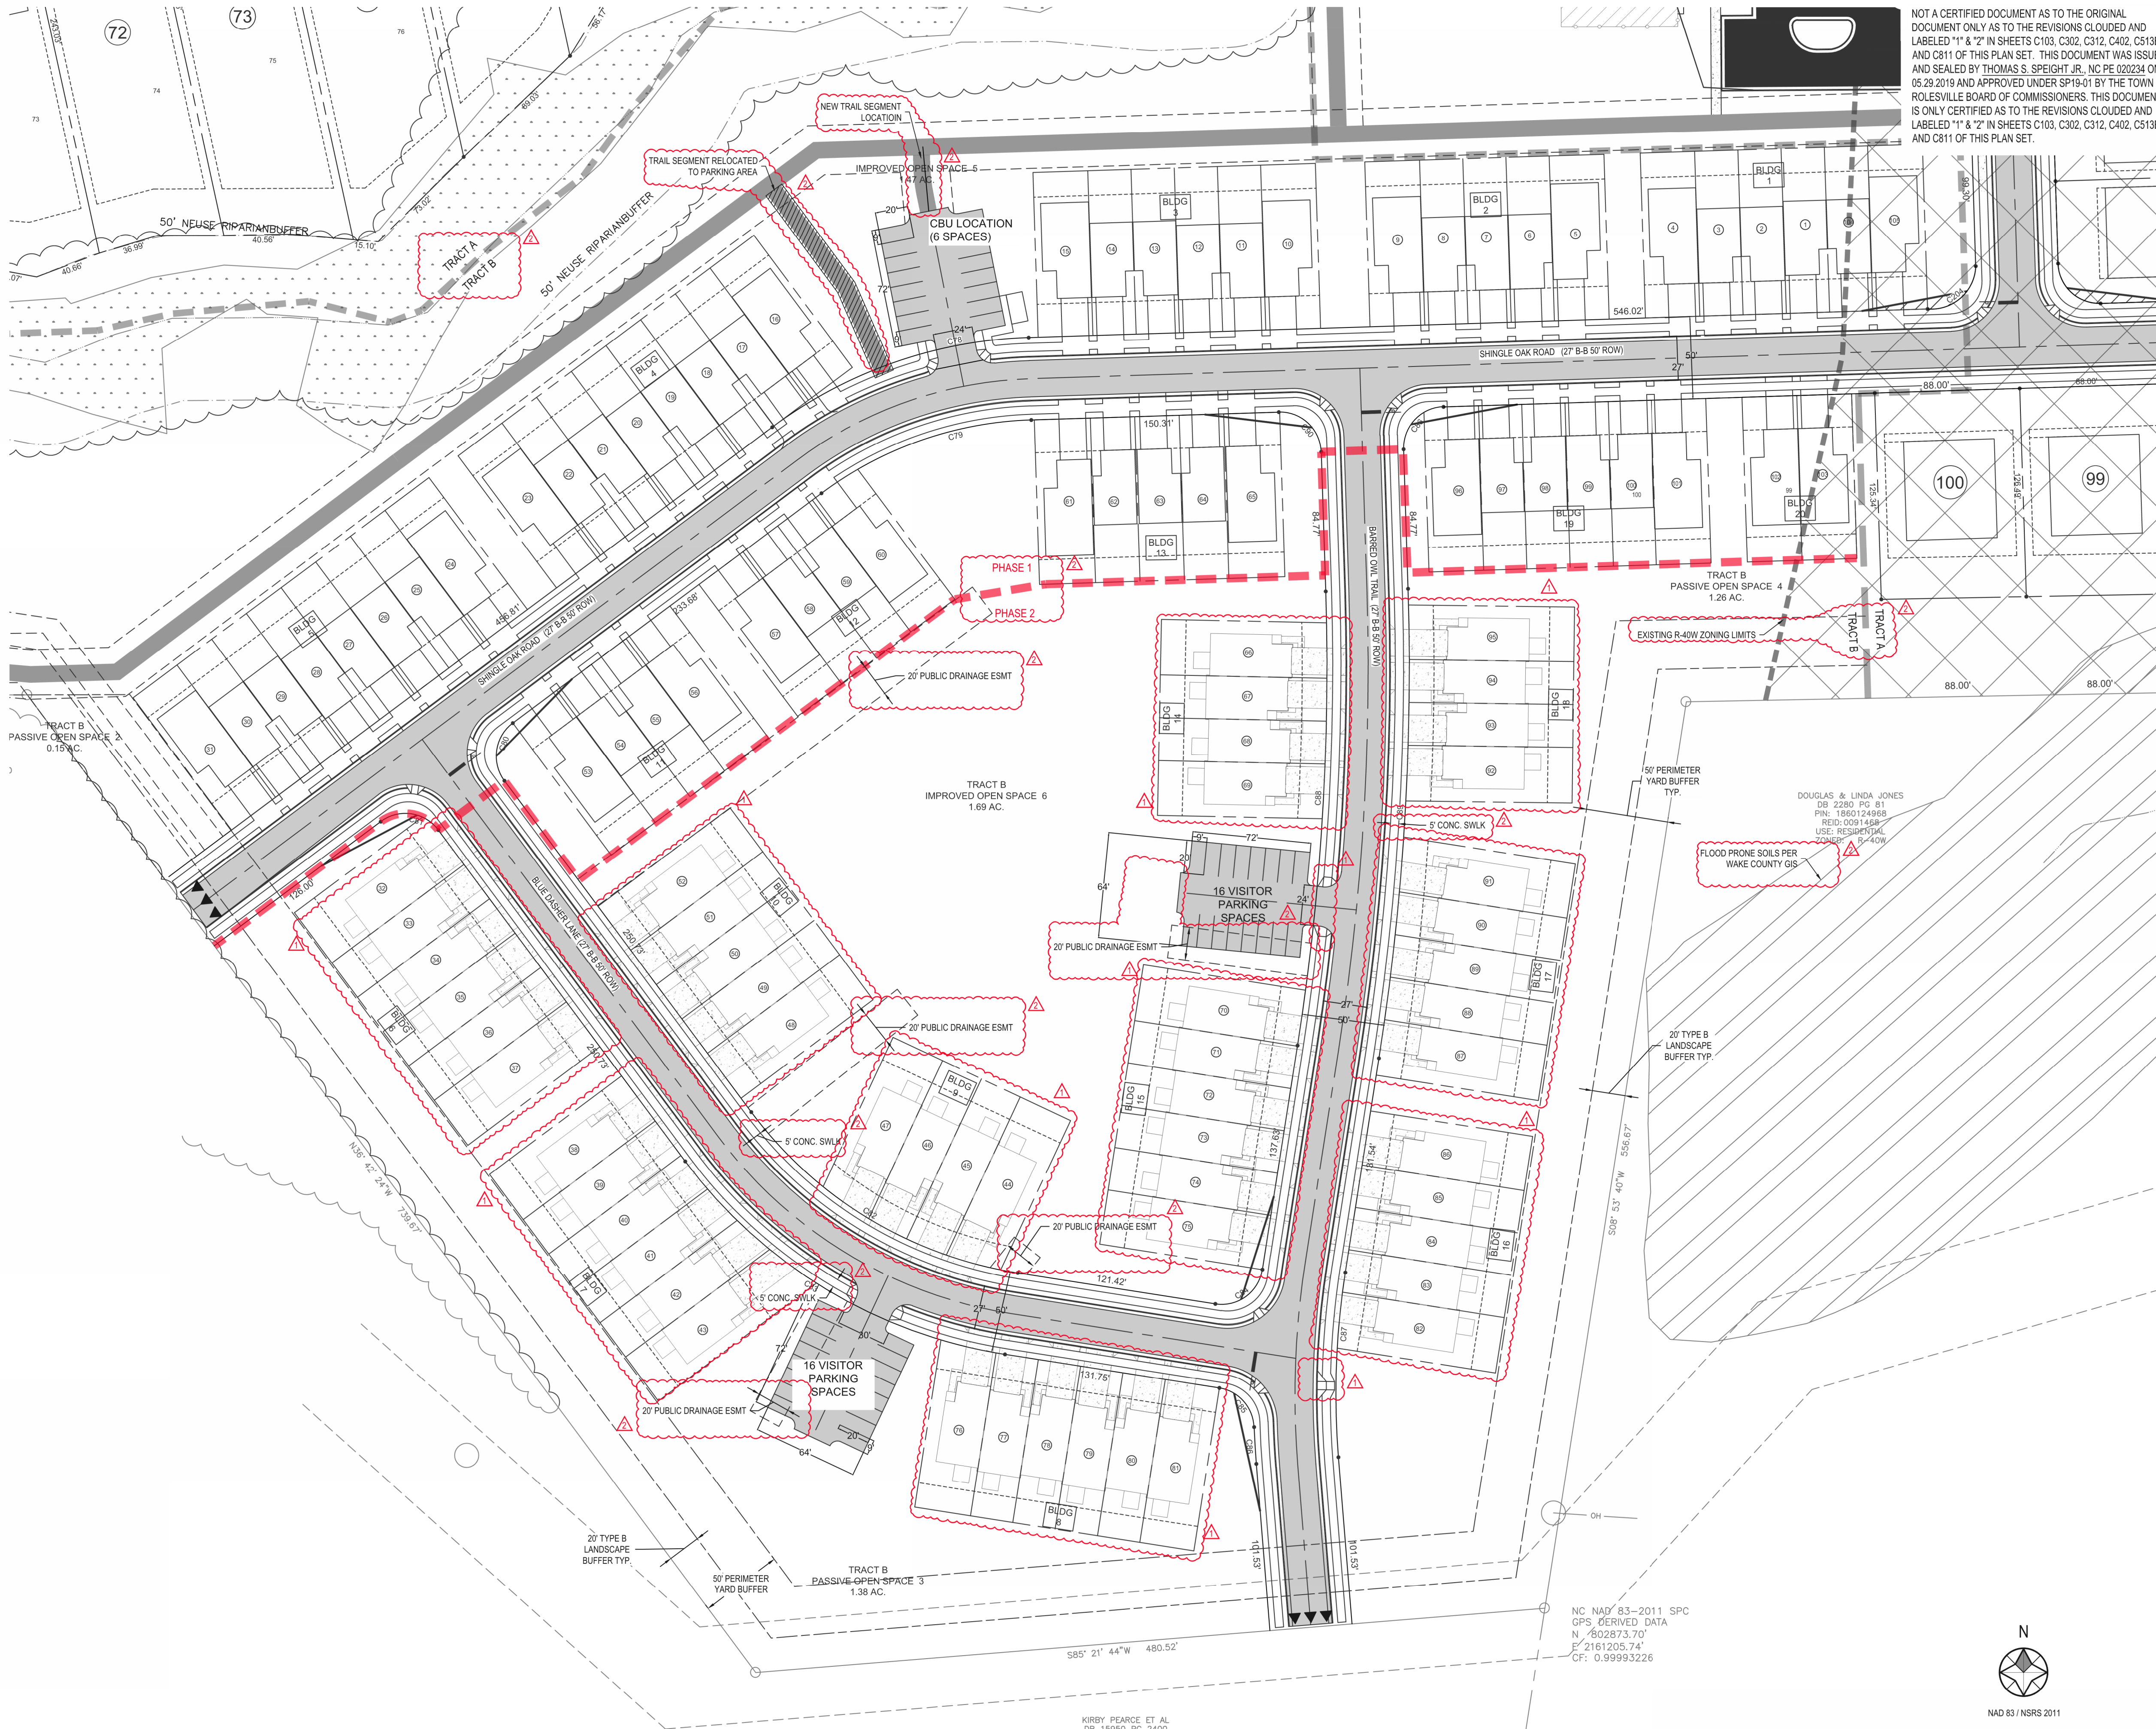

NOT A CERTIFIED DOCUMENT AS TO THE ORIGINAL DOCUMENT ONLY AS TO THE REVISIONS CLOUDED AND LABELED "1" & "2" IN SHEETS C103, C302, C312, C402, C513B AND C811 OF THIS PLAN SET. THIS DOCUMENT WAS ISSUED AND SEALED BY THOMAS S. SPEIGHT JR., NC PE 020234 ON 05.29.2019 AND APPROVED UNDER SP19-01 BY THE TOWN OF ROLESVILLE BOARD OF COMMISSIONERS. THIS DOCUMENT IS ONLY CERTIFIED AS TO THE REVISIONS CLOUDED AND LABELED "1" & "2" IN SHEETS C103, C302, C312, C402, C513B AND C811 OF THIS PLAN SET.



NAD 83 / NRSRS 2011

SCALE 1"=50'

0 50' 100'

KIRBY PEARCE ET AL
DB 19550 PG 2400
PIN: 1850920844
REID: 0091467
USE: AGRICULTURAL
ZONED: R&PD

NC NAD'83-2011 SPC
GPS DERIVED DATA
N = 602873.70
E = 2161205.74
CP: 0.99993226

REV #	DATE	DESCRIPTION
1	12.16.2024	BUILDING FOOTPRINT REVISION TO SP-19-01
2	02.20.2025	REVISION TO SP-19-01 PER TOR COMMENTS


FINAL DRAWING

FOR REVIEW ONLY



Douglas B Cooper
Professional Engineer
State of North Carolina
License No. 23548
Exp. Date 04/01/2025

Bateman Civil Survey Company
Engineers • Surveyors • Planners
2524 Reliance Avenue, Apex, North Carolina 27539
Phone: 919.577.1080 Fax: 919.577.1081
NCBELS FIRM No. C-2376

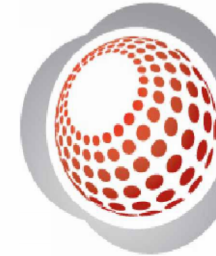

ELIZABETH HEIGHTS
PHASE 2 REVISIONS
1205 AVRETT ROAD
WAKE FOREST, NC 27787
WAKE COUNTY

SITE PLAN CONT.

Design By: BCSC
Date: 24.11.13
Project #: P170348

SHEET

C302

WFVW LLC
DB 16732 PG 2366
PIN: 1850950449
REID: 0010865
USE: RESIDENTIAL
ZONING: R&PUD



Bateman Civil Survey Company
Engineers • Surveyors • Planners
2524 Reliance Avenue, Apex, North Carolina 27539
Phone: 919.577.1080 Fax: 919.577.1081
NCBELS FRM No. C-2376



ELIZABETH HEIGHTS
CONSTRUCTION DRAWINGS
1205 AVERETTE ROAD
WAKE FOREST, NC 27587
WAKE COUNTY, NC


SITE PLAN

Project Engineer: TSS
Designed By: LEG
Drawn By: LEG
Checked By: TSS
Scale: 1"=60'

Date: 07/31/2019

Project Number: 170348

SHEET
C303

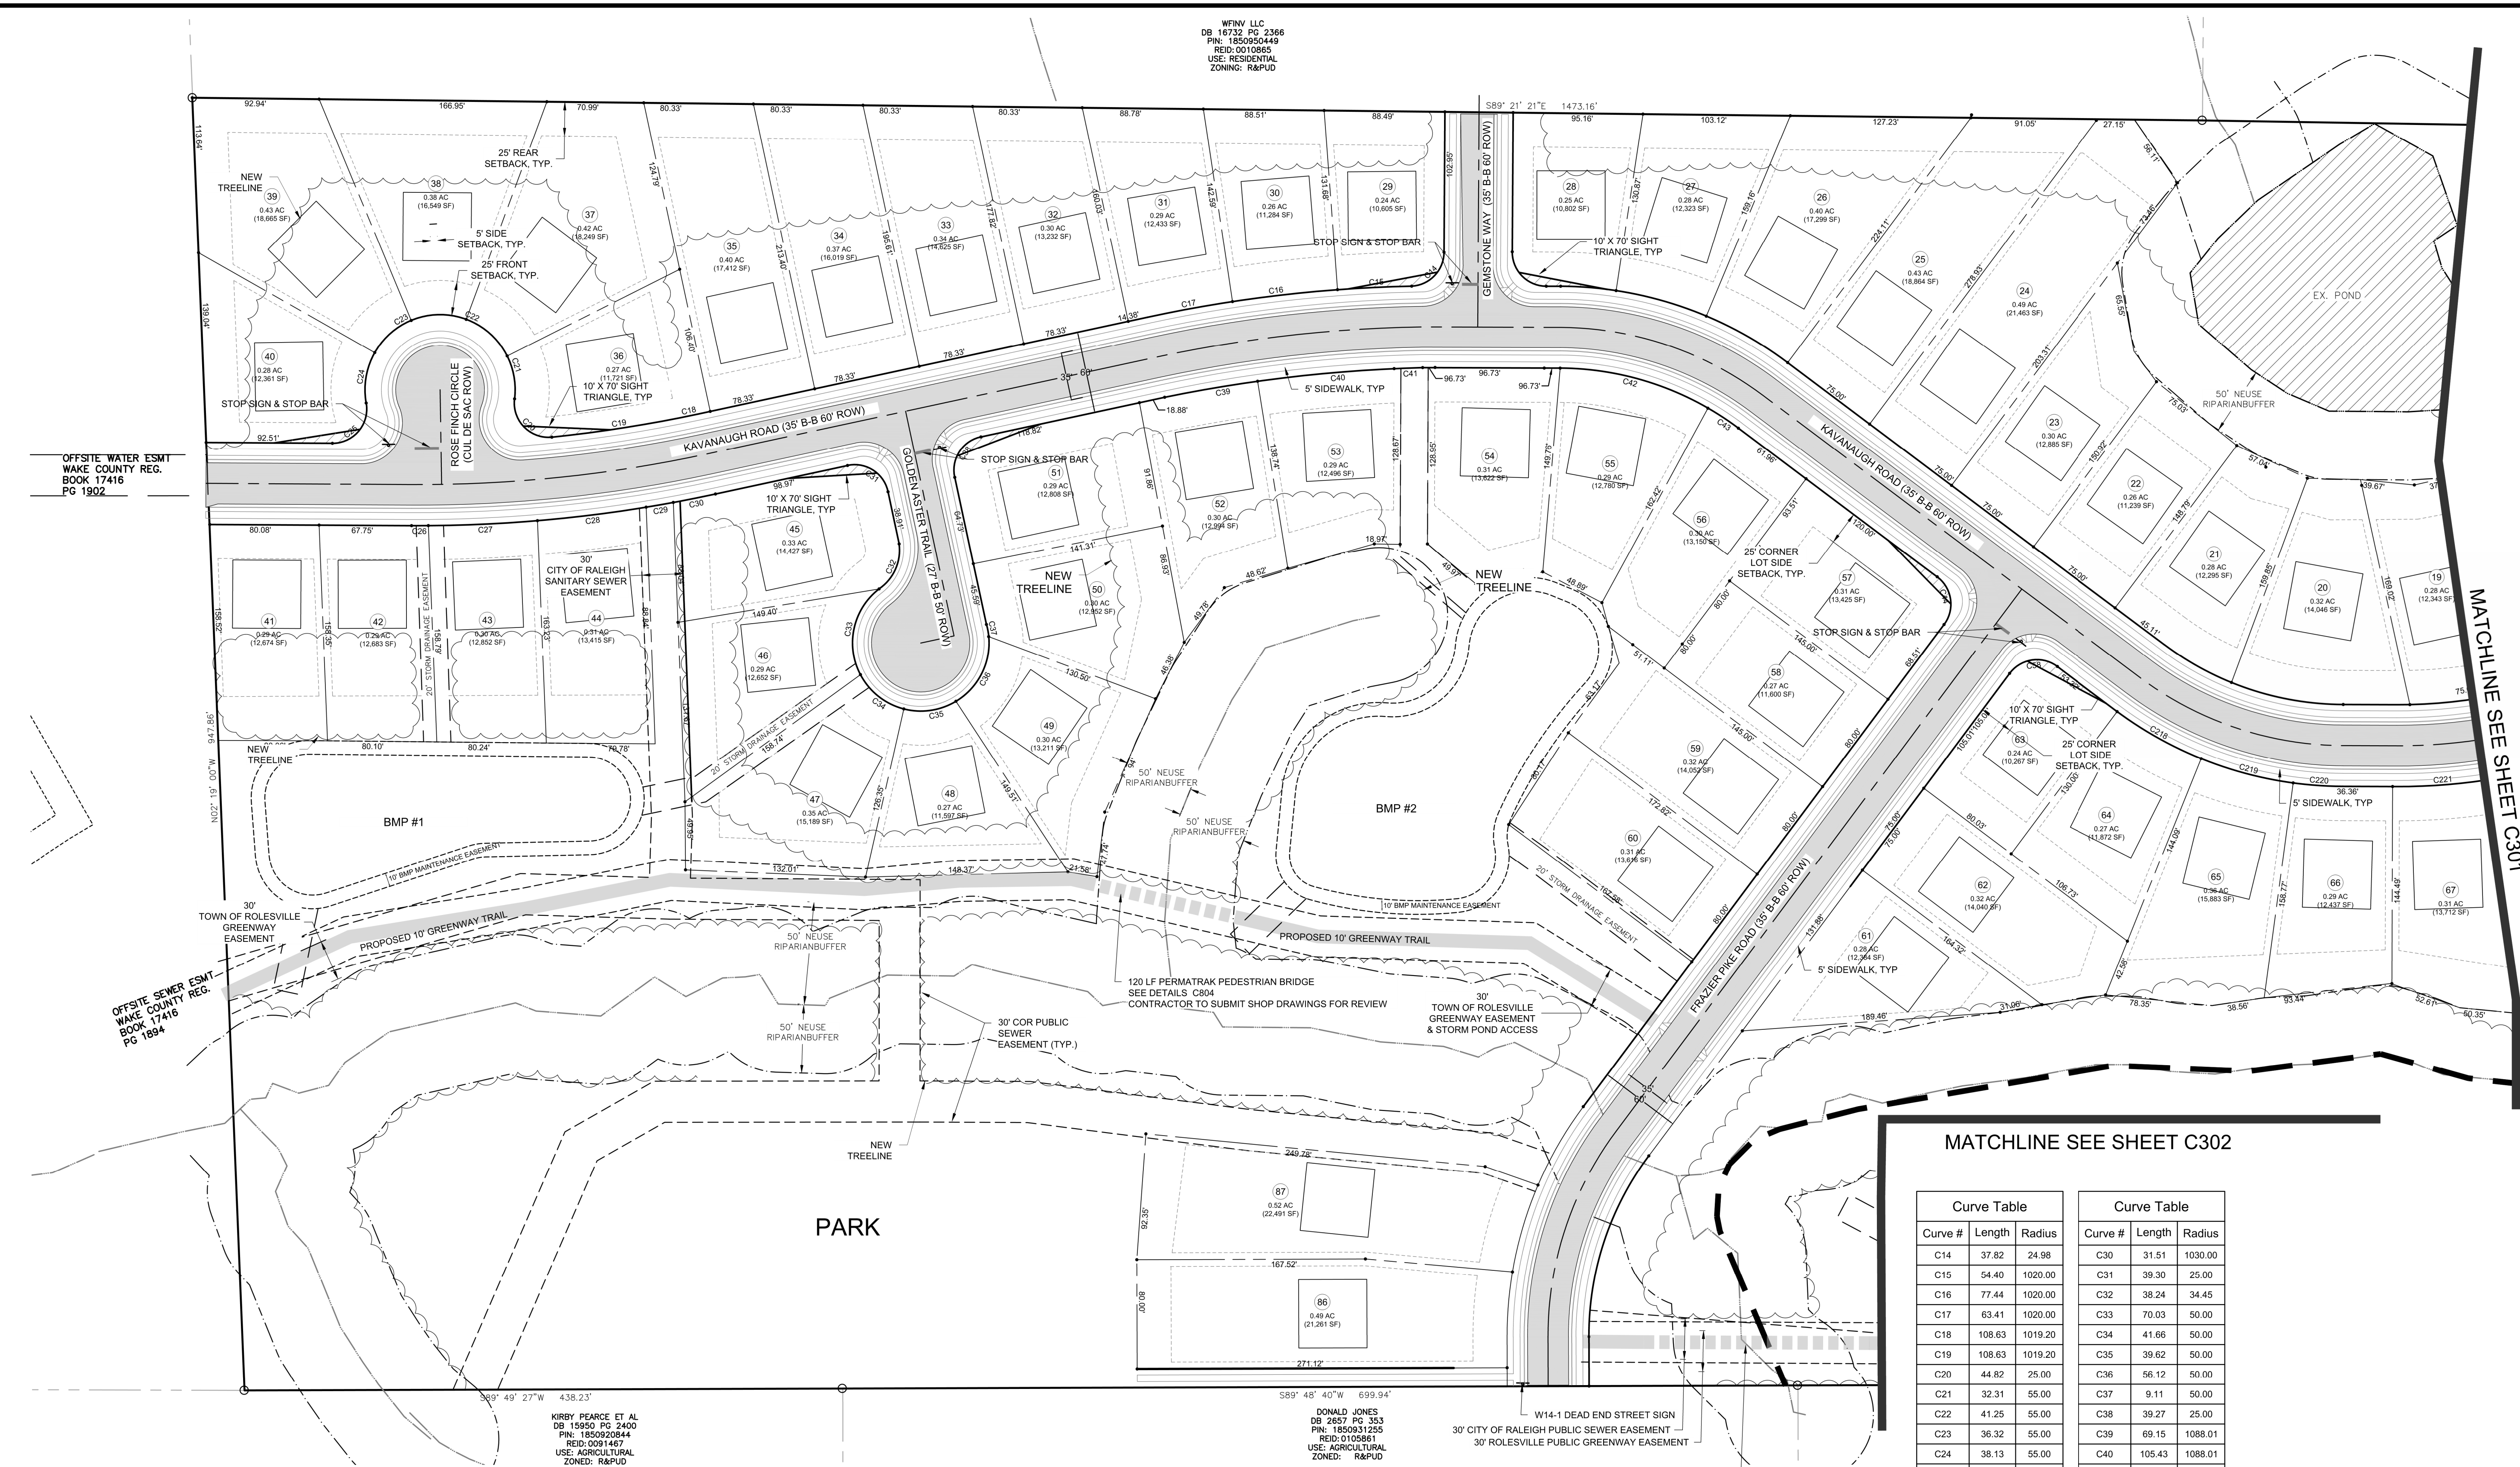

LEGEND

- PROPERTY LINES
- SET BACKS
- LOT #
- ROAD CENTERLINE
- BMP HATCH
- SITE EASEMENT
- SITE PHASING
- RIP BUFFER

SYMBOL LEGEND

- END OF STREET SIGNAGE
- STOP SIGN AND STREET NAME SIGN LOCATION
- ACCESSIBILITY RAMP
- LARGE STREET TREE, TYP
- 2 1/2" CALIPER MIN

MATCHLINE SEE SHEET C302

Curve Table		
Curve #	Length	Radius
C14	37.82	24.98
C15	54.40	1020.00
C16	77.44	1020.00
C17	63.41	1020.00
C18	108.63	1019.20
C19	108.63	1019.20
C20	44.82	25.00
C21	32.31	55.00
C22	41.25	55.00
C23	36.32	55.00
C24	38.13	55.00
C25	43.84	25.00
C26	12.32	1030.00
C27	80.03	1030.00
C28	80.29	1030.00
C29	20.18	1030.00


Curve Table		
Curve #	Length	Radius
C30	31.51	1030.00
C31	39.30	25.00
C32	38.24	34.45
C33	70.03	50.00
C34	41.66	50.00
C35	39.62	50.00
C36	56.12	50.00
C37	9.11	50.00
C38	39.27	25.00
C39	69.15	1088.01
C40	105.43	1088.01
C41	15.96	1088.01
C42	113.40	220.00
C43	26.70	220.00
C44	39.27	25.00
C58	39.26	25.00



KNOW WHAT IS BELOW
CALL BEFORE YOU DIG

1"=60' 60 60 120

REV NO	DESCRIPTIONS	REVISIONS
2	REMOVE SWEET LEAF	07/31/2019
1	REVISED PER TOR COMMENTS	12/07/2018

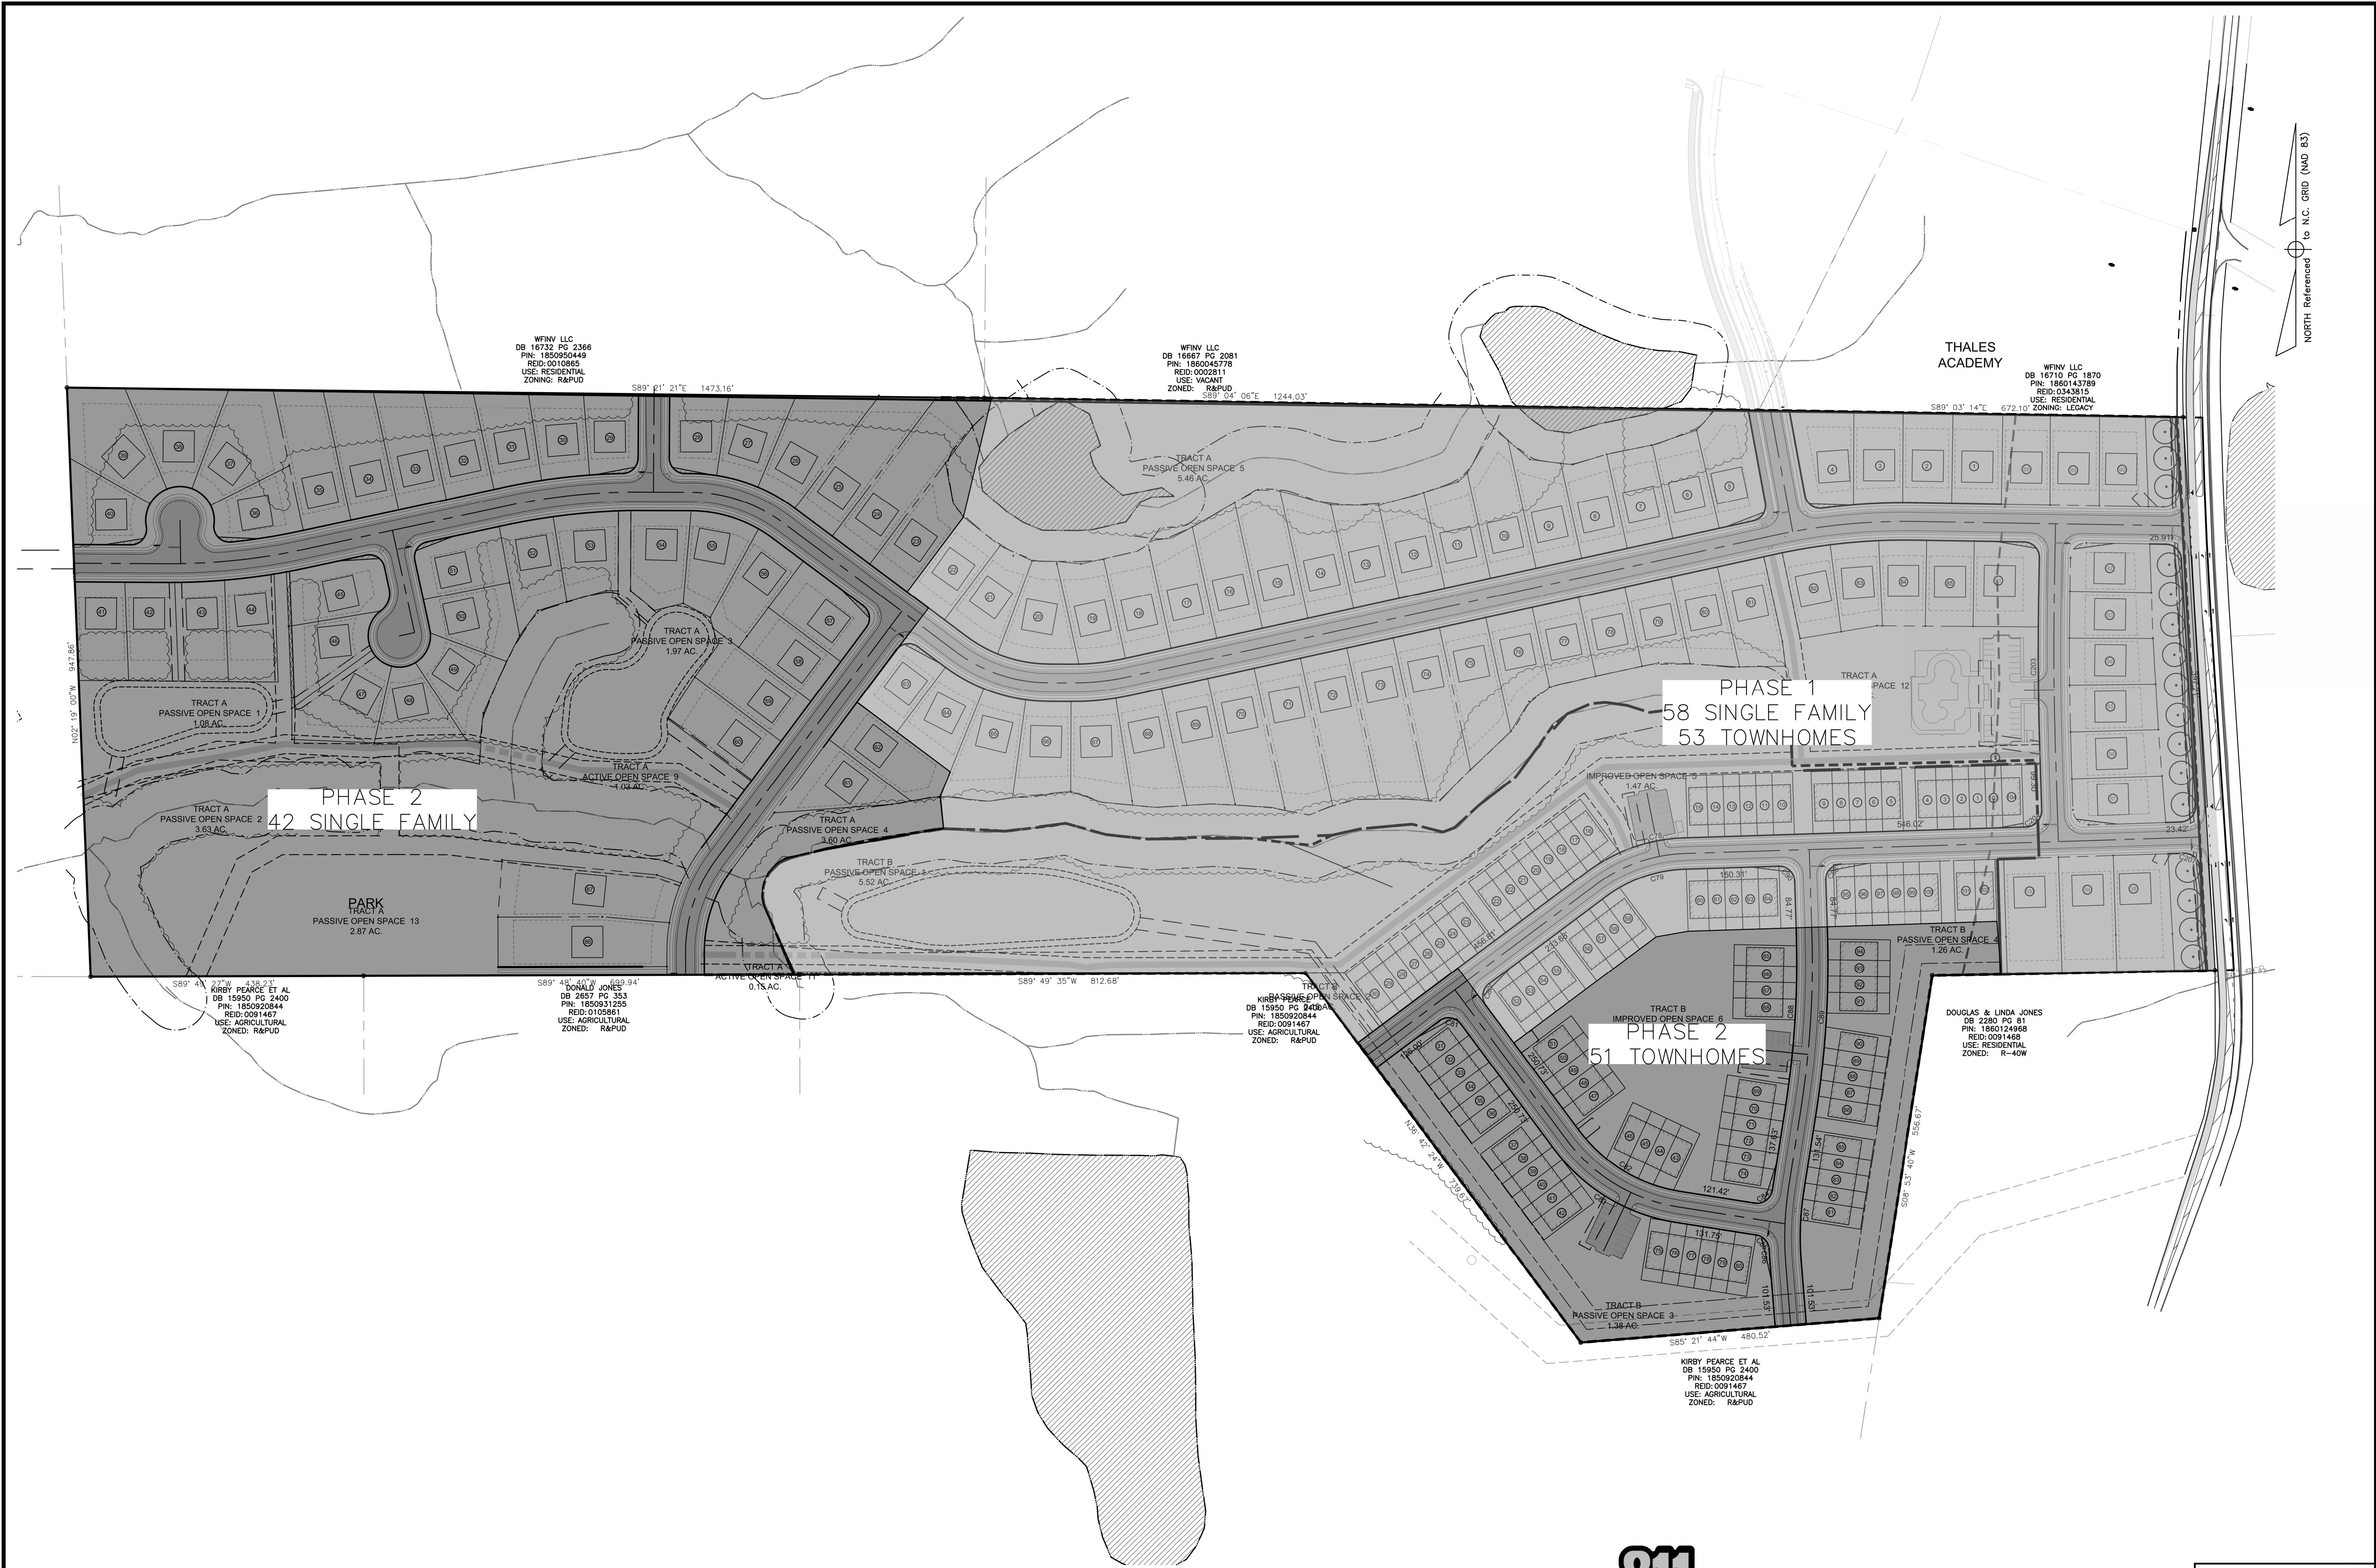

REV NO	DESCRIPTIONS	REVISIONS
2	REMOVE SWEETLEAF	07/31/2019
1	REVISED PER TOR COMMENTS	12/07/2018



Bateman Civil Survey Company
Engineers • Surveyors • Planners
2524 Reliance Avenue, Apex, North Carolina 27539
Phone: 919.577.1080 Fax: 919.577.1081
NCBELS FIRM No. C-2376

ELIZABETH HEIGHTS
CONSTRUCTION DRAWINGS
1205 AVERETTE ROAD
WAKE FOREST, NC 27587
WAKE COUNTY, NC

PHASING MAP



Project Engineer:	TSS
Designed By:	RAJ
Drawn By:	RAJ
Checked By:	TSS
Scale:	NTS

Date:	07/31/2019
Project Number:	.170348

SHEET
C304

ELIZABETH HEIGHTS-----

REV NO.	DESCRIPTIONS	REVISIONS
2	REMOVE SWEETLEAF	07/31/2019
1	REVISED PER TOR COMMENTS	12/07/2018

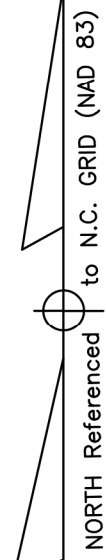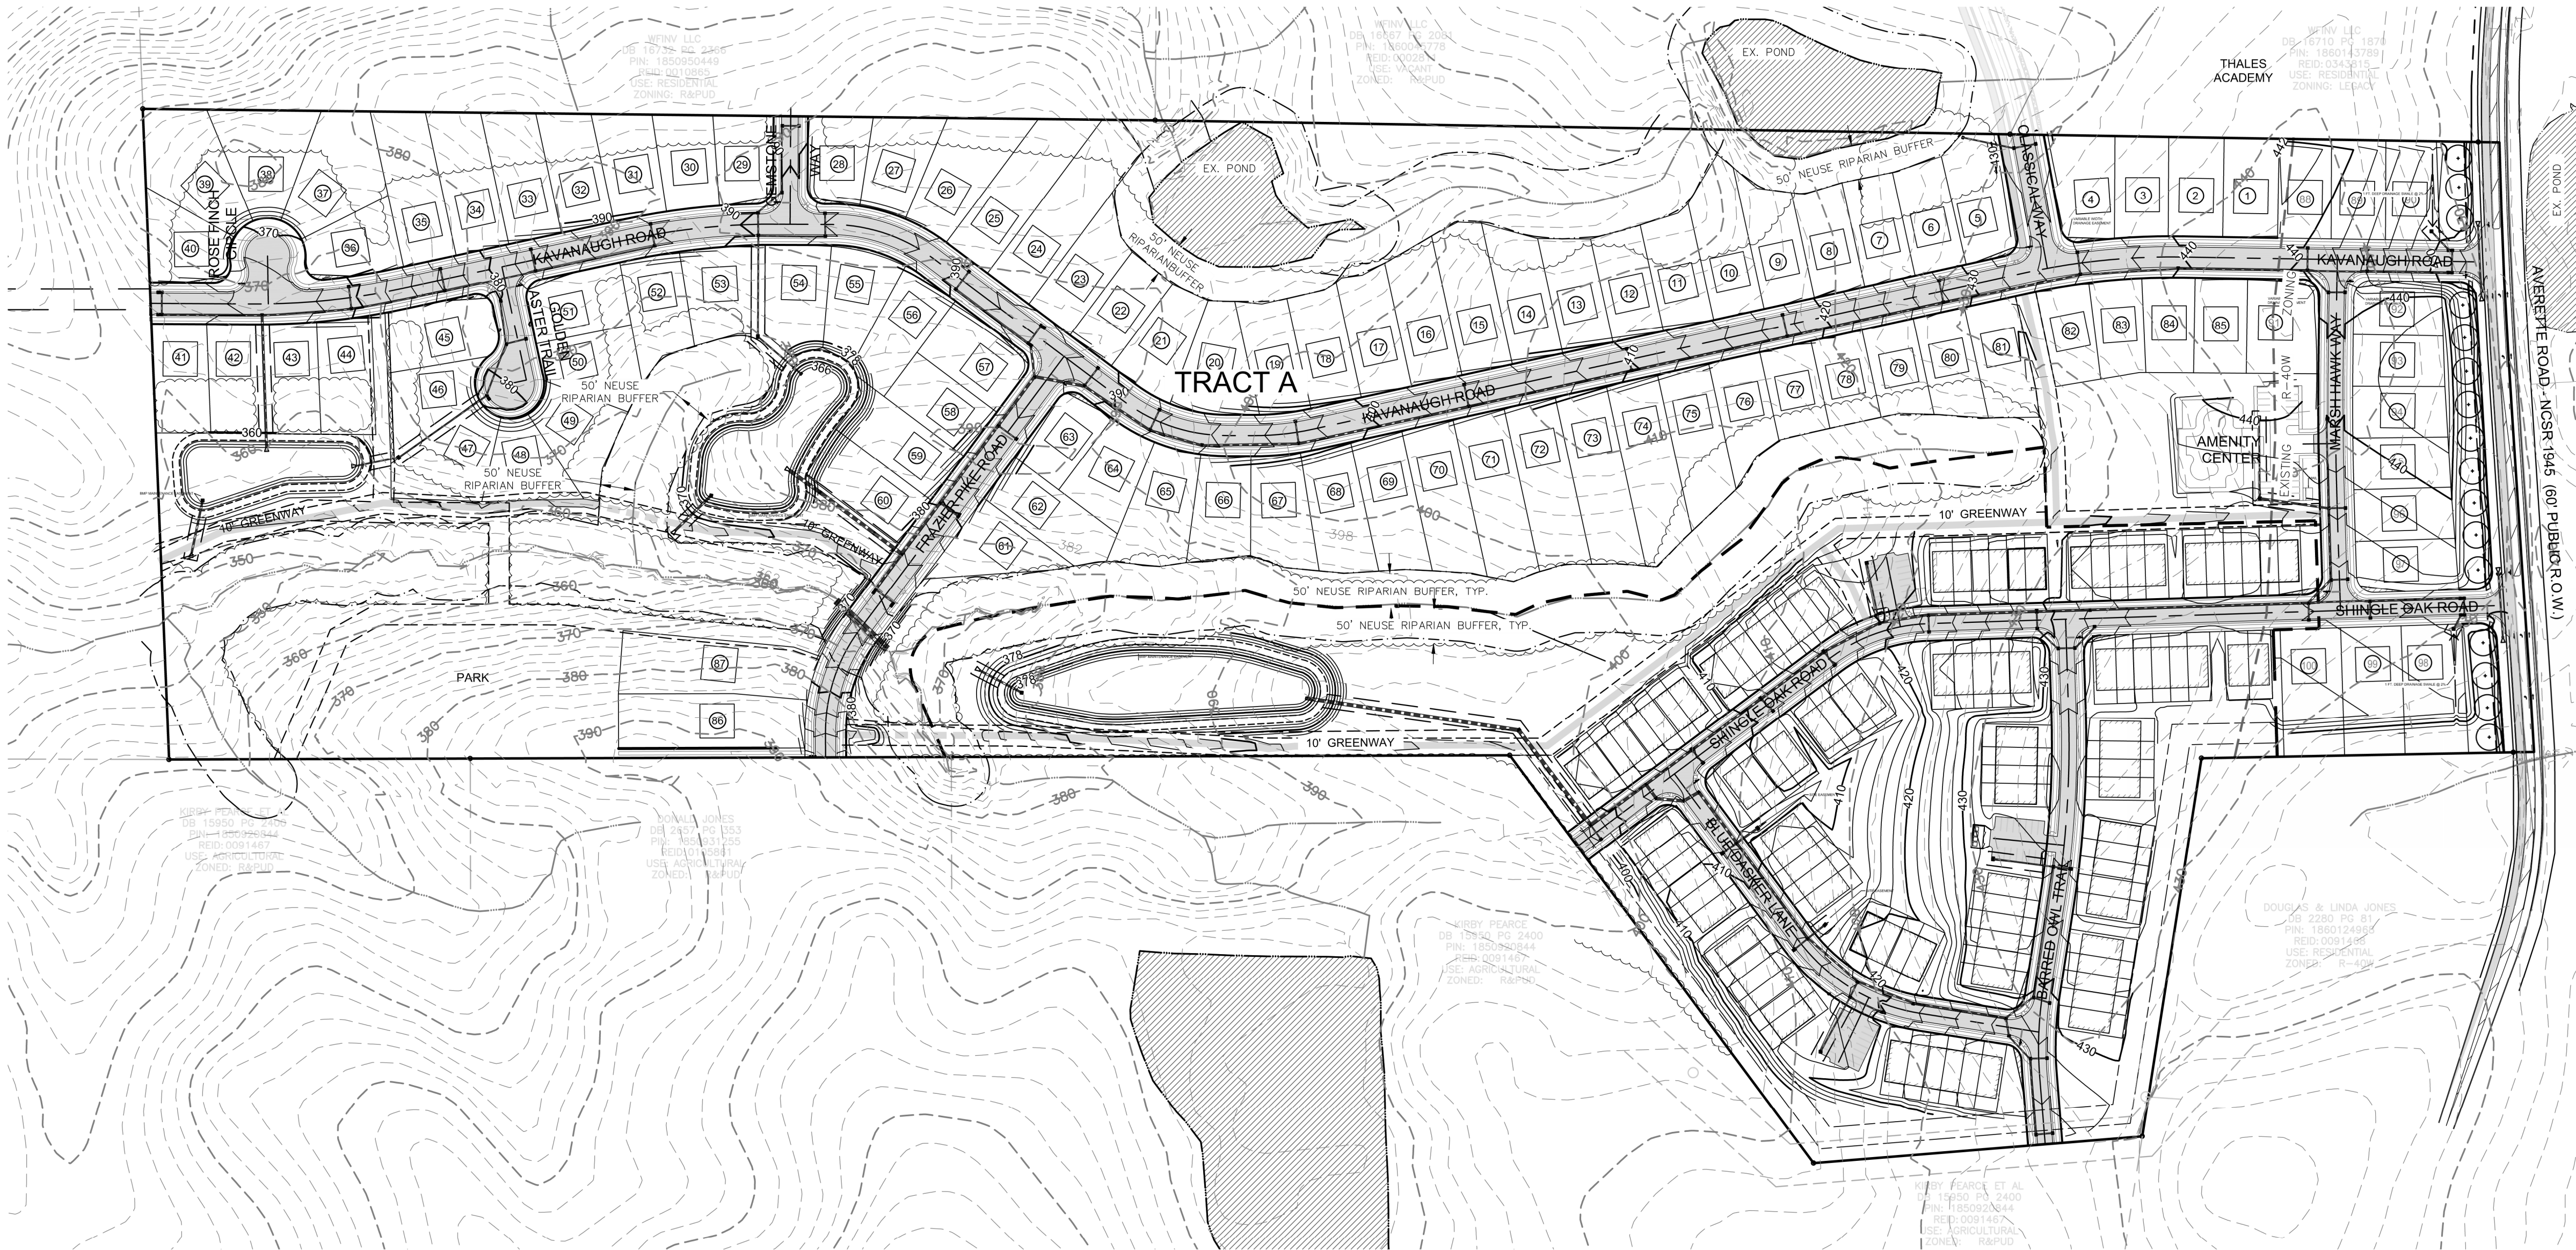

LEGEND:

- EXISTING MAJOR CONTOUR
- EXISTING MINOR CONTOUR
- PROPOSED MAJOR CONTOUR
- PROPOSED MINOR CONTOUR

ELIZABETH HEIGHTS
CONSTRUCTION DRAWINGS

OVERALL GRADING PLAN

Project Engineer:	TSS
Designed By:	LEG
Drawn By:	LEG
Checked By:	TSS
Scale:	1"=150'

Date: 07/31/2019

Project Number: 170348


SHEET
C310



Bateman Civil Survey Company
Engineers • Surveyors • Planners
2524 Reliance Avenue, Apex, North Carolina 27539
Phone: 919.577.1080 Fax: 919.577.1081
NCBELS FRM No. C-2376



MATCHLINE SEE SHEET C313

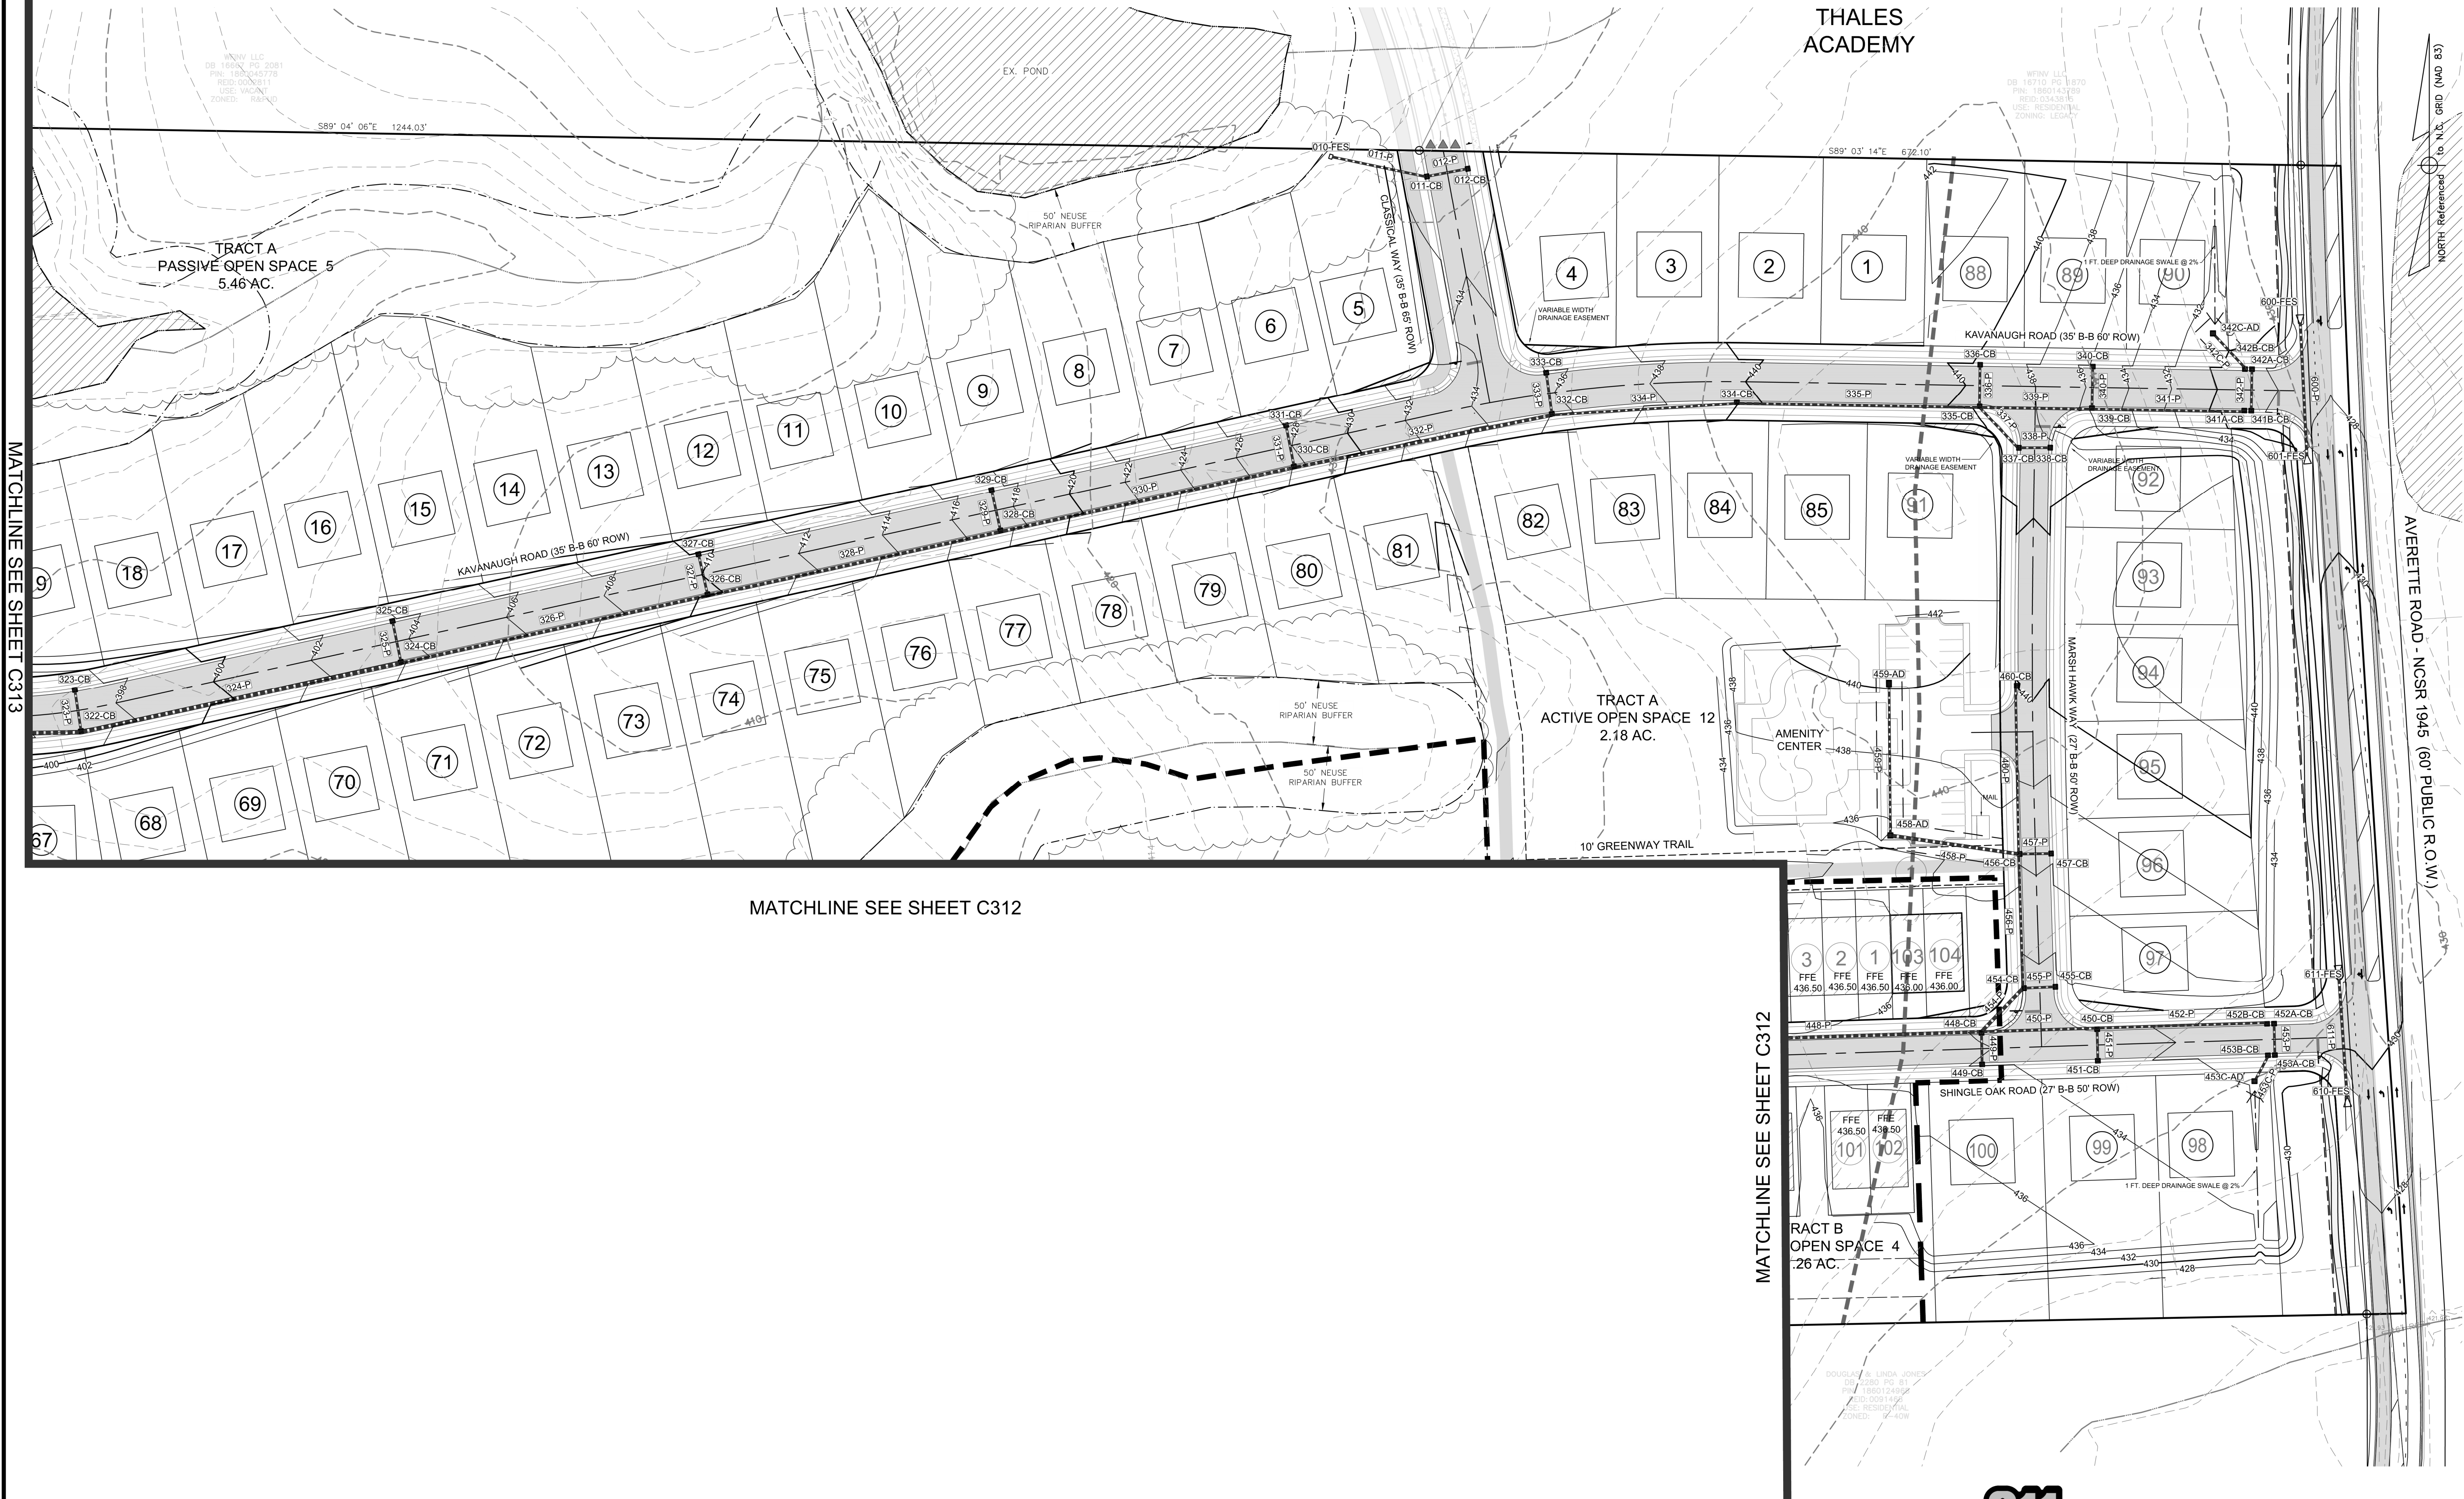

MATCHLINE SEE SHEET C312

MATCHLINE SEE SHEET C312



KNOW WHAT IS BELOW
CALL BEFORE YOU DIG



REV. NO.	DESCRIPTIONS	REVISIONS
2	REMOVE SWEETLEAF	07/31/2019
1	REVISED PER TOR COMMENTS	12/07/2018

ELIZABETH HEIGHTS
CONSTRUCTION DRAWINGS

GRADING PLAN

Project Engineer:	TSS
Designed By:	LEG
Drawn By:	LEG
Checked By:	TSS
Scale:	1"=60'

Date: 07/31/2019

Project Number: 170348

SHEET
C311



Bateman Civil Survey Company
Engineers • Surveyors • Planners
2524 Reliance Avenue, Apex, North Carolina 27539
Phone: 919.577.1080 Fax: 919.577.1081
NCBLS FIRM No. C-2376



STORM STRUCTURE TABLE				
STRUCTURE	RIM EL.	STRUCTURE IN	INVERT 1N	INVERT OUT
411-AD-A	407.90	411-AD-B	402.92	402.72
411-AD-B	414.00			404.60
414-AD-A	413.80			408.70
420-AD-A	419.98			416.53

STORM SYSTEM DATA					
DOWNSTREAM STRUCTURE	UPSTREAM STRUCTURE	SIZE	LENGTH	SLOPE	MATERIAL
420-AD-A	420-AD	15	21.96	0.50%	Reinforced Concrete Pipe
414-AD-A	414-AD	18	86.47	1.03%	Reinforced Concrete Pipe
411-AD-B	411-AD-A	24	152.73	1.10%	Reinforced Concrete Pipe
411-AD-A	411-AD	24	110.32	1.00%	Reinforced Concrete Pipe


NOTE: CATCH BASINS LABELED WITH AN ASTERISK ARE TO BE ROLLOVER GRATES.

- LEGEND:**
- OHE — EXISTING OVERHEAD ELECTRIC LINE
 - EXISTING ELECTRIC POLE
 - X — EXISTING FENCE
 - 300 — EXISTING MAJOR CONTOURS
 - 302 — EXISTING MINOR CONTOURS
 - — EXISTING RIPARIAN BUFFER
 - — EXISTING STREAM
 - — EXISTING TREES
 - — EXISTING WETLAND
 - — PROPOSED CATCH BASIN
 - — PROPOSED FLARED END SECTION
 - 300 — PROPOSED MAJOR CONTOURS
 - 302 — PROPOSED MINOR CONTOURS
 - — PROPOSED RIP RAP
 - — PROPOSED STORM MANHOLE
 - — PROPOSED STORM PIPE
 - — PROPOSED YARD INLET
 - — PROPOSED JUNCTION BOX

SYMBOL LEGEND


- ▲▲ END OF STREET SIGNAGE
- STOP SIGN AND STREET NAME SIGN LOCATION
- ACCESSIBILITY RAMP
- + LARGE STREET TREE, TYP
- 2" CALIPER MIN

- FLOOD PRONE SOILS (GIS)
- EX. R-40W ZONING (SEE NOTE 6 ON SHEET C300 OF FULLY APPROVED ELIZABETH HEIGHTS CONST. DRAWINGS SP-19-01)
- PHASE LINE
- TRACT LINE

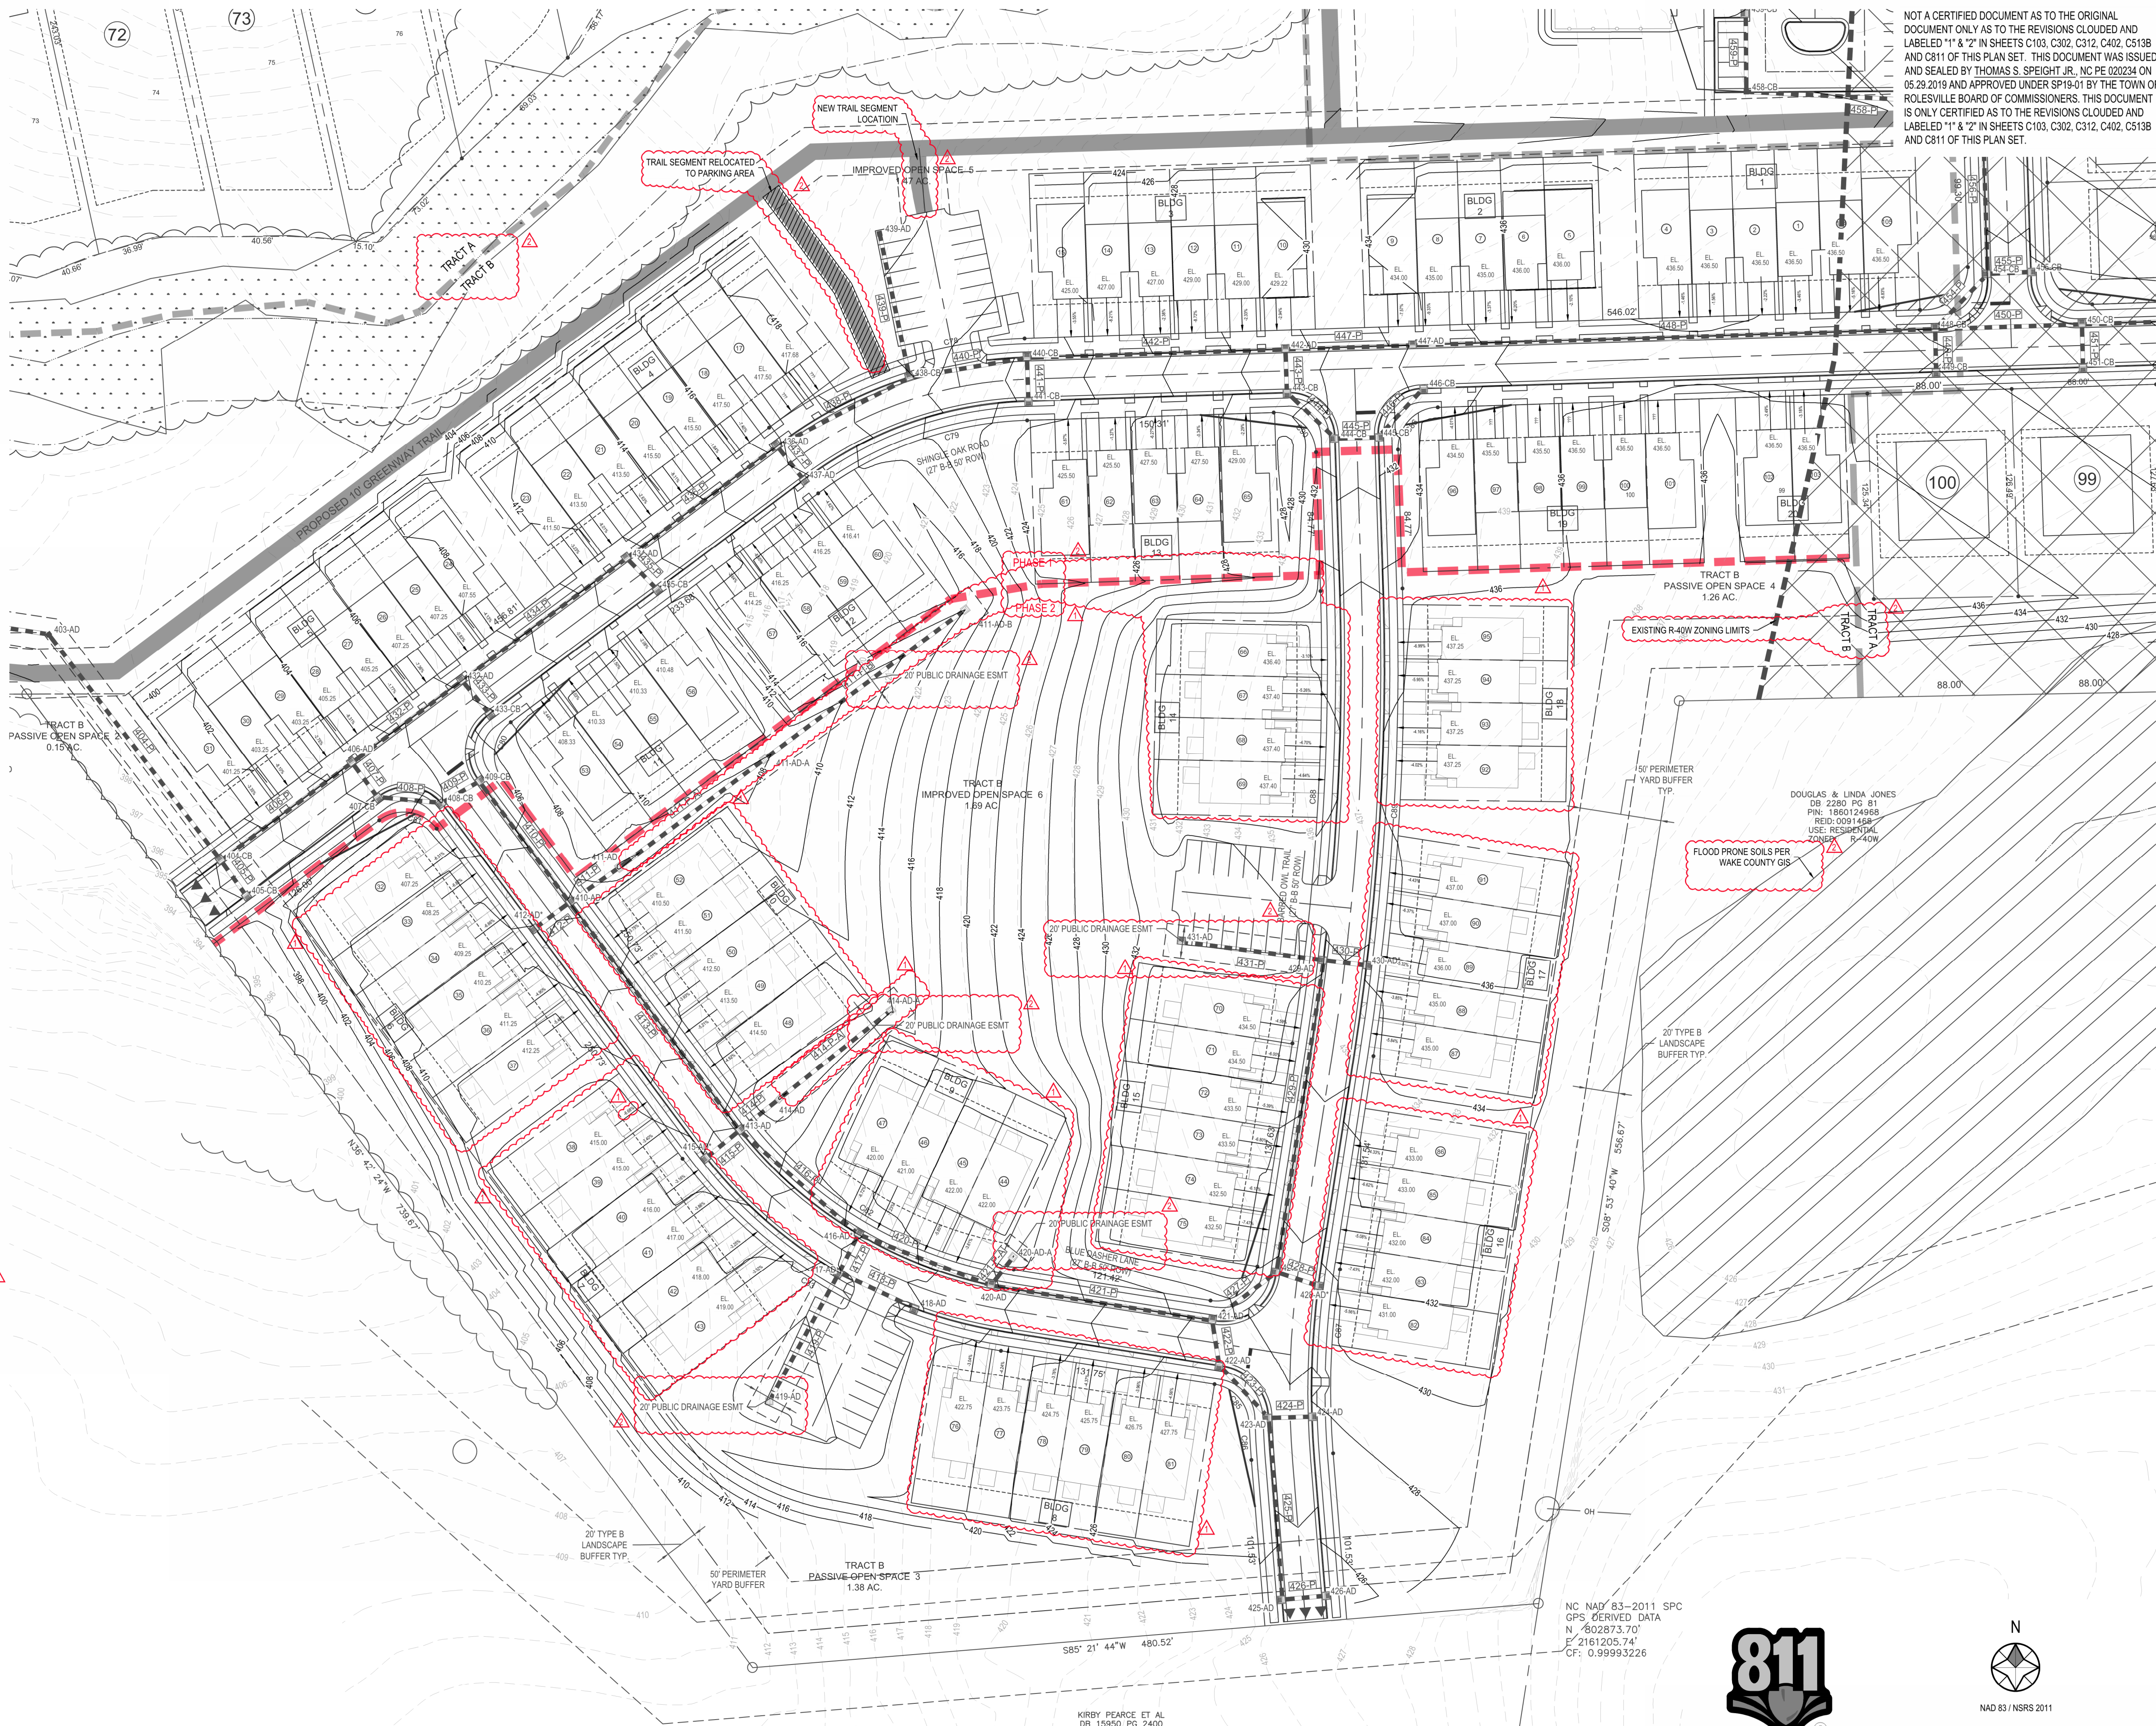

NOT A CERTIFIED DOCUMENT AS TO THE ORIGINAL DOCUMENT ONLY AS TO THE REVISIONS CLOUDED AND LABELED "1" & "2" IN SHEETS C103, C302, C312, C402, C513B AND C811 OF THIS PLAN SET. THIS DOCUMENT WAS ISSUED AND SEALED BY THOMAS S. SPEIGHT JR., NC PE 020234 ON 05.29.2019 AND APPROVED UNDER SP19-01 BY THE TOWN OF ROLESVILLE BOARD OF COMMISSIONERS. THIS DOCUMENT IS ONLY CERTIFIED AS TO THE REVISIONS CLOUDED AND LABELED "1" & "2" IN SHEETS C103, C302, C312, C402, C513B AND C811 OF THIS PLAN SET.

FINAL DRAWING
FOR REVIEW ONLY

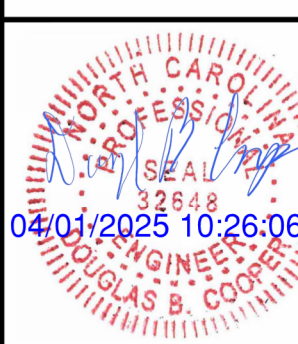

Douglas B. Cooper
Professional Engineer
State of North Carolina
License No. 32618
04/01/2025 10:26:06 AM

Bateman Civil Survey Company
Engineers • Surveyors • Planners
2524 Raliance Avenue, Apex, North Carolina 27539
Phone: 919.577.1080 Fax: 919.577.1081
NCBELS FIRM No. C-2376




ELIZABETH HEIGHTS
PHASE 2 REVISIONS
1205 AVRETT ROAD
WAKE FOREST, NC 27887
WAKE COUNTY

GRADING PLAN CONT.

Design By: BCSC
Date: 24.11.13
Project #: P170348

SHEET
C312

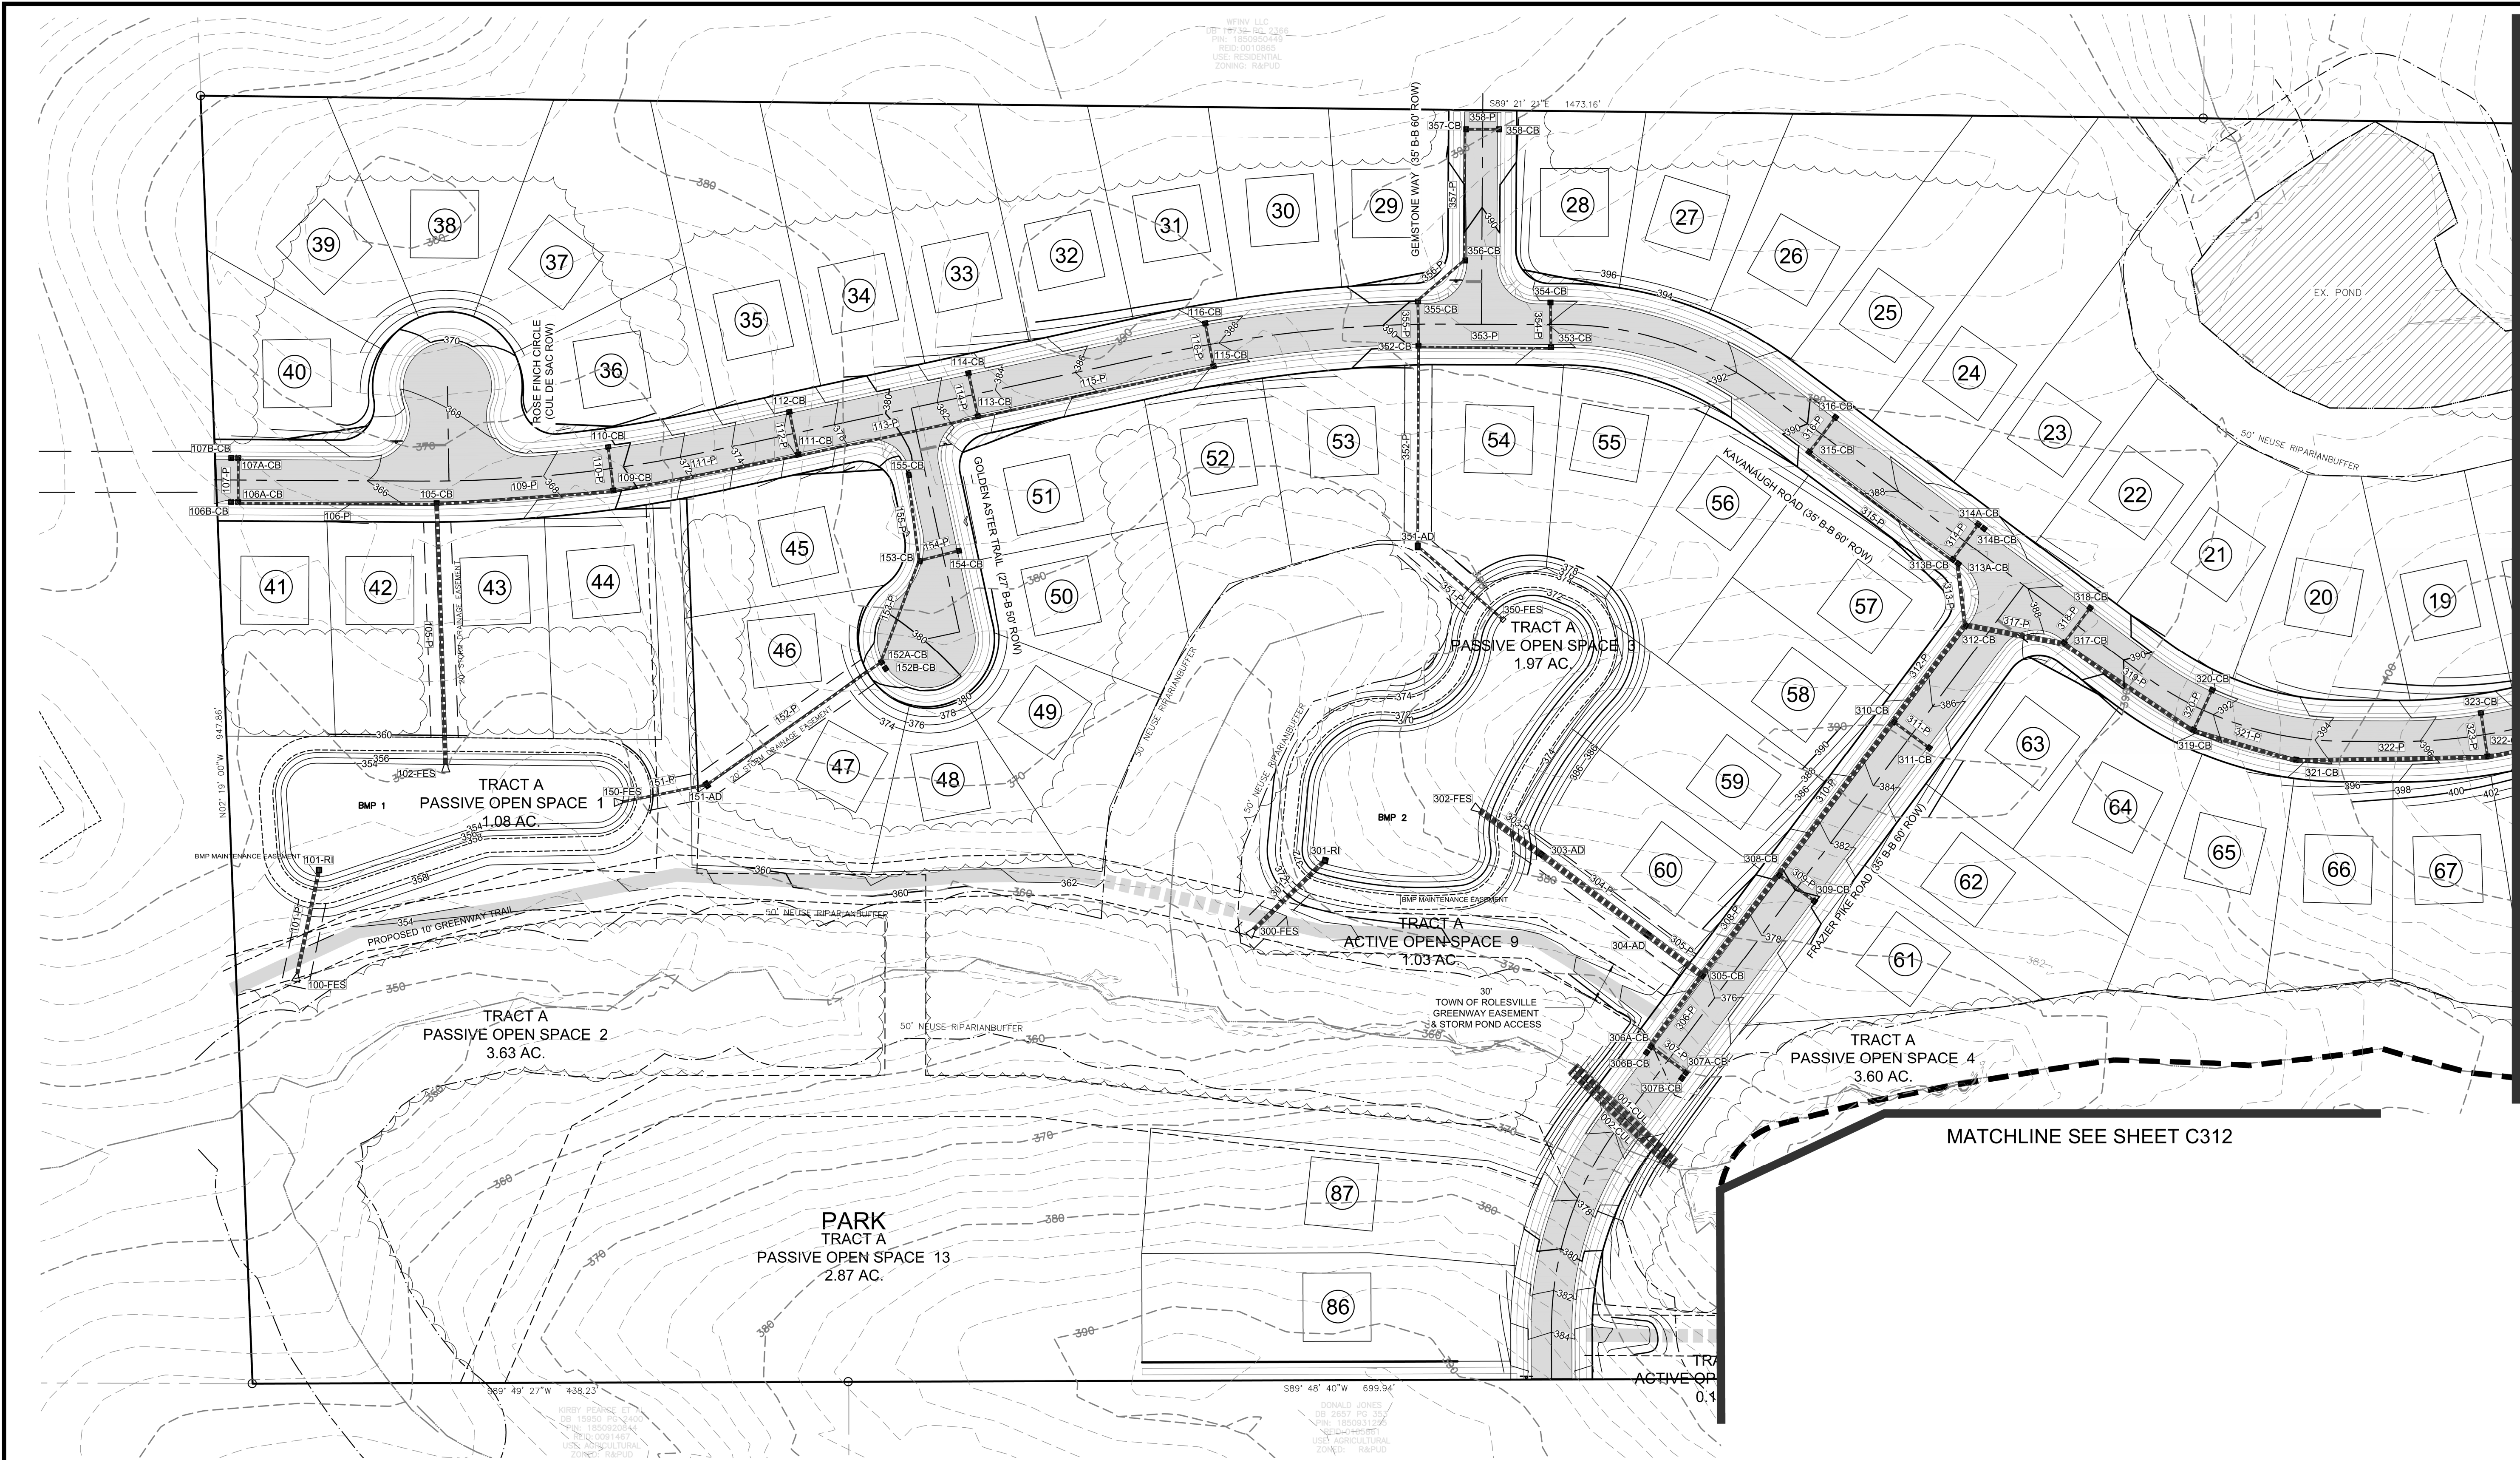


REV. NO.	DESCRIPTIONS	REVISIONS
2	REMOVE SWEETLEAF	07/31/2019
1	REVISED PER TOR COMMENTS	12/07/2018



MATCHLINE SEE SHEET C311

MATCHLINE SEE SHEET C312

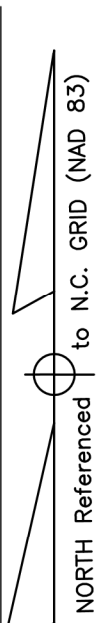

ELIZABETH HEIGHTS
CONSTRUCTION DRAWINGS

GRADING PLAN

Project Engineer:	TSS
Designed By:	LEG
Drawn By:	LEG
Checked By:	TSS
Scale:	1"=60'

Date: 07/31/2019

Project Number: 170348

SHEET
C313



Bateman Civil Survey Company
Engineers • Surveyors • Planners
2524 Reliance Avenue, Apex, North Carolina 27539
Phone: 919.577.1080 Fax: 919.577.1081
NCBELS FRM No. C-2376



STRUCTURE TABLE			
NAME	RIM	PIPES IN	PIPES OUT
010-FES	RIM = 428.22 SUMP = 425.28	011-P - 15" RCP - INV IN = 425.28	
011-CB	RIM = 433.13 SUMP = 426.03	012-P - 15" RCP - INV IN = 429.48	011-P - 15" RCP - INV OUT = 426.03
012-CB	RIM = 433.13 SUMP = 429.82		012-P - 15" RCP - INV OUT = 429.82
100-FES	RIM = 354.33 SUMP = ???	101-P - 24" RCP - INV IN = 352.00	
101-RI	RIM = 357.00 SUMP = 352.77		101-P - 24" RCP - INV OUT = 352.77
102-FES	RIM = 357.46 SUMP = ???	105-P - 30" RCP - INV IN = 354.00	
105-CB	RIM = 366.31 SUMP = 356.28	109-P - 18" RCP - INV IN = 361.09 106-P - 18" RCP - INV IN = 357.00	105-P - 30" RCP - INV OUT = 356.28
106A-CB	RIM = 364.46 SUMP = 359.58	107-P - 15" RCP - INV IN = 359.78	106-P - 18" RCP - INV OUT = 359.58
106B-CB	RIM = 364.39 SUMP = 359.58		
107A-CB	RIM = 364.45 SUMP = 360.12		107-P - 15" RCP - INV OUT = 360.12
107B-CB	RIM = 364.39 SUMP = 360.12		
109-CB	RIM = 369.28 SUMP = 365.30	110-P - 15" RCP - INV IN = 364.96 111-P - 15" RCP - INV IN = 364.80	109-P - 18" RCP - INV OUT = 364.60
110-CB	RIM = 369.29 SUMP = 365.30		110-P - 15" RCP - INV OUT = 365.30
111-CB	RIM = 376.08 SUMP = 371.55	113-P - 15" RCP - INV IN = 372.07 112-P - 15" RCP - INV IN = 371.75	111-P - 15" RCP - INV OUT = 371.55
112-CB	RIM = 376.09 SUMP = 372.09		112-P - 15" RCP - INV OUT = 372.09
113-CB	RIM = 382.96 SUMP = 378.41	114-P - 15" RCP - INV IN = 378.61 115-P - 15" RCP - INV IN = 378.94	113-P - 15" RCP - INV OUT = 378.41
114-CB	RIM = 382.95 SUMP = 378.95		114-P - 15" RCP - INV OUT = 378.95

STRUCTURE TABLE			
NAME	RIM	PIPES IN	PIPES OUT
115-CB	RIM = 387.55 SUMP = 383.01	116-P - 15" RCP - INV IN = 383.21	115-P - 15" RCP - INV OUT = 383.01
116-CB	RIM = 387.54 SUMP = 383.55		116-P - 15" RCP - INV OUT = 383.55
150-FES	RIM = 354.52 SUMP = ???	151-P - 15" RCP - INV IN = 354.00	
151-AD	RIM = 366.49 SUMP = 358.03	152-P - 15" RCP - INV IN = 358.23	151-P - 15" RCP - INV OUT = 358.03
152A-CB	RIM = 379.19 SUMP = 374.98	153-P - 15" RCP - INV IN = 375.18	152-P - 15" RCP - INV OUT = 374.98
152B-CB	RIM = 379.75 SUMP = 374.98		
153-CB	RIM = 380.91 SUMP = 376.63	155-P - 15" RCP - INV IN = 376.83 154-P - 15" RCP - INV IN = 376.83	153-P - 15" RCP - INV OUT = 376.63
154-CB	RIM = 381.14 SUMP = 377.14		154-P - 15" RCP - INV OUT = 377.14
155-CB	RIM = 380.40 SUMP = 377.46		155-P - 15" RCP - INV OUT = 377.46
300-FES	RIM = 368.38 SUMP = ???	301-P - 30" RCP - INV IN = 364.00	
301-RI	RIM = 371.00 SUMP = 364.73		301-P - 30" RCP - INV OUT = 364.73
302-FES	RIM = 370.50 SUMP = ???	303-P - 48" RCP - INV IN = 366.00	
303-AD	RIM = 382.45 SUMP = 367.55	304-P - 48" RCP - INV IN = 367.75	303-P - 48" RCP - INV OUT = 367.55
304-AD	RIM = 378.06 SUMP = 368.85	305-P - 48" RCP - INV IN = 369.05	304-P - 48" RCP - INV OUT = 368.85
305-CB	RIM = 376.36 SUMP = 369.55	308-P - 36" RCP - INV IN = 369.75 306-P - 30" RCP - INV IN = 369.75	305-P - 48" RCP - INV OUT = 369.55
306A-CB	RIM = 374.93 SUMP = 370.39	307-P - 18" RCP - INV IN = 370.59	306-P - 30" RCP - INV OUT = 370.39
306B-CB	RIM = 374.93 SUMP = 370.39		

STRUCTURE TABLE			
NAME	RIM	PIPES IN	PIPES OUT
307A-CB	RIM = 374.93 SUMP = 370.93		307-P - 18" RCP - INV OUT = 370.93
307B-CB	RIM = 374.93 SUMP = 370.93		
308-CB	RIM = 379.75 SUMP = 374.50	310-P - 36" RCP - INV IN = 374.70 309-P - 18" RCP - INV IN = 374.70	308-P - 36" RCP - INV OUT = 374.50
309-CB	RIM = 379.76 SUMP = 375.76		309-P - 18" RCP - INV OUT = 375.76
310-CB	RIM = 385.04 SUMP = 380.21	311-P - 15" RCP - INV IN = 380.72 312-P - 36" RCP - INV IN = 380.41	310-P - 36" RCP - INV OUT = 380.21
311-CB	RIM = 385.05 SUMP = 381.06		311-P - 15" RCP - INV OUT = 381.06
312-CB	RIM = 386.71 SUMP = 381.29	317-P - 36" RCP - INV IN = 381.49 313-P - 24" RCP - INV IN = 381.50	312-P - 36" RCP - INV OUT = 381.29
313A-CB	RIM = 387.22 SUMP = 382.48		313-P - 24" RCP - INV OUT = 382.48
313B-CB	RIM = 387.22 SUMP = 382.48	315-P - 15" RCP - INV IN = 382.68 314-P - 15" RCP - INV IN = 382.90	
314A-CB	RIM = 387.24 SUMP = 383.24		314-P - 15" RCP - INV OUT = 383.24
314B-CB	RIM = 387.24 SUMP = 383.24		
315-CB	RIM = 389.24 SUMP = 384.70	316-P - 15" RCP - INV IN = 384.90	315-P - 15" RCP - INV OUT = 384.70
316-CB	RIM = 389.24 SUMP = 385.24		316-P - 15" RCP - INV OUT = 385.24
317-CB	RIM = 388.51 SUMP = 383.49	319-P - 30" RCP - INV IN = 383.69 318-P - 15" RCP - INV IN = 384.23	317-P - 36" RCP - INV OUT = 383.49
318-CB	RIM = 388.56 SUMP = 384.57		318-P - 15" RCP - INV OUT = 384.57
319-CB	RIM = 391.44 SUMP = 386.42	321-P - 30" RCP - INV IN = 386.62 320-P - 15" RCP - INV IN = 387.11	319-P - 30" RCP - INV OUT = 386.42
320-CB	RIM = 391.45 SUMP = 387.45		320-P - 15" RCP - INV OUT = 387.45

STRUCTURE TABLE			
NAME	RIM	PIPES IN	PIPES OUT
321-CB	RIM = 393.36 SUMP = 388.34	322-P - 30" RCP - INV IN = 388.54	321-P - 30" RCP - INV OUT = 388.34
322-CB	RIM = 396.88 SUMP = 391.86	324-P - 30" RCP - INV IN = 392.06 323-P - 15" RCP - INV IN = 392.55	322-P - 30" RCP - INV OUT = 391.86
323-CB	RIM = 396.89 SUMP = 392.89		323-P - 15" RCP - INV OUT = 392.89
324-CB	RIM = 403.41 SUMP = 398.39	326-P - 24" RCP - INV IN = 398.59 325-P - 15" RCP - INV IN = 399.08	324-P - 30" RCP - INV OUT = 398.39
325-CB	RIM = 403.42 SUMP = 399.42		325-P - 15" RCP - INV OUT = 399.42
326-CB	RIM = 409.69 SUMP = 404.19	327-P - 15" RCP - INV IN = 405.35 328-P - 24" RCP - INV IN = 404.39	326-P - 24" RCP - INV OUT = 404.19
327-CB	RIM = 409.68 SUMP = 405.69		327-P - 15" RCP - INV OUT = 405.69
328-CB	RIM = 417.07 SUMP = 412.53	329-P - 15" RCP - INV IN = 412.73 330-P - 24" RCP - INV IN = 413.06	328-P - 24" RCP - INV OUT = 412.53
329-CB	RIM = 417.07 SUMP = 413.07		329-P - 15" RCP - INV OUT = 413.07
330-CB	RIM = 427.58 SUMP = 416.20	331-P - 15" RCP - INV IN = 423.27 332-P - 24" RCP - INV IN = 416.40	330-P - 24" RCP - INV OUT = 416.20
331-CB	RIM = 427.61 SUMP = 423.61		331-P - 15" RCP - INV OUT = 423.61
332-CB	RIM = 435.54 SUMP = 418.43	333-P - 15" RCP - INV IN = 429.10 334-P - 15" RCP - INV IN = 418.63	332-P - 24" RCP - INV OUT = 418.43
333-CB	RIM = 435.53 SUMP = 431.52		333-P - 15" RCP - INV OUT = 431.52
334-CB	RIM = 439.48 SUMP = 420.06	335-P - 18" RCP - INV IN = 420.26	334-P - 15" RCP - INV OUT = 420.06
335-CB	RIM = 439.33 SUMP = 422.14	338-P - 18" RCP - INV IN = 422.34 336-P - 15" RCP - INV IN = 434.99 337-P - 15" RCP - INV IN = 433.43	335-P - 18" RCP - INV OUT = 422.14
336-CB	RIM = 439.32 SUMP = 435.33		336-P - 15" RCP - INV OUT = 435.33
337-CB	RIM = 438.83 SUMP = 433.86	338-P - 15" RCP - INV IN = 434.06	337-P - 15" RCP - INV OUT = 433.86

STRUCTURE TABLE			
NAME	RIM	PIPES IN	PIPES OUT
338-CB	RIM = 438.32 SUMP = 434.32		338-P - 15" RCP - INV OUT = 434.32
339-CB	RIM = 438.38 SUMP = 423.21	341-P - 18" RCP - INV IN = 423.41 340-P - 15" RCP - INV IN = 431.04	339-P - 18" RCP - INV OUT = 423.21
340-CB	RIM = 438.38 SUMP = 431.38		340-P - 15" RCP - INV OUT = 431.38
341A-CB	RIM = 428.67 SUMP = 424.59		341-P - 18" RCP - INV OUT = 424.59
341B-CB	RIM = 428.67 SUMP = 424.59	342-P - 15" RCP - INV IN = 424.59	
342A-CB	RIM = 428.92 SUMP = 424.93		342-P - 15" RCP - INV OUT = 424.93
342B-CB	RIM = 428.92 SUMP = 425.99	342C-P - 15" RCP - INV IN = 425.99	
342C-AD	RIM = 430.34 SUMP = 424.35		342C-P - 15" RCP - INV OUT = 426.35
350-FES	RIM = 368.94 SUMP = 366.00	351-P - 15" RCP - INV IN = 366.00	
351-AD	RIM = 379.53 SUMP = 374.00	352-P - 15" RCP - INV IN = 374.00	351-P - 15" RCP - INV OUT = 374.00
352-CB	RIM = 390.09 SUMP = 382.12	353-P - 15" RCP - INV IN = 386.09 355-P - 15" RCP - INV IN = 382.32	352-P - 15" RCP - INV OUT = 382.12
353-CB	RIM = 392.20 SUMP = 387.14	354-P - 15" RCP - INV IN = 387.34	353-P - 15" RCP - INV OUT = 387.14
354-CB	RIM = 391.69 SUMP = 387.69		354-P - 15" RCP - INV OUT = 387.69
355-CB	RIM = 390.49 SUMP = 388.66	356-P - 15" RCP - INV IN = 382.86	355-P - 15" RCP - INV OUT = 382.66
356-CB	RIM = 390.16 SUMP = 383.31	357-P - 15" RCP - INV IN = 383.51	356-P - 15" RCP - INV OUT = 383.31
357-CB	RIM = 388.94 SUMP = 384.48	358-P - 15" RCP - INV IN = 384.68	357-P - 15" RCP - INV OUT = 384.48
358-CB	RIM = 388.93 SUMP = 384.94		358-P - 15" RCP - INV OUT = 384.94

STRUCTURE TABLE			
NAME	RIM	PIPES IN	PIPES OUT
400-FES	RIM = 379.33 SUMP = ???	401-P - 24" RCP - INV IN = 373.22	
401-RI	RIM = 382.00 SUMP = 373.91		401-P - 24" RCP - INV OUT = 373.91
402-FES	RIM = 380.50 SUMP = ???	403-P - 48" RCP - INV IN = 376.00	
403-AD	RIM = 398.00 SUMP = 389.47	404-P - 48" RCP - INV IN = 389.67	403-P - 48" RCP - INV OUT = 389.47
404-CB	RIM = 398.67 SUMP = 391.40	406-P - 36" RCP - INV IN = 392.40 405-P - 15" RCP - INV IN = 393.60	404-P - 48" RCP - INV OUT = 391.40
405-CB	RIM = 398.14 SUMP = 393.87		405-P - 15" RCP - INV OUT = 393.87
406-CB	RIM = 402.33 SUMP = 397.46	432-P - 30" RCP - INV IN = 398.04 407-P - 36" RCP - INV IN = 397.66	406-P - 36" RCP - INV OUT = 397.46
407-CB	RIM = 402.96 SUMP = 397.92	408-P - 36" RCP - INV IN = 398.12	407-P - 36" RCP - INV OUT = 397.92
408-CB	RIM = 404.10 SUMP = 399.27	409-P - 36" RCP - INV IN = 399.47	408-P - 36" RCP - INV OUT = 399.27
409-CB	RIM = 404.76 SUMP = 399.73	410-P - 36" RCP - INV IN = 399.93	409-P - 36" RCP - INV OUT = 399.73
410-CB	RIM = 407.58 SUMP = 400.85	411-P - 24" RCP - INV IN = 401.05 413-P - 24" RCP - INV IN = 402.81 412-P - 15" RCP - INV IN = 404.06	410-P - 36" RCP - INV OUT = 400.85
411-AD	RIM = 405.69 SUMP = 401.42		411-P - 24" RCP - INV OUT = 401.42
412-AD	RIM = 407.60 SUMP = 404.32		412-P - 15" RCP - INV OUT = 404.32
413-CB	RIM = 414.09 SUMP = 407.10	416-P - 24" RCP - INV IN = 408.99 415-P - 15" RCP - INV IN = 410.35 414-P - 18" RCP - INV IN = 407.30	413-P - 24" RCP - INV OUT = 407.10
414-AD	RIM = 411.88 SUMP = 407.61		414-P - 18" RCP - INV OUT = 407.61
415-AD	RIM = 414.11 SUMP = 410.61		415-P - 15" RCP - INV OUT = 410.61
416-CB	RIM = 417.90 SUMP = 411.45	417-P - 15" RCP - INV IN = 411.65 420-P - 24" RCP - INV IN = 413.03	416-P - 24" RCP - INV OUT = 411.45

STRUCTURE TABLE			
NAME	RIM	PIPES IN	PIPES OUT
417-CB	RIM = 417.96 SUMP = 411.91	419-P - 15" RCP - INV IN = 412.11 418-P - 15" RCP - INV IN = 414.30	417-P - 15" RCP - INV OUT = 411.91
418-CB	RIM = 419.79 SUMP = 416.08		418-P - 15" RCP - INV OUT = 416.08
419-AD	RIM = 417.00 SUMP = 413.00		419-P - 15" RCP - INV OUT = 413.00
420-CB	RIM = 421.32 SUMP = 416.22	421-P - 24" RCP - INV IN = 416.42	420-P - 24" RCP - INV OUT = 416.22
421-CB	RIM = 426.59 SUMP = 417.81	427-P - 18" RCP - INV IN = 422.59 422-P - 18" RCP - INV IN = 418.01	421-P - 24" RCP - INV OUT = 417.81
422-CB	RIM = 426.73 SUMP = 418.28	423-P - 15" RCP - INV IN = 418.48	422-P - 18" RCP - INV OUT = 418.28
423-CB	RIM = 427.21 SUMP = 418.98	425-P - 15" RCP - INV IN = 419.18 424-P - 15" RCP - INV IN = 423.03	423-P - 15" RCP - INV OUT = 418.98
424-CB	RIM = 427.28 SUMP = 423.29		424-P - 15" RCP - INV OUT = 423.29
425-CB	RIM = 424.74 SUMP = 420.29	426-P - 15" RCP - INV IN = 420.49	425-P - 15" RCP - INV OUT = 420.29
426-CB	RIM = 424.75 SUMP = 420.75		426-P - 15" RCP - INV OUT = 420.75
427-CB	RIM = 429.25 SUMP = 424.83	428-P - 15" RCP - INV IN = 425.03 429-P - 15" RCP - INV IN = 425.14	427-P - 18" RCP - INV OUT = 424.83
428-CB	RIM = 429.17 SUMP = 425.29		428-P - 15" RCP - INV OUT = 425.29
429-CB	RIM = 433.71 SUMP = 427.06	431-P - 15" RCP - INV IN = 427.26 430-P - 15" RCP - INV IN = 429.45	429-P - 15" RCP - INV OUT = 427.06
430-AD	RIM = 433.71 SUMP = 429.71		430-P - 15" RCP - INV OUT = 429.71
431-AD	RIM = 432.13 SUMP = 428.13		431-P - 15" RCP - INV OUT = 428.13
432-AD	RIM = 405.80 SUMP = 401.15	433-P - 15" RCP - INV IN = 401.35 434-P - 30" RCP - INV IN = 401.53	432-P - 30" RCP - INV OUT = 401.15
433-CB	RIM = 405.88 SUMP = 401.61		433-P - 15" RCP - INV OUT = 401.61

STRUCTURE TABLE			
NAME	RIM	PIPES IN	PIPES OUT
434-AD	RIM = 411.03 SUMP = 406.29	435-P - 18" RCP - INV IN = 406.49 436-P - 30" RCP - INV IN = 406.75	434-P - 30" RCP - INV OUT = 406.29
435-CB	RIM = 411.16 SUMP = 406.75		435-P - 18" RCP - INV OUT = 406.75
436-AD	RIM = 415.79 SUMP = 410.92	438-P - 30" RCP - INV IN = 411.12 437-P - 15" RCP - INV IN = 411.57	436-P - 30" RCP - INV OUT = 410.92
437-CB	RIM = 415.82 SUMP = 411.83		437-P - 15" RCP - INV OUT = 411.83
438-CB	RIM = 419.42 SUMP = 412.03	439-P - 15" RCP - INV IN = 412.23 440-P - 30" RCP - INV IN = 414.94	438-P - 30" RCP - INV OUT = 412.03
439-AD	RIM = 419.14 SUMP = 413.12		439-P - 15" RCP - INV OUT = 413.12
440-CB	RIM = 422.31 SUMP = 417.55	441-P - 15" RCP - INV IN = 417.78 442-P - 30" RCP - INV IN = 417.75	440-P - 30" RCP - INV OUT = 417.55
441-CB	RIM = 422.31 SUMP = 418.04		441-P - 15" RCP - INV OUT = 418.04
442-AD	RIM = 428.88 SUMP = 419.33	447-P - 24" RCP - INV IN = 419.53 443-P - 15" RCP - INV IN = 424.22	442-P - 30" RCP - INV OUT = 419.33
443-CB	RIM = 428.86 SUMP = 424.48	444-P - 15" RCP - INV IN = 424.68	443-P - 15" RCP - INV OUT = 424.48
444-CB	RIM = 430.64 SUMP = 426.05	445-P - 15" RCP - INV IN = 426.25	444-P - 15" RCP - INV OUT = 426.05
445-CB	RIM = 431.30 SUMP = 426.51	446-P - 15" RCP - INV IN = 426.71	445-P - 15" RCP - INV OUT = 426.51
446-CB	RIM = 432.32 SUMP = 428.46		446-P - 15" RCP - INV OUT = 428.46
447-CB	RIM = 432.08 SUMP = 420.31	448-P - 24" RCP - INV IN = 420.51	447-P - 24" RCP - INV OUT = 420.31
448-CB	RIM = 433.89 SUMP = 423.69	450-P - 18" RCP - INV IN = 423.89 449-P - 15" RCP - INV IN = 429.54 454-P - 24" RCP - INV IN = 428.34	448-P - 24" RCP - INV OUT = 423.69
449-CB	RIM = 433.85 SUMP = 429.80		449-P - 15" RCP - INV OUT = 429.80
450-CB	RIM = 432.55 SUMP = 424.79	452-P - 18" RCP - INV IN = 424.99 451-P - 15" RCP - INV IN = 426.26	450-P - 18" RCP - INV OUT = 424.79

2	REMOVE SWEETLEAF	07/31/2019
1	REVISED PER TOR COMMENTS	12/07/2018
REV NO.	DESCRIPTIONS	
REVISIONS		

PIPE TABLE					
NAME	CONNECT	SIZE	LENGTH	SLOPE	MATERIAL
001-CUL	UP: DOWN:	48"	102.24'	1.47%	RCP
002-CUL	UP: DOWN:	48"	102.15'	1.47%	RCP
011-P	UP: 011-CB DOWN: 010-FES	15"	74.95'	1.00%	RCP
012-P	UP: 012-CB DOWN: 011-CB	15"	34.00'	1.00%	RCP
101-P	UP: 101-RI DOWN: 100-FES	24"	77.45'	1.00%	RCP
105-P	UP: 105-CB DOWN: 102-FES	30"	191.18'	1.19%	RCP
106-P	UP: 106A-CB DOWN: 105-CB	18"	145.96'	1.77%	RCP
107-P	UP: 107A-CB DOWN: 106A-CB	15"	34.00'	1.00%	RCP
109-P	UP: 109-CB DOWN: 105-CB	18"	130.45'	2.69%	RCP
110-P	UP: 110-CB DOWN: 109-CB	15"	34.00'	1.00%	RCP
111-P	UP: 111-CB DOWN: 109-CB	15"	138.64'	4.87%	RCP
112-P	UP: 112-CB DOWN: 111-CB	15"	34.00'	1.00%	RCP
113-P	UP: 113-CB DOWN: 111-CB	15"	134.96'	4.70%	RCP
114-P	UP: 114-CB DOWN: 113-CB	15"	34.00'	1.00%	RCP
115-P	UP: 115-CB DOWN: 113-CB	15"	177.07'	2.29%	RCP
116-P	UP: 116-CB DOWN: 115-CB	15"	34.00'	1.00%	RCP
151-P	UP: 151-AD DOWN: 150-FES	15"	63.19'	6.38%	RCP
152-P	UP: 152A-CB DOWN: 151-AD	15"	156.05'	10.74%	RCP
153-P	UP: 153-CB DOWN: 152A-CB	15"	80.31'	1.80%	RCP
154-P	UP: 154-CB DOWN: 153-CB	15"	31.17'	1.00%	RCP
155-P	UP: 155-CB DOWN: 153-CB	15"	63.34'	1.00%	RCP
301-P	UP: 301-RI DOWN: 300-FES	30"	72.63'	1.00%	RCP
303-P	UP: 303-AD DOWN: 302-FES	48"	54.98'	2.82%	RCP
304-P	UP: 304-AD DOWN: 303-AD	48"	98.08'	1.12%	RCP
305-P	UP: 305-CB DOWN: 304-AD	48"	49.75'	1.00%	RCP
306-P	UP: 306A-CB DOWN: 305-CB	30"	64.25'	1.00%	RCP
307-P	UP: 307A-CB DOWN: 306A-CB	18"	34.00'	1.00%	RCP
308-P	UP: 308-CB DOWN: 305-CB	36"	92.95'	5.11%	RCP
309-P	UP: 309-CB DOWN: 308-CB	18"	34.00'	3.13%	RCP
310-P	UP: 310-CB DOWN: 308-CB	36"	140.84'	3.91%	RCP
311-P	UP: 311-CB DOWN: 310-CB	15"	34.00'	1.00%	RCP
312-P	UP: 312-CB DOWN: 310-CB	36"	88.39'	1.00%	RCP
313-P	UP: 313A-CB DOWN: 312-CB	24"	44.73'	2.19%	RCP
314-P	UP: 314A-CB DOWN: 313B-CB	15"	34.01'	1.00%	RCP
315-P	UP: 315-CB DOWN: 313B-CB	15"	131.78'	1.53%	RCP
316-P	UP: 316-CB DOWN: 315-CB	15"	34.00'	1.00%	RCP
317-P	UP: 317-CB DOWN: 312-CB	36"	73.57'	2.72%	RCP
318-P	UP: 318-CB DOWN: 317-CB	15"	34.00'	1.00%	RCP
319-P	UP: 319-CB DOWN: 317-CB	30"	115.17'	2.37%	RCP
320-P	UP: 320-CB DOWN: 319-CB	15"	33.99'	1.00%	RCP
321-P	UP: 321-CB DOWN: 319-CB	30"	78.89'	2.18%	RCP
322-P	UP: 322-CB DOWN: 321-CB	30"	141.00'	2.35%	RCP
323-P	UP: 323-CB DOWN: 322-CB	15"	34.00'	1.00%	RCP
324-P	UP: 324-CB DOWN: 322-CB	30"	253.14'	2.50%	RCP
325-P	UP: 325-CB DOWN: 324-CB	15"	34.00'	1.00%	RCP
326-P	UP: 326-CB DOWN: 324-CB	24"	242.80'	2.31%	RCP
327-P	UP: 327-CB DOWN: 326-CB	15"	34.00'	1.00%	RCP
328-P	UP: 328-CB DOWN: 326-CB	24"	231.89'	3.51%	RCP

PIPE TABLE					
NAME	CONNECT	SIZE	LENGTH	SLOPE	MATERIAL
329-P	UP: 329-CB DOWN: 328-CB	15"	34.00'	1.00%	RCP
330-P	UP: 330-CB DOWN: 328-CB	24"	232.42'	1.35%	RCP
331-P	UP: 331-CB DOWN: 330-CB	15"	34.01'	1.00%	RCP
332-P	UP: 332-CB DOWN: 330-CB	24"	203.39'	1.00%	RCP
333-P	UP: 333-CB DOWN: 332-CB	15"	34.00'	7.14%	RCP
334-P	UP: 334-CB DOWN: 332-CB	15"	143.19'	1.00%	RCP
335-P	UP: 335-CB DOWN: 334-CB	18"	187.95'	1.00%	RCP
336-P	UP: 336-CB DOWN: 335-CB	15"	34.00'	1.00%	RCP
337-P	UP: 337-CB DOWN: 335-CB	15"	43.00'	1.00%	RCP
338-P	UP: 338-CB DOWN: 337-CB	15"	26.01'	1.00%	RCP
339-P	UP: 339-CB DOWN: 335-CB	18"	86.97"	1.00%	RCP
340-P	UP: 340-CB DOWN: 339-CB	15"	34.00'	1.00%	RCP
341-P	UP: 341A-CB DOWN: 339-CB	18"	117.75'	1.00%	RCP
342-P	UP: 342A-CB DOWN: 341B-CB	15"	34.00'	1.00%	RCP
342C-P	UP: 342C-AD DOWN: 342B-CB	15"	36.34'	1.00%	RCP
351-P	UP: 351-AD DOWN: 350-FES	15"	82.80'	9.66%	RCP
352-P	UP: 352-CB DOWN: 351-AD	15"	146.38'	5.54%	RCP
353-P	UP: 353-CB DOWN: 352-CB	15"	97.42'	1.08%	RCP
354-P	UP: 354-CB DOWN: 353-CB	15"	34.79'	1.00%	RCP
355-P	UP: 355-CB DOWN: 352-CB	15"	34.51'	1.00%	RCP
356-P	UP: 356-CB DOWN: 355-CB	15"	44.80'	1.00%	RCP
357-P	UP: 357-CB DOWN: 356-CB	15"	96.60'	1.00%	RCP
358-P	UP: 358-CB DOWN: 357-CB	15"	26.00'	1.00%	RCP
401-P	UP: 401-RI DOWN: 400-FES	24"	69.06'	1.00%	RCP
403-P	UP: 403-AD DOWN: 402-FES	48"	312.32'	4.31%	RCP
404-P	UP: 404-CB DOWN: 403-AD	48"	172.83'	1.00%	RCP
405-P	UP: 405-CB DOWN: 404-CB	15"	26.55'	1.00%	RCP
406-P	UP: 406-CB DOWN: 404-CB	36"	99.73'	5.08%	RCP
407-P	UP: 407-CB DOWN: 406-CB	36"	26.00'	1.00%	RCP
408-P	UP: 408-CB DOWN: 407-CB	36"	39.46'	2.91%	RCP
409-P	UP: 409-CB DOWN: 408-CB	36"	26.25'	0.99%	RCP
410-P	UP: 410-CB DOWN: 409-CB	36"	91.99'	1.00%	RCP
411-P	UP: 411-AD DOWN: 410-CB	24"	37.03'	1.00%	RCP
412-P	UP: 412-AD DOWN: 410-CB	15"	26.00'	1.00%	RCP
413-P	UP: 413-CB DOWN: 410-CB	24"	173.24'	2.47%	RCP
414-P	UP: 414-AD DOWN: 413-CB	18"	31.26'	1.00%	RCP
415-P	UP: 415-AD DOWN: 413-CB	15"	26.00'	1.00%	RCP
416-P	UP: 416-CB DOWN: 413-CB	24"	96.21'	2.55%	RCP
417-P	UP: 417-CB DOWN: 416-CB	15"	26.05'	1.00%	RCP
418-P	UP: 418-CB DOWN: 417-CB	15"	50.87"	3.50%	RCP
419-P	UP: 419-AD DOWN: 417-CB	15"	89.22'	1.00%	RCP
420-P	UP: 420-CB DOWN: 416-CB	24"	86.61'	3.68%	RCP
421-P	UP: 421-CB DOWN: 420-CB	24"	136.50'	1.02%	RCP
422-P	UP: 422-CB DOWN: 421-CB	18"	27.32'	0.99%	RCP
423-P	UP: 423-CB DOWN: 422-CB	15"	44.24'	1.13%	RCP
424-P	UP: 424-CB DOWN: 423-CB	15"	26.02'	1.00%	RCP
425-P	UP: 425-CB DOWN: 423-CB	15"	111.06'	1.00%	RCP
426-P	UP: 426-CB DOWN: 425-CB	15"	26.00'	1.00%	RCP

PIPE TABLE					
NAME	CONNECT	SIZE	LENGTH	SLOPE	MATERIAL
427-P	UP: 427-CB DOWN: 421-CB	18"	49.15'	4.54%	RCP
428-P	UP: 428-CB DOWN: 427-CB	15"	26.48'	1.00%	RCP
429-P	UP: 429-CB DOWN: 427-CB	15"	192.19'	1.00%	RCP
430-P	UP: 430-AD DOWN: 429-CB	15"	26.00'	1.00%	RCP
431-P	UP: 431-AD DOWN: 429-CB	15"	87.58'	1.00%	RCP
432-P	UP: 432-AD DOWN: 406-CB	30"	83.62'	3.72%	RCP
433-P	UP: 433-CB DOWN: 432-AD	15"	26.03'	1.00%	RCP
434-P	UP: 434-AD DOWN: 432-AD	30"	125.14'	3.81%	RCP
435-P	UP: 435-CB DOWN: 434-AD	18"	26.22'	0.99%	RCP
436-P	UP: 436-AD DOWN: 434-AD	30"	114.32'	3.65%	RCP
437-P	UP: 437-CB DOWN: 436-AD	15"	26.01'	1.00%	RCP
438-P	UP: 438-CB DOWN: 436-AD	30"	90.80'	1.00%	RCP
439-P	UP: 439-AD DOWN: 438-CB	15"	89.76'	1.00%	RCP
440-P	UP: 440-CB DOWN: 438-CB	30"	72.57'	3.60%	RCP
441-P	UP: 441-CB DOWN: 440-CB	15"	26.00'	1.00%	RCP
442-P	UP: 442-AD DOWN: 440-CB	30"	157.61'	1.00%	RCP
443-P	UP: 443-CB DOWN: 442-AD	15"	26.00'	1.00%	RCP
444-P	UP: 444-CB DOWN: 443-CB	15"	40.77'	3.37%	RCP
445-P	UP: 445-CB DOWN: 444-CB	15"	25.99'	1.00%	RCP
446-P	UP: 446-CB DOWN: 445-CB	15"	40.98'	4.26%	RCP
447-P	UP: 447-CB DOWN: 442-AD	24"	77.48'	1.01%	RCP
448-P	UP: 448-CB DOWN: 447-CB	24"	318.76'	1.00%	RCP
449-P	UP: 449-CB DOWN: 448-CB	15"	25.98'	1.00%	RCP
450-P	UP: 450-CB DOWN: 448-CB	18"	89.44'	1.00%	RCP
451-P	UP: 451-CB DOWN: 450-CB	15"	26.00'	1.00%	RCP
452-P	UP: 452A-CB DOWN: 450-CB	18"	131.38'	1.00%	RCP
453-P	UP: 453A-CB DOWN: 452B-CB	15"	26.00'	1.00%	RCP
453C-P	UP: 453C-AD DOWN: 453B-CB	15"	21.89'	1.00%	RCP
454-P	UP: 454-CB DOWN: 448-CB	24"	46.40'	1.00%	RCP
455-P	UP: 455-CB DOWN: 454-CB	15"	26.00'	1.00%	RCP
456-P	UP: 456-CB DOWN: 454-CB	18"	103.95'	1.00%	RCP
457-P	UP: 457-CB DOWN: 456-CB	15"	26.00'	1.00%	RCP
458-P	UP: 458-AD DOWN: 456-CB	24"	100.50'	1.00%	RCP
459-P	UP: 459-AD DOWN: 458-AD	15"	117.46'	3.94%	RCP
460-P	UP: 460-CB DOWN: 456-CB	15"	130.03'	2.72%	RCP
600-P	UP: 601-FES DOWN: 600-FES	18"	102.70'	1.00%	RCP
611-P	UP: 611-FES DOWN: 610-FES	18"	97.16'	1.00%	RCP

CLASS IV

CLASS IV



Bateman Civil Survey Company
Engineers • Surveyors • Planners
2524 Reliance Avenue, Apex, North Carolina 27539
Phone: 919.577.1080 Fax: 919.577.1081
NCBELS FRM No. C-2376



ELIZABETH HEIGHTS
CONSTRUCTION DRAWINGS
1205 AVERETTE ROAD
WAKE FOREST, NC 27587
WAKE COUNTY, NC


STORM PIPE TABLES

Project Engineer:	TSS
Designed By:	LEG
Drawn By:	LEG
Checked By:	TSS
Scale:	1"=150'

Date:	07/31/2019
Project Number:	170348

SHEET
C315

REV. NO.	DESCRIPTIONS	
2	REMOVE SWEETLEAF	07/31/2019
1	REVISED PER TOR COMMENTS	12/07/2018
REVISIONS		

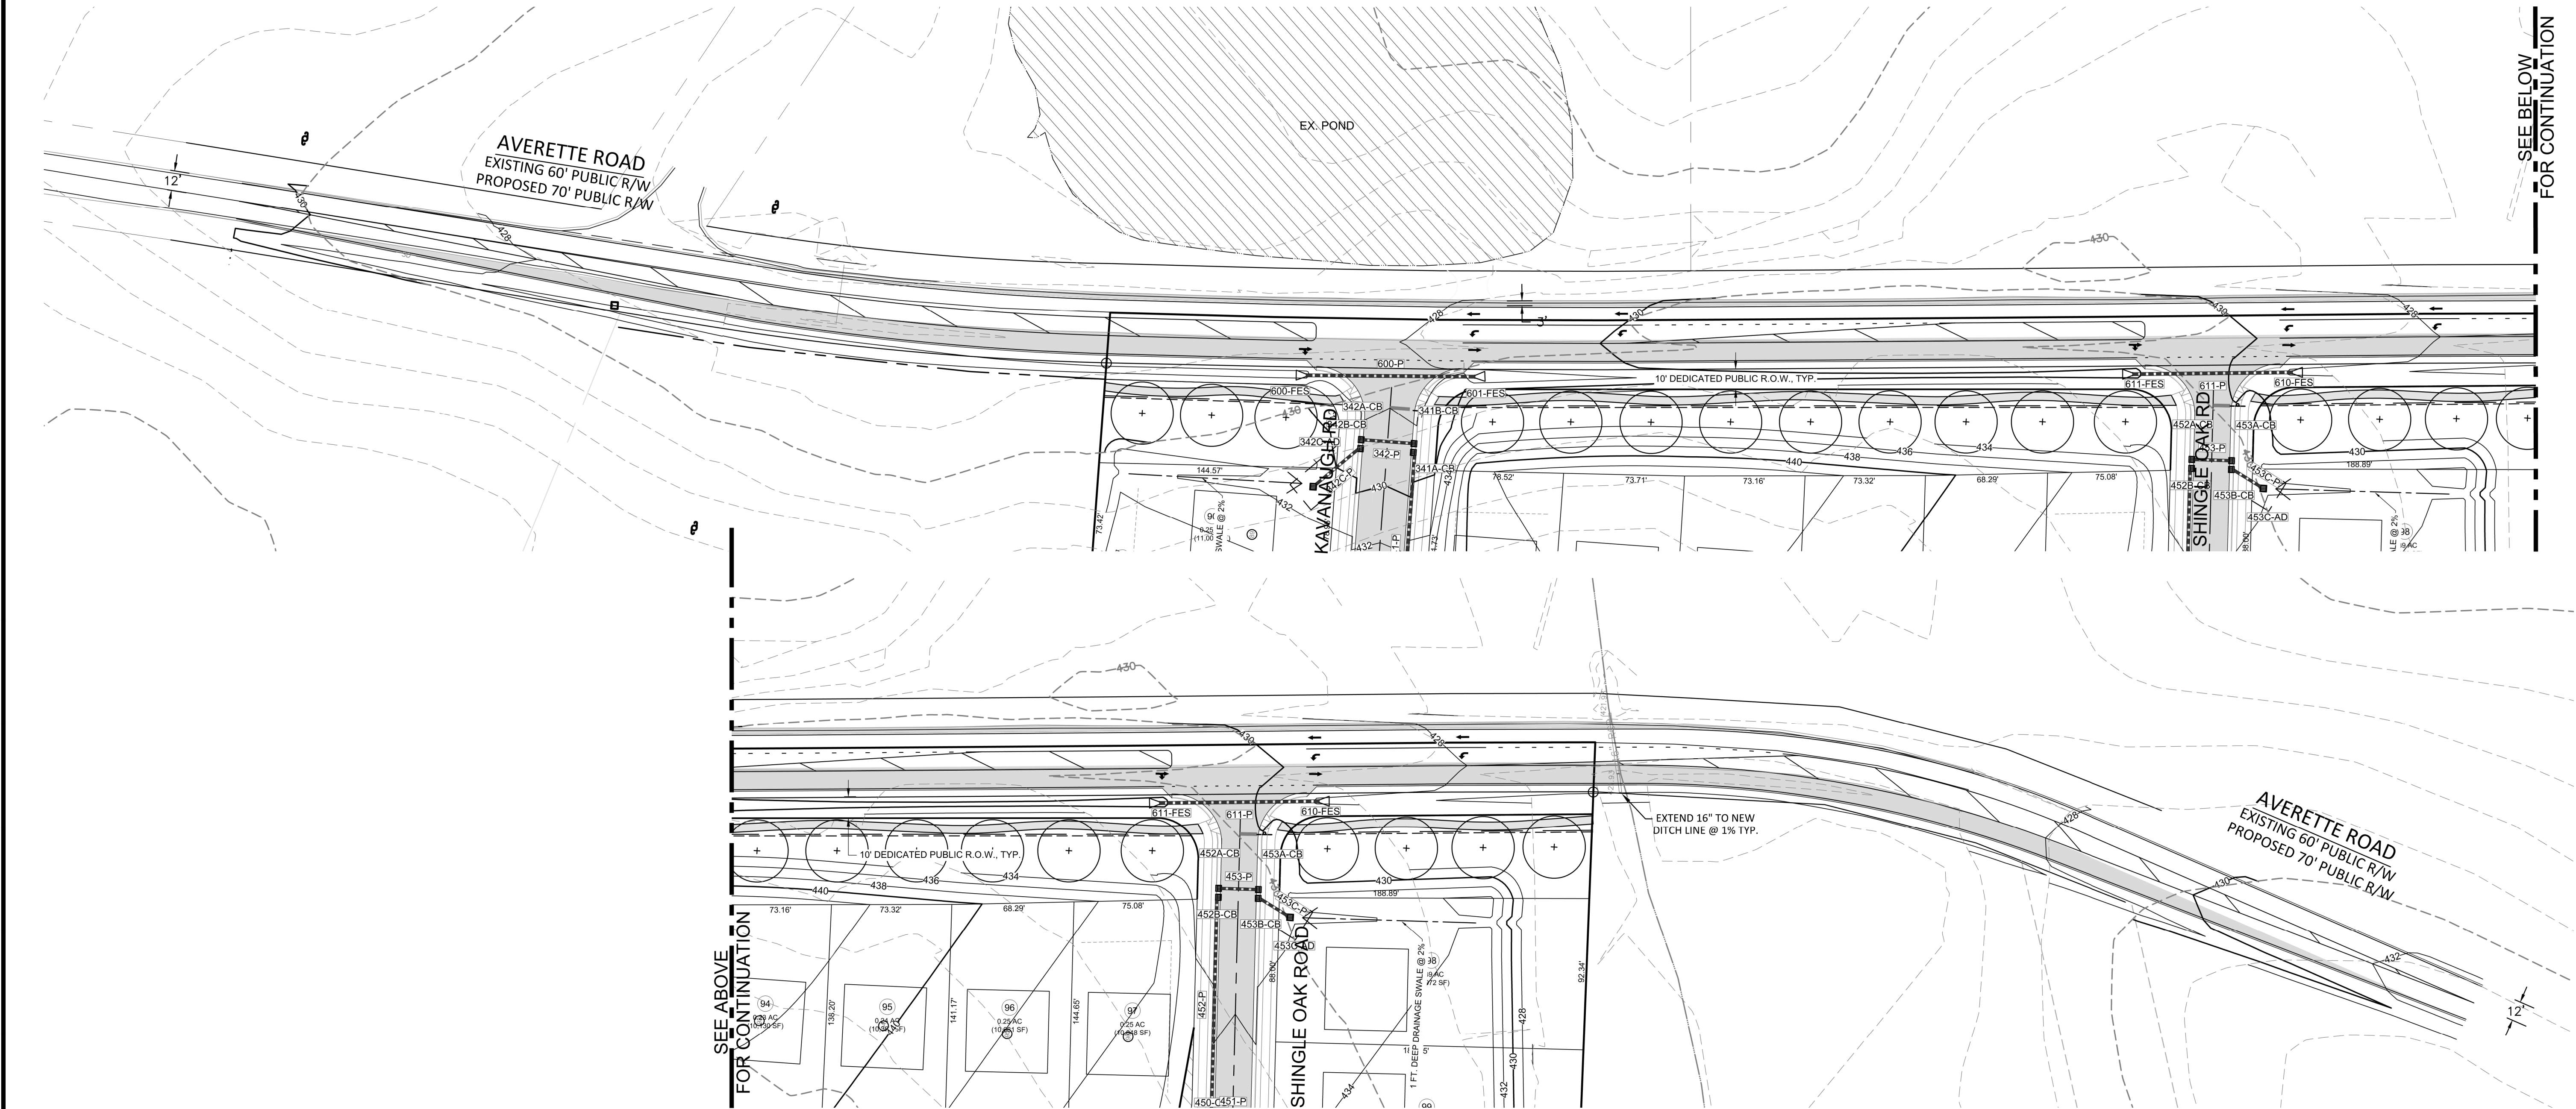

ELIZABETH HEIGHTS
CONSTRUCTION DRAWINGS

AWERETTE ROAD
GRADING PLAN

Project Engineer:	TSS
Designed By:	RAJ
Drawn By:	RAJ
Checked By:	TSS
Scale:	NTS

Date: 07/31/2019

Project Number: .170348

SHEET
C316






Bateman Civil Survey Company
Engineers • Surveyors • Planners
2524 Reliance Avenue, Apex, North Carolina 27539
Phone: 919.577.1080 Fax: 919.577.1081
NCBELS FRM No. C-2376



ELIZABETH HEIGHTS----

2	REMOVE SWEETLEAF	07/31/2019
REV NO.	DESCRIPTIONS	
	REVISIONS	

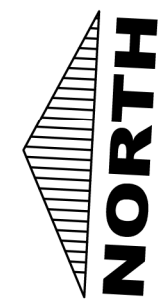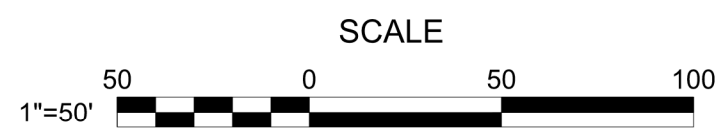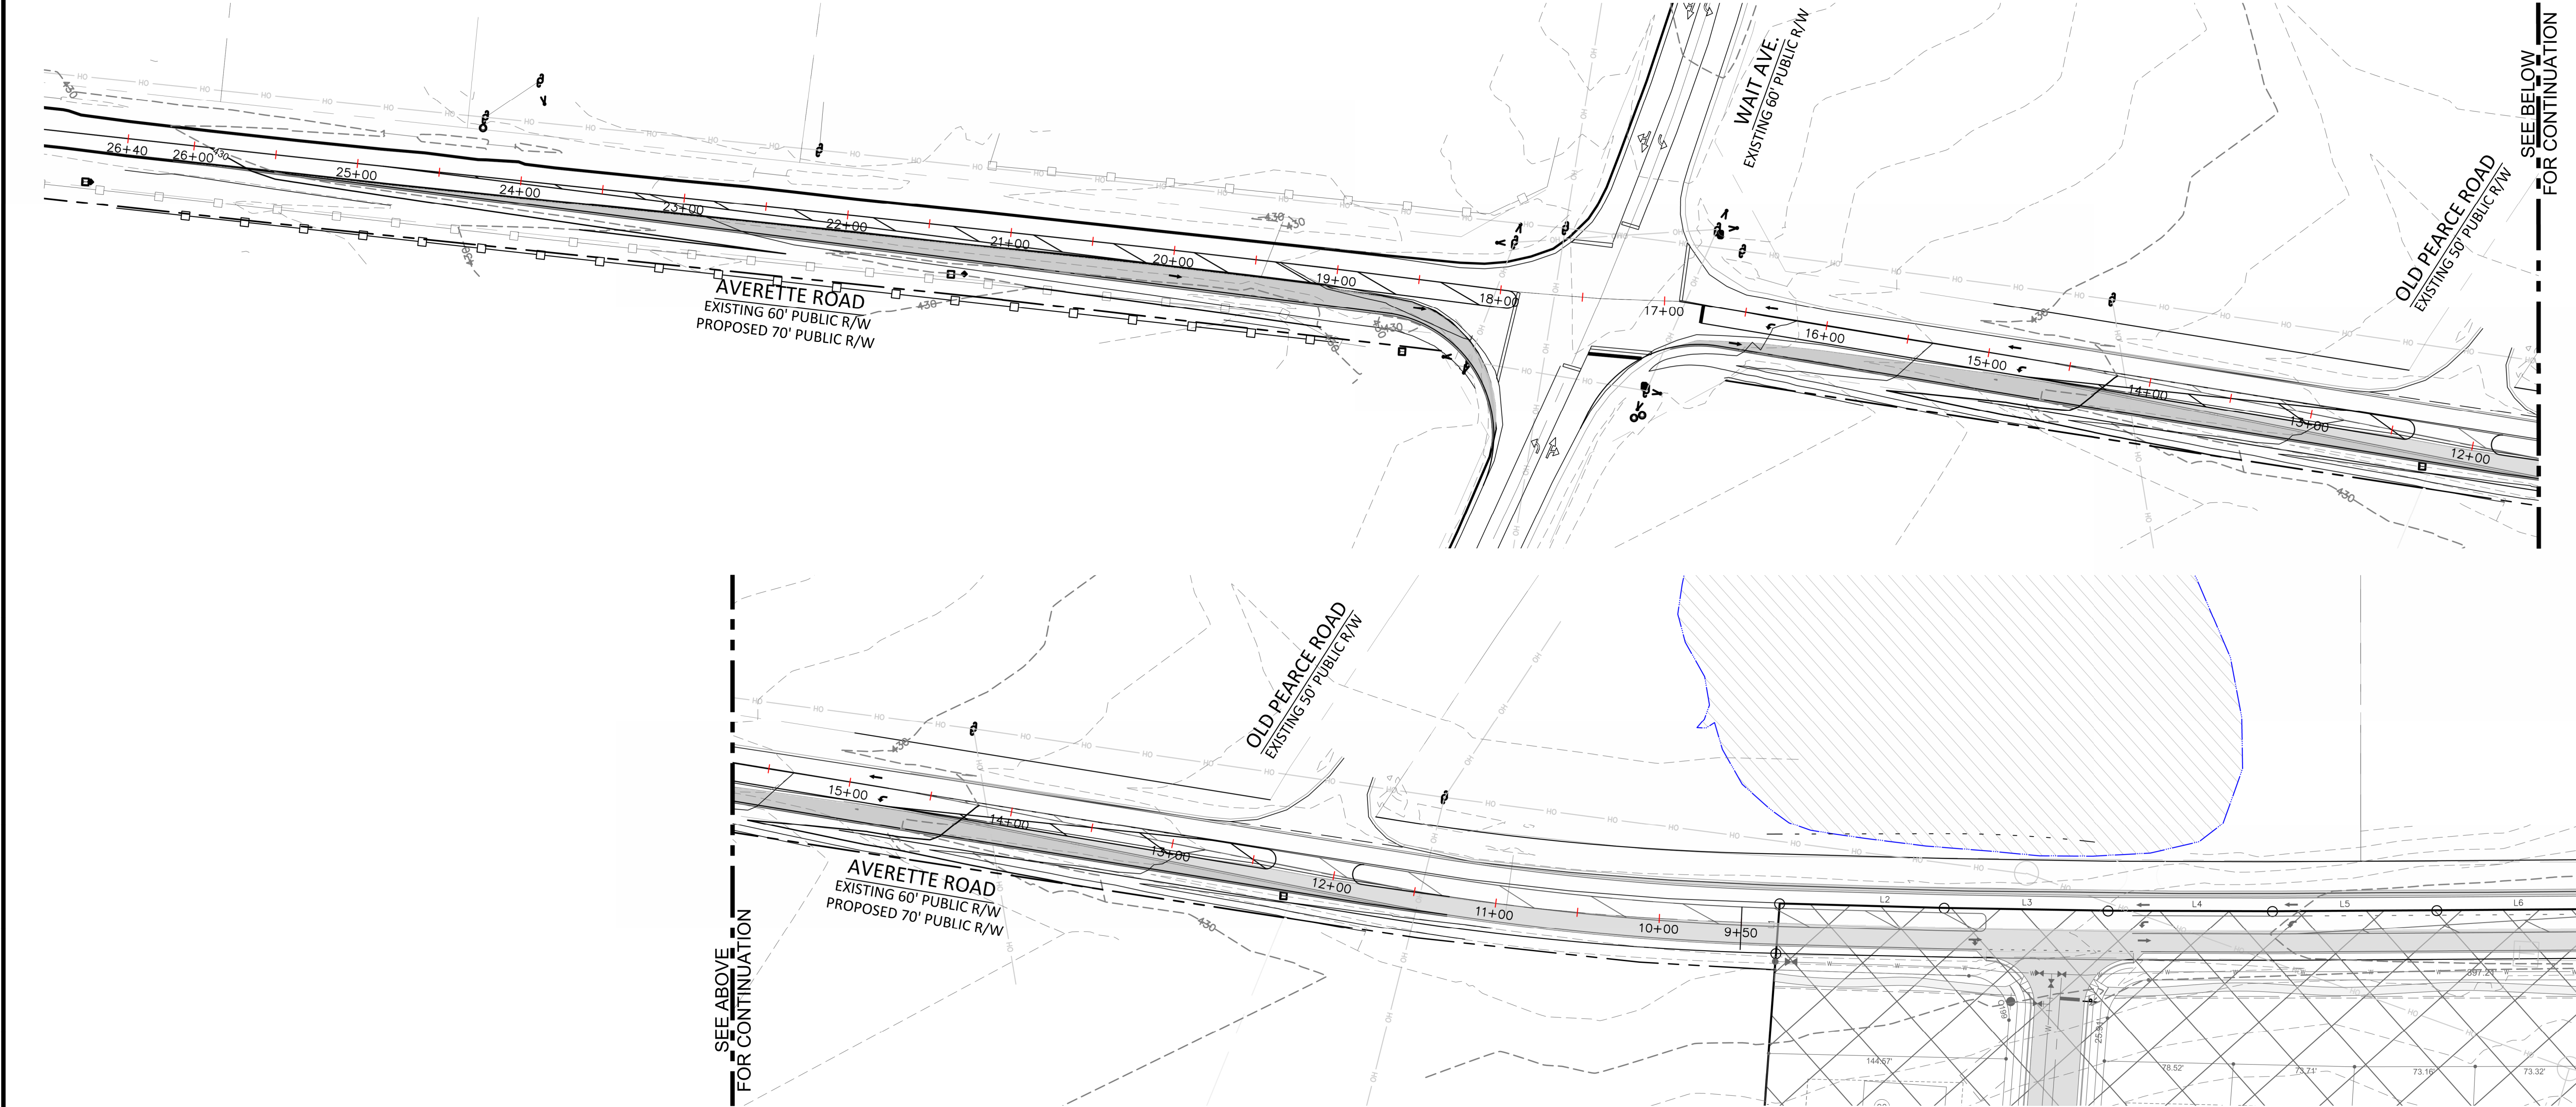

**AVERETTE RD. / WAIT AVE.
GRADING PLAN**

**ELIZABETH HEIGHTS
CONSTRUCTION DRAWINGS**



Bateman Civil Survey Company
Engineers • Surveyors • Planners
2524 Reliance Avenue, Apex, North Carolina 27539
Phone: 919.577.1080 Fax: 919.577.1081
NCBELS FRM No. C-2376




Project Engineer:	TSS
Designed By:	RAJ
Drawn By:	RAJ
Checked By:	TSS
Scale:	NTS


Date: 07/31/2019

Project Number: .170348

SHEET
C317
OF: ---

ELIZABETH HEIGHTS-----

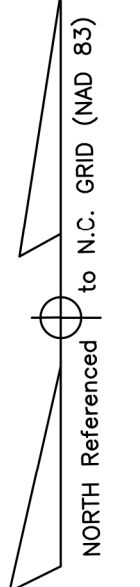

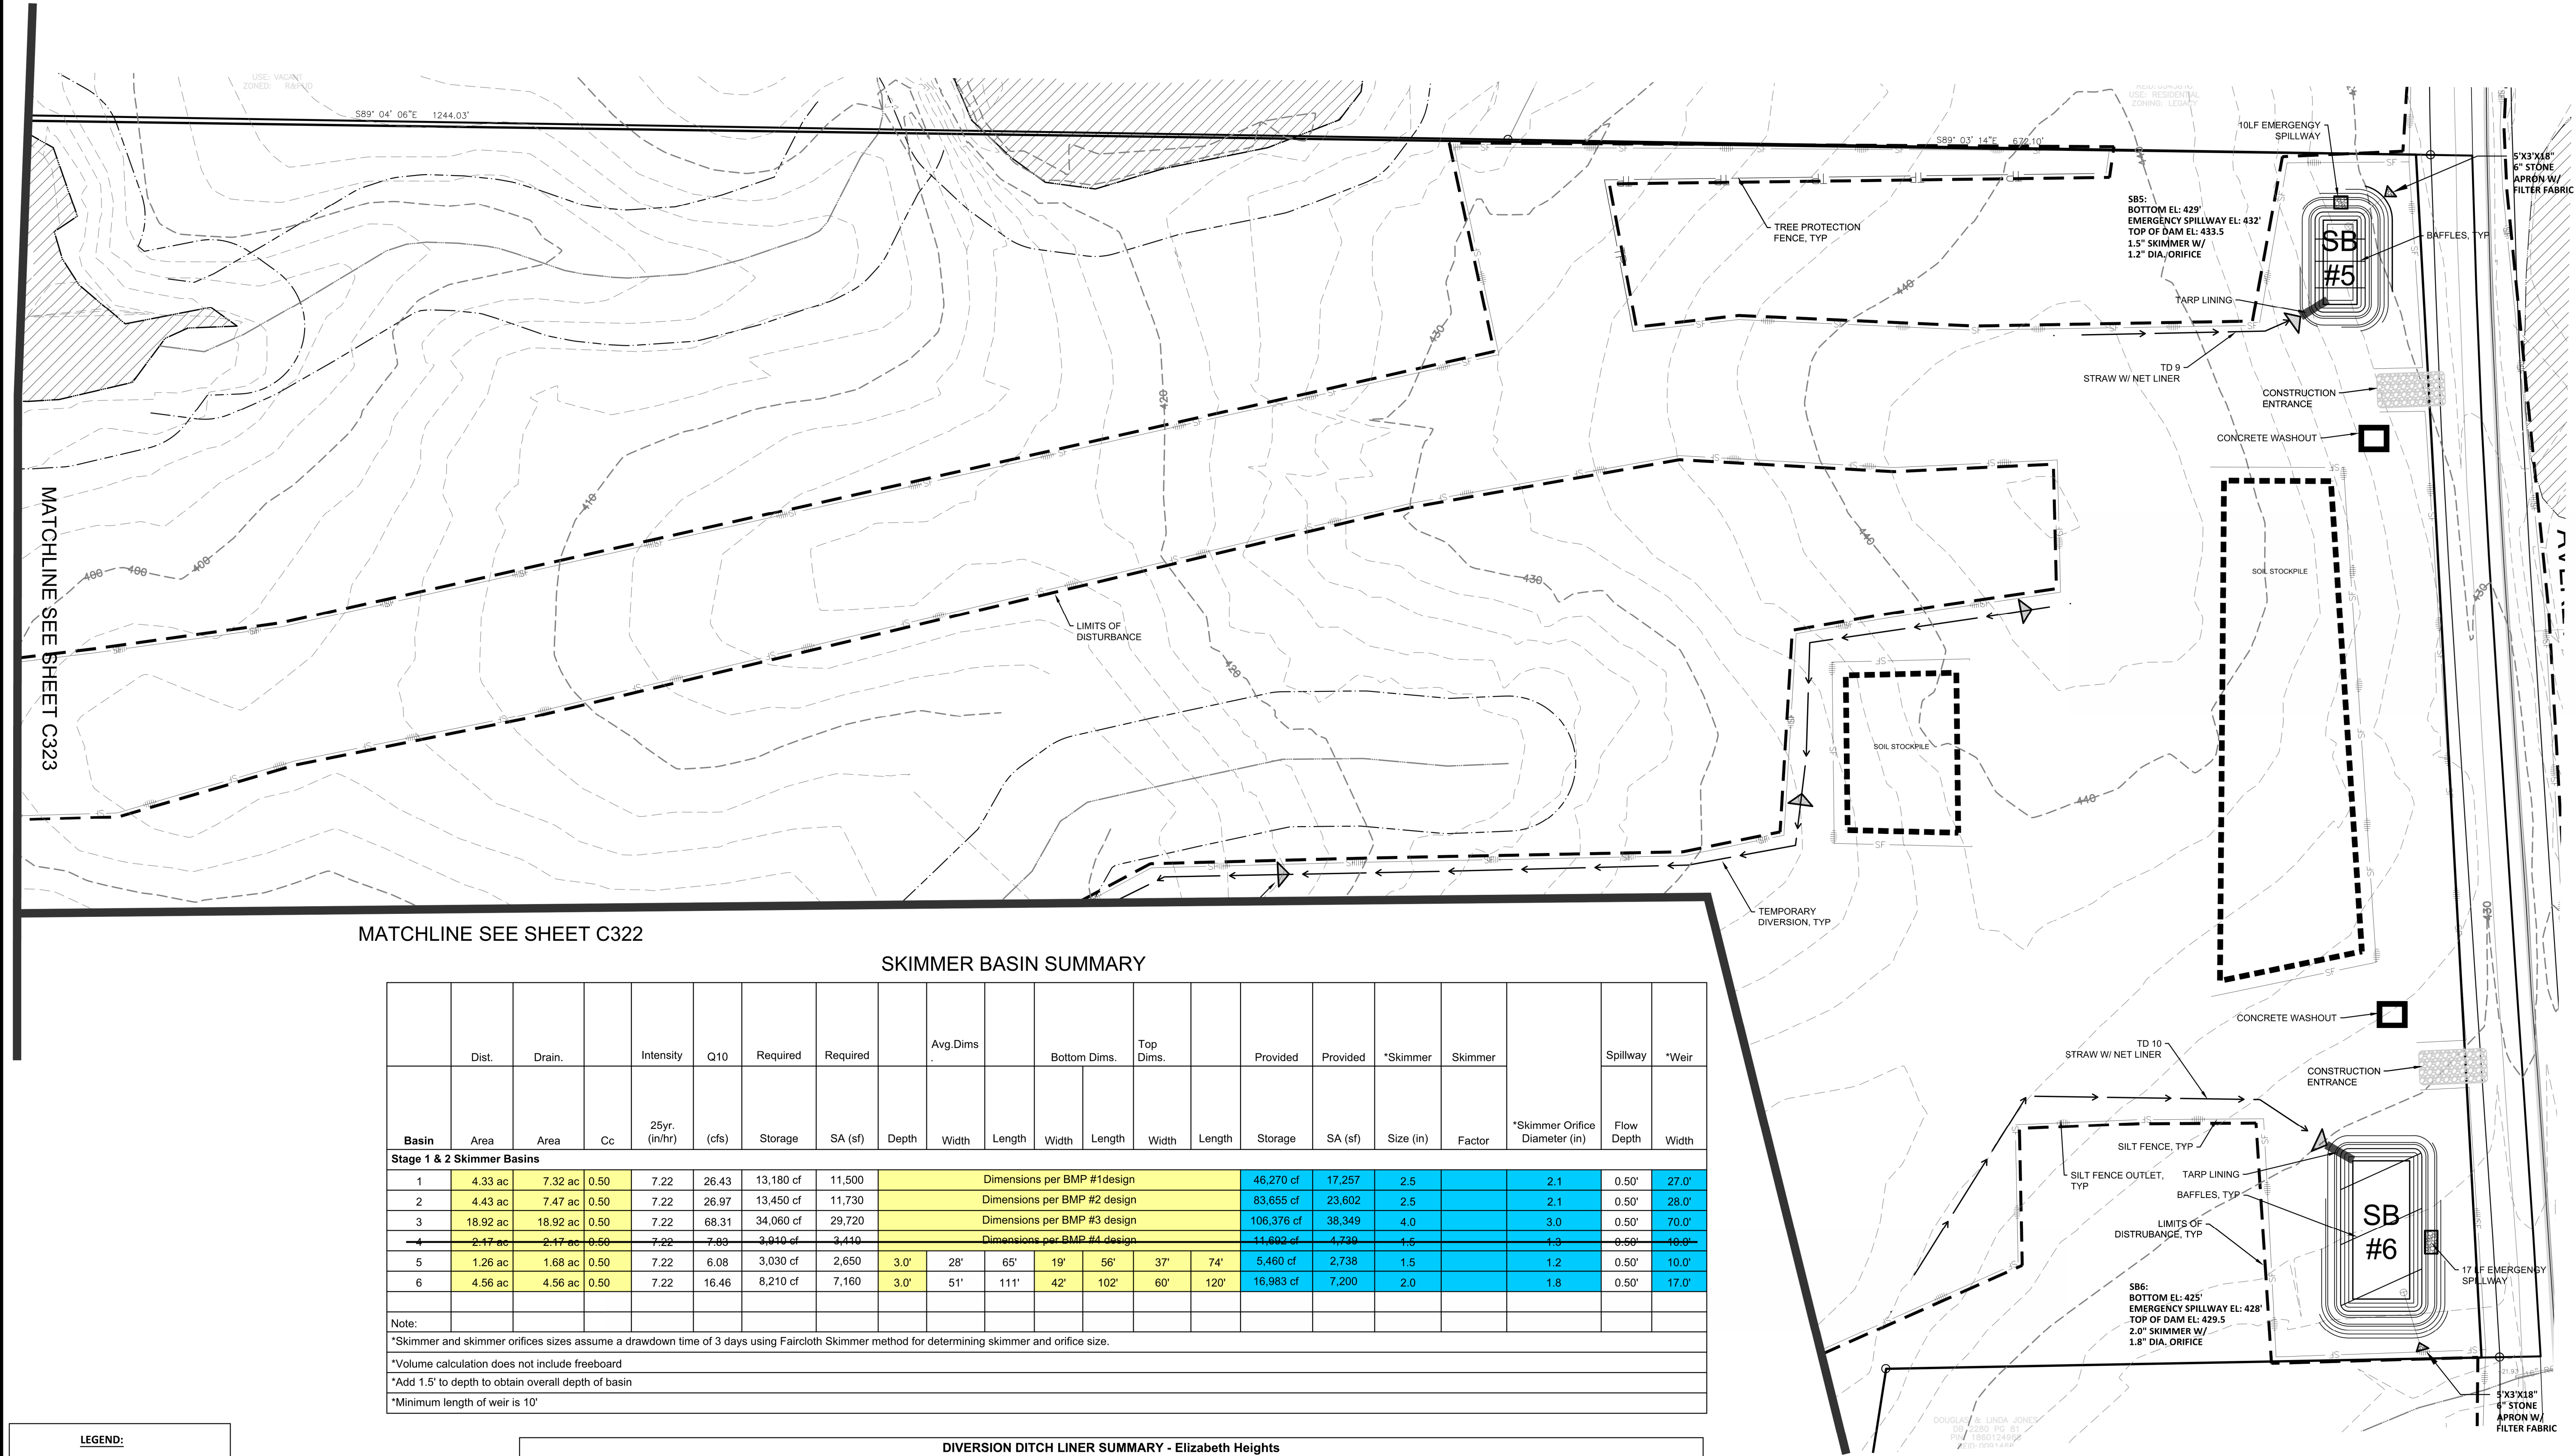

	Dist.	Drain.		Intensity	Q10	Required	Required		Avg Dims				Bottom Dims.	Top Dims.		Provided	Provided	*Skimmer	Skimmer		Spillway	*Weir
Basin	Area	Area	Cc	25yr. (in/hr)	(cfs)	Storage	SA (sf)	Depth	Width	Length	Width	Length	Width	Length	Storage	SA (sf)	Size (in)	Factor	*Skimmer Orifice Diameter (in)	Flow Depth	Width	
Stage 1 & 2 Skimmer Basins																						
1	4.33 ac	7.32 ac	0.50	7.22	26.43	13,180 cf	11,500	Dimensions per BMP #1 design							46,270 cf	17,257	2.5		2.1	0.50'	27.0'	
2	4.43 ac	7.47 ac	0.50	7.22	26.97	13,450 cf	11,730	Dimensions per BMP #2 design							83,655 cf	23,602	2.5		2.1	0.50'	28.0'	
3	18.92 ac	18.92 ac	0.50	7.22	68.31	34,060 cf	29,720	Dimensions per BMP #3 design							106,376 cf	38,349	4.0		3.0	0.50'	70.0'	
4	2.17 ac	2.17 ac	0.50	7.22	7.83	3,910 cf	3,410	Dimensions per BMP #4 design							11,602 cf	4,739	1.5		1.3	0.50'	16.0'	
5	1.26 ac	1.68 ac	0.50	7.22	6.08	3,030 cf	2,650	3.0'	28'	65'	19'	56'	37'	74'	5,460 cf	2,738	1.5		1.2	0.50'	10.0'	
6	4.56 ac	4.56 ac	0.50	7.22	16.46	8,210 cf	7,160	3.0'	51'	111'	42'	102'	60'	120'	16,983 cf	7,200	2.0		1.8	0.50'	17.0'	
Note:																						
*Skimmer and skimmer orifices sizes assume a drawdown time of 3 days using Faircloth Skimmer method for determining skimmer and orifice size.																						
*Volume calculation does not include freeboard																						
*Add 1.5' to depth to obtain overall depth of basin																						
*Minimum length of weir is 10'																						

DIVERSION DITCH LINER SUMMARY - Elizabeth Heights													
Temporary Diversion #	Total Area (ac)	Total Length	Begin Elevation	End Elevation	Δ Elevation	Tc	Slope	C	Intensity	Q	Depth	Shear	Liner
Stage 1 Diversions													
1	0.42	296.0	366.0	360.0	6.0	2.80	0.020	0.5	7.22	1.50	0.37	0.47	Straw w/ Net
2	1.58	726.0	389.5	362.0	27.5	4.40	0.038	0.5	7.22	5.70	0.54	1.28	Straw w/ Net
3	0.50	179.0	389.5	378.0	11.5	1.22	0.064	0.5	7.22	1.79	0.32	1.28	Straw w/ Net
4	0.80	385.0	390.5	378.0	12.5	2.86	0.032	0.5	7.22	2.90	0.44	0.89	Straw w/ Net
5	7.73	1634.0	443.5	398.0	45.5	9.24	0.028	0.5	7.22	27.90	1.04	1.81	Synthetic Mat
6	7.30	1550.0	425.5	384.0	41.5	9.01	0.027	0.5	7.22	26.34	1.02	1.70	Synthetic Mat
7	0.95	662.0	386.0	364.0	22.0	5.84	0.026	0.5	7.22	3.43	0.48	0.76	Straw w/ Net
8	0.33	565.0	392.0	364.0	28.0	3.27	0.050	0.5	7.22	1.18	0.29	0.90	Straw w/ Net
9	0.22	185.0	442.5	434.0	8.5	1.42	0.046	0.5	7.22	0.80	0.25	0.72	Straw w/ Net
10	0.81	424.0	436.0	429.5	6.5	4.12	0.015	0.5	7.22	2.93	0.50	0.48	Straw w/ Net

LEGEND:

- SILT FENCE
- TREE PROTECTION FENCE
- SILT FENCE OUTLET
- EX CONTOUR LINE
- PROP CONTOUR LINE
- LIMITS OF DISTURBANCE
- CONSTRUCTION ENTRANCE
- TEMPORARY DIVERSION DITCH
- CONCRETE WASHOUT
- STOCKPILE AREA
- ROCK CHECK DAM

2	REMOVE SWEETLEAF	07/31/2019
REV NO.	DESCRIPTIONS	REVISIONS



Bateman Civil Survey Company
Engineers • Surveyors • Planners
2524 Reliance Avenue, Apex, North Carolina 27539
Phone: 919.577.1080 Fax: 919.577.1081
NCBELS FRM No. C-2376



ELIZABETH HEIGHTS
CONSTRUCTION DRAWINGS
1205 AVERETTE ROAD
WAKE FOREST, NC 27587
WAKE COUNTY, NC


EROSION CONTROL PLAN

Project Engineer: TSS
Designed By: LEG
Drawn By: LEG
Checked By: TSS
Scale: 1"=60'

Date: 07/31/2019

Project Number: 170348

SHEET
C321

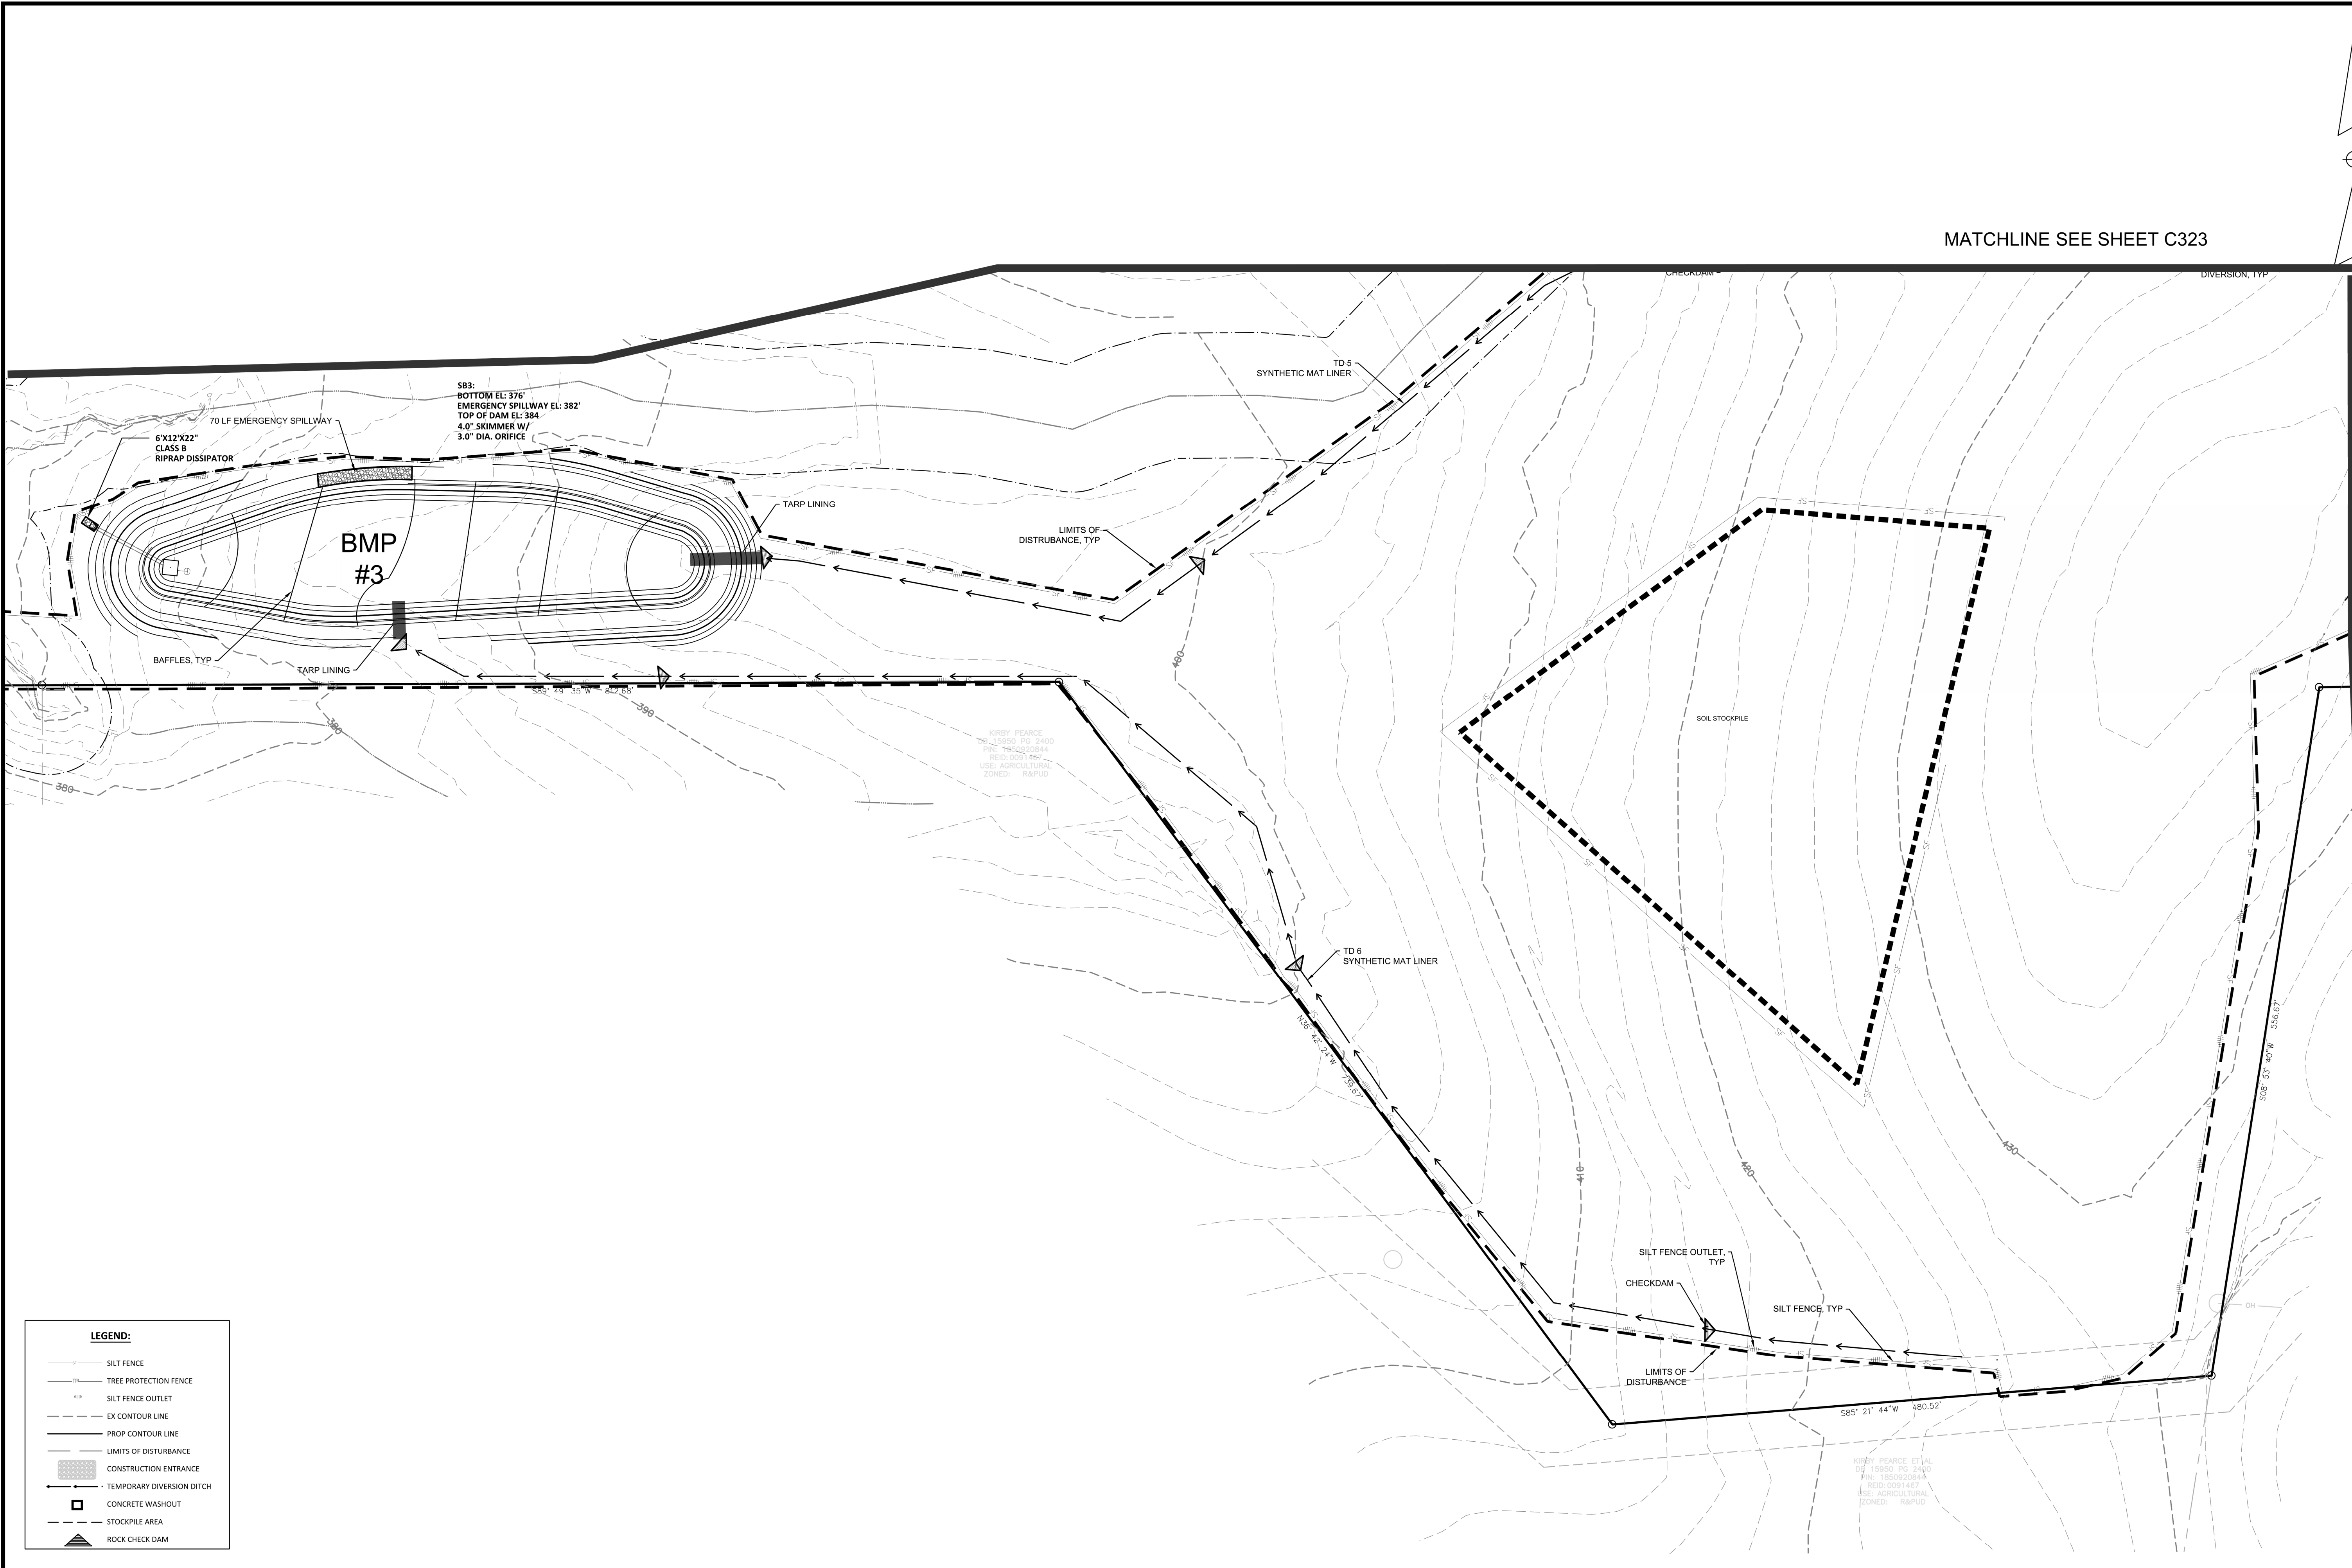

LEGEND:

- SILT FENCE
- TREE PROTECTION FENCE
- SILT FENCE OUTLET
- EX CONTOUR LINE
- PROP CONTOUR LINE
- LIMITS OF DISTURBANCE
- CONSTRUCTION ENTRANCE
- TEMPORARY DIVERSION DITCH
- CONCRETE WASHOUT
- STOCKPILE AREA
- ROCK CHECK DAM

2	REMOVE SWEETLEAF	07/31/2019
REV NO.	DESCRIPTIONS	
	REVISIONS	



Bateman Civil Survey Company
Engineers • Surveyors • Planners
2524 Reliance Avenue, Apex, North Carolina 27539
Phone: 919.577.1080 Fax: 919.577.1081
NCBELS FRM No. C-2376



ELIZABETH HEIGHTS
CONSTRUCTION DRAWINGS
1205 AVERETTE ROAD
WAKE FOREST, NC 27587
WAKE COUNTY, NC


EROSION CONTROL PLAN

Project Engineer:	TSS
Designed By:	LEG
Drawn By:	LEG
Checked By:	TSS
Scale:	1"=60'

Date: 07/31/2019

Project Number: 170348

SHEET
C322

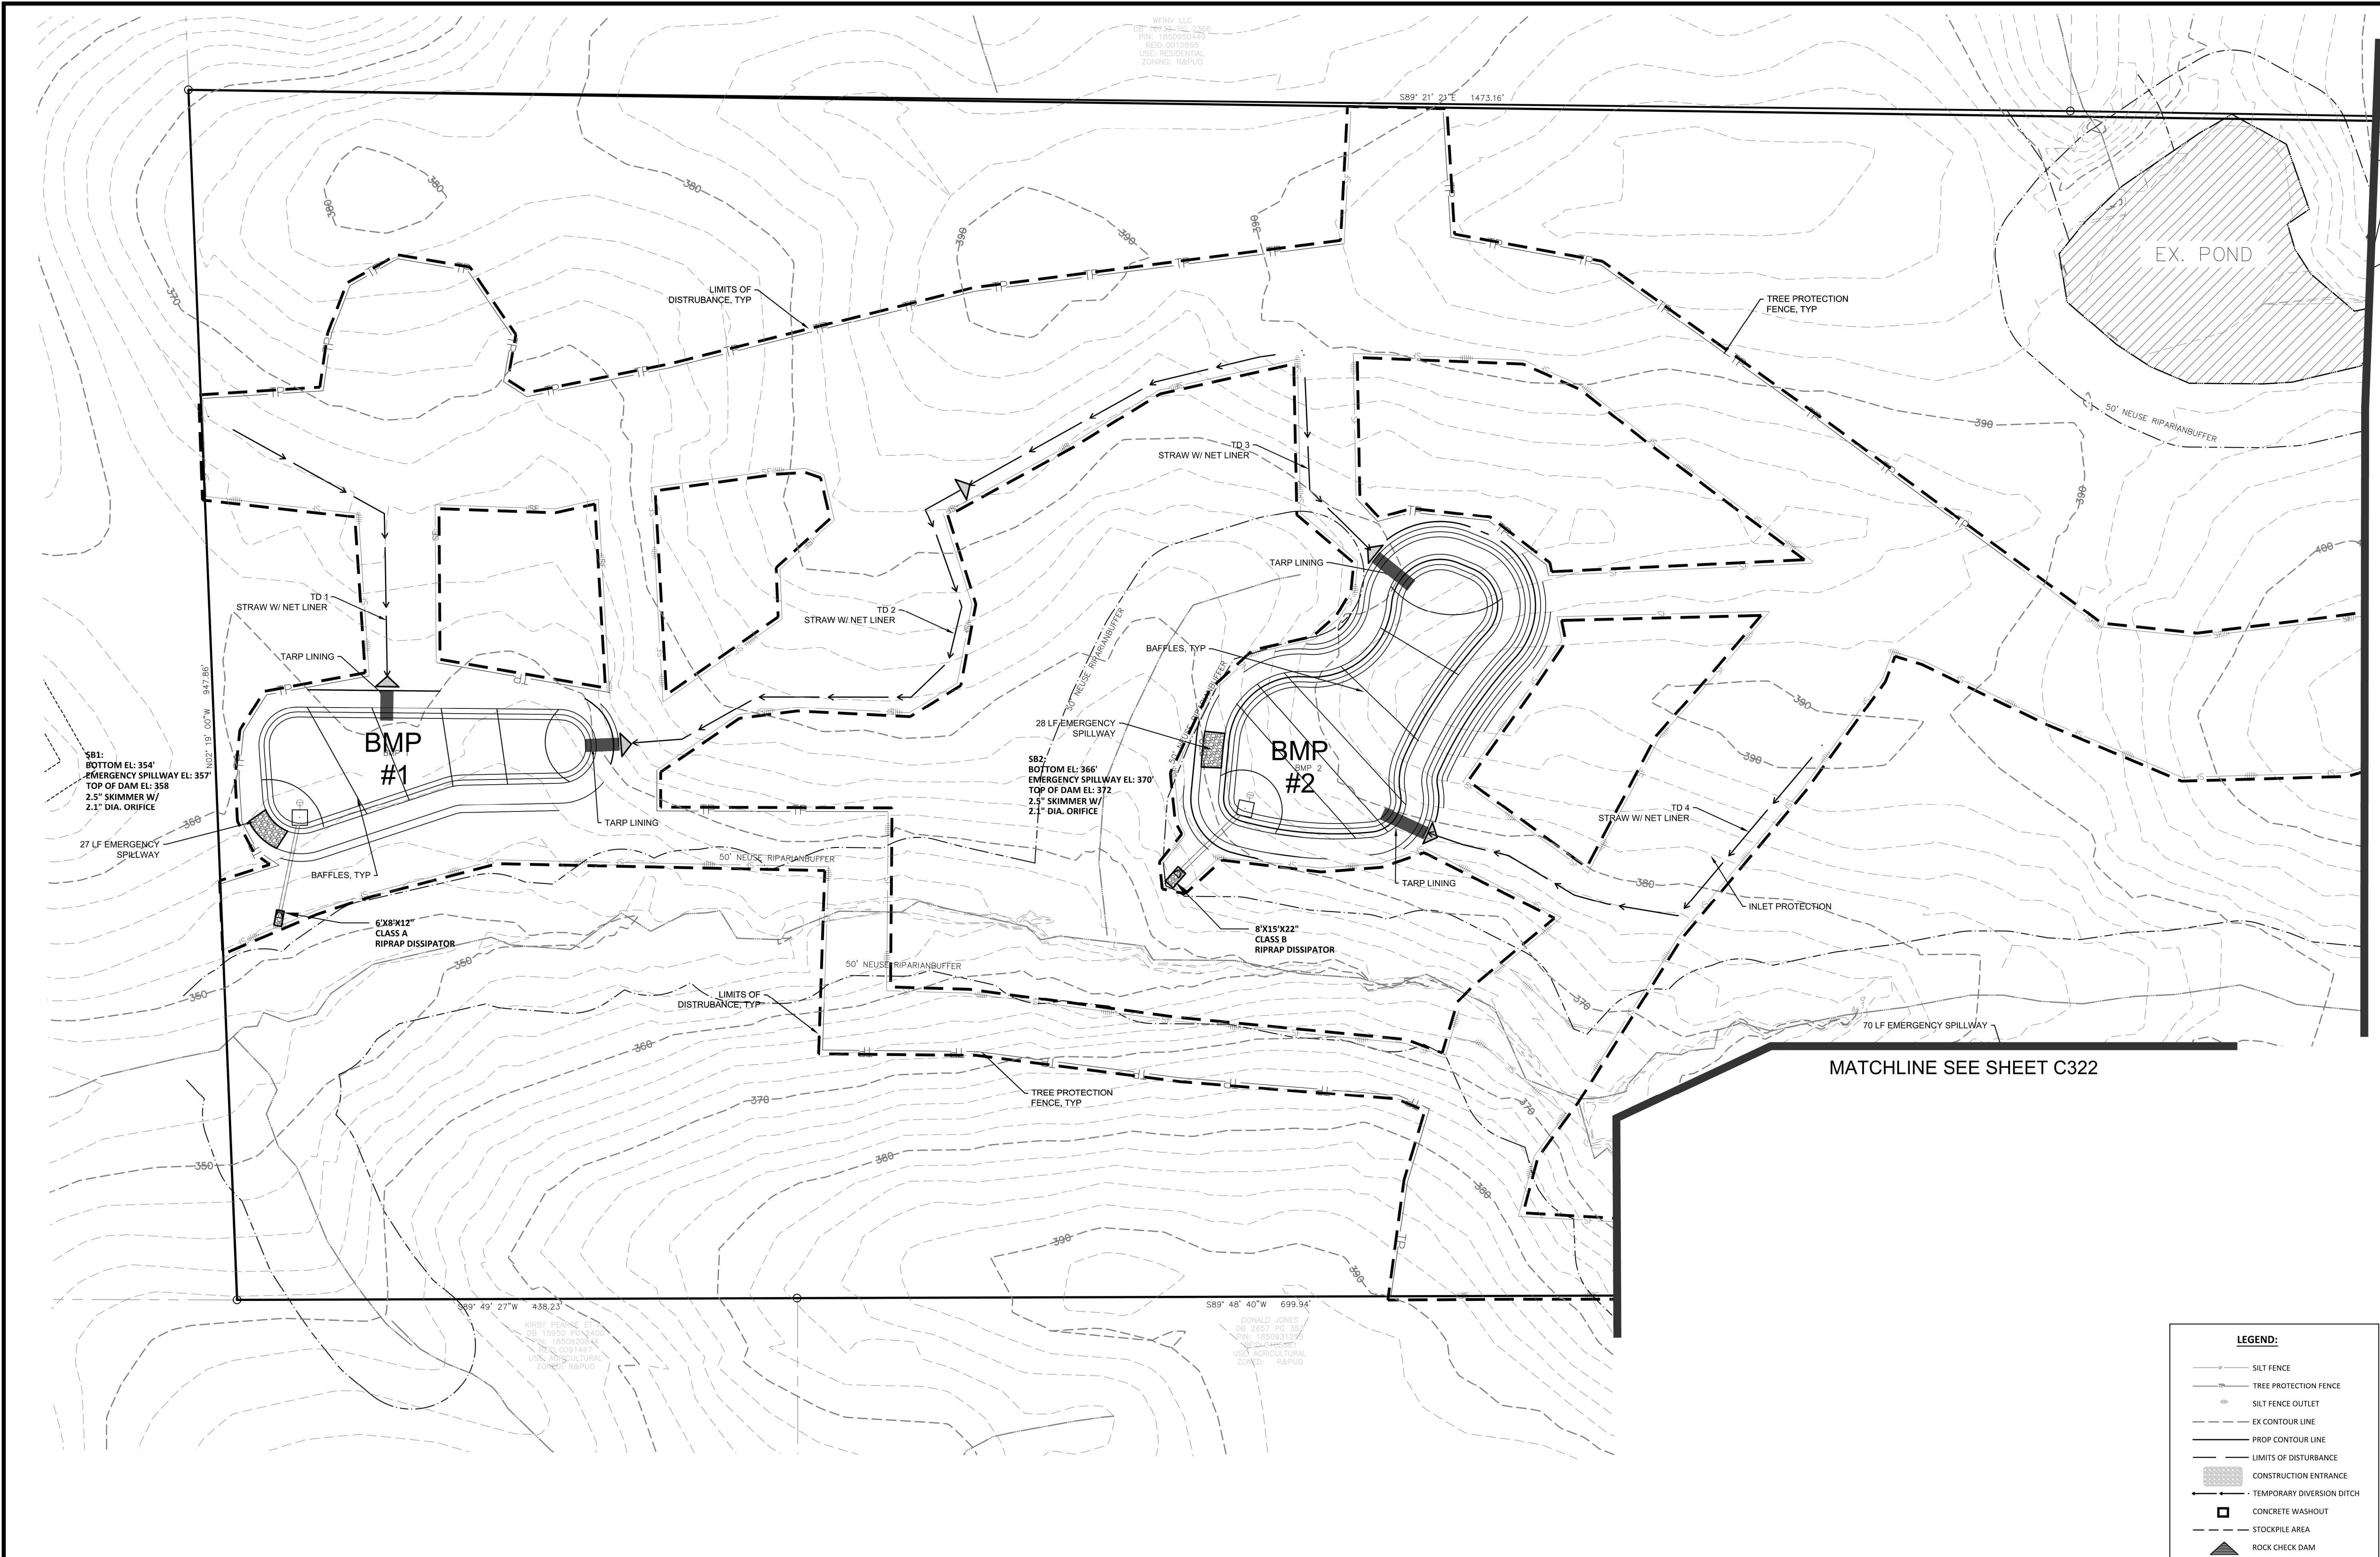

REV. NO.	DESCRIPTIONS	REVISIONS
2	REMOVE SWEETLEAF	07/31/2019



LEGEND:	
	SILT FENCE
	TREE PROTECTION FENCE
	SILT FENCE OUTLET
	EX CONTOUR LINE
	PROP CONTOUR LINE
	LIMITS OF DISTURBANCE
	CONSTRUCTION ENTRANCE
	TEMPORARY DIVERSION DITCH
	CONCRETE WASHOUT
	STOCKPILE AREA
	ROCK CHECK DAM



Bateman Civil Survey Company
Engineers • Surveyors • Planners
2524 Reliance Avenue, Apex, North Carolina 27539
Phone: 919.577.1080 Fax: 919.577.1081
NCBELS FRM No. C-2376



ELIZABETH HEIGHTS
CONSTRUCTION DRAWINGS



1205 AVERETTE ROAD
WAKE FOREST, NC 27587
WAKE COUNTY, NC

EROSION CONTROL PLAN


Project Engineer:	TSS
Designed By:	LEG
Drawn By:	LEG
Checked By:	TSS
Scale:	1"=60'
Date:	07/31/2019
Project Number:	170348

SHEET
C323

2	REMOVE SWEETLEAF	07/31/2019
REV NO.	DESCRIPTIONS	
	REVISIONS	

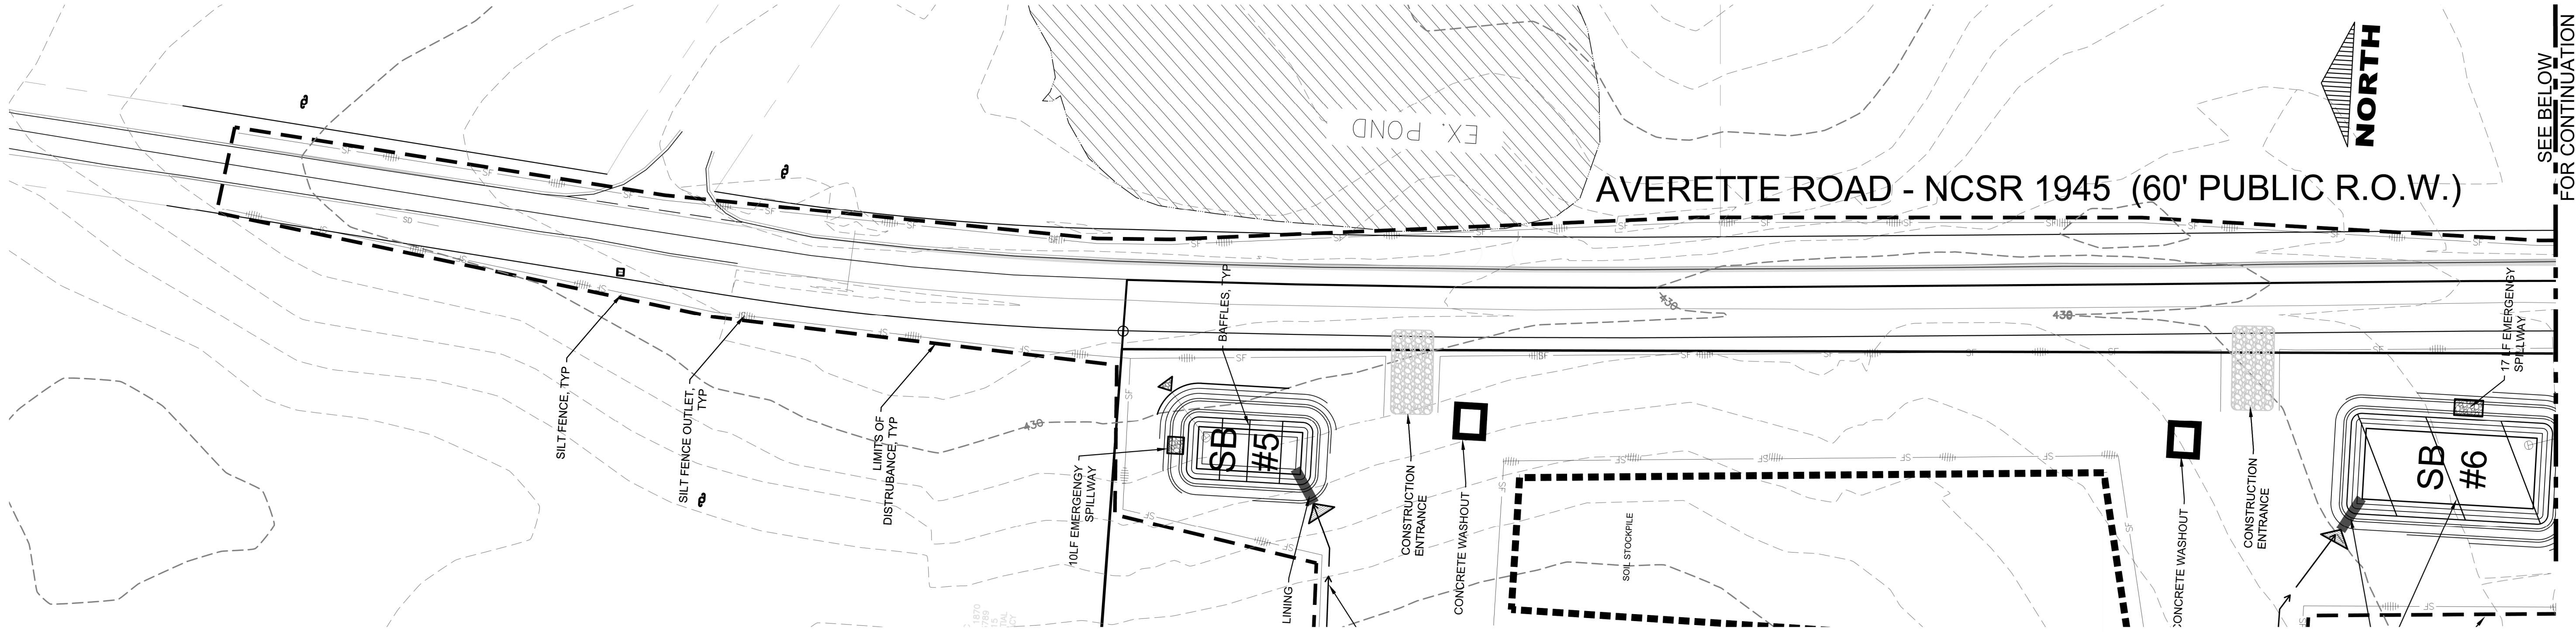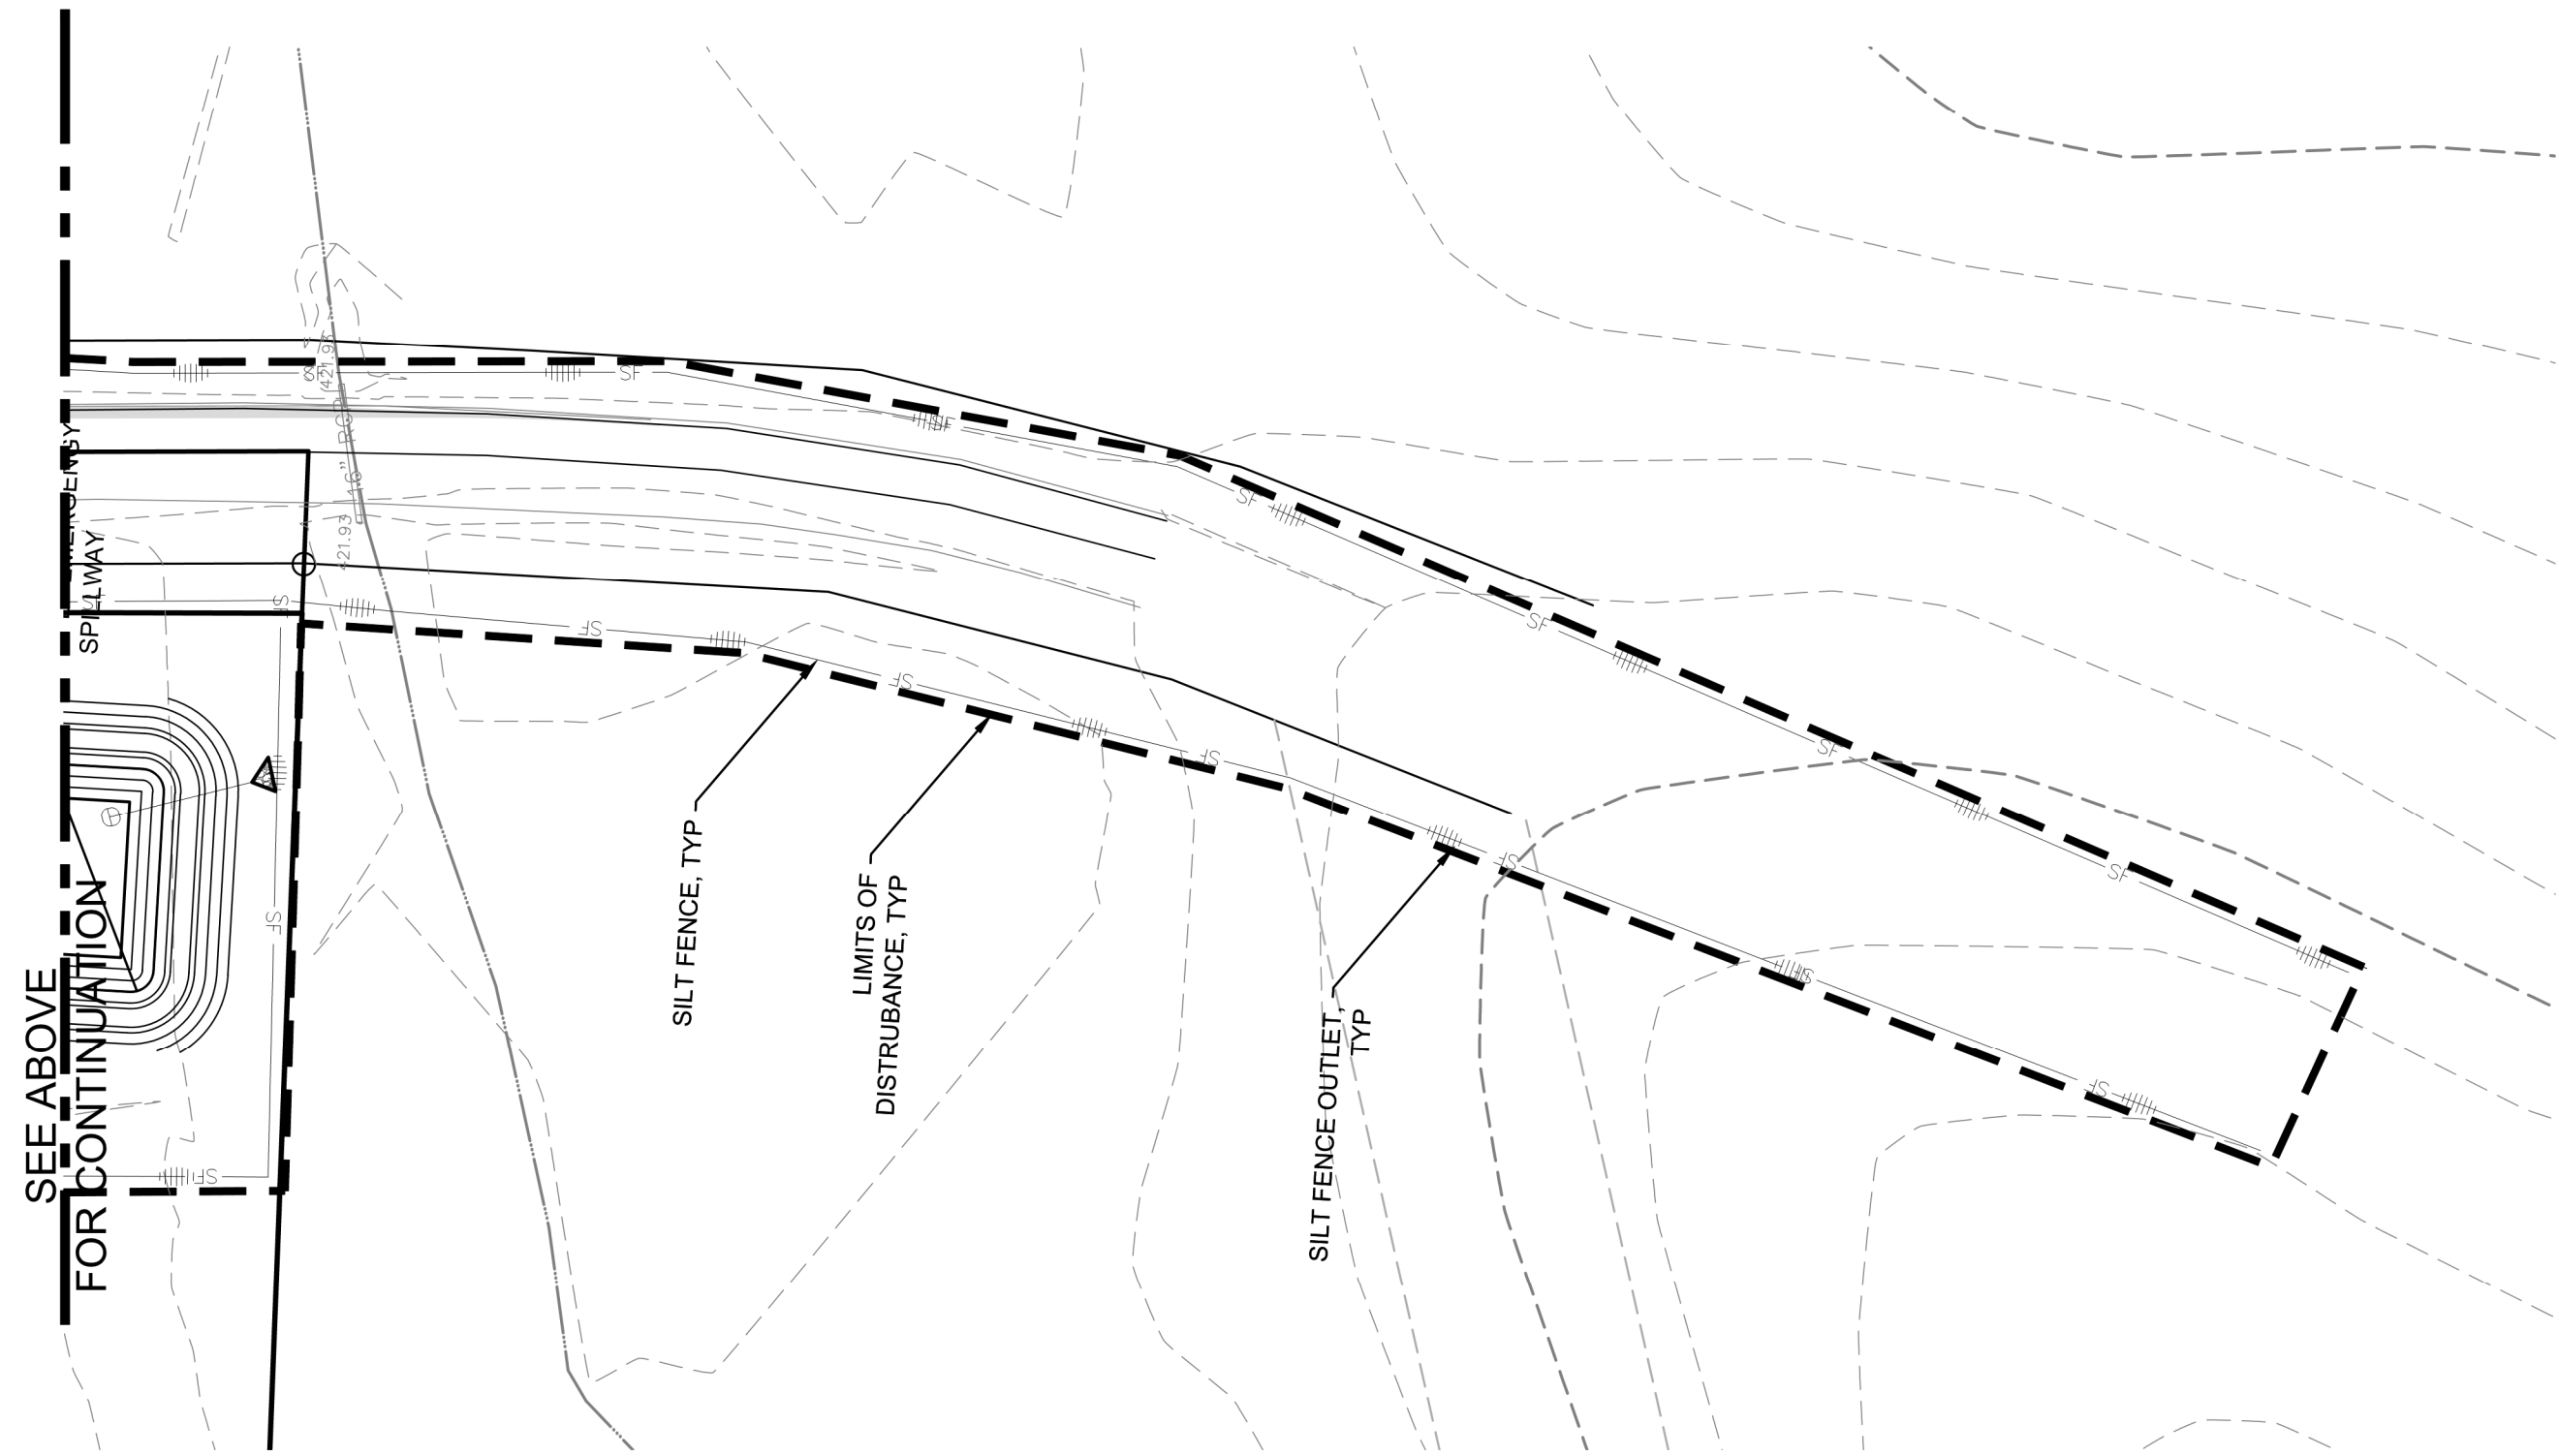

LEGEND:	
	SILT FENCE
	TREE PROTECTION FENCE
	SILT FENCE OUTLET
	EX CONTOUR LINE
	PROP CONTOUR LINE
	LIMITS OF DISTURBANCE
	CONSTRUCTION ENTRANCE
	TEMPORARY DIVERSION DITCH
	CONCRETE WASHOUT
	STOCKPILE AREA
	ROCK CHECK DAM

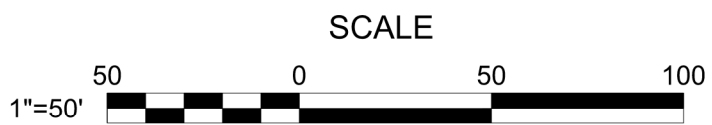

Project Engineer:	TSS
Designed By:	RAJ
Drawn By:	RAJ
Checked By:	TSS
Scale:	NTS

Date:	07/31/2019
Project Number:	.170348

SHEET
C324

ELIZABETH HEIGHTS

CONSTRUCTION DRAWINGS

1205 AVERETTE ROAD
WAKE FOREST, NC 27587
WAKE COUNTY, NC



Bateman Civil Survey Company

Engineers • Surveyors • Planners

2524 Reliance Avenue, Apex, North Carolina 27539


Phone: 919.577.1080 Fax: 919.577.1081

NCBELS FRM No. C-2376



ELIZABETH HEIGHTS-----

2	REMOVE SWEETLEAF	07/31/2019
REV NO.	DESCRIPTIONS	
	REVISIONS	

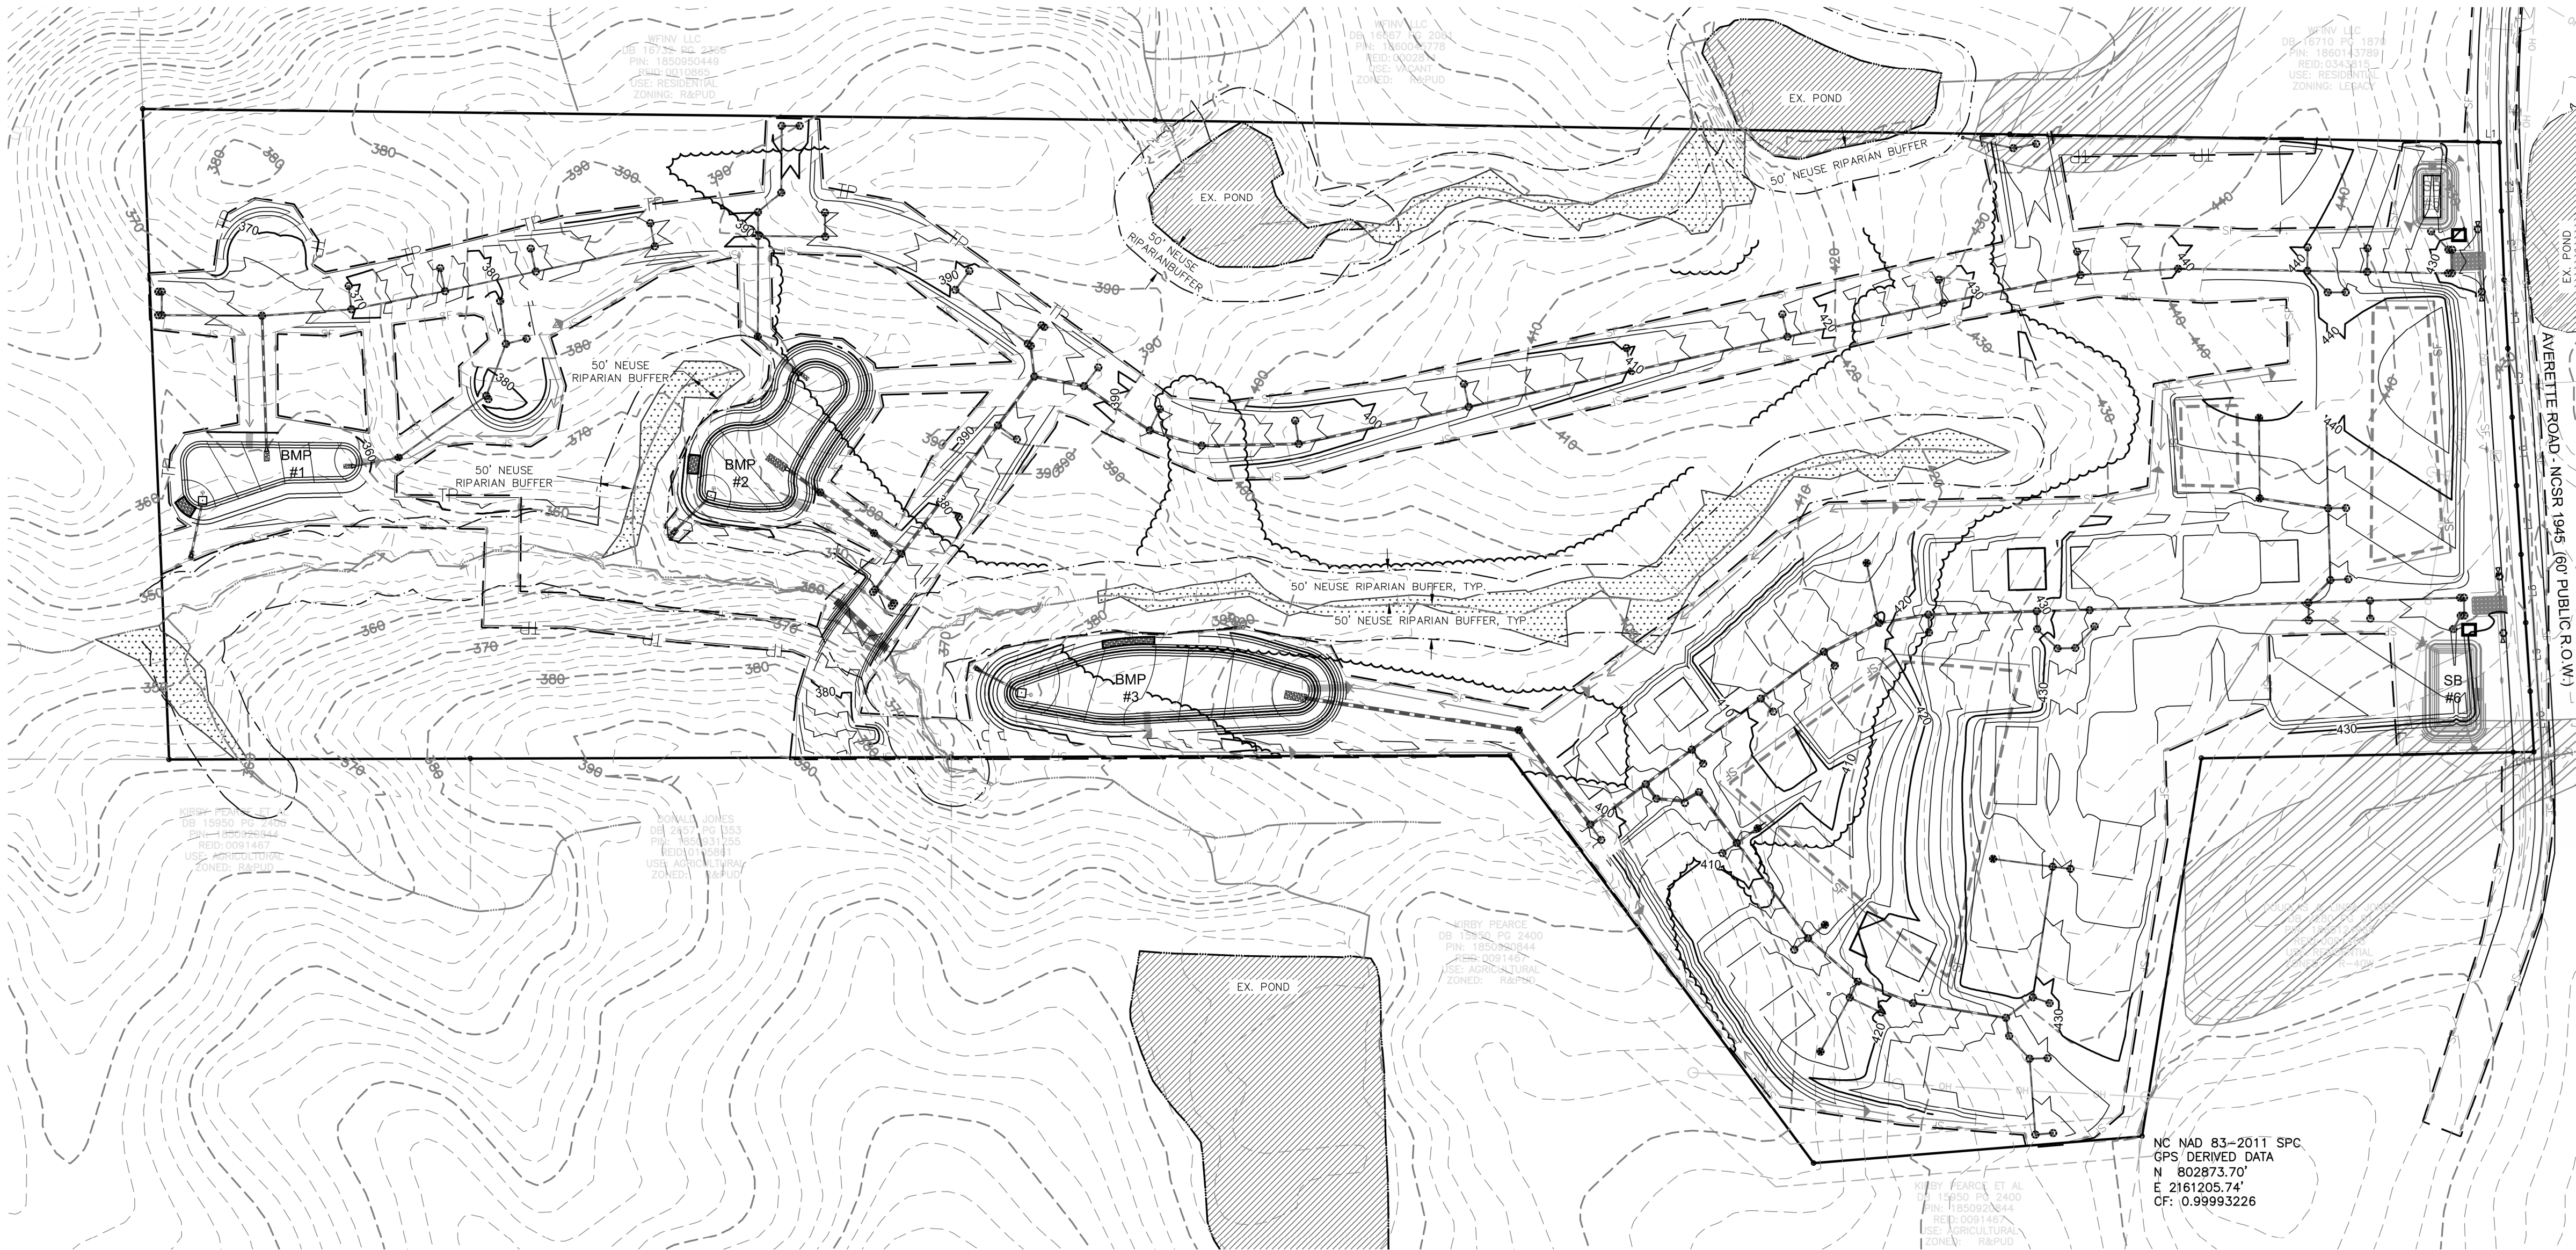

LEGEND:

- SILT FENCE
- TREE PROTECTION FENCE
- SILT FENCE OUTLET
- EX CONTOUR LINE
- PROP CONTOUR LINE
- LIMITS OF DISTURBANCE
- CONSTRUCTION ENTRANCE
- TEMPORARY DIVERSION DITCH
- CONCRETE WASHOUT
- STOCKPILE AREA
- INLET PROTECTION
- ROCK CHECK DAM

**TOTAL DISTURBED AREA =
1,852,574 SF
42.52 AC**



ELIZABETH HEIGHTS
CONSTRUCTION DRAWINGS

OVERALL
EROSION CONTROL PLAN


Project Engineer:	TSS
Designed By:	LEG
Drawn By:	LEG
Checked By:	TSS
Scale:	1"=150'
Date:	07/31/2019
Project Number:	170348

SHEET
C325



Bateman Civil Survey Company
Engineers • Surveyors • Planners
2524 Reliance Avenue, Apex, North Carolina 27539
Phone: 919.577.1080 Fax: 919.577.1081
NCBELS FRM No. C-2376



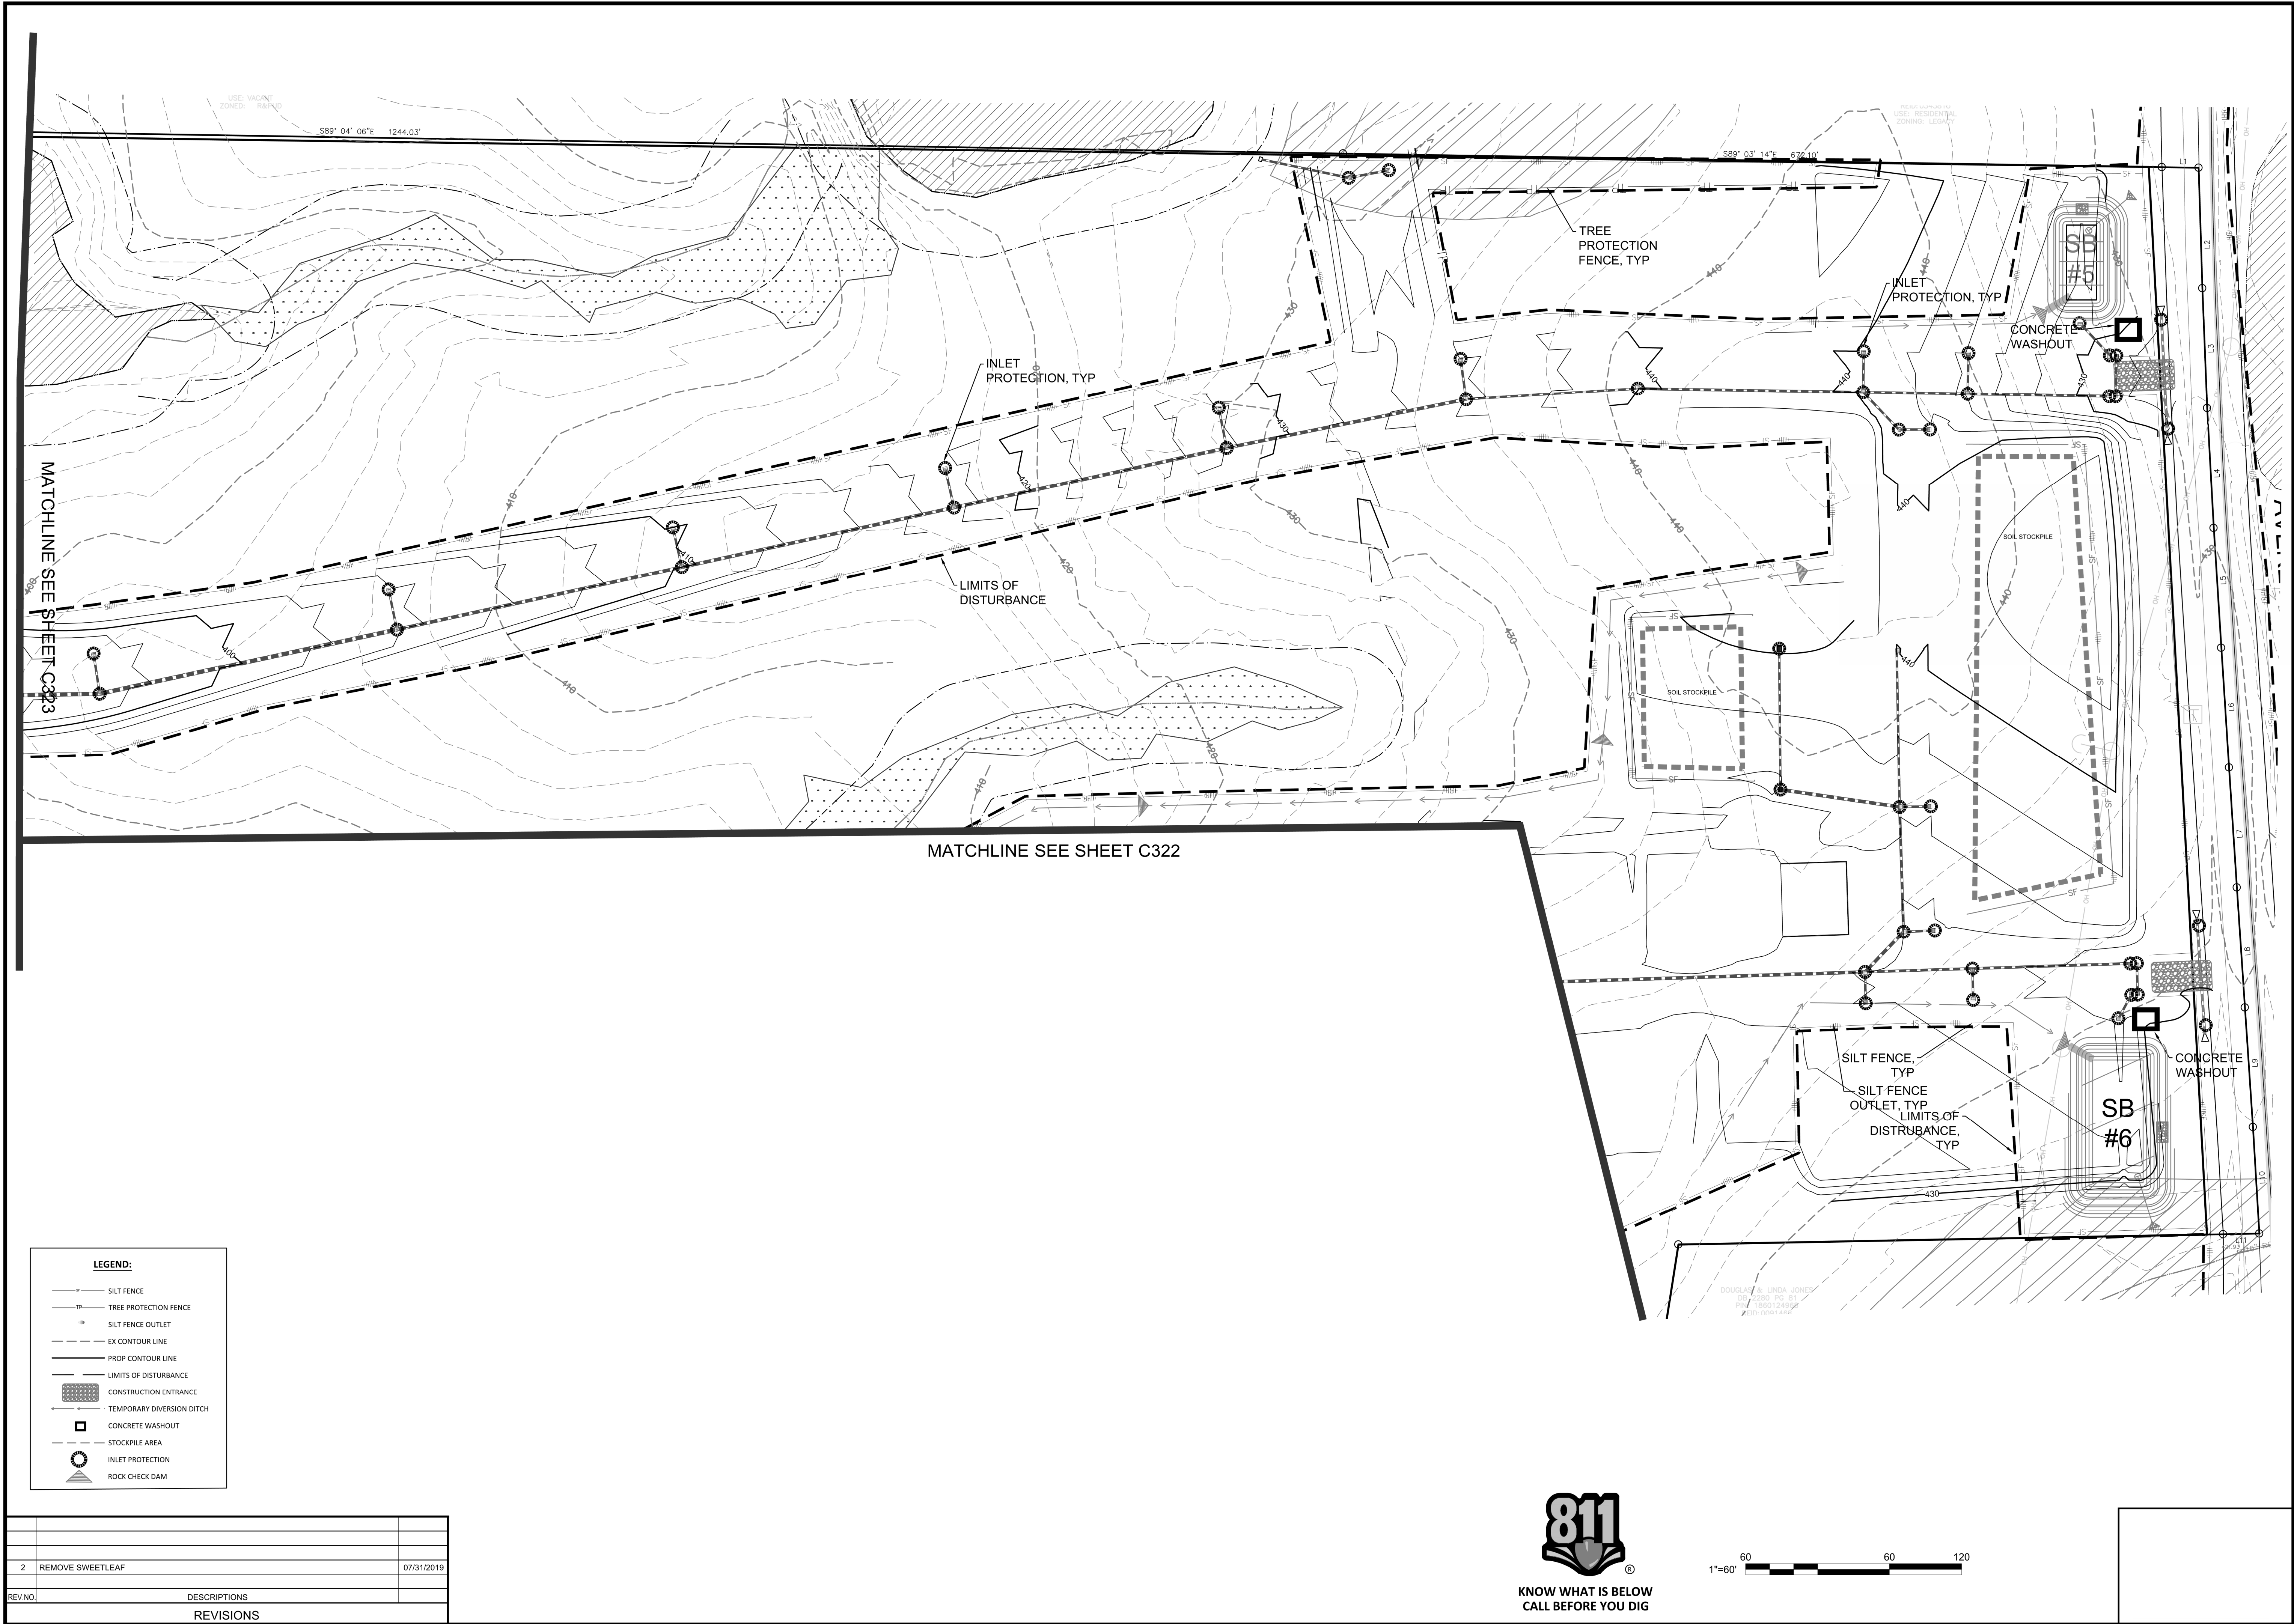

LEGEND:		
	SILT FENCE	
	TREE PROTECTION FENCE	
	SILT FENCE OUTLET	
	EX CONTOUR LINE	
	PROP CONTOUR LINE	
	LIMITS OF DISTURBANCE	
	CONSTRUCTION ENTRANCE	
	TEMPORARY DIVERSION DITCH	
	CONCRETE WASHOUT	
	STOCKPILE AREA	
	INLET PROTECTION	
	ROCK CHECK DAM	

REV NO.	DESCRIPTIONS	REVISIONS
2	REMOVE SWEETLEAF	07/31/2019



Bateman Civil Survey Company
Engineers • Surveyors • Planners
2524 Reliance Avenue, Apex, North Carolina 27539
Phone: 919.577.1080 Fax: 919.577.1081
NCBELS FIRM No. C-2376

ELIZABETH HEIGHTS
CONSTRUCTION DRAWINGS
1205 AVERETTE ROAD
WAKE FOREST, NC 27587
WAKE COUNTY, NC

EROSION CONTROL PLAN

Project Engineer:	TSS
Designed By:	LEG
Drawn By:	LEG
Checked By:	TSS
Scale:	1"=60'

Date:	07/31/2019
Project Number:	170348

SHEET

C326